


Parcel	Kind of Instrument	Date of Grant	Grantor	Grantee	Recorded	Remarks
B'	G.C.D.	9-13-33	Lelia E. Thurston	Staf W. 12	440	9-18-33
A	"	9-14-33	W.G. Farr	" 22	442	9-18-33


STATE	PLAT	YEAR	SHEET	TOTAL SHEETS
VT.	ARHIVE	1933	11	30

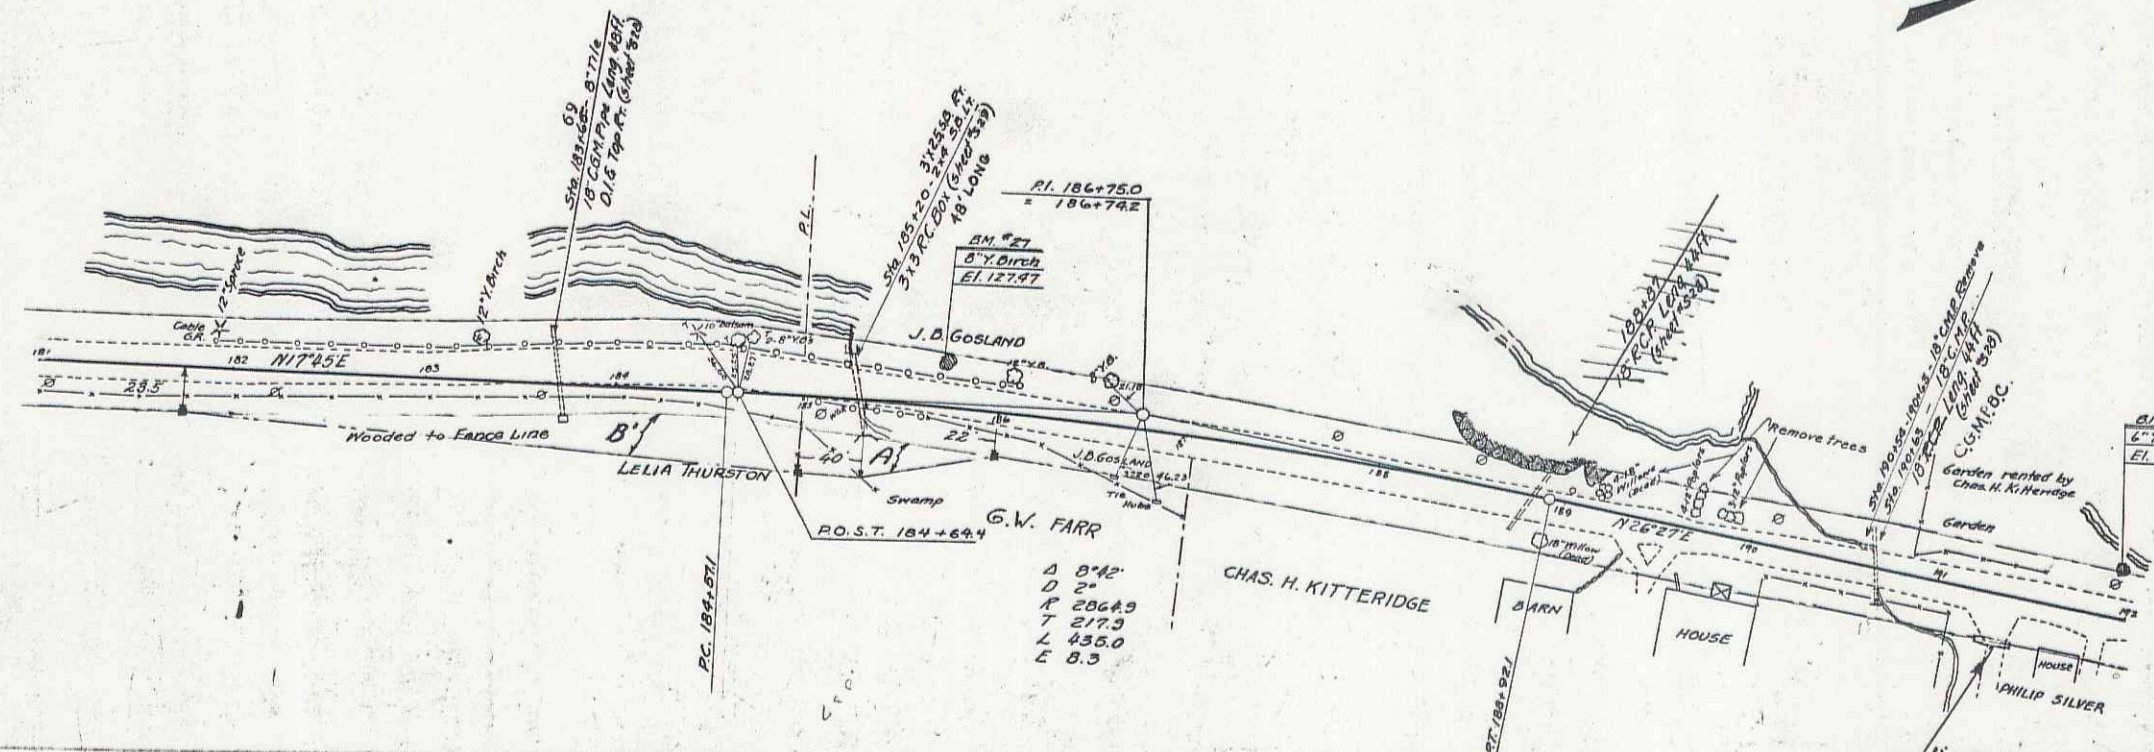

CONCRETE R.O.W. MARKERS

STATION	LT	RT	DISTANCE
181+75	L		23.5'
185+00	L		40.0'
186+00	L		22.0'

Distance measured to iron pin  
MARKERS SET BY R.J.M.  
July 1934

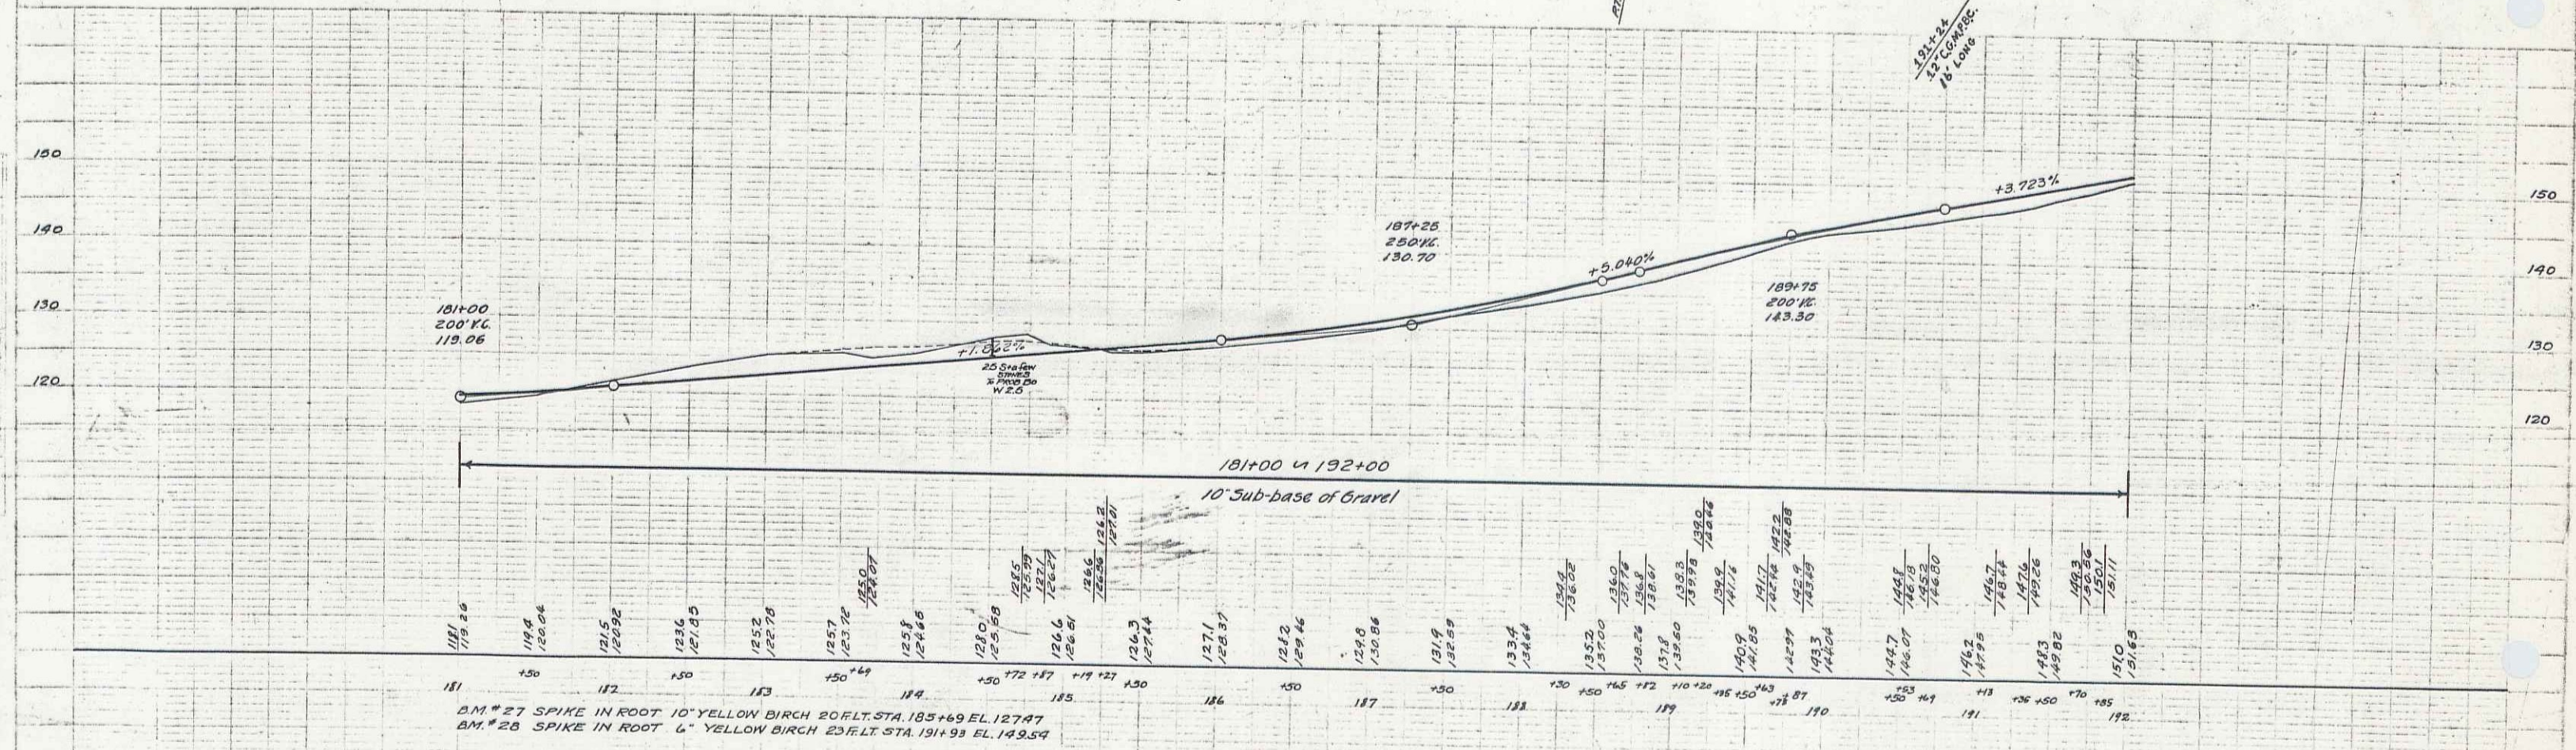

BM # 27 SPIKE IN ROOT 10" YELLOW BIRCH 20' E.L.T. STA. 183+69 EL. 127.97  
 BM # 28 SPIKE IN ROOT 6" YELLOW BIRCH 23' E.L.T. STA. 191+93 EL. 143.54

SERIES NRH NO. 81E  
 SHEET 11 OF 30

9