
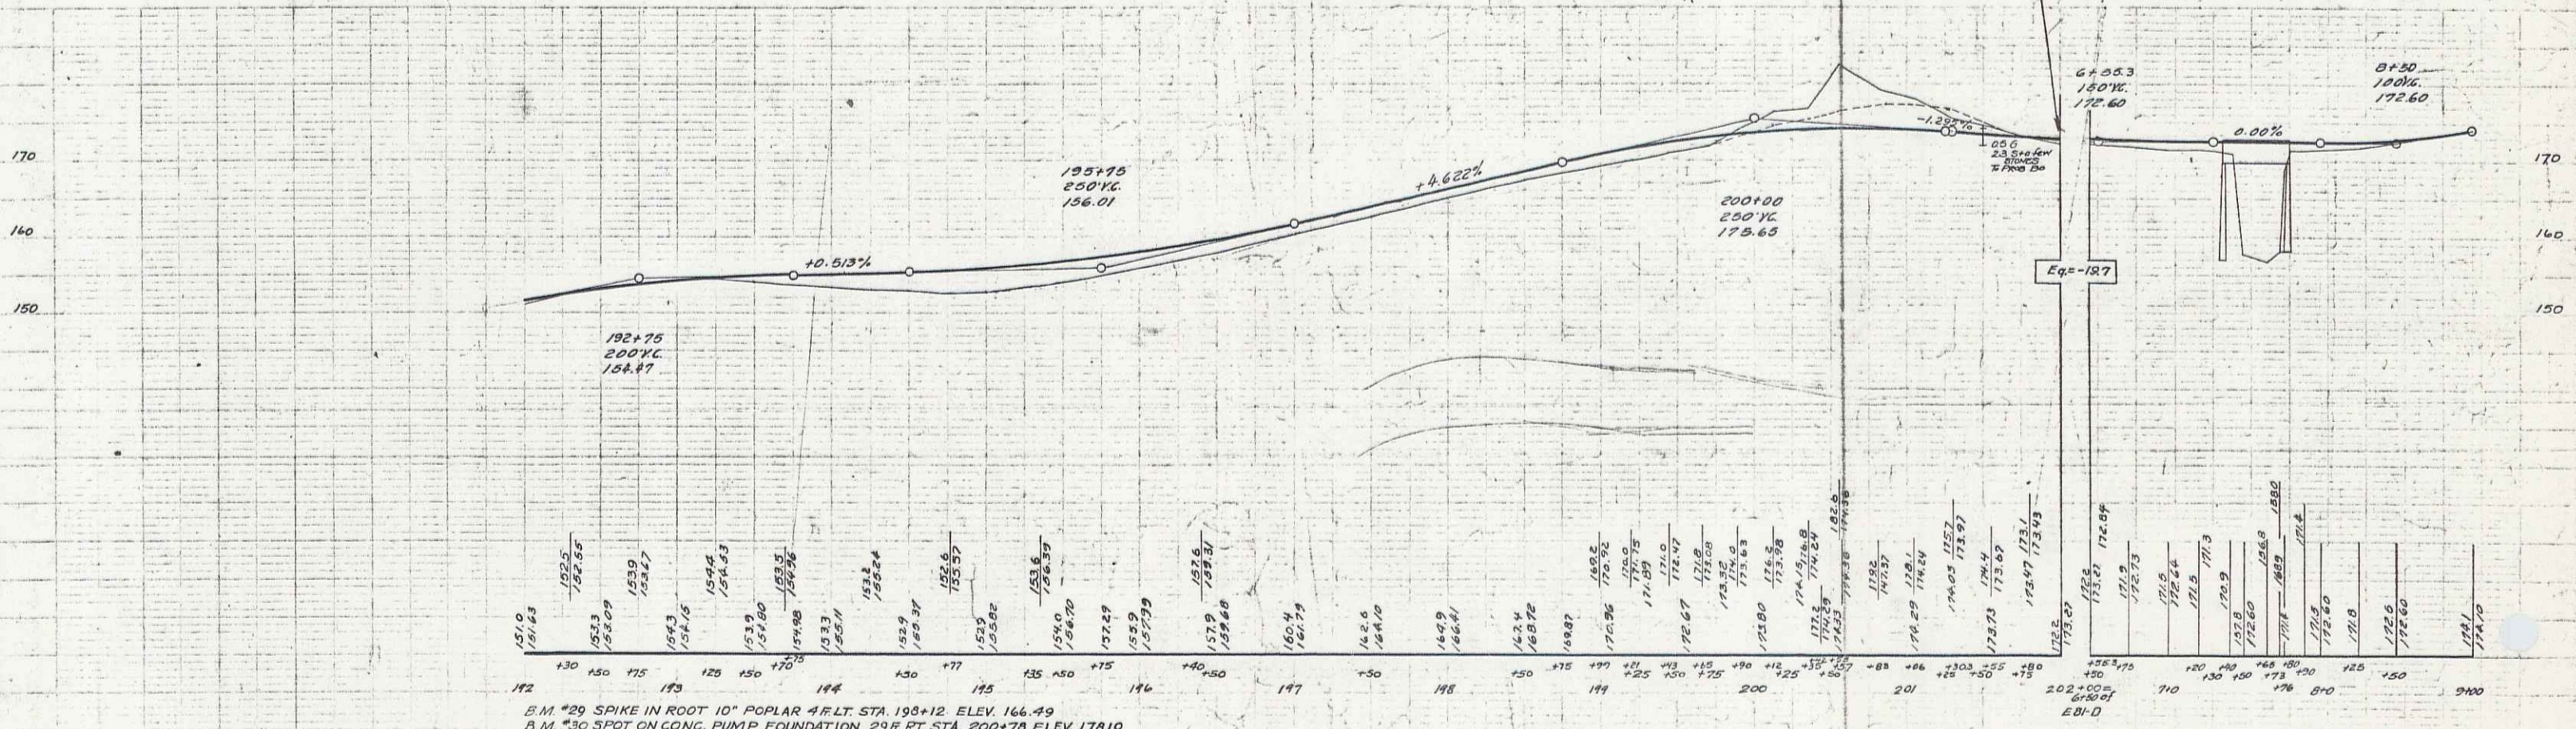


Parcel	Kind of Instrument	Date of Instrument	Grantor	Grantee	Recorded	Remarks
C	Q.C.D.	9-14-33	Philip A. Silver	Staff	Book Page Date	
B	"	9-14-33	W.G. Farr	"	22 44 9 9-18-33	
C	"	9-13-33	Lelia E. Thurston	"	22 44 2 9-18-33	
A	"	10-23-33	Elizabeth Bennett	"	22 44 8 12-1-33	

STATE	YEAR	SHEET NO.	TOTAL SHEETS
VT.	1933	12	50

CONCRETE R.O.W. MARKERS
 STATION LT. RT. DISTANCE
 191+85 ✓ 24.5'
 192+25 ✓ 40.0'
 193+00 ✓ 40.0'
 194+00 ✓ 25.0'
 195+00 ✓ 26.0'
 199+75 ✓ 33.0'
 201+50 ✓ 50.0'

Distance measured to center of iron PIN
 MARKERS SET BY A.M.M.
 July 1934.

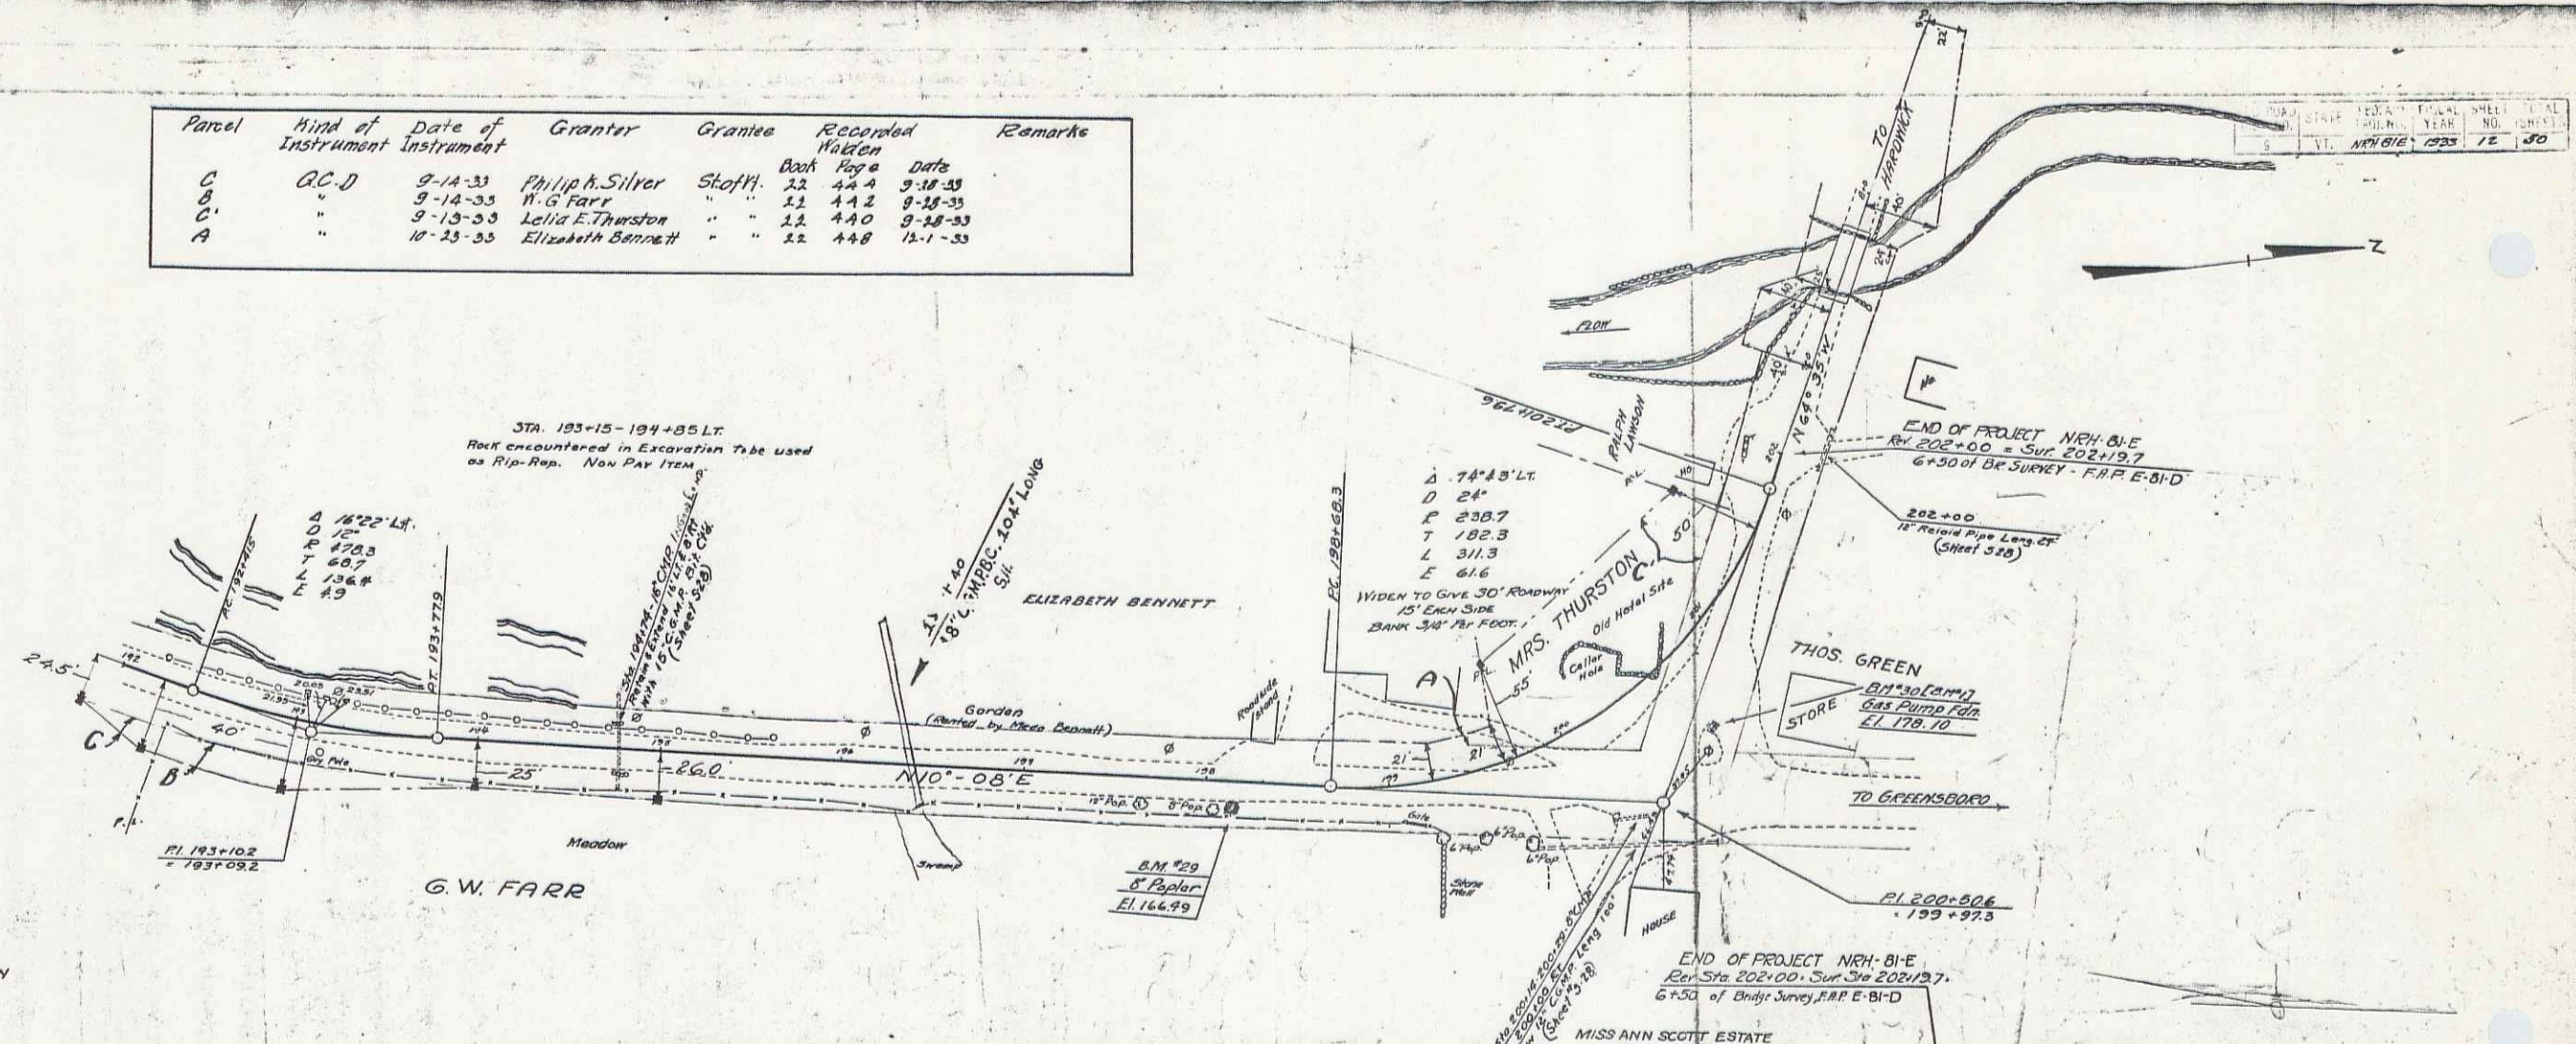

SERIES-NRW NO. 81 E
 SHEET 12 OF 50

16