
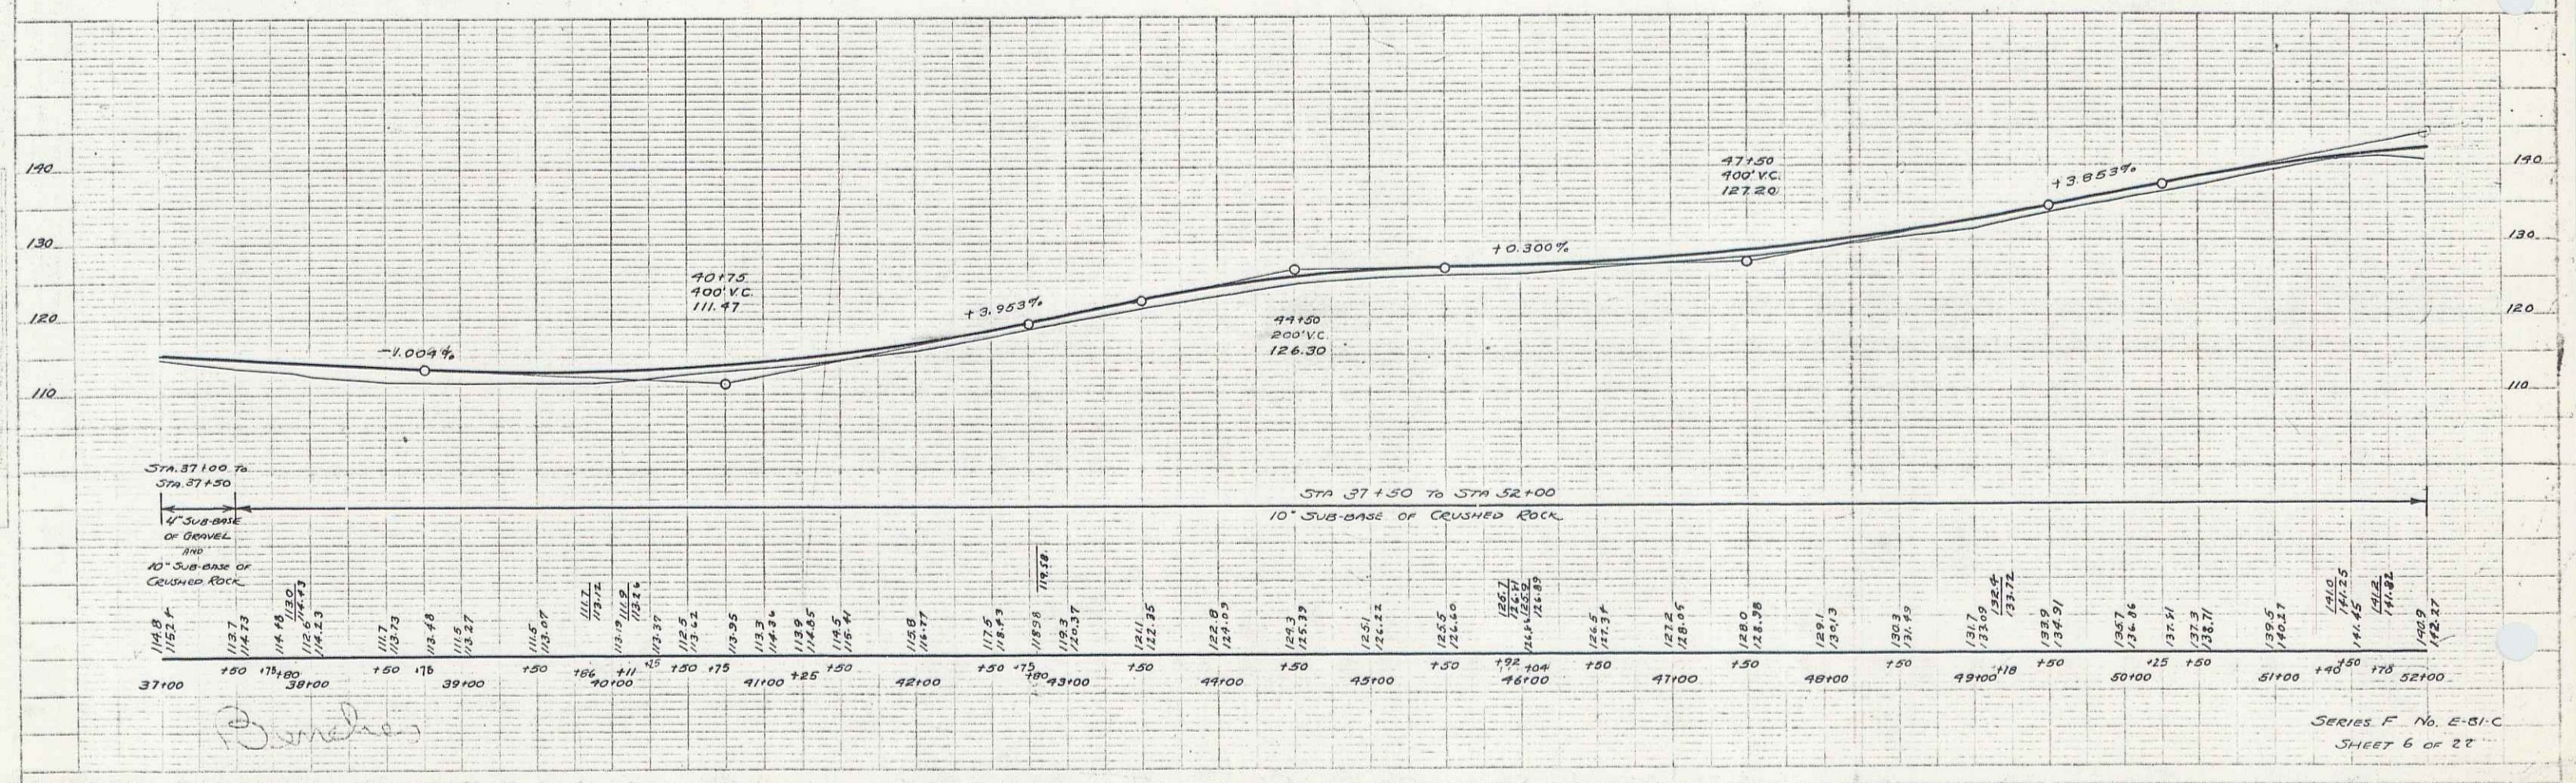


Parcel	Kind of Instrument	Date of Instrument	Grantor	Grantee	Recorded Certificate	Remarks
A & B'	C.C.D.	2-10-33	W.W. Ainsworth	Sloft V.	33 618-619	2-14-33
A	"	2-10-33	W.W. Ainsworth	Sloft V.	33 620-621	2-17-33

FEDERAL ROAD DIST. NO. STATE PROJ. NO. YEAR SHEET NO. TOTAL SHEETS  
 9 VI. E-81-C 1932 6 22

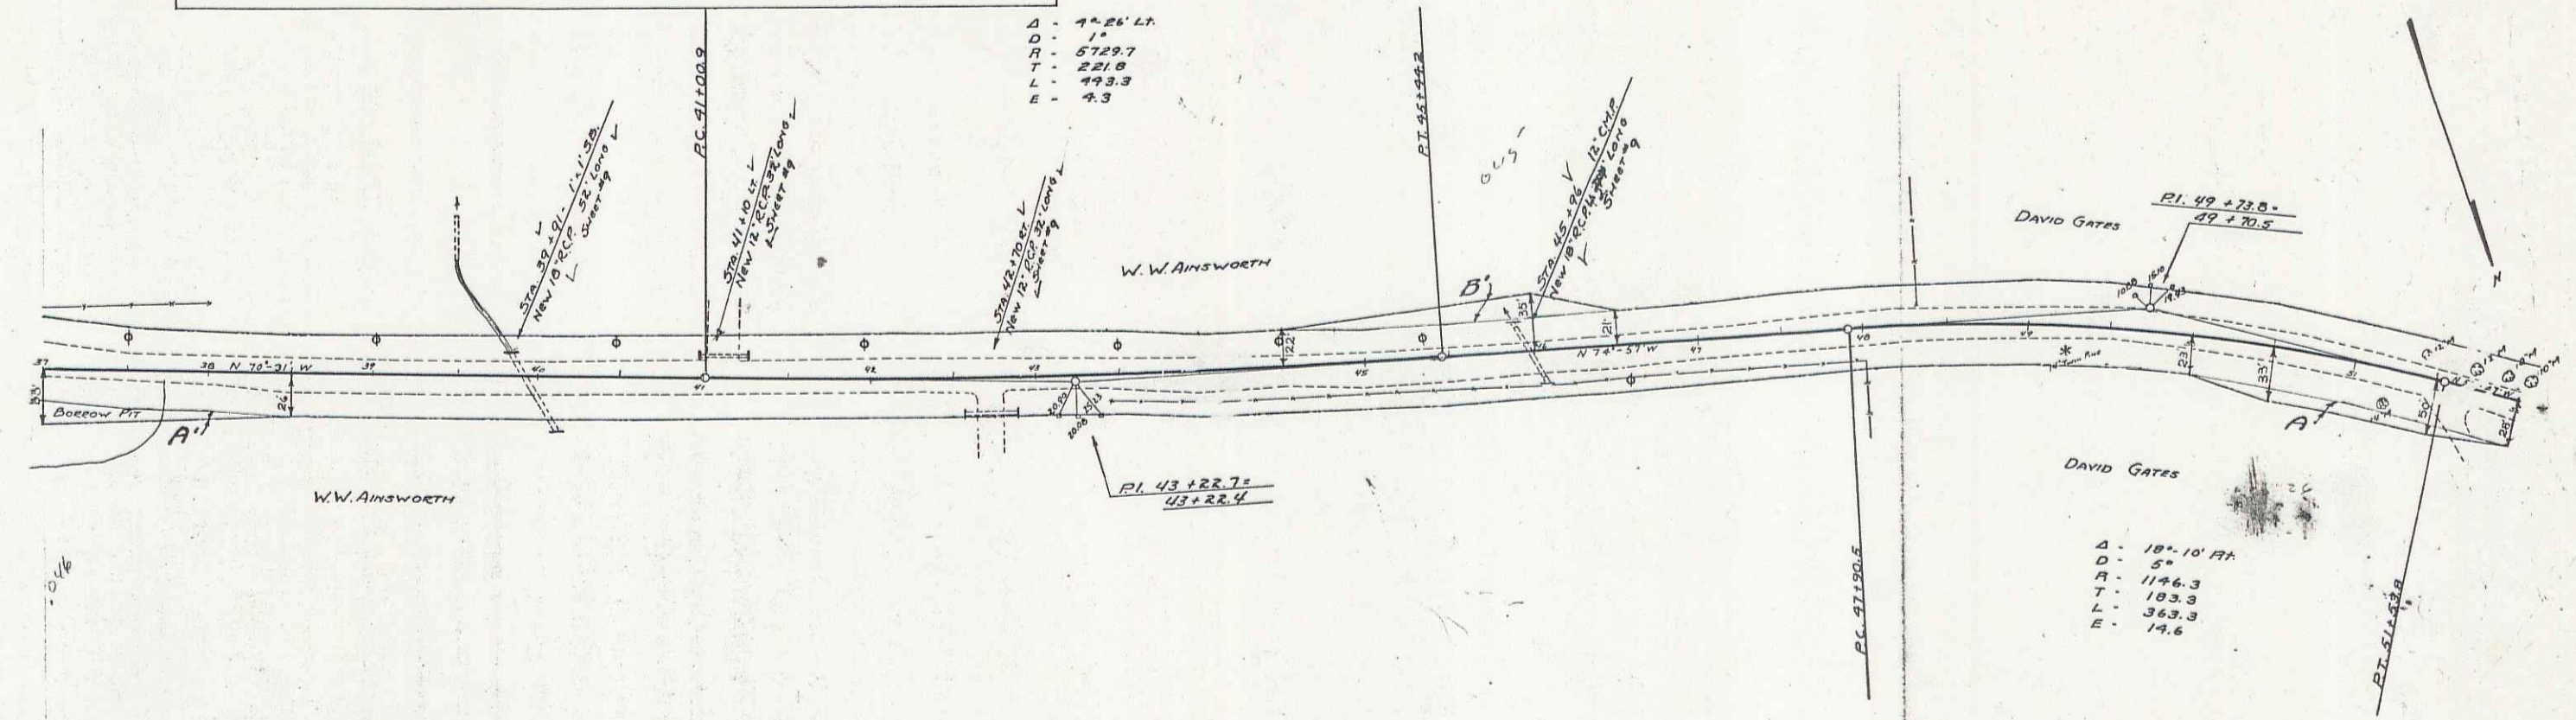

PLAN  
 WOOD THOMAS  
 3/4"

PROFILE  
 WOOD THOMAS  
 3/4"

*Handwritten signature*

SERIES F No. E-81-C  
 SHEET 6 OF 22