
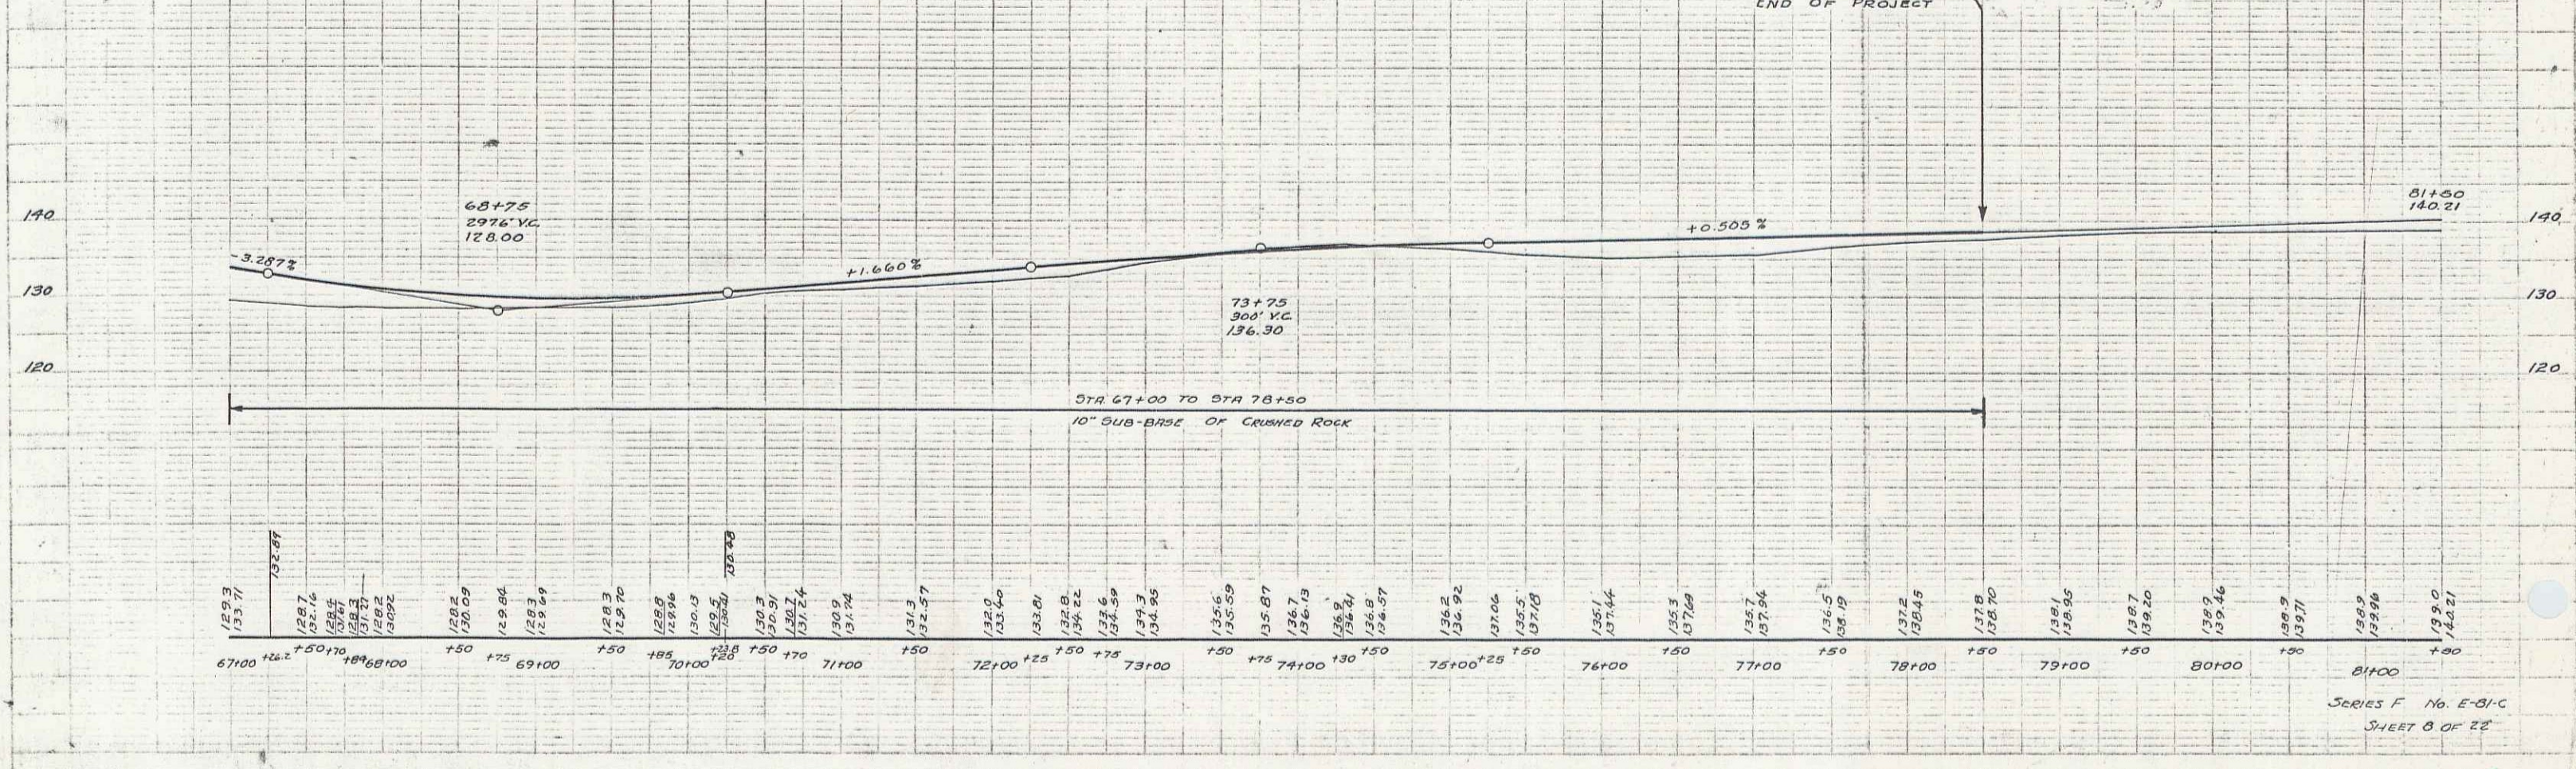


Parcel	Kind of Instrument	Date of Grant	Grantor	Grantee	Recorded Date	Remarks
B'	D.C.D.	1-10-39	W.A.R. Smith	Sheff H. 33	6/21/47	2.14.33

FED. ROAD DIST. NO.	STATE	SECTION	FISCAL YEAR	SHEET NO.	TOTAL SHEETS
9	VI.	E-61-C	1932	B	22

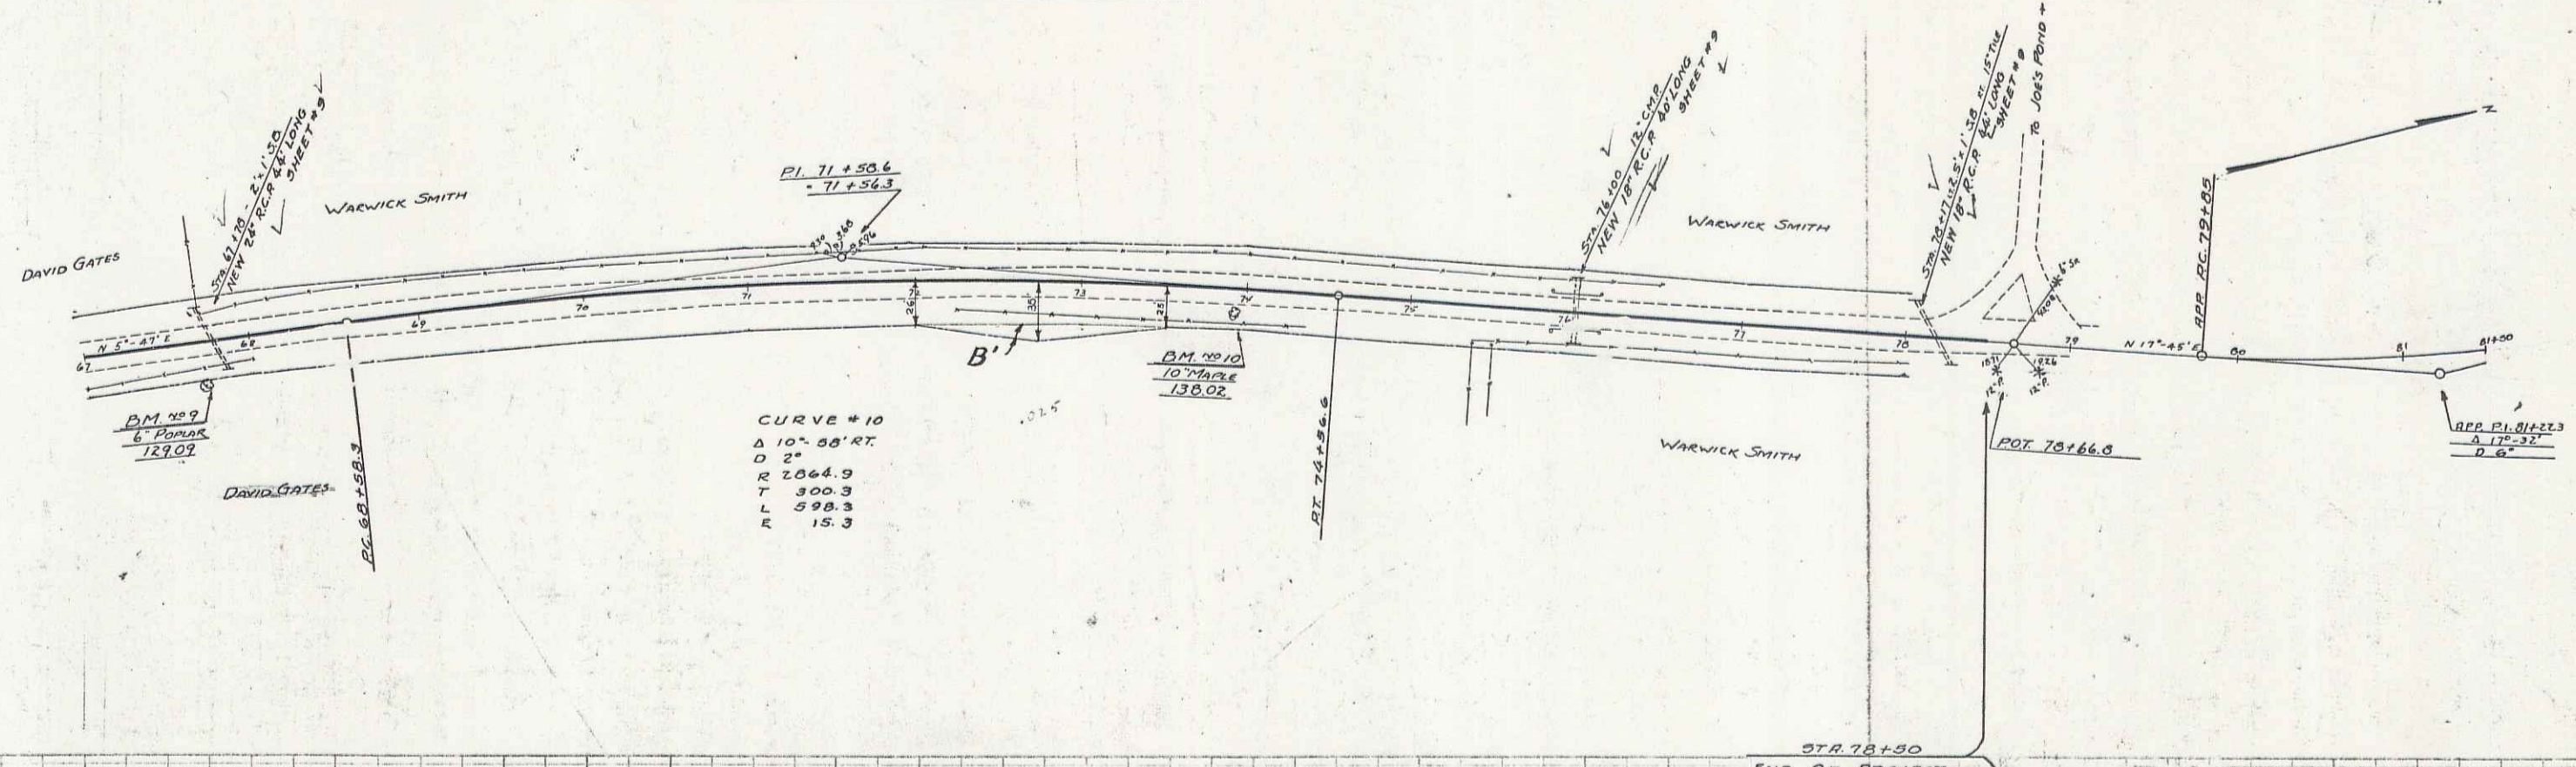

SERIES F No. E-61-C  
SHEET 8 OF 22

5