
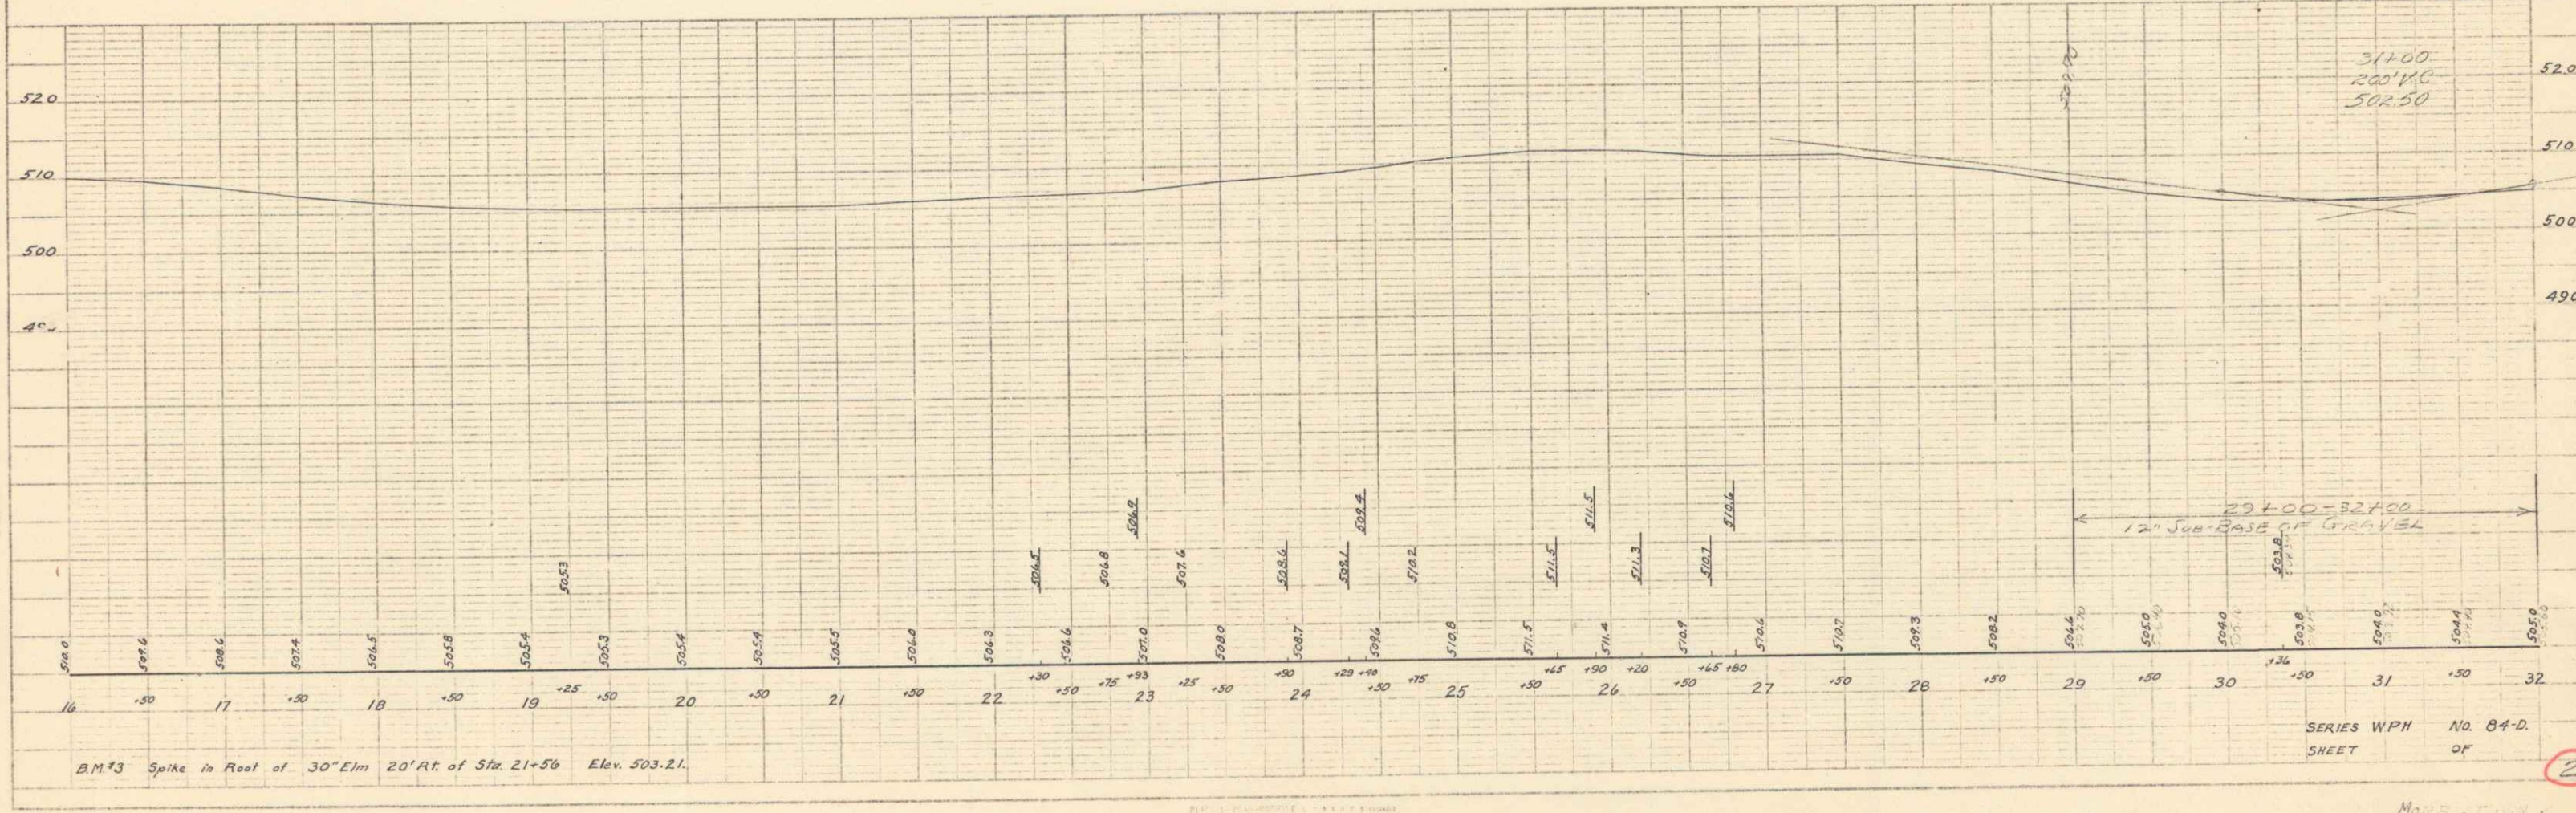


PLAN
 DATE
 DRAWN BY
 CHECKED BY

PLAN
 DATE
 DRAWN BY
 CHECKED BY

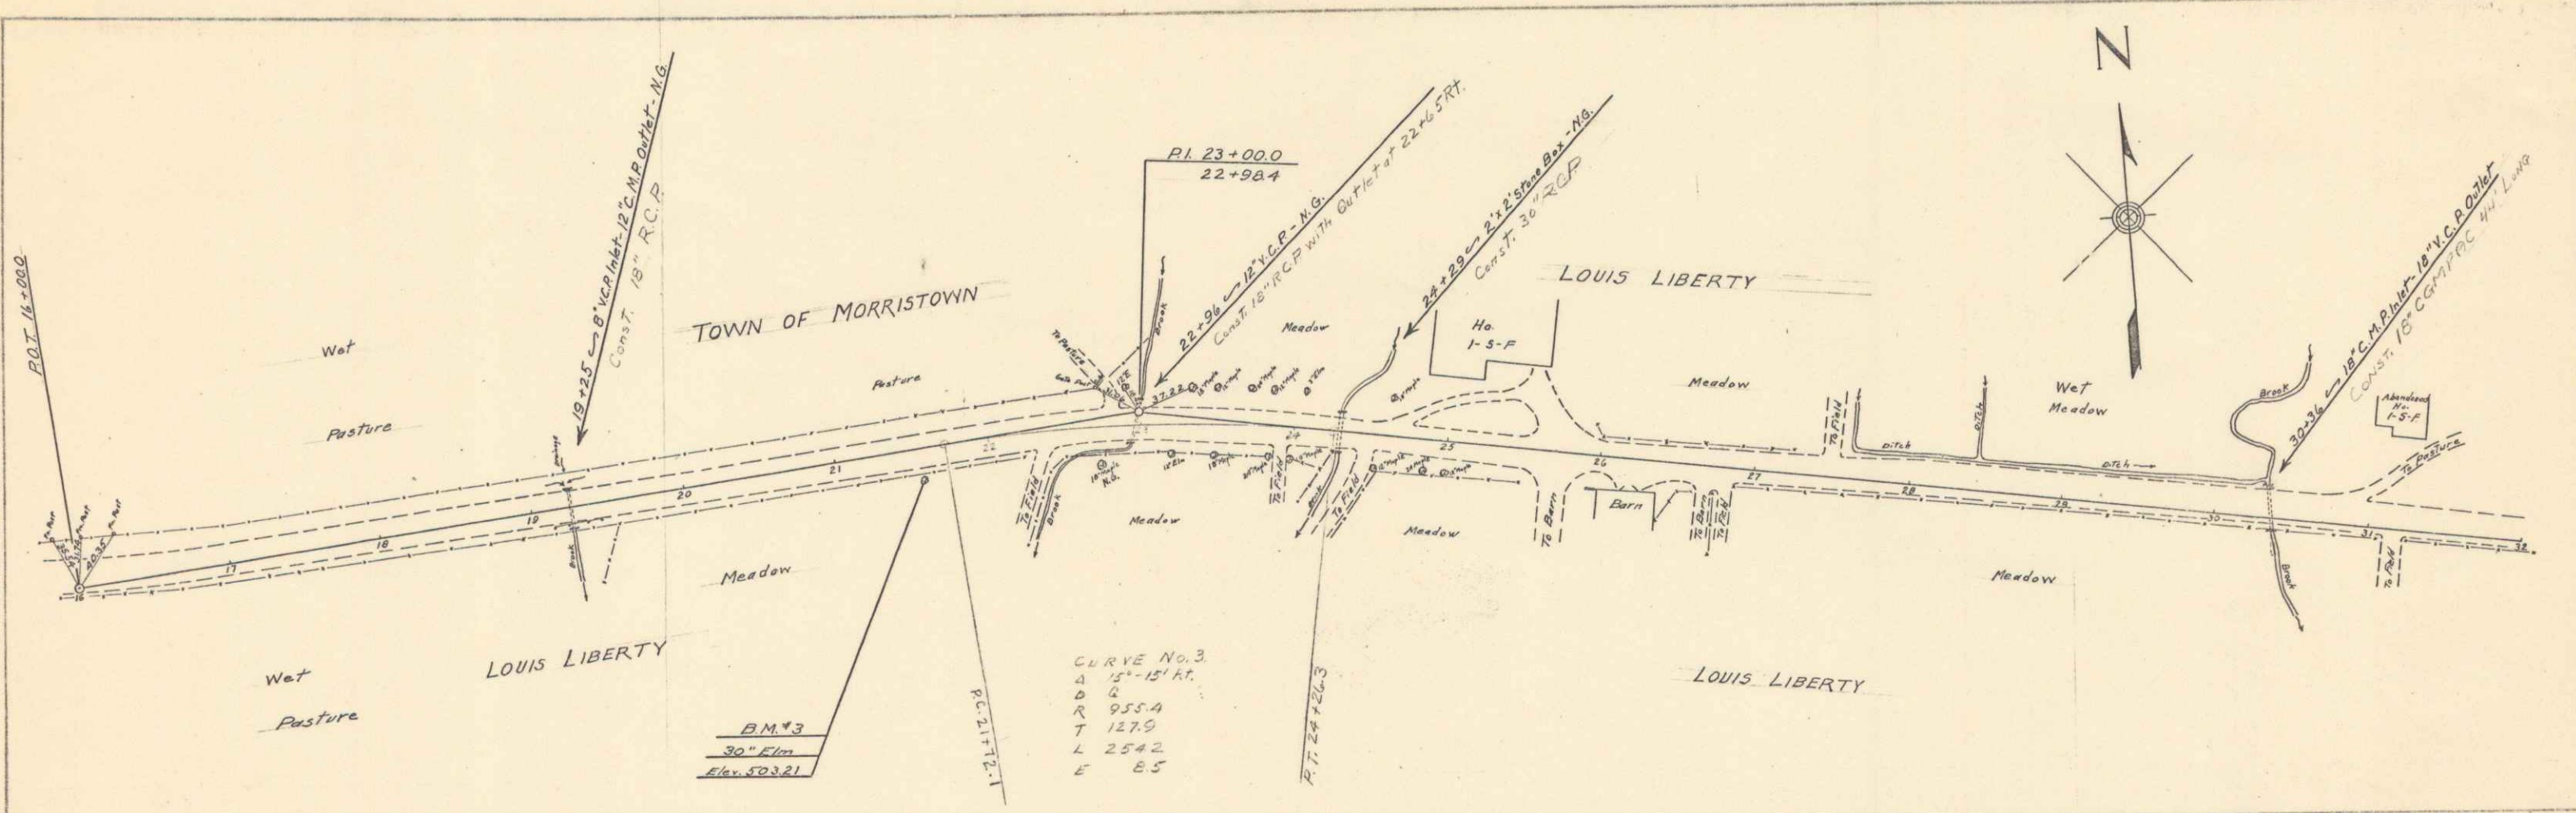

SERIES WPH No. 04-D
 SHEET OF

2

3