


- Δ 30'-50' El ✓
- 0.6' ✓
- R 9554 ✓
- T 2635 ✓
- L 3139 ✓
- E 356 ✓

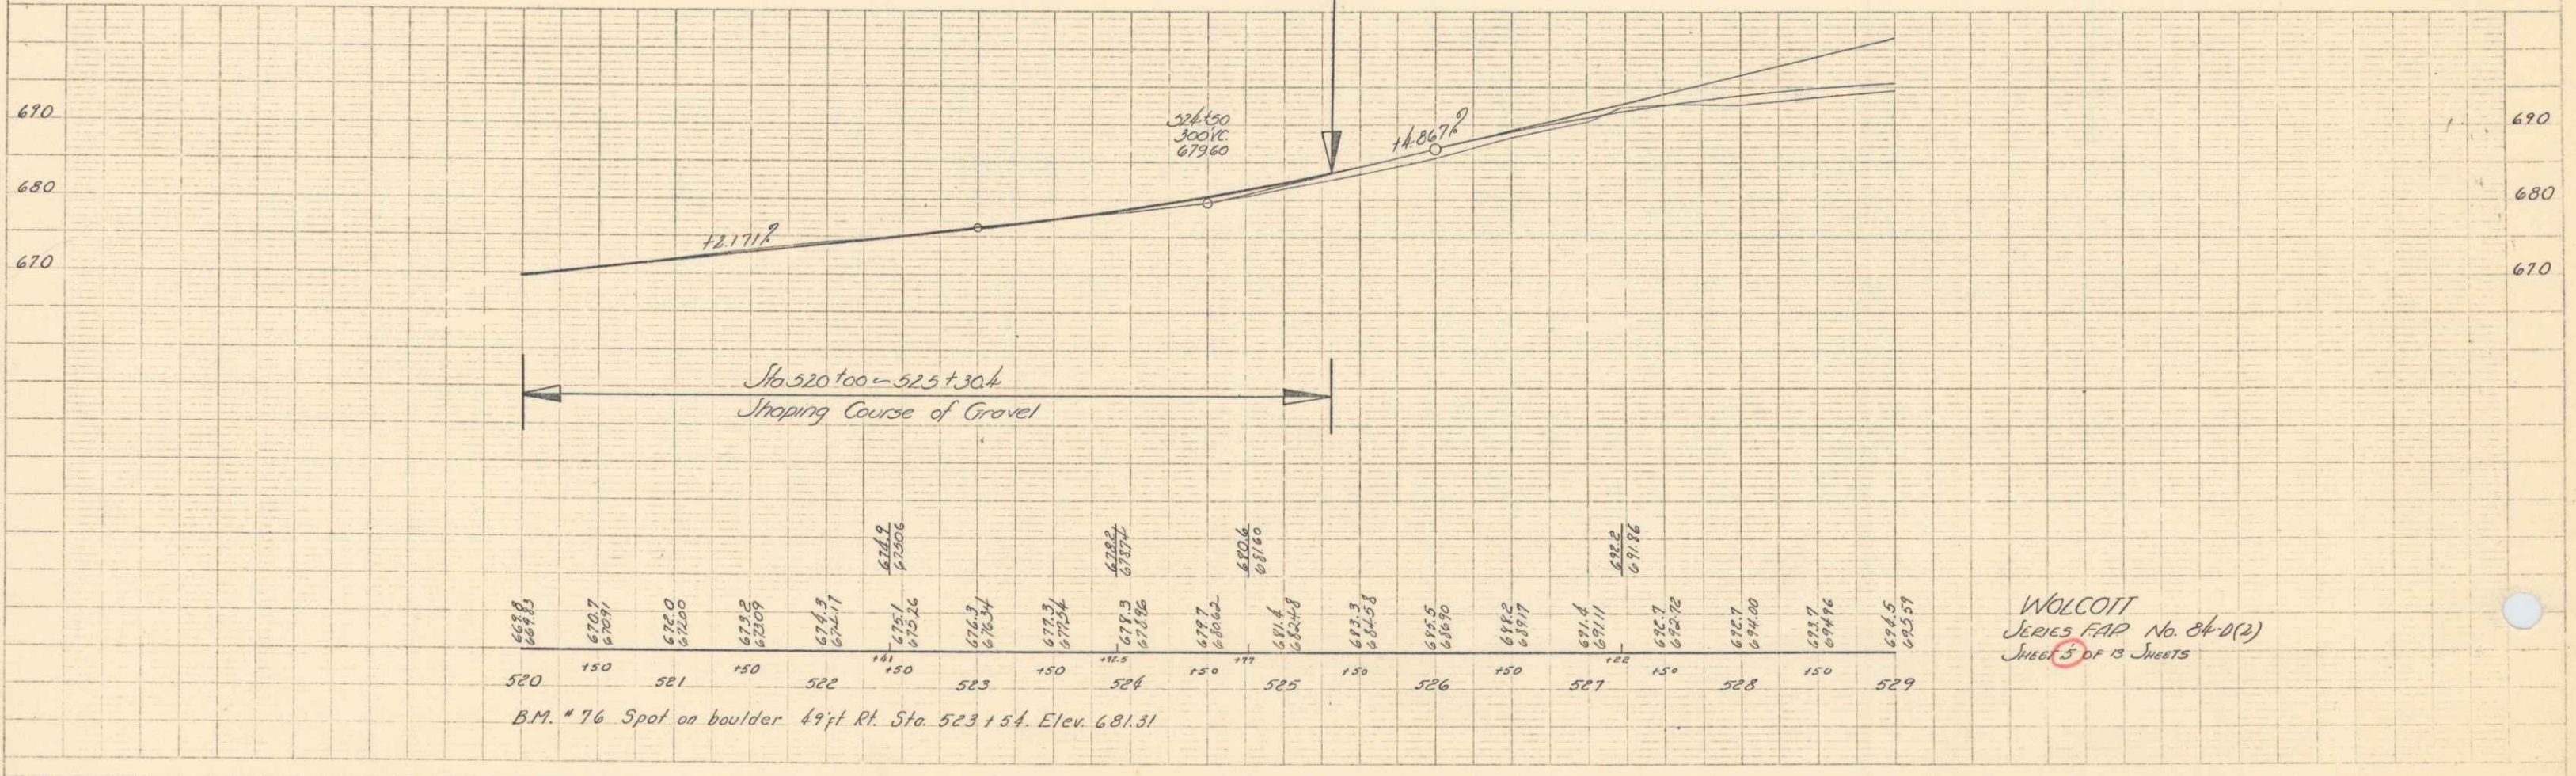

WOLCOTT
 SERIES FAP No. 64-D(2)
 SHEET 5 OF 13 SHEETS