



84(10) 1941 9 169

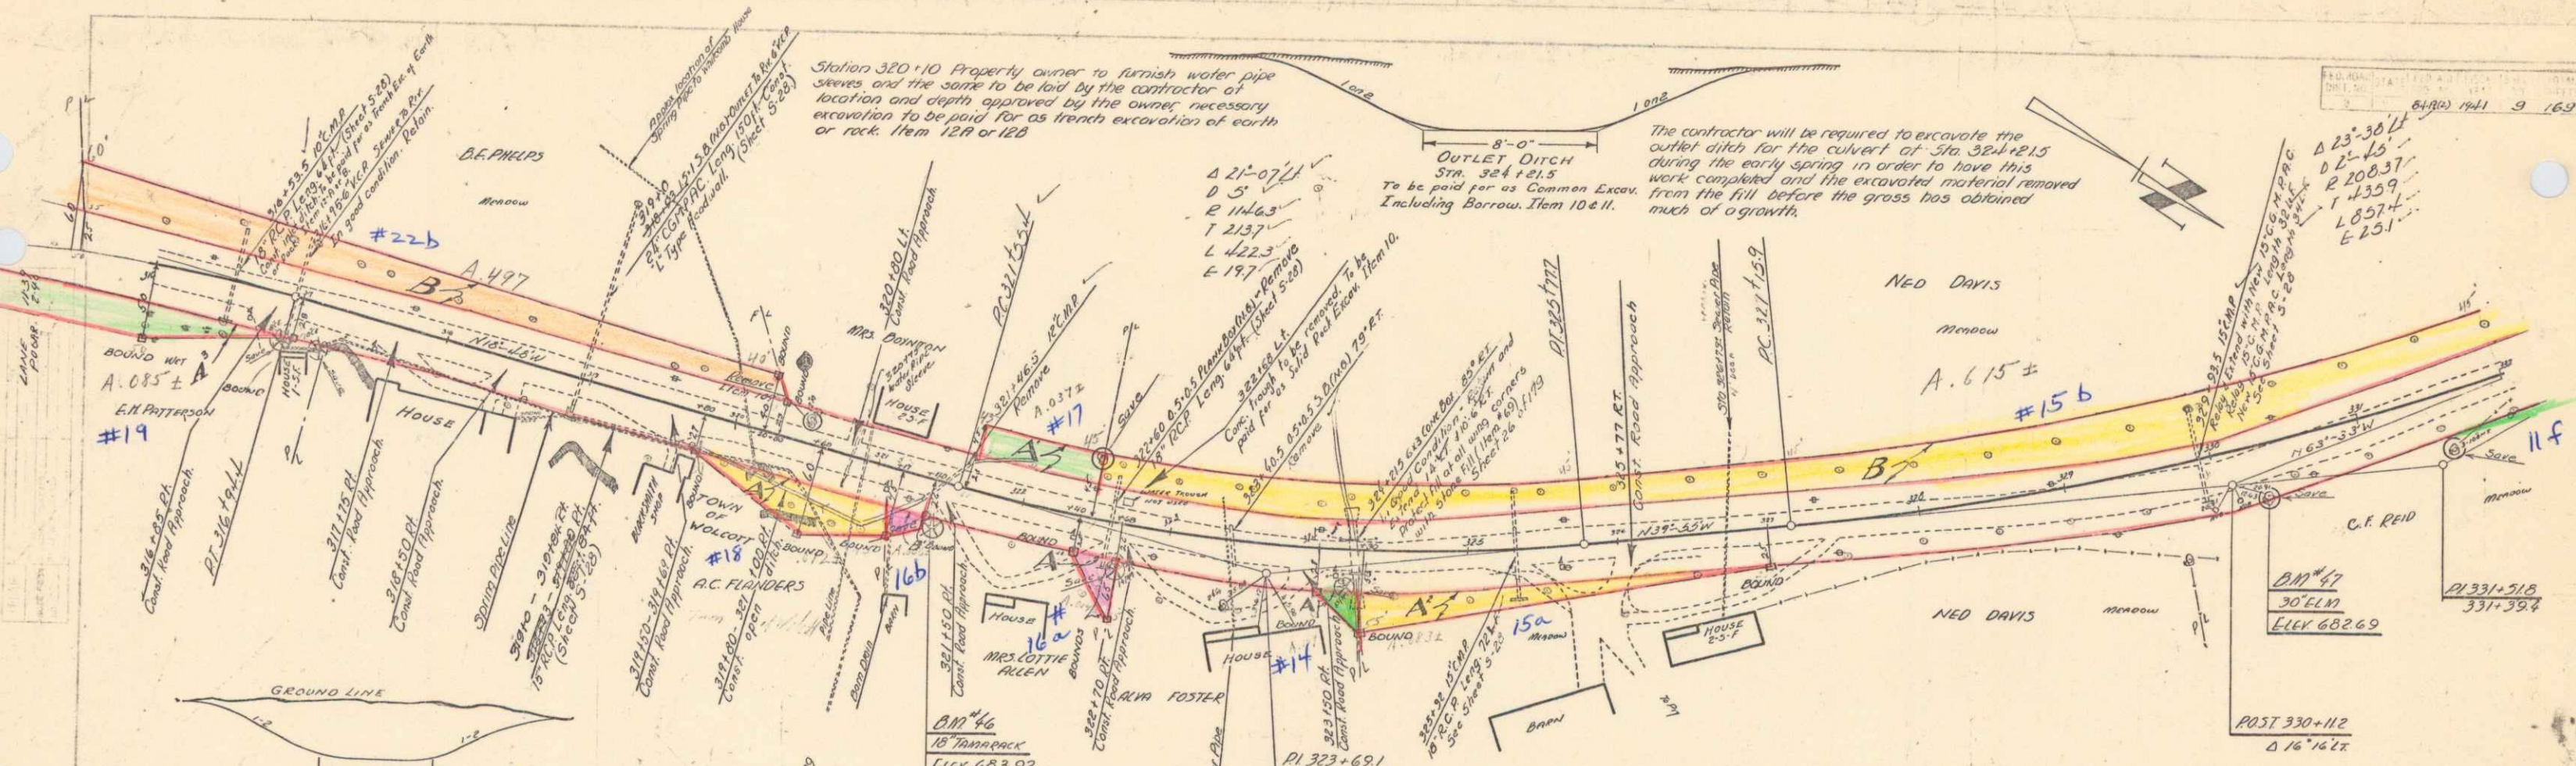

GROUND LINE  
319+00 - 321+00 RT  
Constructed Open Ditch  
Paid for as Subst. Road, Exc. Item 10  
or Common Exc. Incl. Borrow. Item 10

PARCEL	INSTRUMENT	DATE	GRANTOR	GRANTEE	RECORDED	REMARKS
B	W.D.O.E.	3-26-41	BURTON & DOROTHY PHELPS	ST. OF VT.	27 252-253	3-12-41
A	W.D.O.E.	3-26-41	TOWN OF WOLCOTT	ST. OF VT.	27 229-30	3-5-41
A'	W.D.O.E.	3-26-41	HATTIE BOYNTON	ST. OF VT.	27 229-30	3-12-41
A''	W.D.O.E.	3-26-41	LOTTIE ALLEN	ST. OF VT.	27 229-30	3-12-41
A'''	W.D.O.E.	3-26-41	ALVA & BESSIE FOSTER	ST. OF VT.	27 222-223	3-12-41
A''''	W.D.O.E.	3-26-41	NED & MADLINE DAVIS	ST. OF VT.	27 351-52	3-12-41
A'''''	W.D.O.E.	3-26-41	E.H. PHILIP PATTERSON	ST. OF VT.	27 200-201	3-12-41

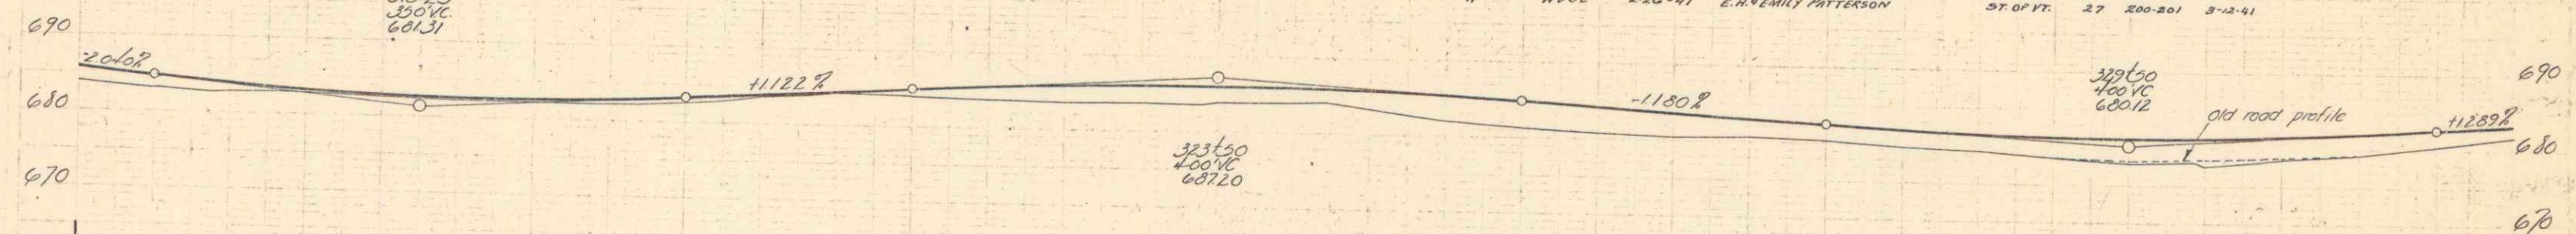

BM 46 SIR 18 Tamarack 31 PI Sta 321+46 El. 683.92  
BM 47 SIR 30 Elm 34 PI Sta 330+27 El. 682.69

WOLCOTT  
FAD 84-A(2)  
SERIES (A) R NO 844(2)  
Sheet 5 of 169