



PARCEL INTRUMENT	DATE	GRANTOR	GRANTEE	RECORDED	REMARKS
BC A	M.D.O.E COND	3-3-41 11-21-60	C.F. EVELYN REED ST. & L.C.R.R.	ST. OF V. 8391 ST. OF V. 27	PAGE 137E-41 151-7

PERMANENT STATE FLD. AID FISCAL SHEET TOTAL  
 84-A(1) 1941 12 169

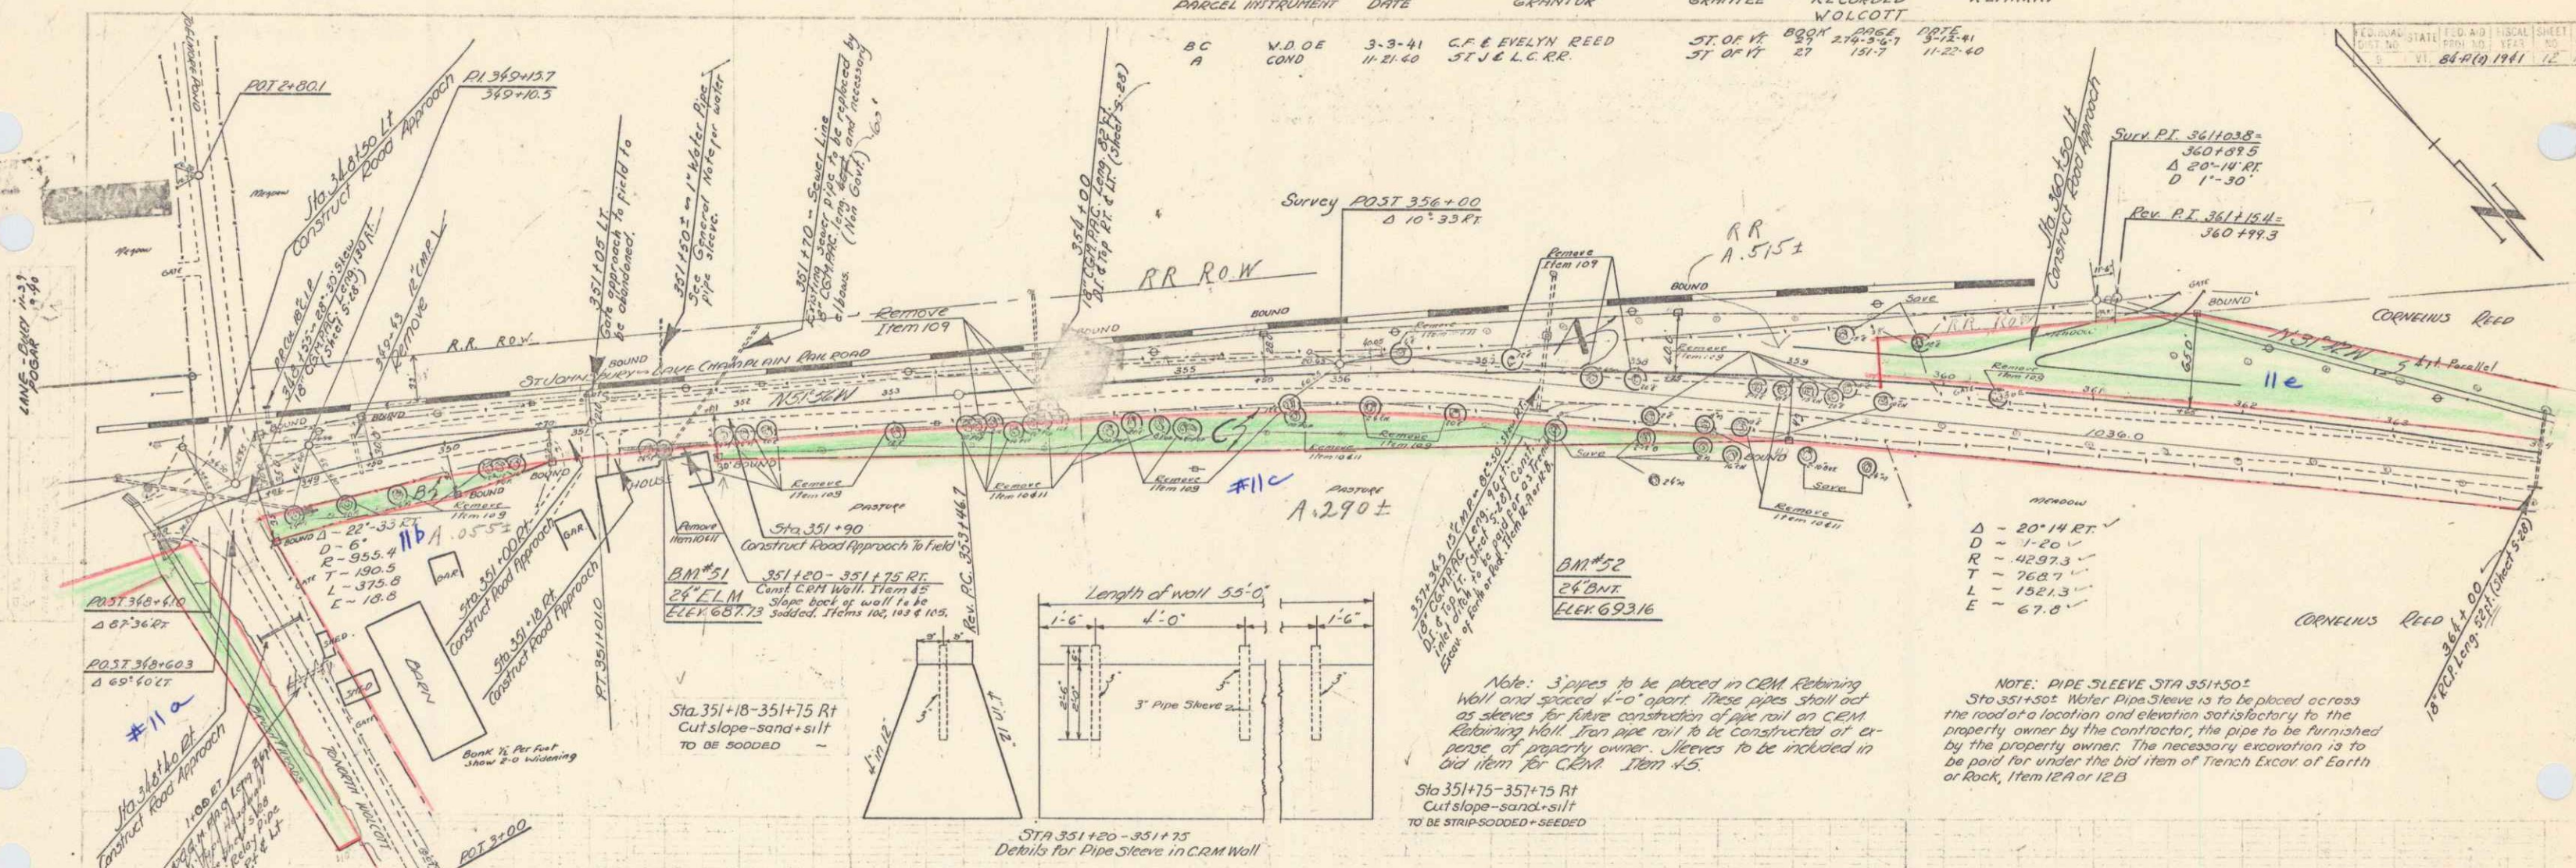

MONUMENT  
 Δ - 20'-14 RT ✓  
 D - 1'-20 ✓  
 R - 4297.3 ✓  
 T - 760.7 ✓  
 L - 1521.3 ✓  
 E - 67.0 ✓

NOTE: PIPE SLEEVE STA 351+50.5  
 Sta 351+50.5 Water Pipe Sleeve is to be placed across the road at a location and elevation satisfactory to the property owner by the contractor, the pipe to be furnished by the property owner. The necessary excavation is to be paid for under the bid item of Trench Excav. of Earth or Rock, Item 12A or 12B.

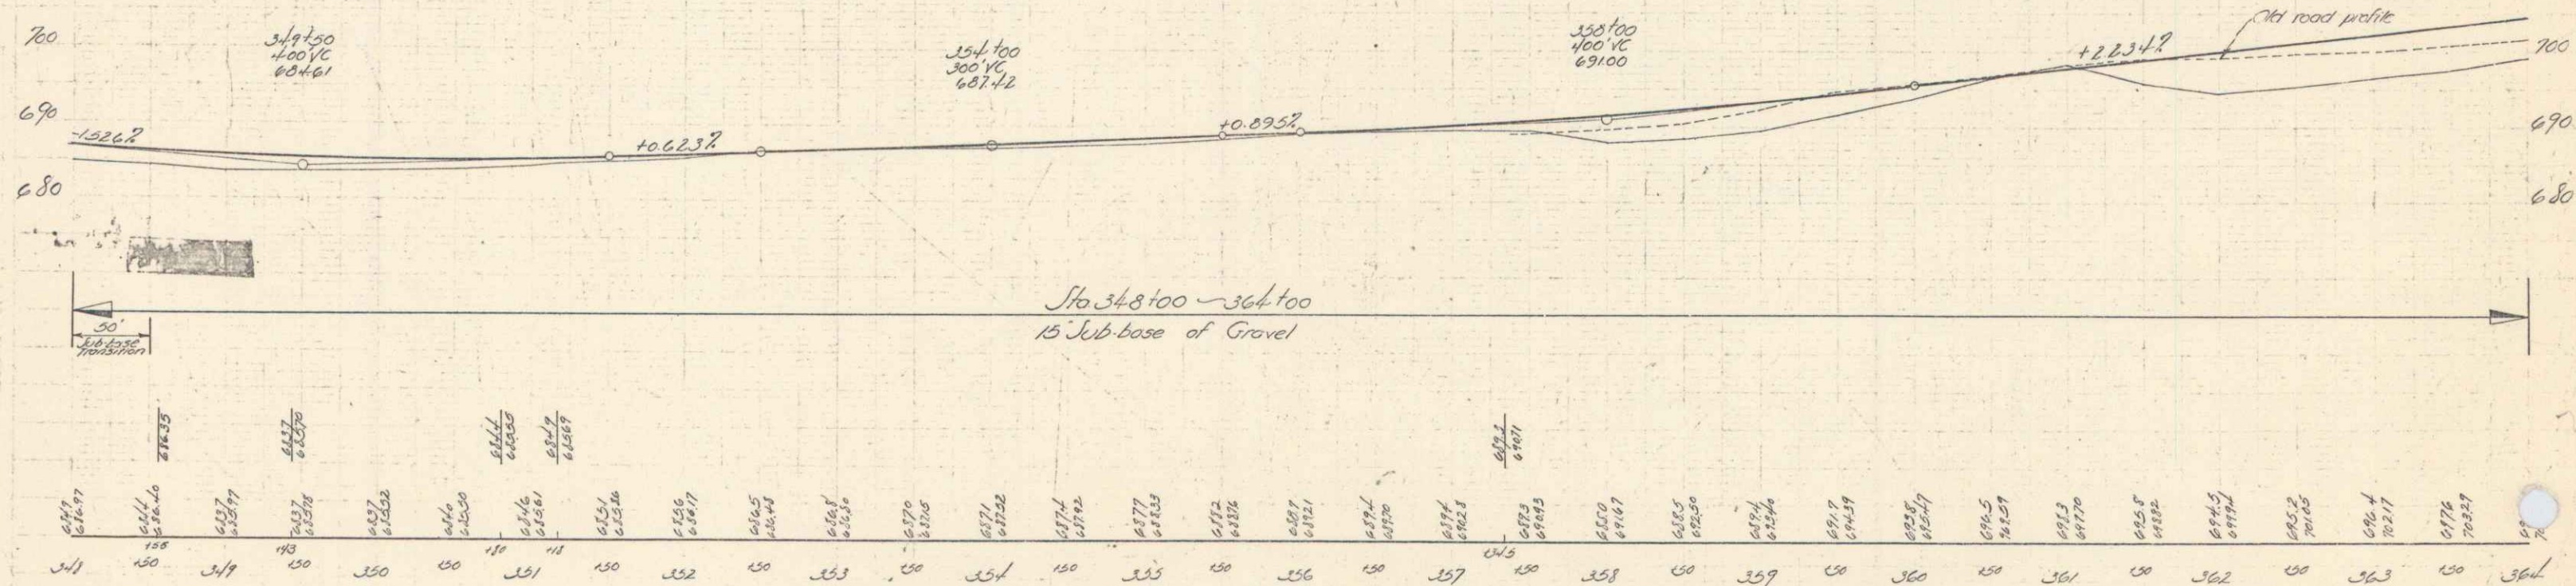

348	349	350	351	352	353	354	355	356	357	358	359	360	361	362	363	364
687.67	686.46	687.37	687.37	687.37	687.37	687.37	687.37	687.37	687.37	687.37	687.37	687.37	687.37	687.37	687.37	687.37

BM 51 SIR 24 Elm 17 Rt Sta 351+44 El 687.73  
 BM 52 SIR 24 Elm 40 Rt Sta 357+44 El 693.16

SERIES MAP No. 84-A(1) FILED  
 SHEET 12 OF 169