
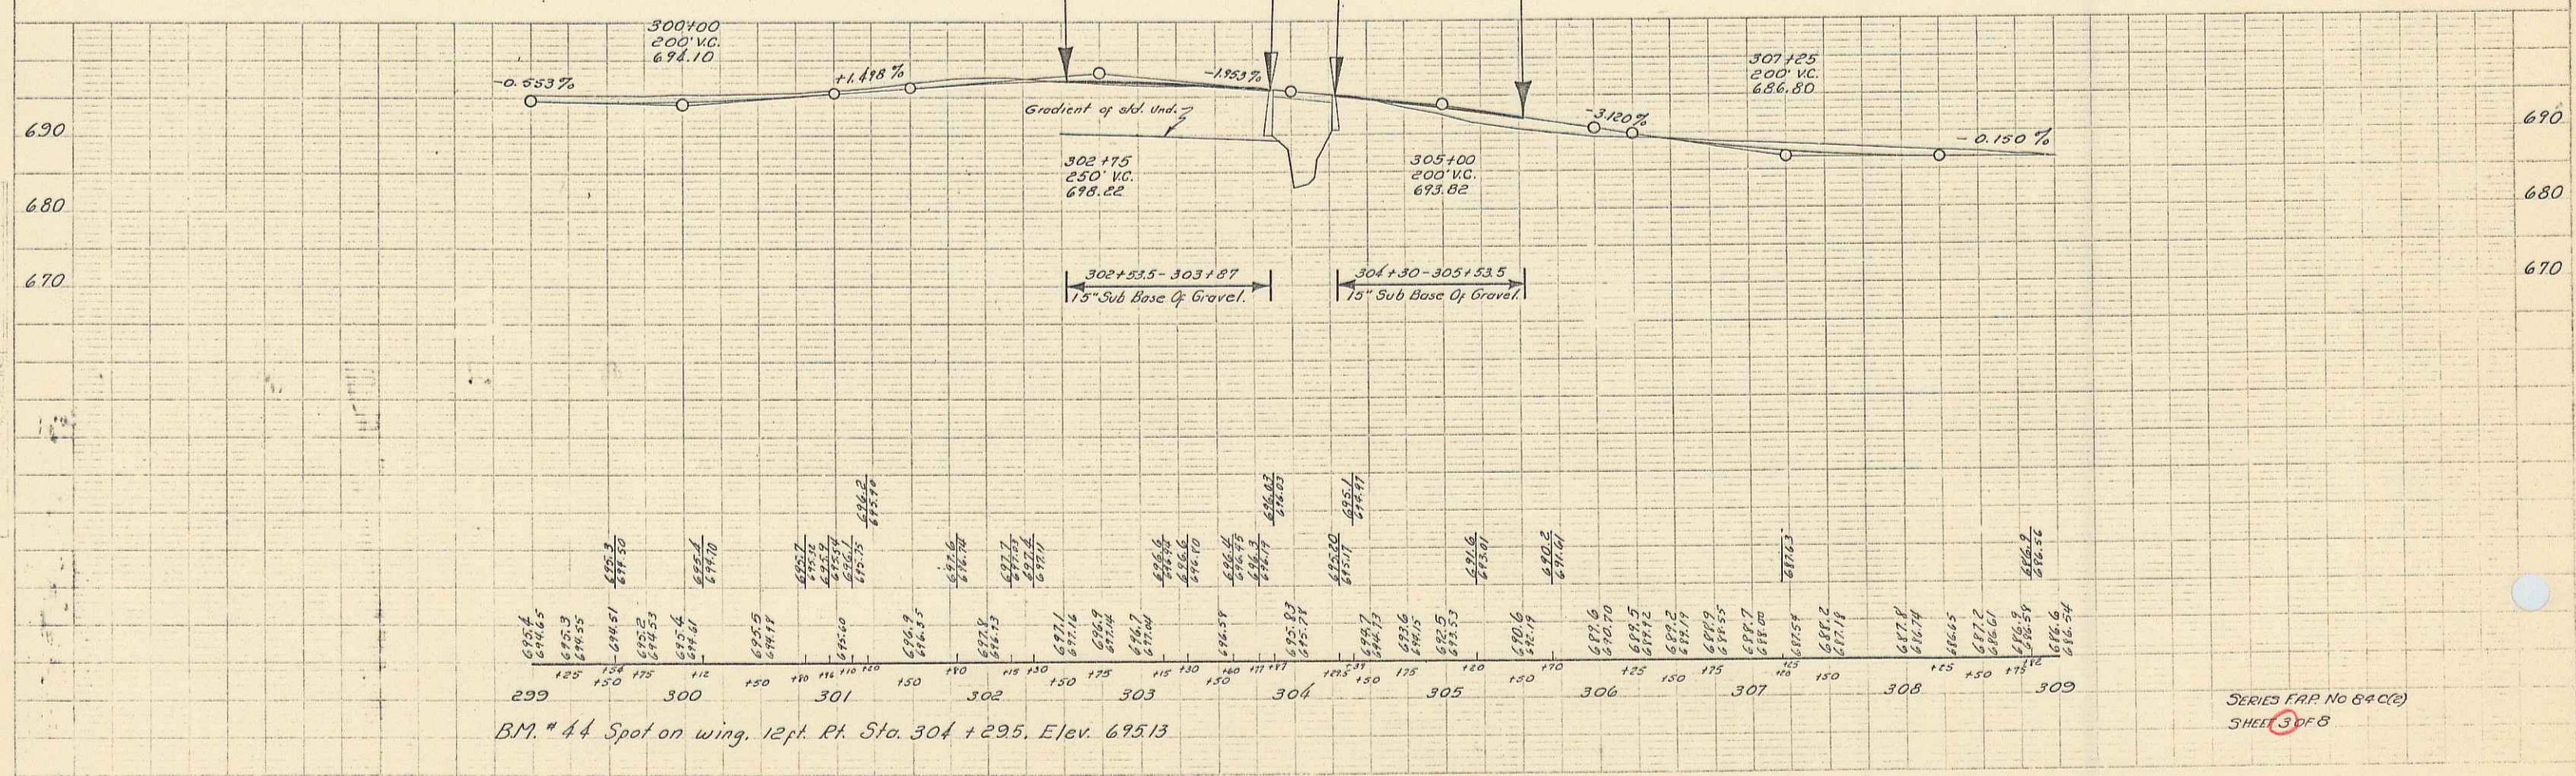


PLAN  
 DATE NOV 1941  
 DRAWN BY J. H. CHASE  
 CHECKED BY J. H. CHASE

1-40  
 5-40  
 5-40  
 5-40

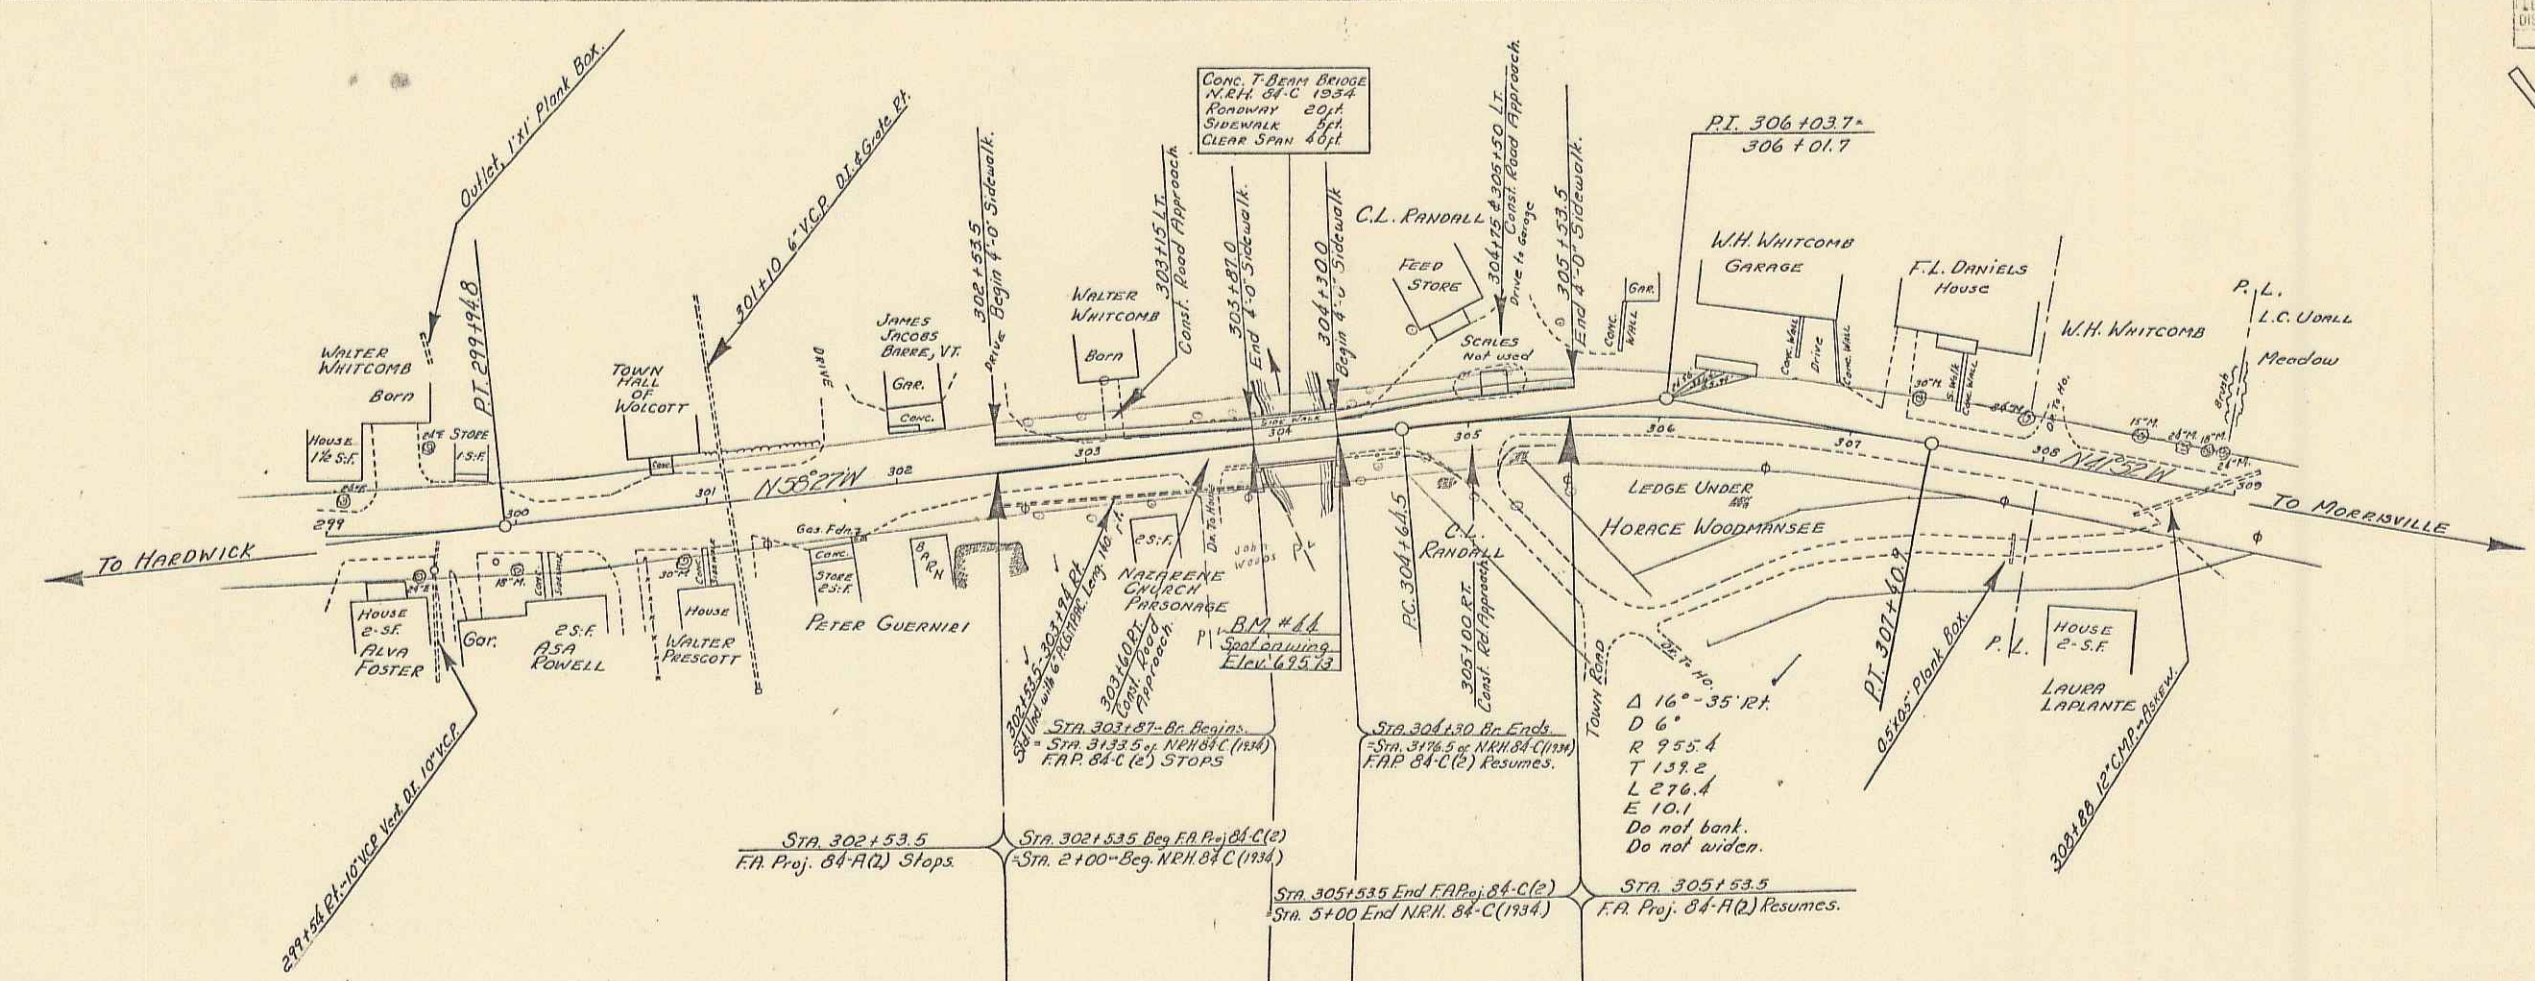

BM. # 44 Spot on wing, 12ft. Pt. Sta. 304 + 295, Elev. 695.13