

INDEX OF SHEETS

SHEET NO.	TITLE PAGE	
1	TYPICAL CROSS-SECTION OF IMPROVEMENT	(Grading, drainage, & base, with guard rail, and double foot cast of ref. loc. with pea stone seal. Item 212)
2	BANKING AND WIDENING TABLES	
3	PLAN AND PROFILE	
4-5	STD. STRUCTURE SHEET, 5-28,	PIPE CULVERTS.
6	5-30,	GUARD RAIL.
7	5-30A,	BOUNDARY MARKERS.
8	5-40,	BARBICOBES, SIGNS, & LIGHTS.
9	5-41,	ROUNDING OF SLOPES.
10		
11-22	CROSS SECTION SHEETS.	

STD. STRUCTURE SHEETS APPROVED  
BY THE CHIEF ENGINEER:  
5-28, JULY 11, 1933.  
5-30, AUG. 15, 1934.

(To Be Returned to R.O.W. Division)  
DOWN OF UT 15  
PERMIT  
RIGHT-OF-WAY DIVISION

STATE OF VERMONT  
STATE HIGHWAY DEPARTMENT


PLAN AND PROFILE OF PROPOSED  
STATE HIGHWAY

STATE AID PROJECT


TOWN OF WOLCOTT *Pin# 000283*

HARDWICK - MORRISVILLE ROAD

BEGINNING AT A POINT ON ROUTE 15; 0.27 MI.  
SOUTH-EASTERLY FROM THE ST. JOHNSBURY &  
LAKE CHAMPLAIN RAILROAD UNDERPASS AND  
EXTENDING NORTH-WESTERLY 0.511 MILES.  
LENGTH OF PROJECT, 2569.4 FT. = 0.486 MI.

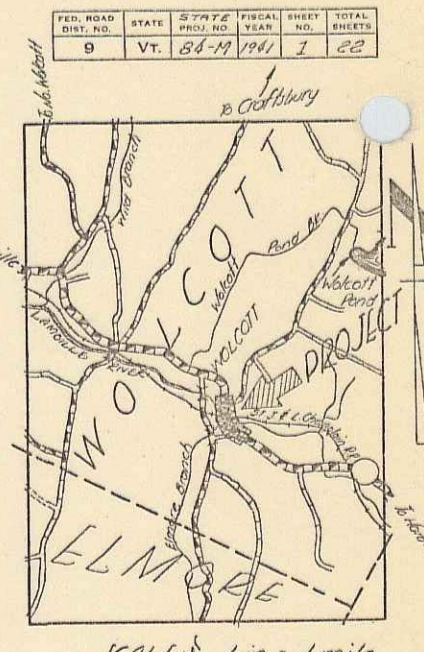

RECORD PLANS  
By  
G. A. Pierce

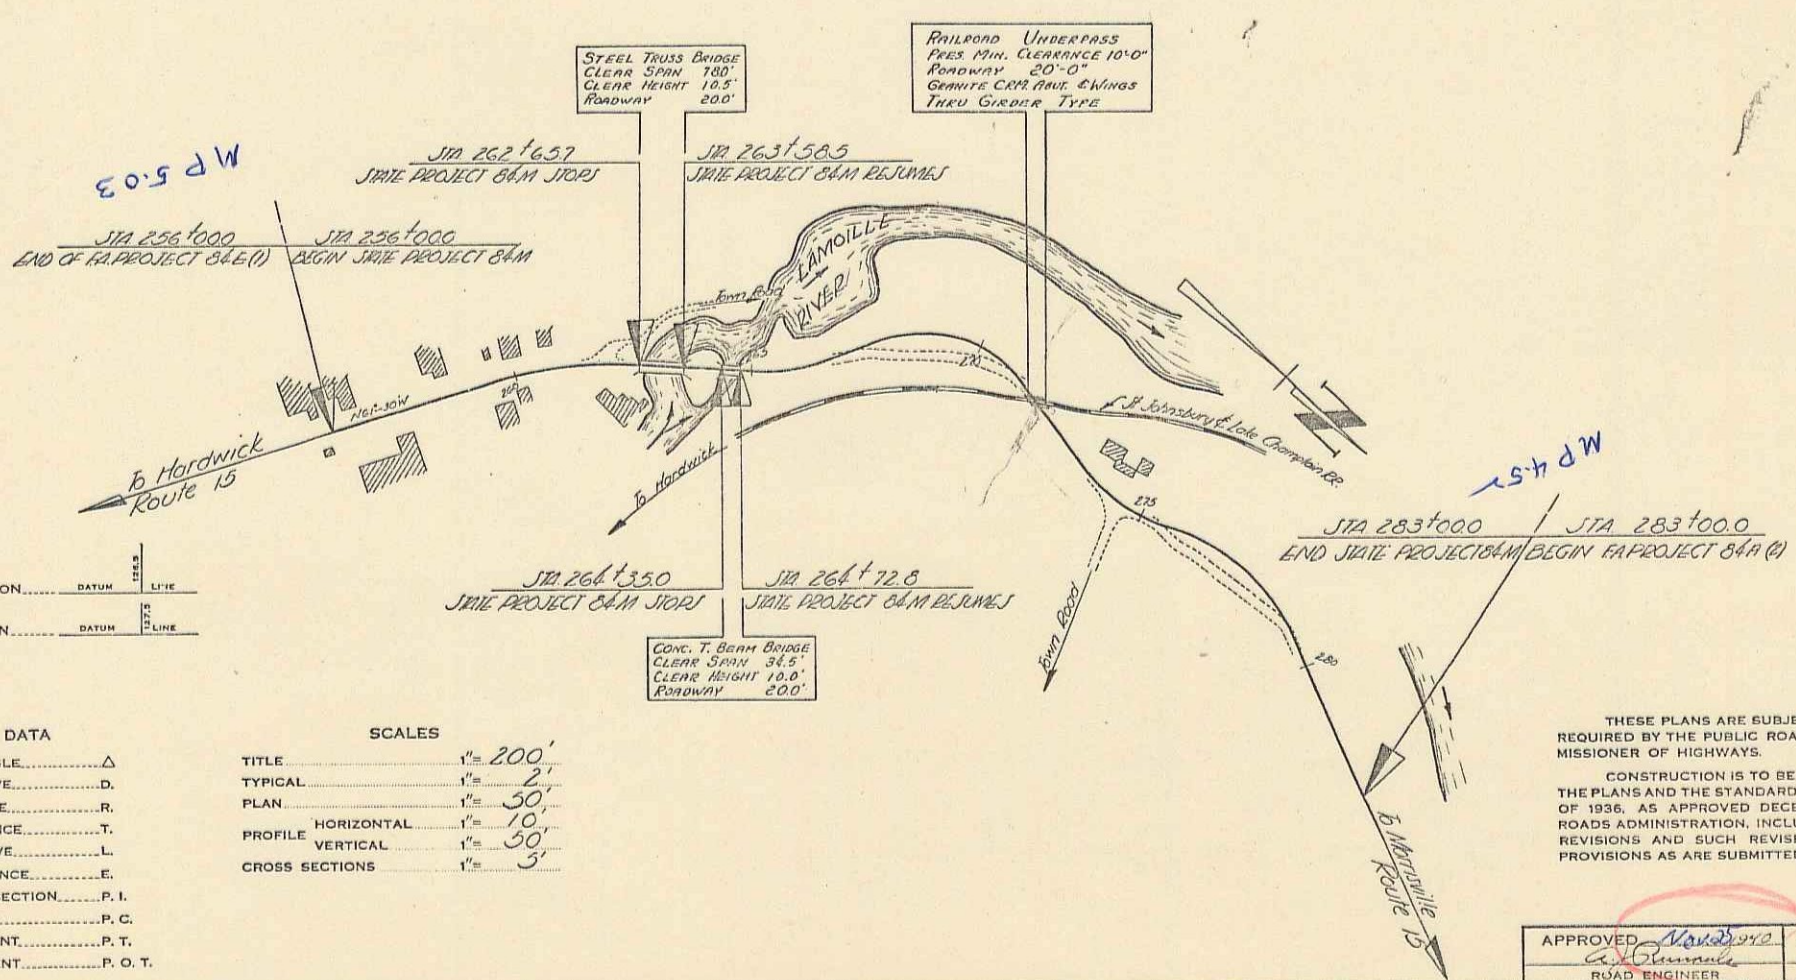

COUNTY LINE	.....
TOWN LINE	.....
FENCE LINE	.....
STONE WALL	.....
UNFENCED PROPERTY	.....
GUARD RAIL	.....
TRAVELED WAY	.....
RAILROAD	.....
RETAINING WALL	.....
CENTER LINE	.....
SURVEY LINE	.....
CULVERT	.....
DROP INLET	.....
TROLLEY POLE	.....
POWER POLE	.....
TELEPHONE POLE	.....
TREES	.....
HEDGE	.....

GROUND ELEVATION	DATUM	UNIT
GRADE ELEVATION	DATUM	UNIT

TITLE	1" = 200'
TYPICAL	1" = 2'
PLAN	1" = 50'
PROFILE HORIZONTAL	1" = 10'
PROFILE VERTICAL	1" = 30'
CROSS SECTIONS	1" = 3'

Record Plans  
Wolcott ST 84 M  
Contractor - Lambert & George 1941

APPROVED: *[Signature]*  
COMMISSIONER OF HIGHWAYS  
SUBMITTED BY ORDER OF THE STATE HIGHWAY BOARD

Project No. ST 84 M  
Rte. VT 15

RECOMMENDED FOR APPROVAL  
DISTRICT ENGINEER  
PUBLIC ROADS ADMINISTRATION  
FEDERAL WORKS AGENCY  
APPROVED  
DISTRICT ENGINEER  
PUBLIC ROADS ADMINISTRATION  
FEDERAL WORKS AGENCY

THESE PLANS ARE SUBJECT TO SUCH REVISIONS AS MAY BE REQUIRED BY THE PUBLIC ROADS ADMINISTRATION OR THE COMMISSIONER OF HIGHWAYS.  
CONSTRUCTION IS TO BE CARRIED ON IN ACCORDANCE WITH THE PLANS AND THE STANDARD ROAD AND BRIDGE SPECIFICATIONS OF 1936, AS APPROVED DECEMBER 29TH, 1936 BY THE PUBLIC ROADS ADMINISTRATION, INCLUDING ALL SUBSEQUENT APPROVED REVISIONS AND SUCH REVISED SPECIFICATIONS AND SPECIAL PROVISIONS AS ARE SUBMITTED WITH THE PLANS.

APPROVED *[Signature]* ROAD ENGINEER  
APPROVED *[Signature]* DISTRICT HIGHWAY COMMISSIONER  
SERIES ST. No. 84 M FILED  
SHEET 1 OF 22