


Sta 256+33 Property owner to furnish water pipe sleeves and the same to be laid by the contractor at location and depth approved by the owner. Necessary excavation to be paid for as trench excavation.

Station 258+00 to Station 259+00 Left  
 The contractor will remove stone posts in front of house and pile the same outside of the right of way and in a location acceptable to the property owner. Any posts broken by the contractor due to handling or hauling shall be replaced at the contractor's expense.

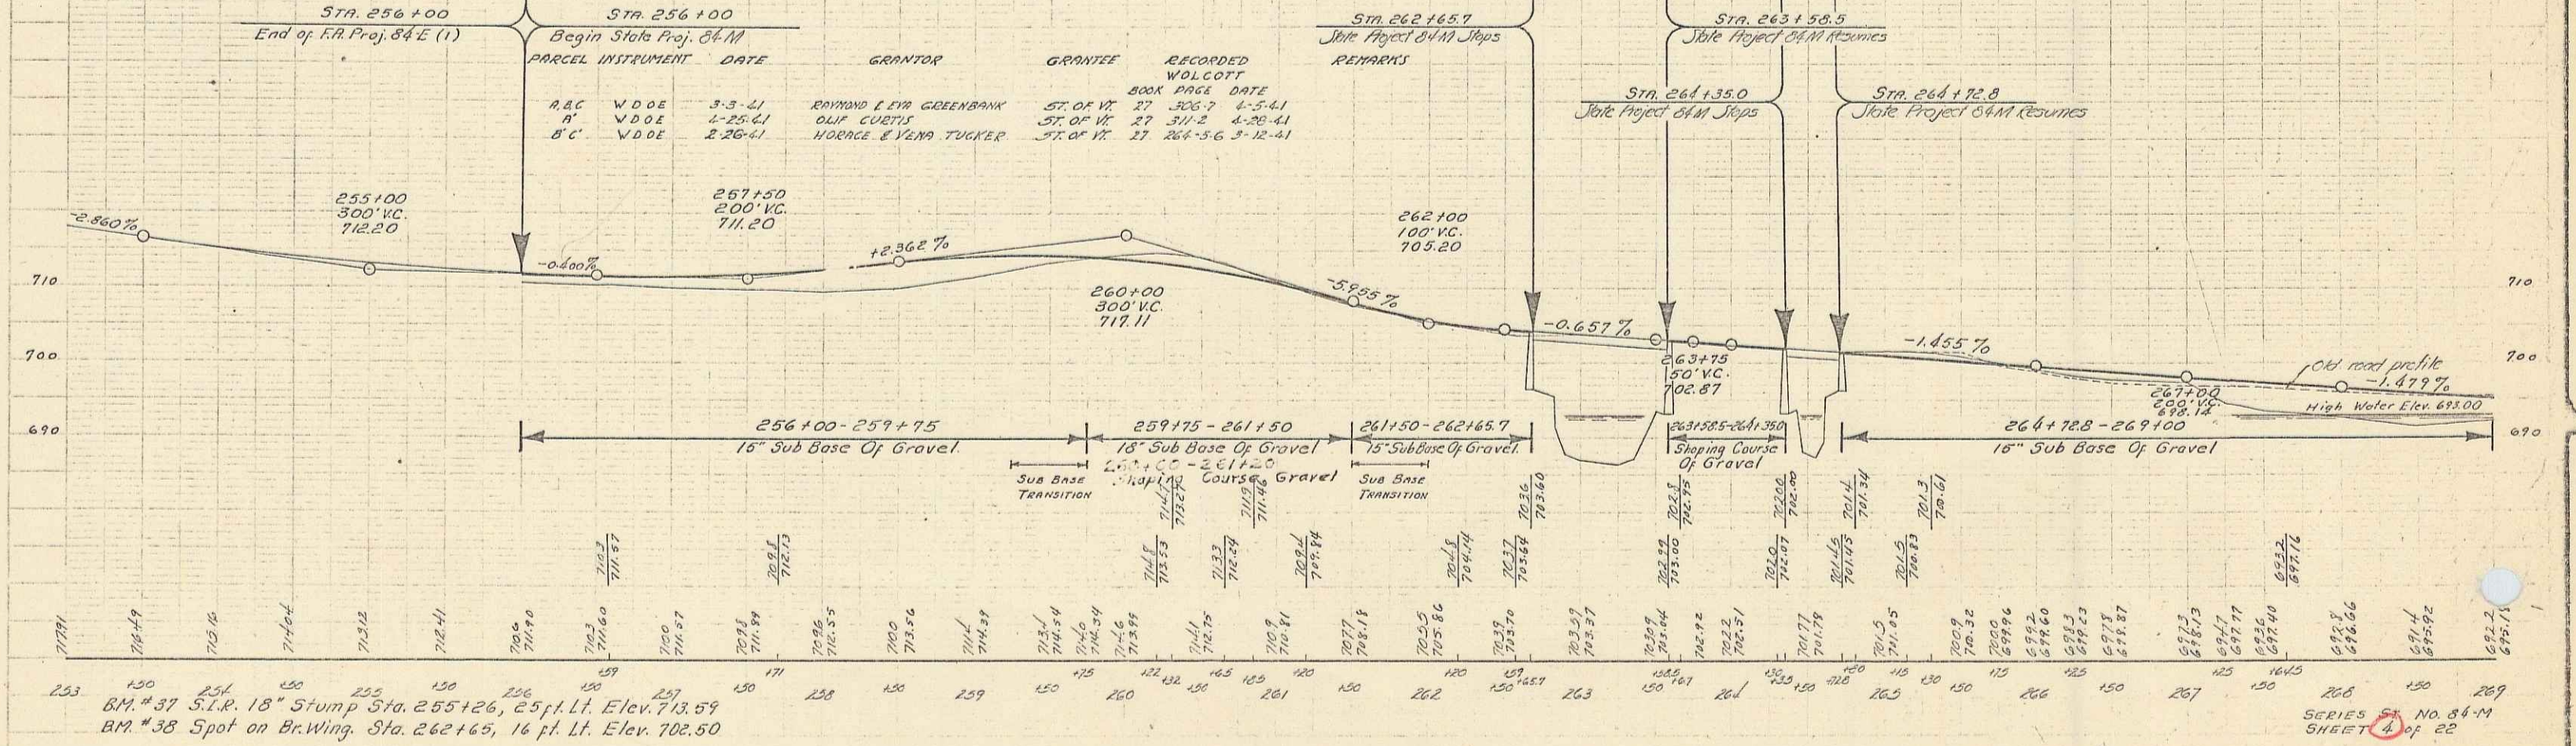

253 150 254 150 255 150 256 150 257 150 258 150 259 150 260 150 261 150 262 150 263 150 264 150 265 150 266 150 267 150 268 150 269

BM #37 S.I.R. 18" Stump Sta. 255+26, 25 ft. Lt. Elev. 713.59  
 BM #38 Spot on Br. Wing. Sta. 262+65, 16 ft. Lt. Elev. 702.50

SERIES NO. 84-M  
 SHEET 4 of 22