


PLAN
 PROJECT: [unclear]
 DRAWN BY: [unclear]
 CHECKED BY: [unclear]

ELEVATION
 120
 110
 100
 90

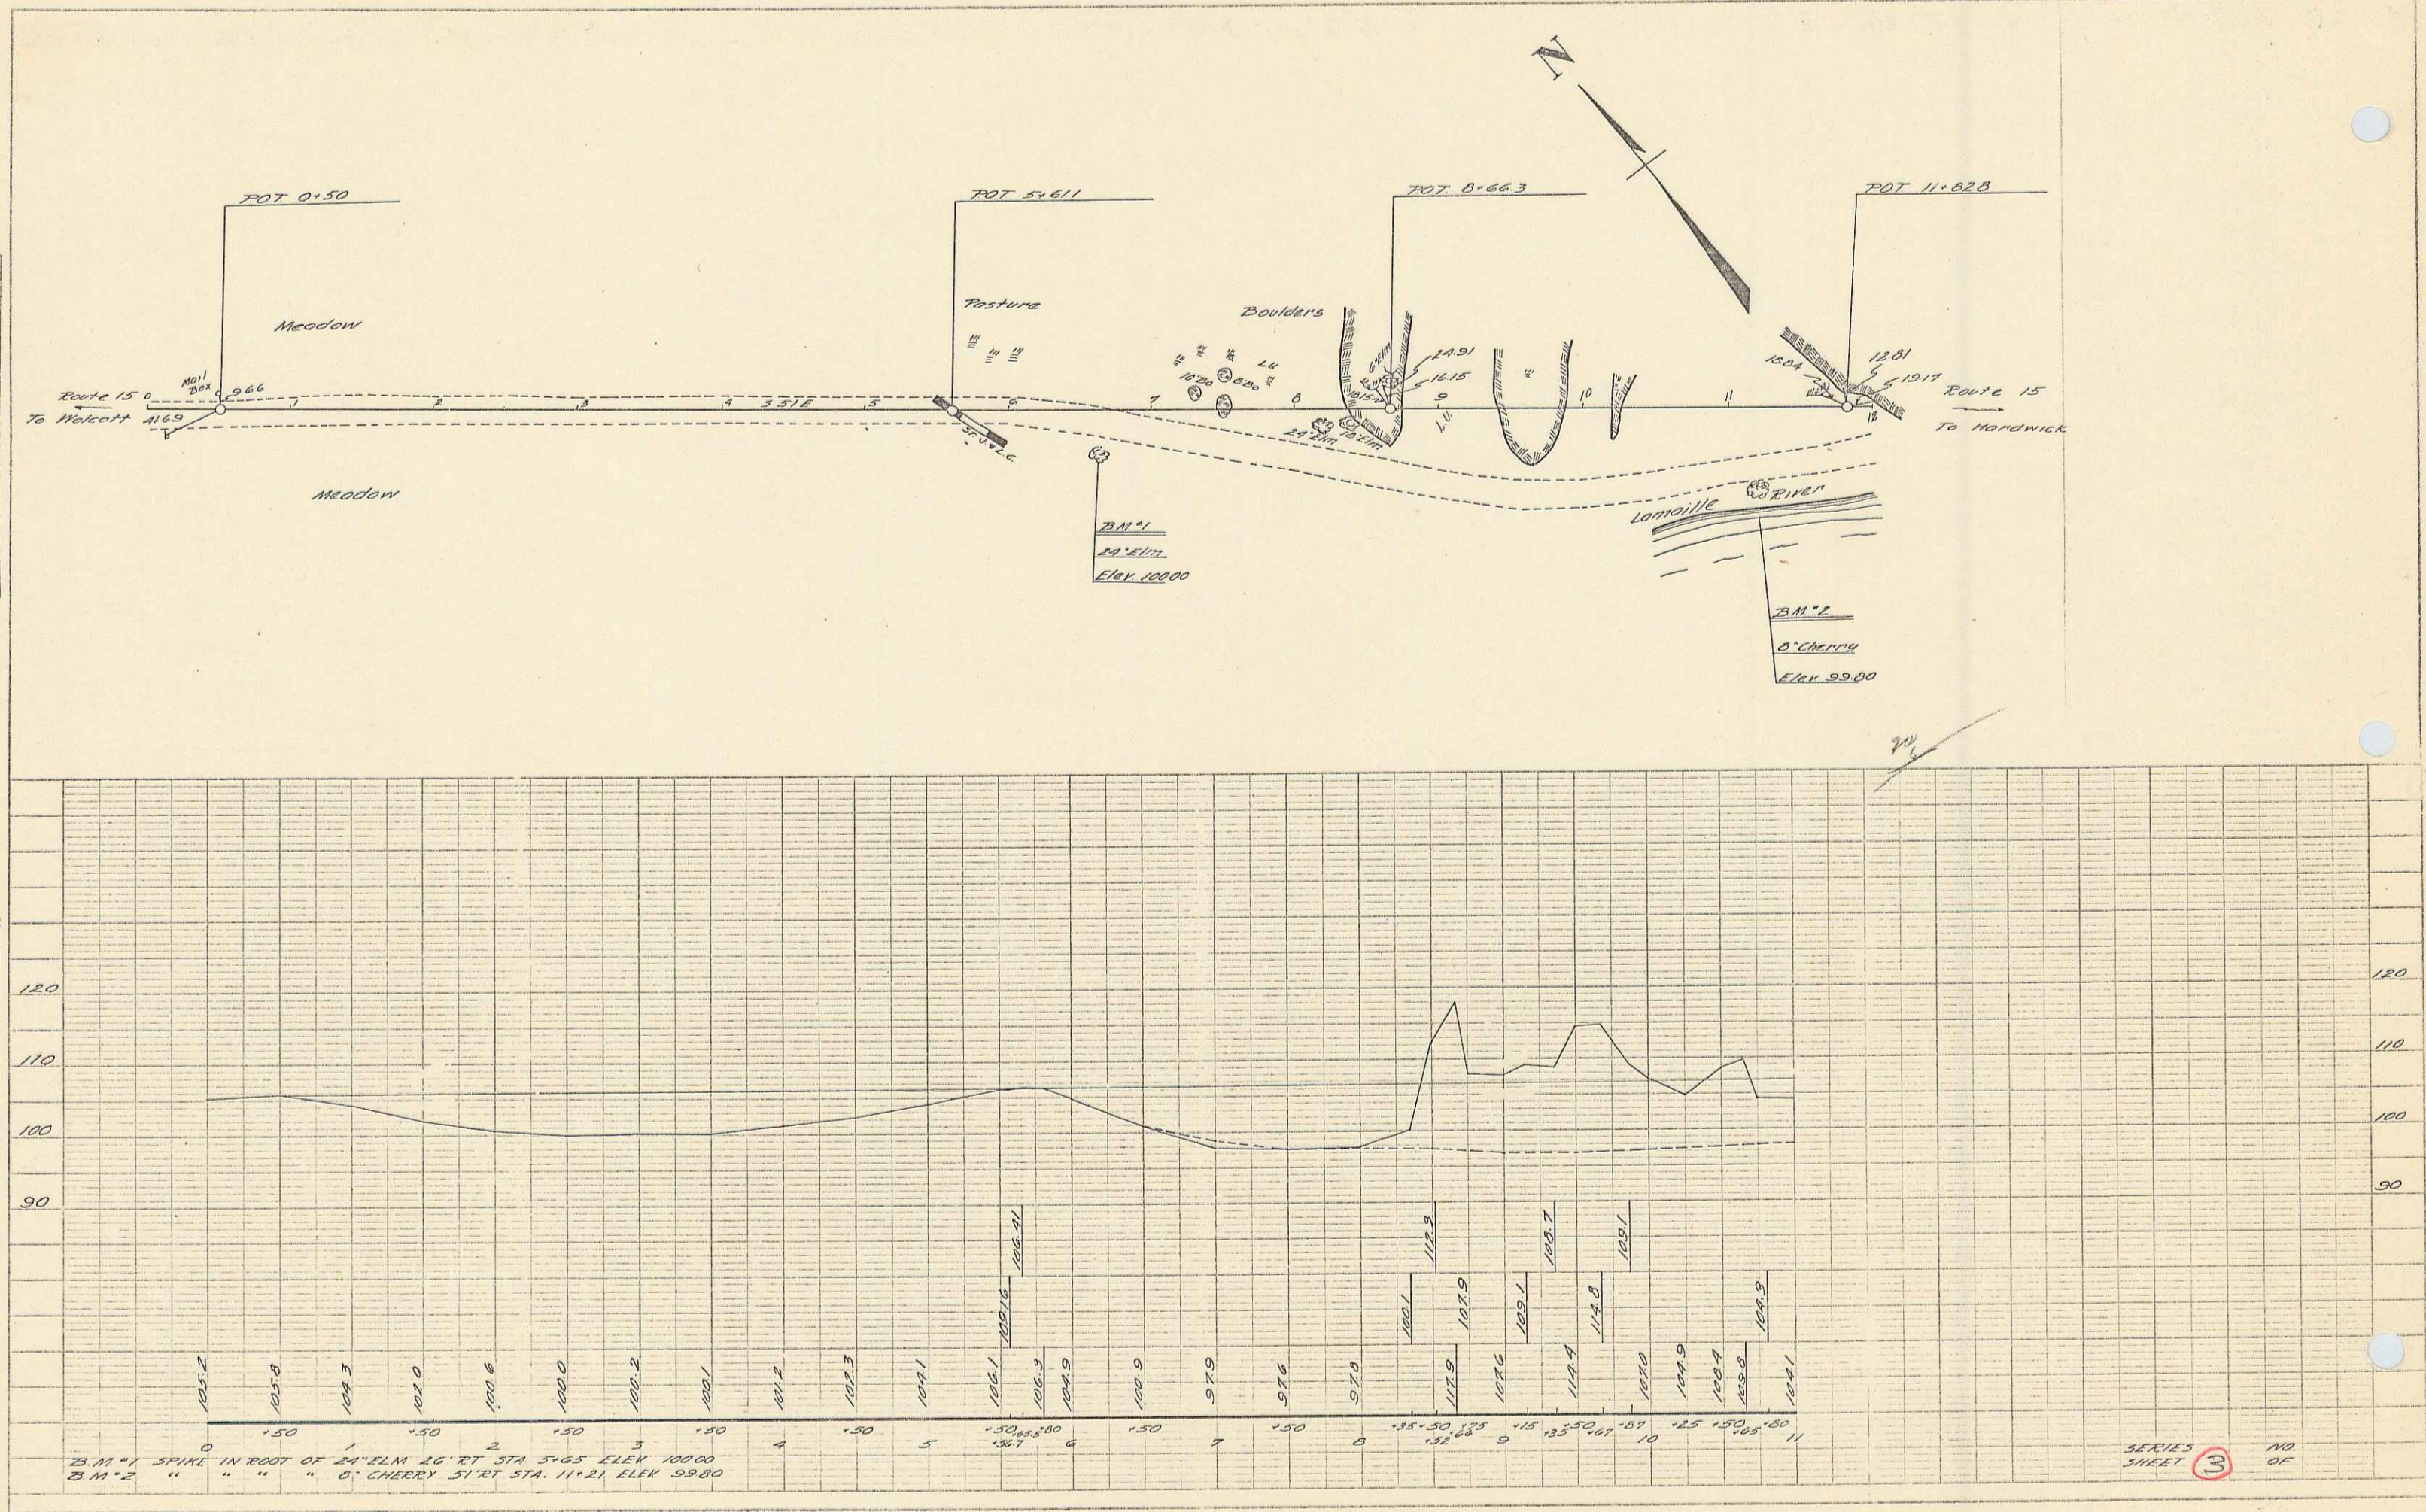

SERIES SHEET 3 NO OF