



NOTE: STA 73+00 - 75+00 LL, STA 76+00 - 76+25 LL, STA 79+75 - 83+00 LL. Embankments as shown on the cross sections to be made from solid rock excavation encountered on the project between Sta 73+00 and 83+00. This work will be paid for under the item of solid rock excavation, item 10, and also under the item of stone fill, item 69, and the embankments shall be constructed in accordance with item 69.

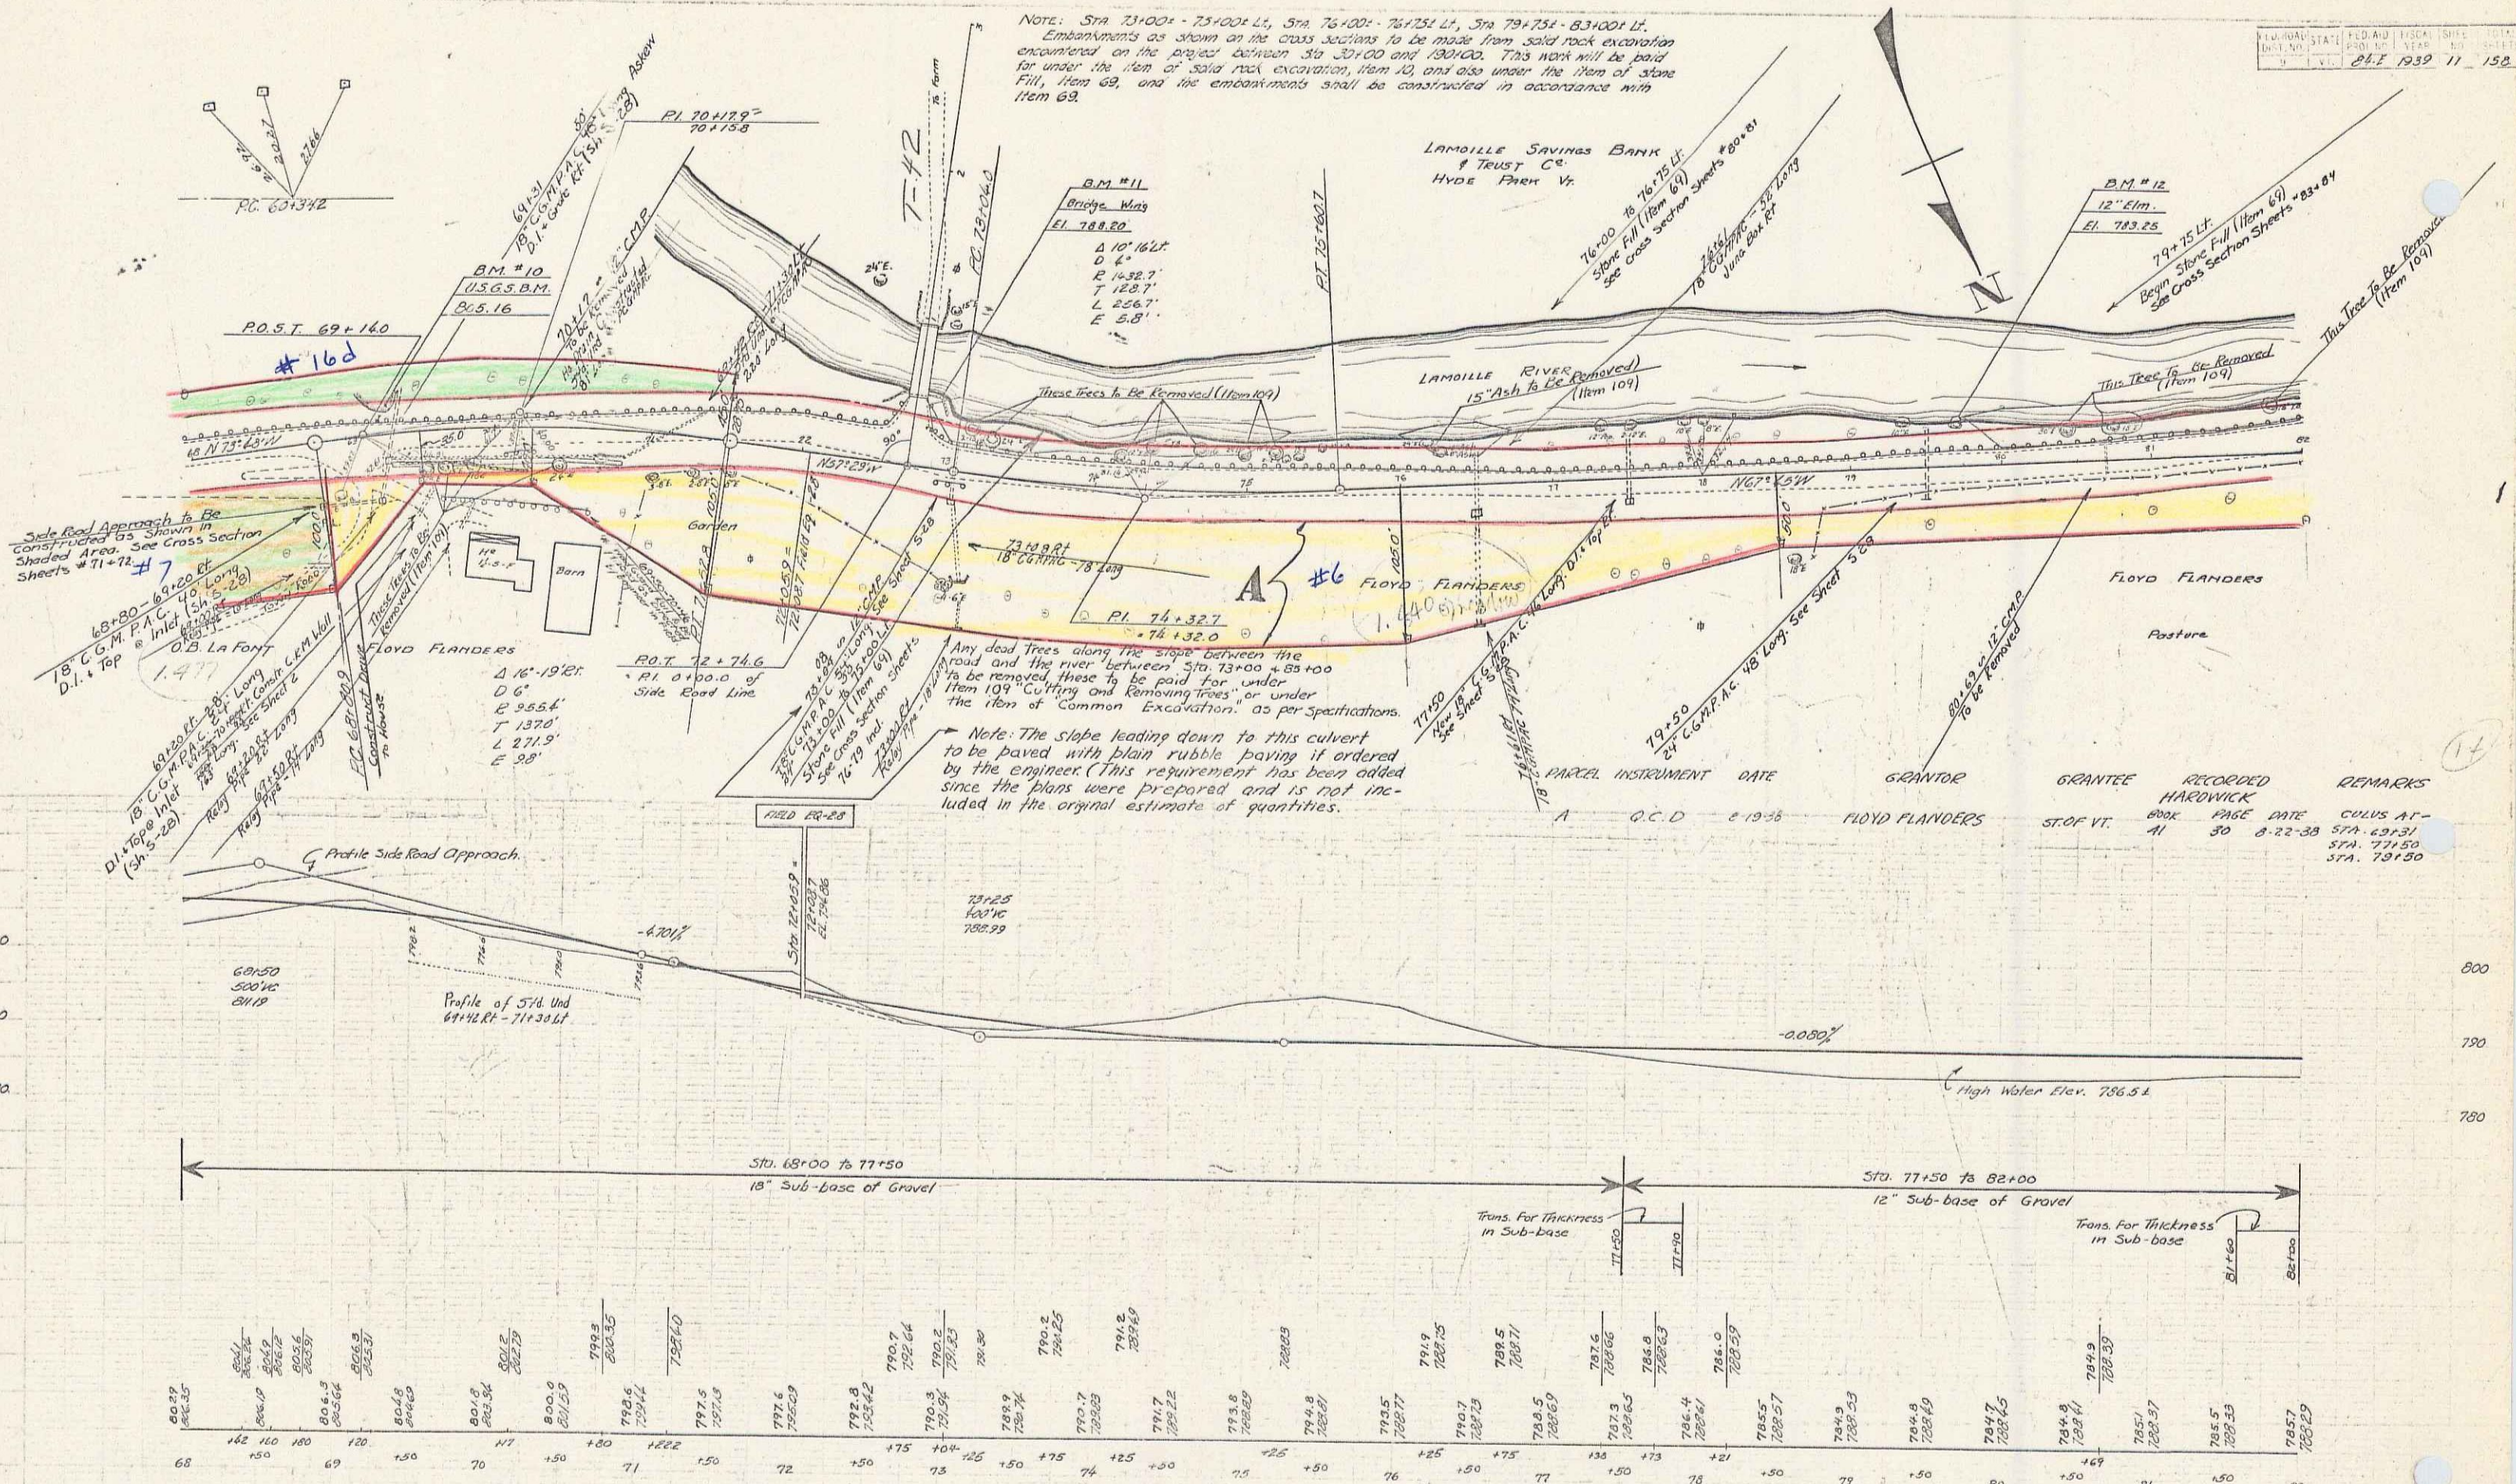

Any dead trees along the slope between the road and the river between Sta. 73+00 + 83+00 to be removed, these to be paid for under item 109 "Cutting and Removing Trees", or under the item of "Common Excavation", as per specifications.

Note: The slope leading down to this culvert to be paved with plain rubble paving if ordered by the engineer. (This requirement has been added since the plans were prepared and is not included in the original estimate of quantities.)

GRANTOR	GRANTEE	RECORDED HARDWARE	REMARKS
A. G.C.D.	FLOYD FLANDERS	ST. OF VT. 41	CULV. AT STA. 77+50 STA. 79+50 STA. 79+50

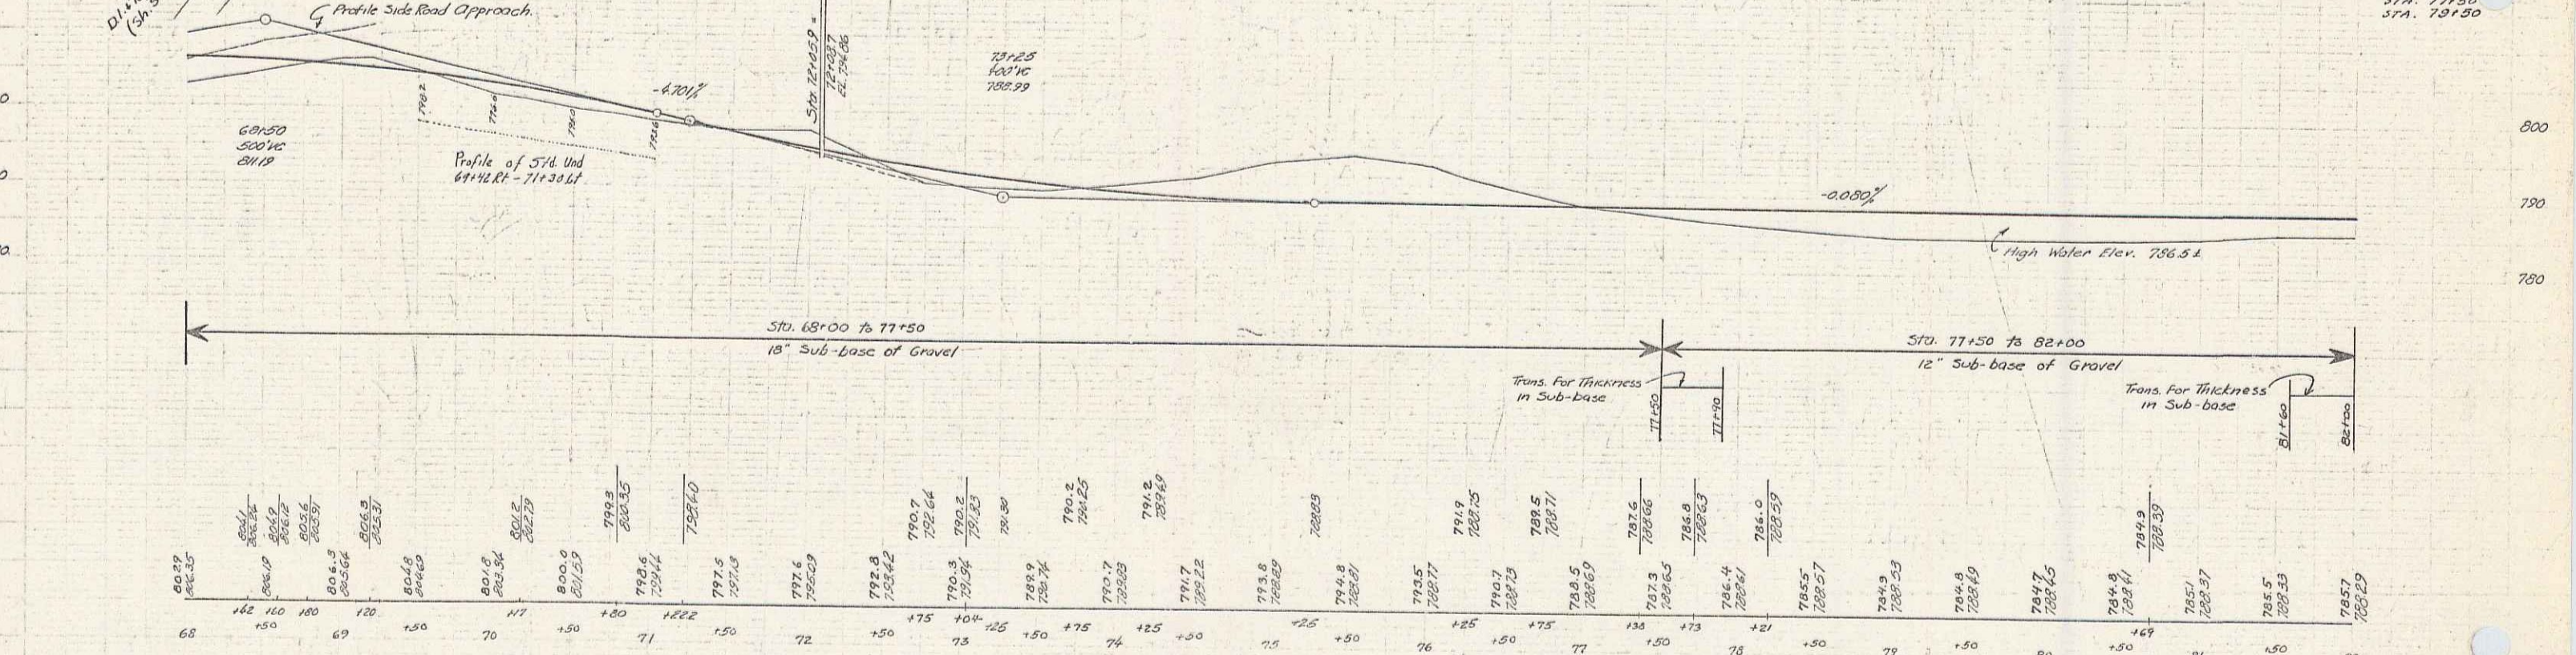

B.M. #10 U.S.G.S. B.M. - ME 1428 - Orange Disc in bridge 10' S. of Sta. 69+32 Elev. 805.16
 B.M. #11 Spot on bridge wing 40' N. Sta. 72+86 Elev. 798.20
 B.M. #12 Spike in trunk 12' Elm 27' N. Sta. 79+64 Elev. 793.25

Northwest-Isabel Road 15 Series 111 No. 81 E Sheet 11 of 152

Line Section 6300 to 6309
 1. 6300
 2. 6301
 3. 6302
 810. 7109
 811. 7