


PARCEL INSTRUMENT	DATE	GRANTOR	GRANTEE	RECORDED HARDWICK
A	Q.C.D.	9-19-38	LAMOILLE CO. SAV. BANK & TR. Co.	ST. OF VT. BOOK 24 PAGE 193 DATE 9-26-38
A-B-C-D	Q.C.D.	9-19-38	LAMOILLE CO. SAV. BANK & TR. Co.	ST. OF VT. BOOK 24 PAGE 193 DATE 9-26-38

158 Hardwick-Walpole Route 15  
Series FRP No. 84-E  
Sheet 16 of 158

158 Hardwick-Walpole Route 15  
 Series FRP No. 84-E  
 Sheet 16 of 158  
 158 Hardwick-Walpole Route 15  
 Series FRP No. 84-E  
 Sheet 16 of 158


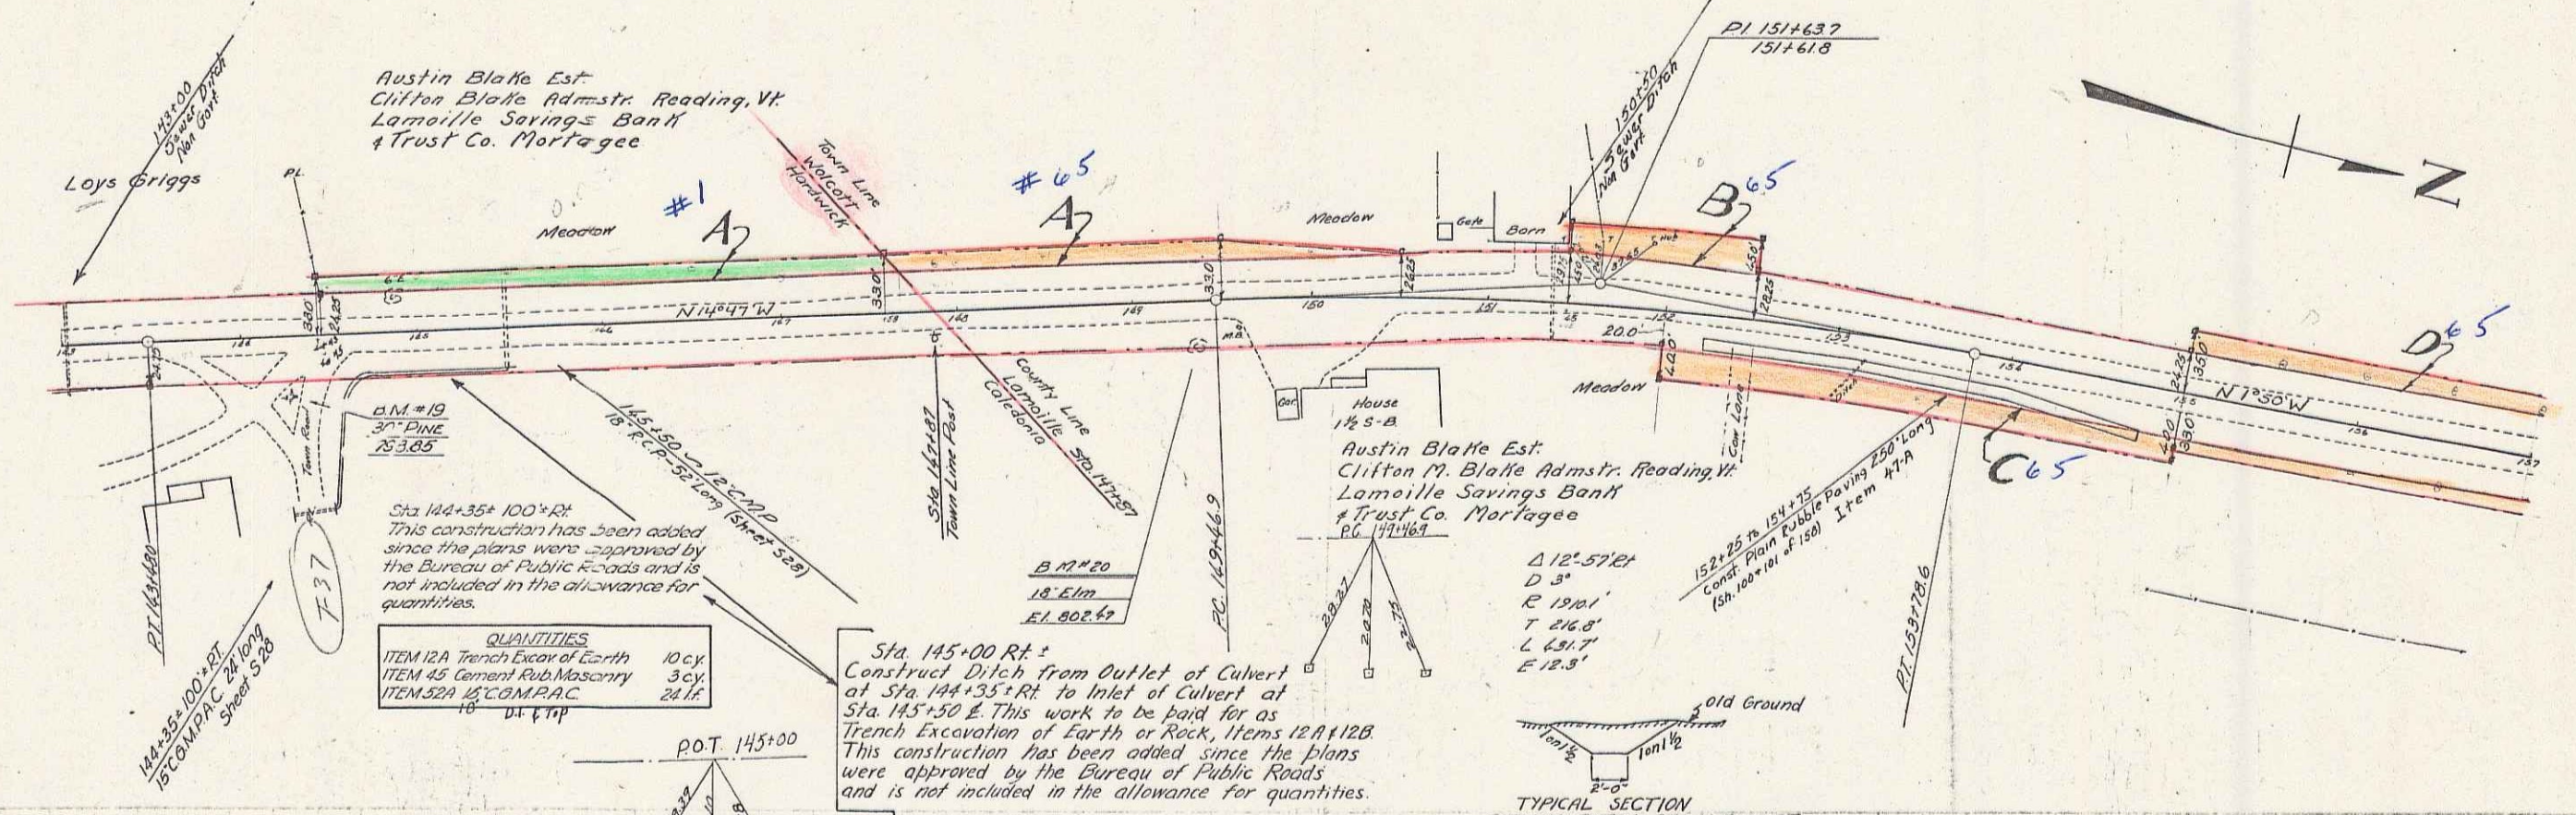


Sta. 144+35+100+RT  
This construction has been added since the plans were approved by the Bureau of Public Roads and is not included in the allowance for quantities.

QUANTITIES	AMOUNT
ITEM 12A Trench Excav of Earth	10 cy
ITEM 45 Cement Rub. Masonry	3 cy
ITEM 52A 12" COMP. AC	24 LF

Sta. 145+00 RT  
Construct Ditch from Outlet of Culvert at Sta. 144+35+RT to Inlet of Culvert at Sta. 143+50 E. This work to be paid for as Trench Excavation of Earth or Rock, Items 12A 12B. This construction has been added since the plans were approved by the Bureau of Public Roads and is not included in the allowance for quantities.

QUANTITIES	ITEM	AMOUNT
ITEM 12A TRENCH EXCAV OF EARTH		10.5 CY.

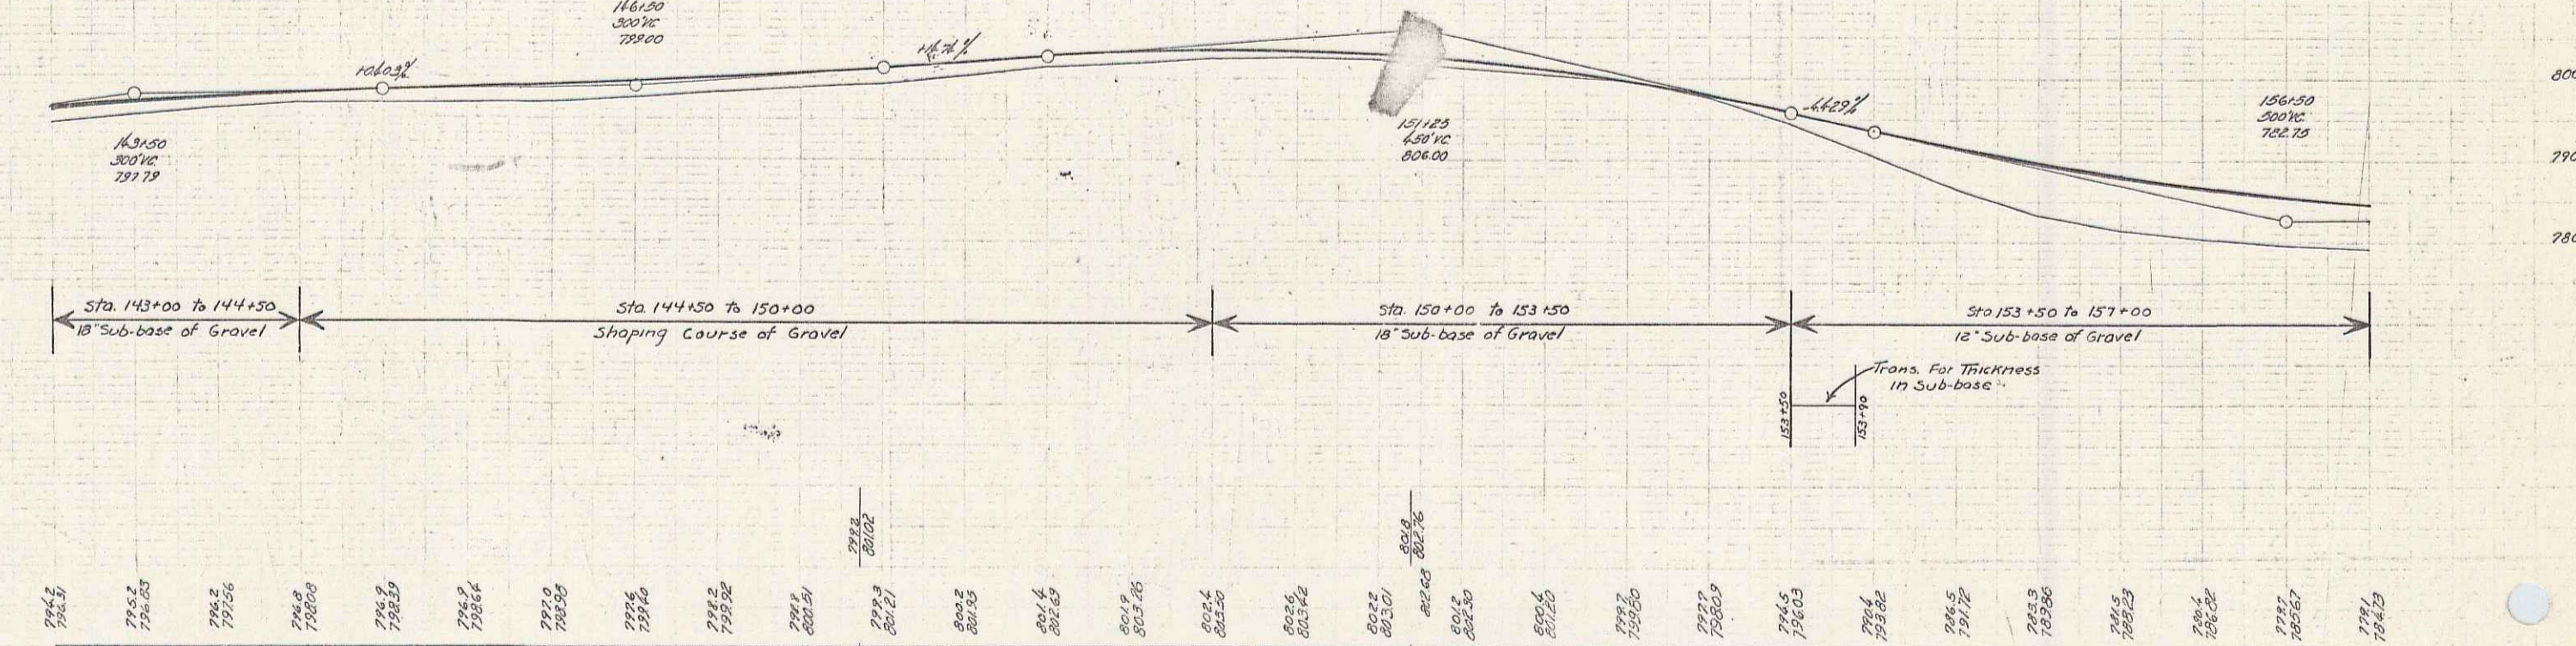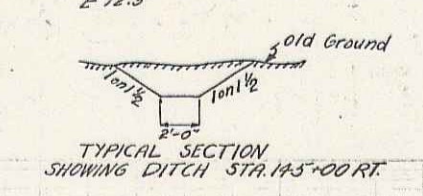

Station	Elevation	Notes
143+00	797.79	Sub-base of Gravel
144+00	798.00	Shaping Course of Gravel
145+00	798.20	Sub-base of Gravel
146+00	798.40	Sub-base of Gravel
147+00	798.60	Sub-base of Gravel
148+00	798.80	Sub-base of Gravel
149+00	799.00	Sub-base of Gravel
150+00	799.20	Sub-base of Gravel
151+00	799.40	Sub-base of Gravel
152+00	799.60	Sub-base of Gravel
153+00	799.80	Sub-base of Gravel
154+00	800.00	Sub-base of Gravel
155+00	800.20	Sub-base of Gravel
156+00	800.40	Sub-base of Gravel
157+00	800.60	Sub-base of Gravel

158 Hardwick-Walpole Route 15  
Series FRP No. 84-E  
Sheet 16 of 158