


PARCEL	INITIATION	DATE	GRANTOR	GRANTEE	RECORDED	REMARKS
B	Q.C.D.	10-15-38	ALFRED E. MEDERISE	GOSSSELIN	ST OF VT	26 197 10-15-38
B	R.V.L.	9-14-38	FEDERAL LAND BANK	GOSSSELIN	24 190 10-15-38	
B	Q.C.D.	9-6-38	H.S. WOODMANEE	ST OF VT	24 185 9-9-38	
A-B	Q.C.D.	3-6-38	ELIUD L. GEORGE, MOUNTAIN C.	ST OF VT	24 131 3-26-38	
A	Q.C.D.	12-29-39	WILL LETTA MOUNTAIN	ST OF VT	24 225 1-31-40	

84E 1939 21 158

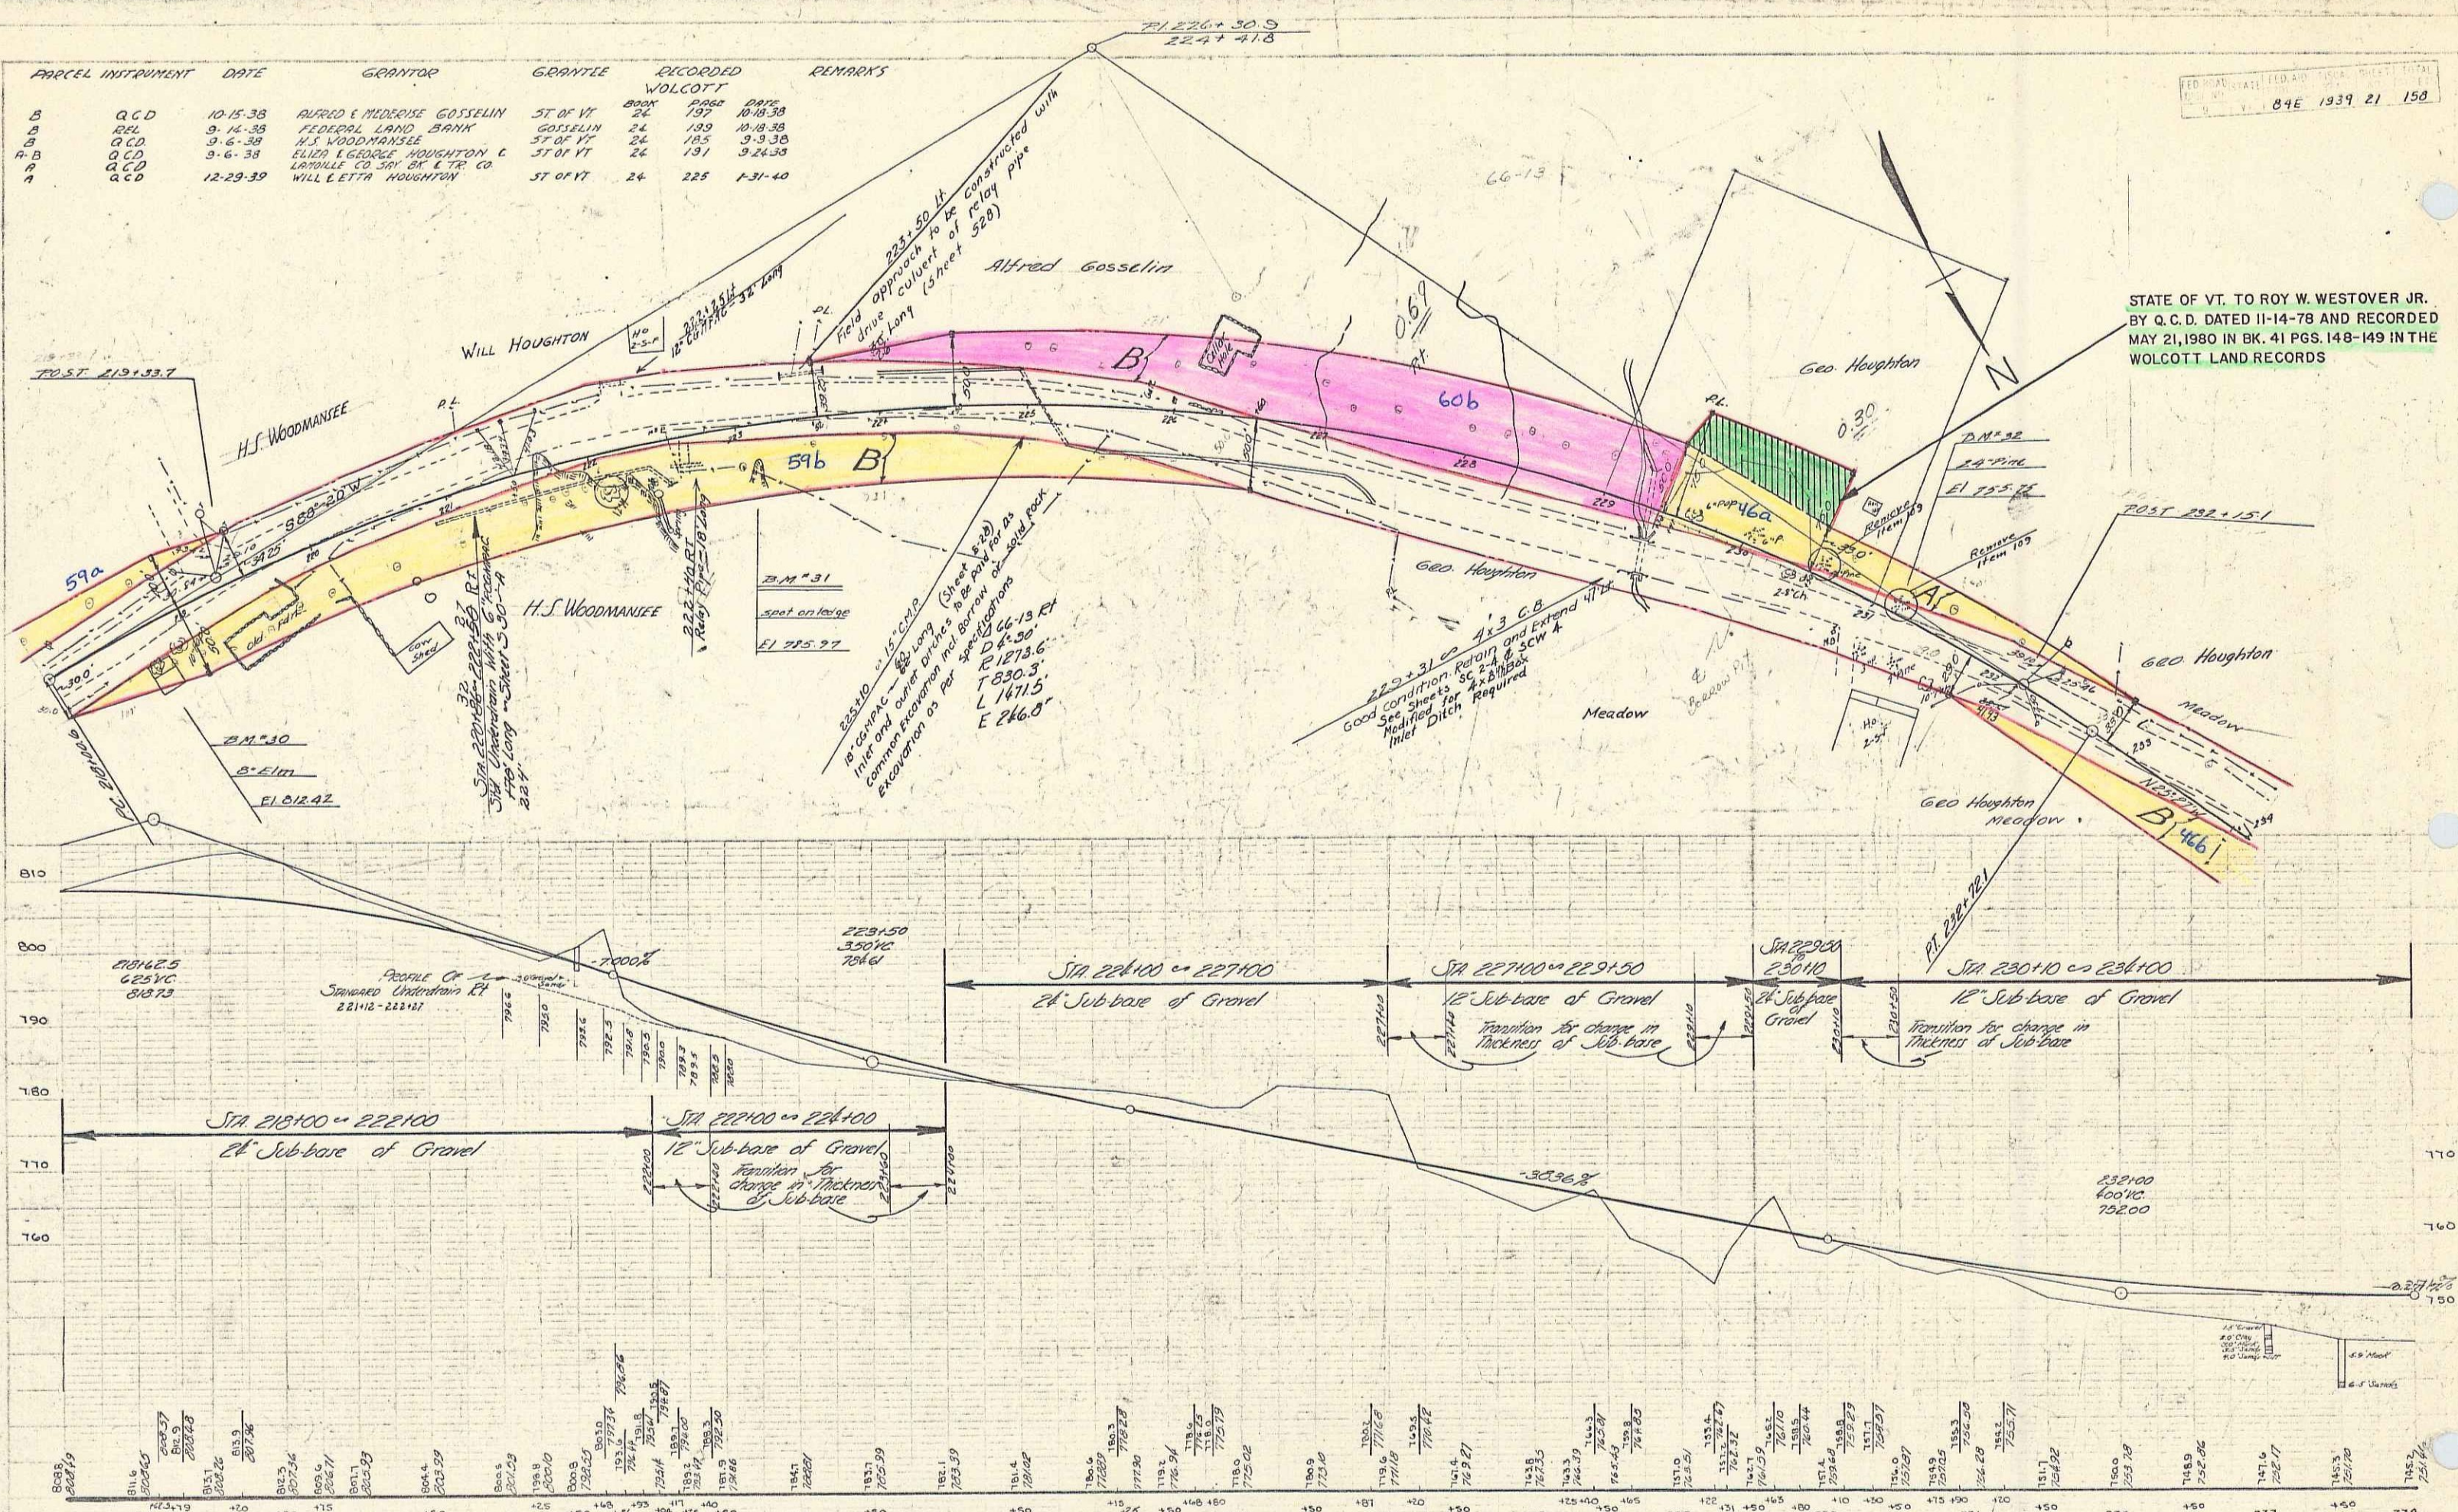

STATE OF VT. TO ROY W. WESTOVER JR.
 BY Q.C.D. DATED 11-14-78 AND RECORDED
 MAY 21, 1980 IN BK. 41 PGS. 148-149 IN THE
 WOLCOTT LAND RECORDS

Traced
 G. Lane
 R. Bailey

A.D. Wood
 R. Williams
 R. Bailey

218+00 SPIKE IN ROOT 8" DIA 25' RT STA 218+00 EL. 912.92
 219+31 SPIKE ON LEDGE 29.5' RT STA 219+31 EL. 735.97
 219+32 SPIKE IN ROOT 24" TINE 5' LT STA 219+32 EL. 755.75

JUL 1 1980