

POOR ORIGINAL COPY

STATE OF VERMONT

STATE HIGHWAY DEPARTMENT

PLAN AND PROFILE OF PROPOSED STATE HIGHWAY


FEDERAL AID PROJECT

TOWNS OF WESTFORD AND UNDERHILL Pin #000286

STATE ROUTE 15 CAMBRIDGE-ESSEX JUNCTION ROAD

BEGINNING AT A POINT 0.32 MILE NORTH OF THE WESTFORD-UNDERHILL TOWN LINE AND EXTENDING SOUTHERLY 5.084 MILES TO A POINT 0.17 MILE NORTH OF THE UNDERHILL-JERICO TOWN LINE

STA	LENGTH	OF ROADWAY	FT	MI
238+27	540	BRIDGE	5058	0.012
250+64	540	BRIDGE	5058	0.012
TOTAL	26822.7	PROJECT	5084	0.096

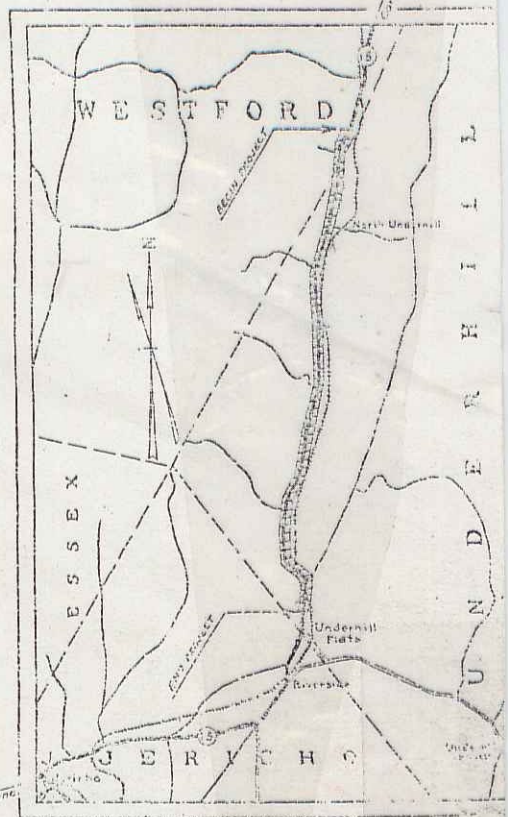


- SHEETS
- SECTION OF IMPROVEMENT CRUSHED GRAVEL MIXED IN PLACE SURFACE COURSE WITH REFINED TAR IFLM 25 B.30
 - CONSTRUCTION
 - DETAILS BRIDGE STA. 237+90 TO 238+02
 - DETAIL BRIDGE STA. 250+50
 - GENERAL NOTES
 - PIPE CULVERTS
 - BOX CULVERTS BARRELS 2X2 TO 4X4
 - SWINGS FOR 2X2 B3X3 BOXES
 - RAIL
 - UNDERDRAIN
 - CONCRETE
 - MARKERS
 - TRAFFIC SIGNS & LIGHTS
 - GRADING OF SLOPES

NO BE RETURNED TO BUREAU OF HIGHWAYS

APPROVED

RECOMMENDED

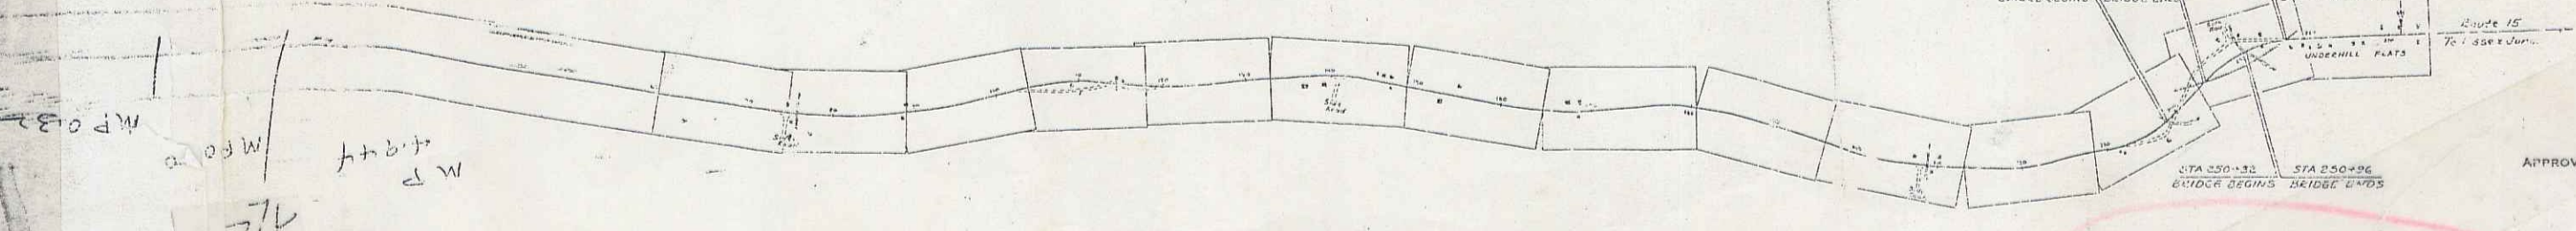

SCALES

TITLE	1 IN. = 1000 FT.
TYPICAL	1 IN. = 3 FT.
PLAN & PROFILE	1 IN. = 30 FT.
CROSS SECTIONS	1 IN. = 5 FT.

THESE PLANS ARE SUBJECT TO SUCH REVISIONS AS MAY BE REQUIRED BY THE BUREAU OF PUBLIC ROADS OR THE COMMISSIONER OF HIGHWAYS. CONSTRUCTION IS TO BE CARRIED ON IN ACCORDANCE WITH THE PLANS AND THE STANDARD ROAD AND BRIDGE SPECIFICATIONS OF 1935 AS APPROVED DEC. 29, 1935 BY THE BOARD OF PUBLIC ROADS INCLUDING ALL SUBSEQUENT APPROVED REVISIONS AND SUCH REVISED SPECIFICATIONS AND SPECIAL PROVISIONS AS ARE SUBMITTED WITH THE PLANS.

Project No FAP 98H
RE.VT 15

VT 15

SHEET NAME 1 of 12

May 3, 1936