

QCD 12/7/81 Book 50 Pg. 346

LAND ~~TO BE~~ QUIT CLAIMED TO TOWN OF UNDERHILL BY STATE OF VERMONT, FORMERLY VT. RTE. 15 (1.56 A±)

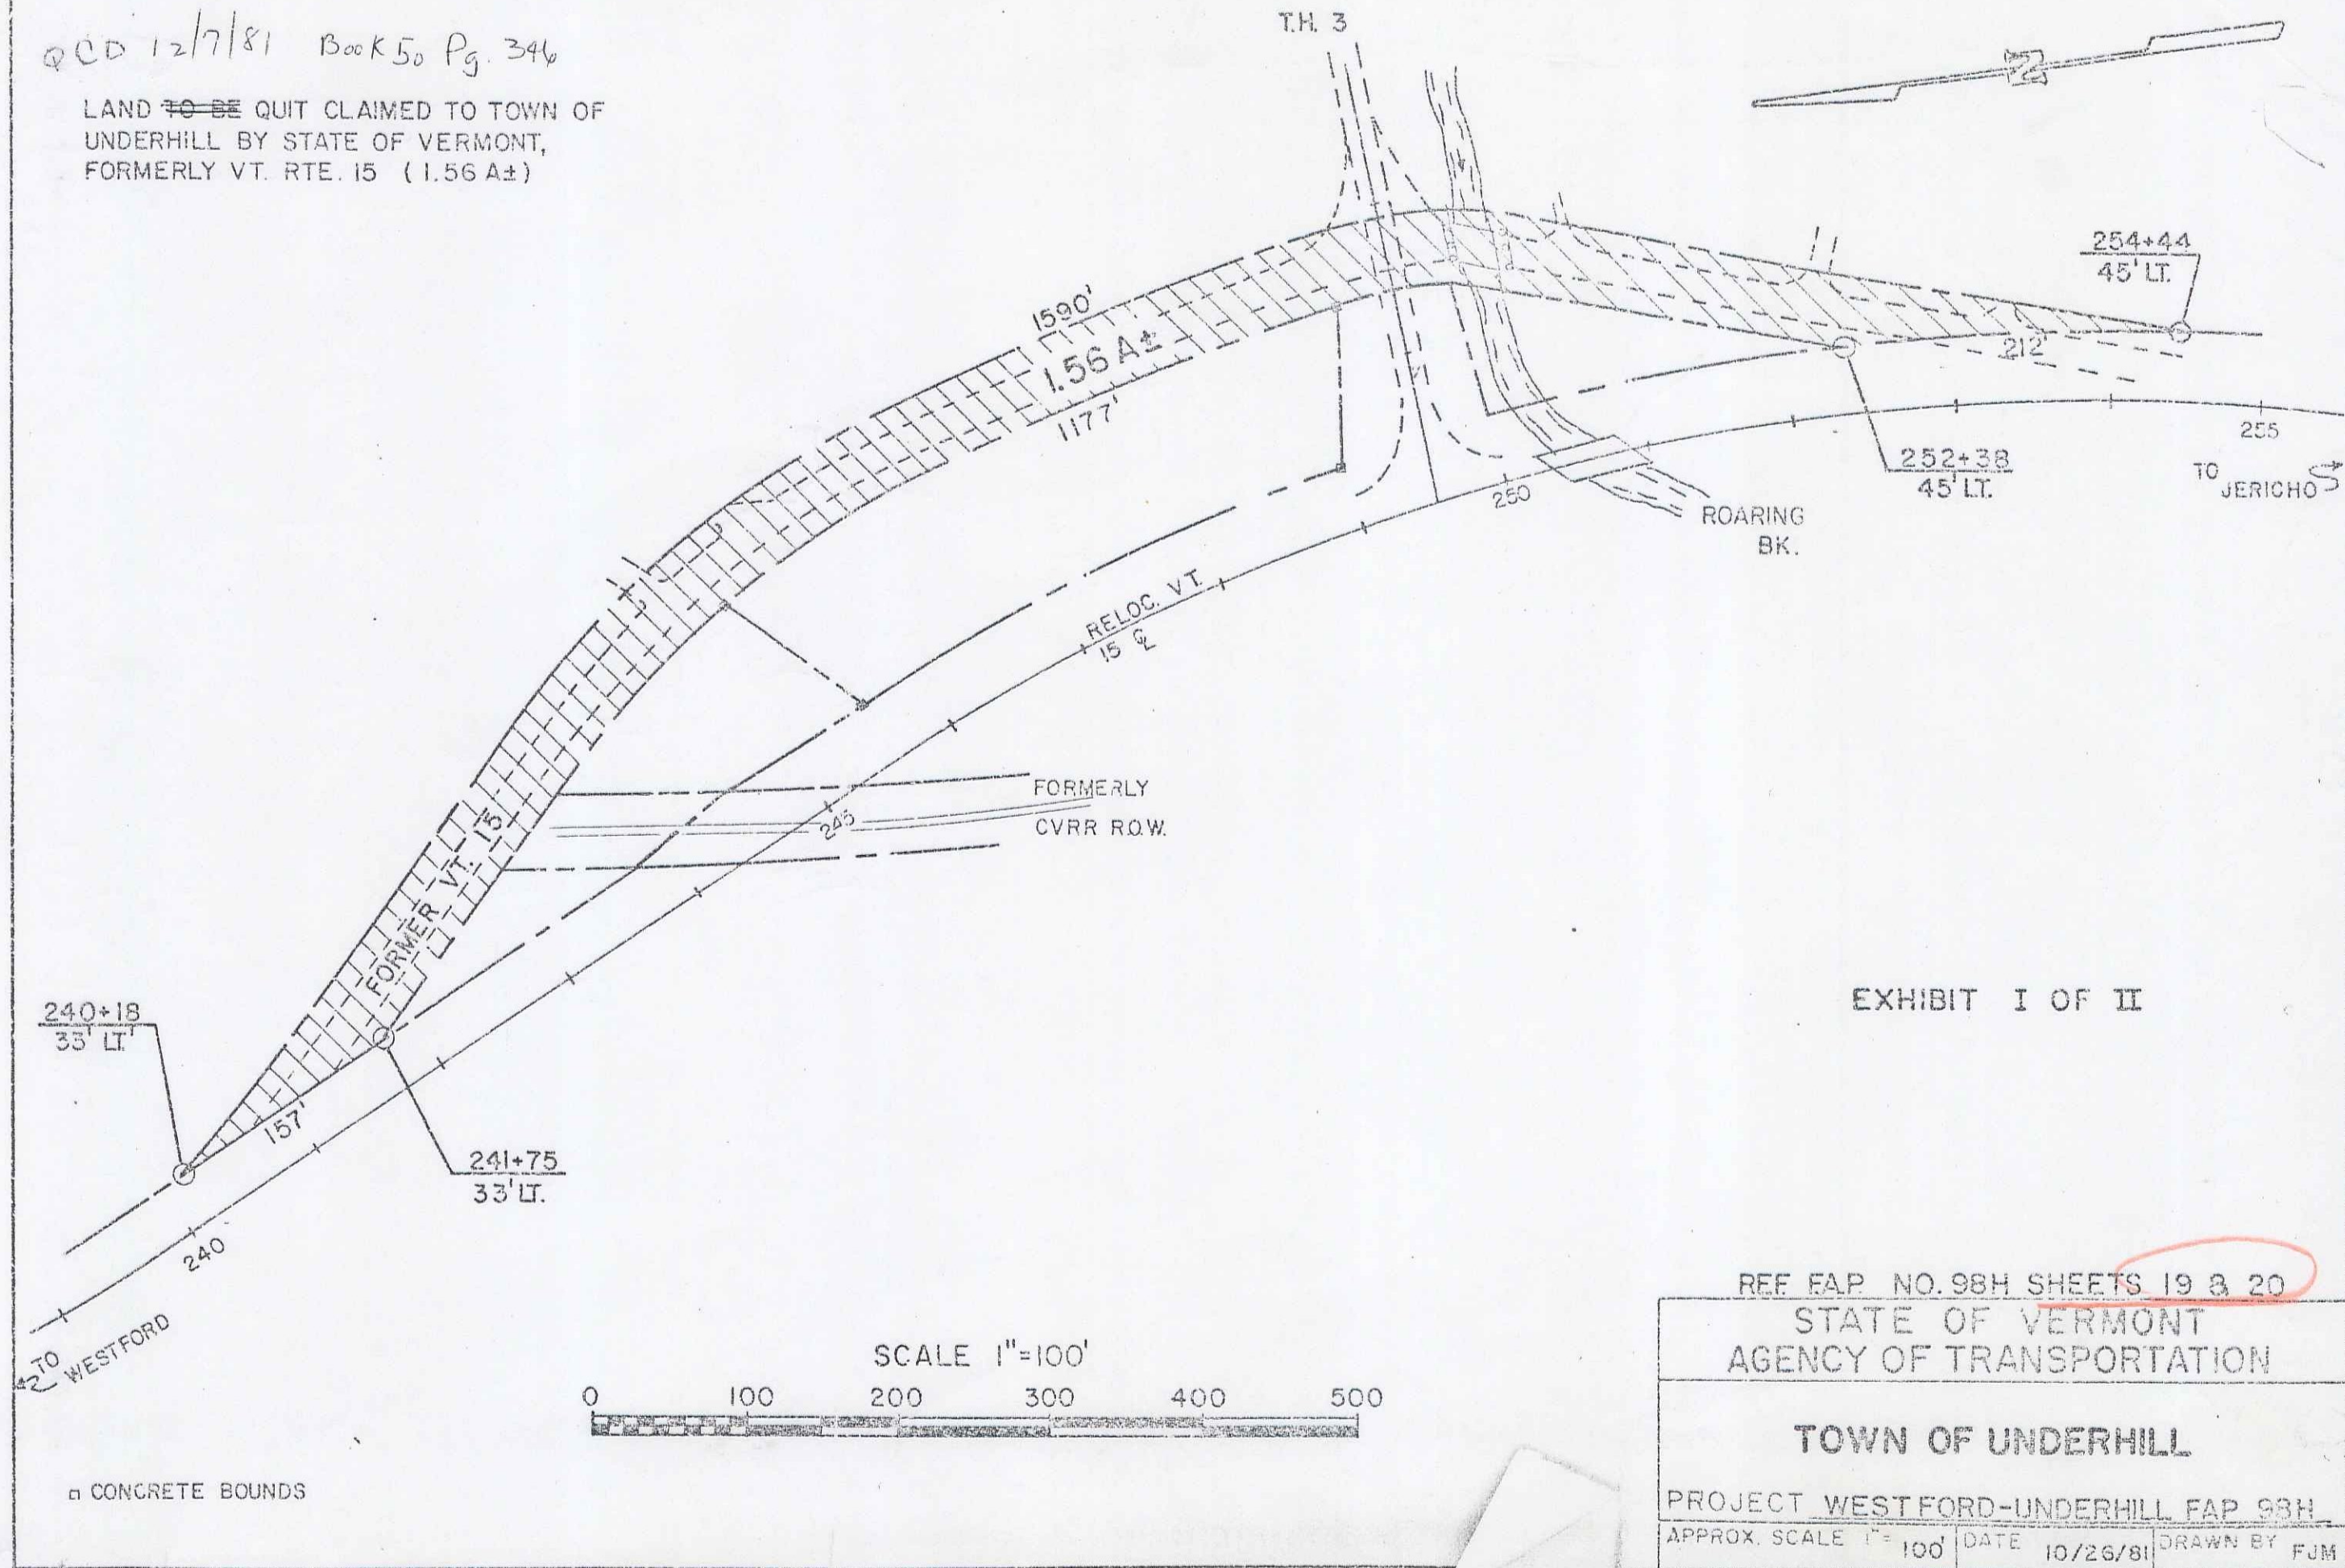


EXHIBIT I OF II

REF. MAP NO. 98H SHEETS 19 & 20  
STATE OF VERMONT  
AGENCY OF TRANSPORTATION

TOWN OF UNDERHILL

PROJECT WESTFORD-UNDERHILL MAP 98H  
APPROX. SCALE 1" = 100' DATE 10/26/81 DRAWN BY FJM

2