


NO.	STATE	YEAR	TOTAL SHEETS
9	VI.	96.H	1935

PARCEL INSTRUMENT	DATE	GRANTOR	GRANTEE	RECORDED UNDERHILL	REMARKS
A-O-C	O.C.D.	4-12-38	BERT FRENCH	ST. 34	BOOK 326 DATE 4-15-38 35 66+00

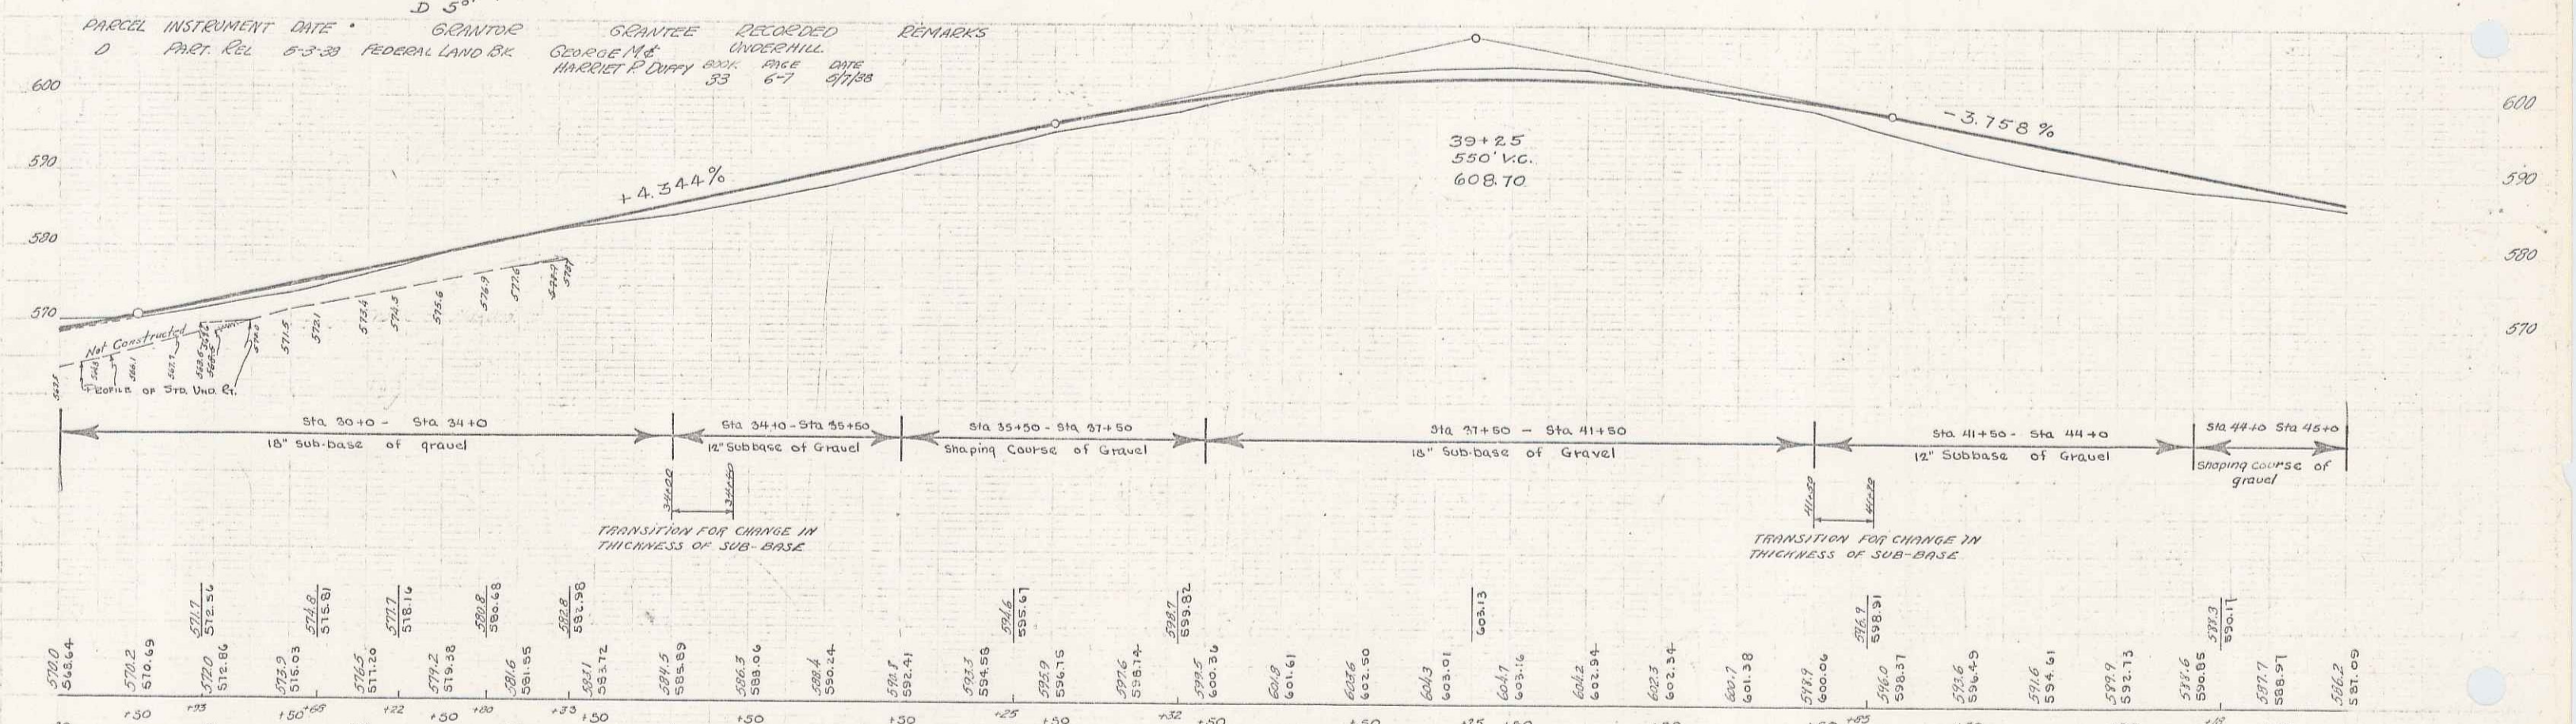

BM No. 6 - spike in root of 24" elm 40 ft left of Sta. 30+77 - Elevation: 570.27 -
 BM No. 7 - spike in root of 15" maple 35 ft left of Sta. 36+29 - Elevation: 594.17 -
 B.M. No. 8 - spike in root of 20" maple 16 ft right of Sta. 41+16 - Elevation: 601.41 -