


PARCEL	INSTRUMENT	DATE	GRANTOR	GRANTEE	RECORDED UNDER	REMARKS
					BOOK PAGE DATE	

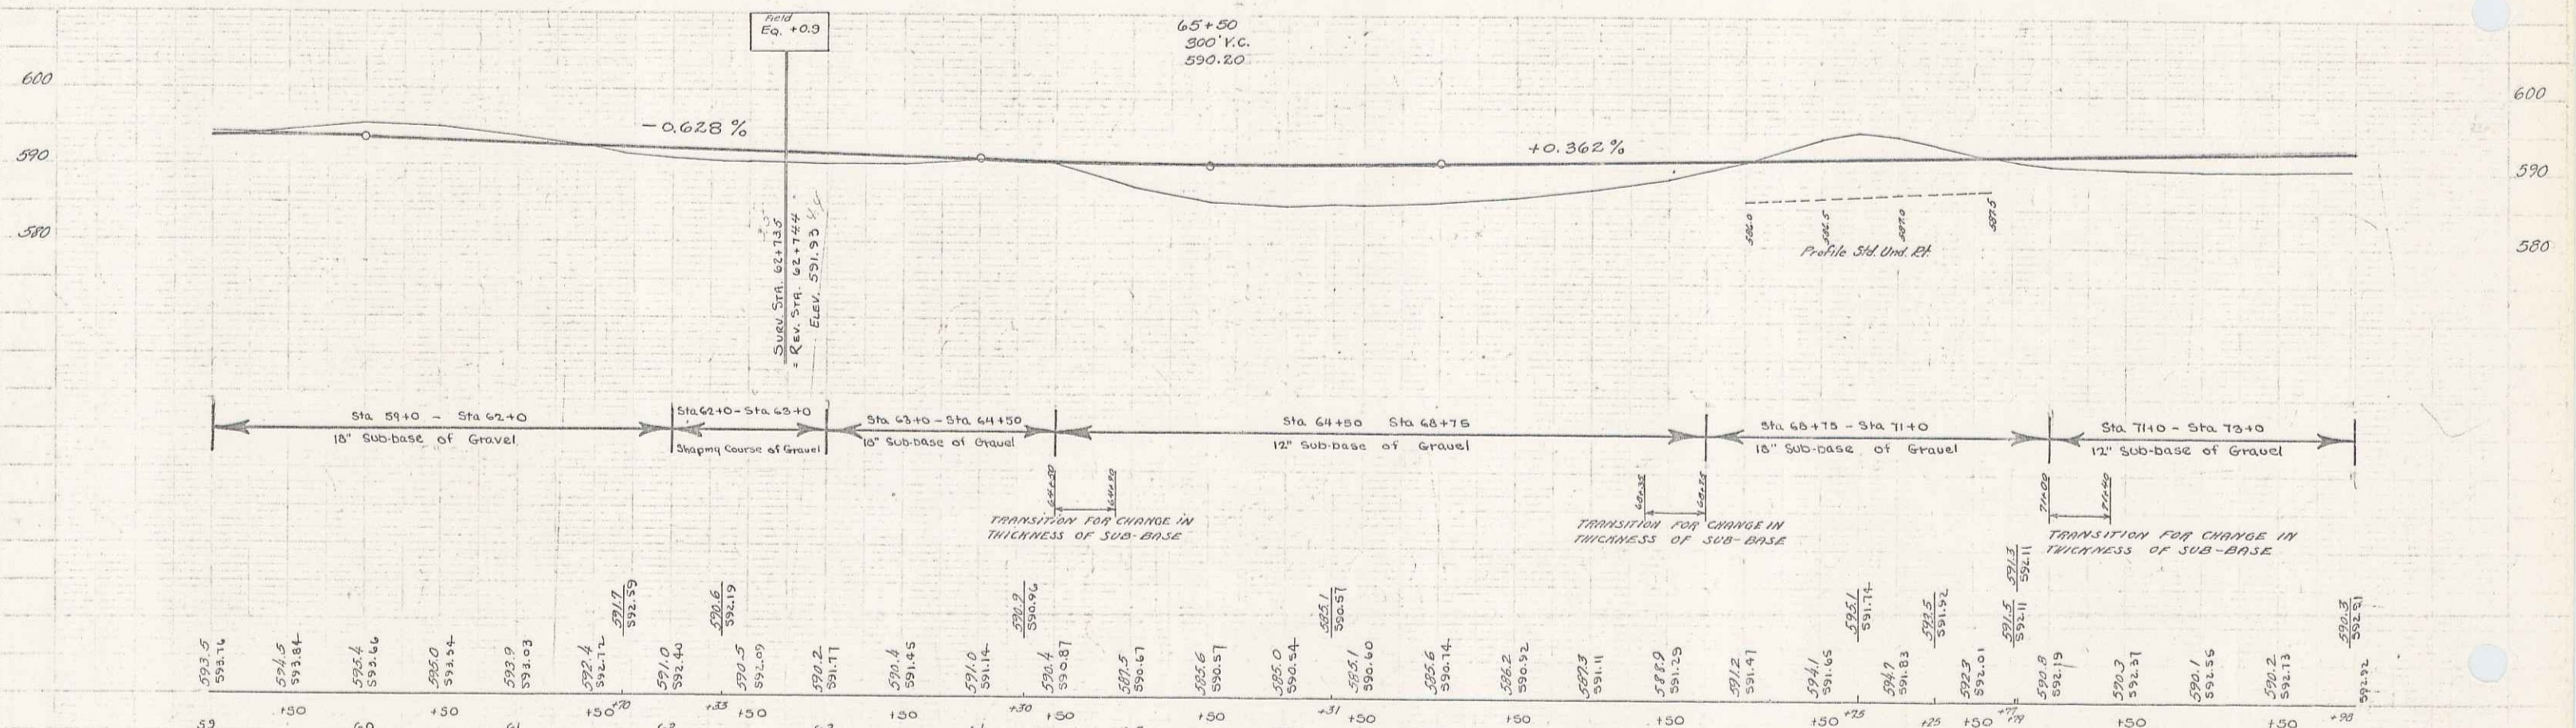

B.M. No 11 - point spot on boulder 29 ft. left of sta 62+61 - elevation: 592.50.
 B.M. No 12 - spike in root of 12" maple 16 ft. left of sta. 68+82 - elevation: 590.61.