

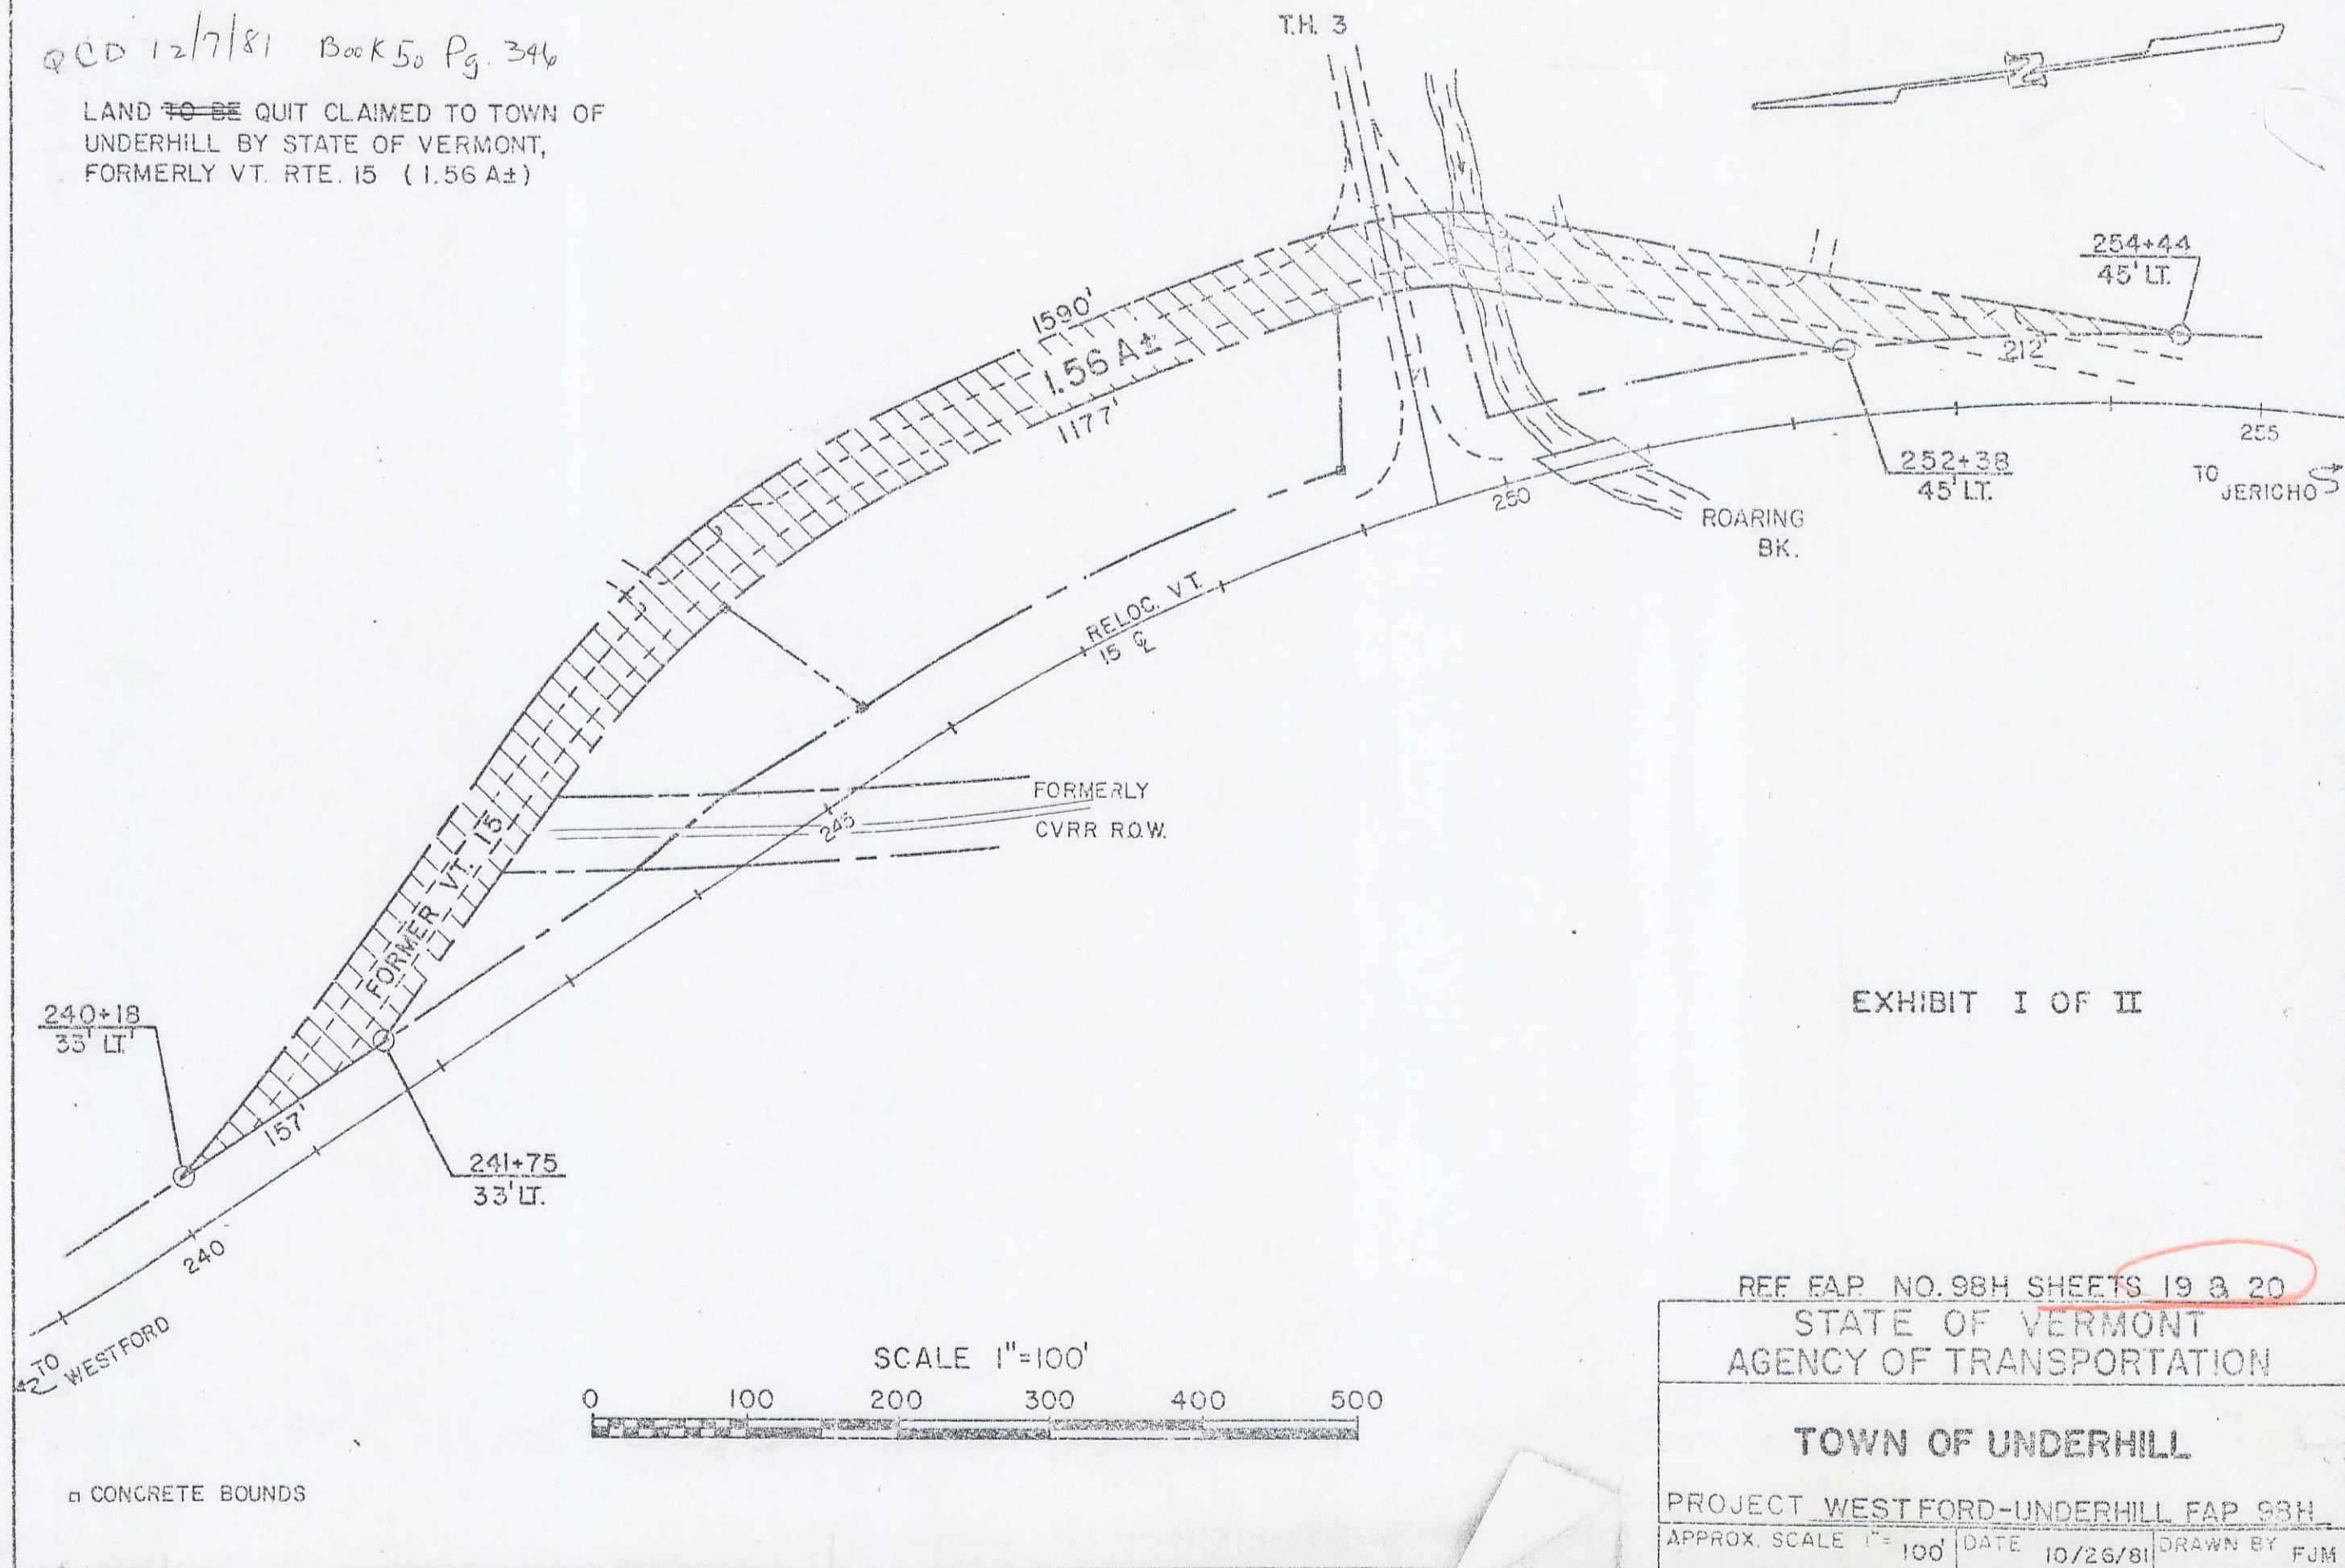


QCD 12/7/81 Book 50 Pg. 346

LAND ~~TO BE~~ QUIT CLAIMED TO TOWN OF UNDERHILL BY STATE OF VERMONT, FORMERLY VT. RTE. 15 (1.56 A±)

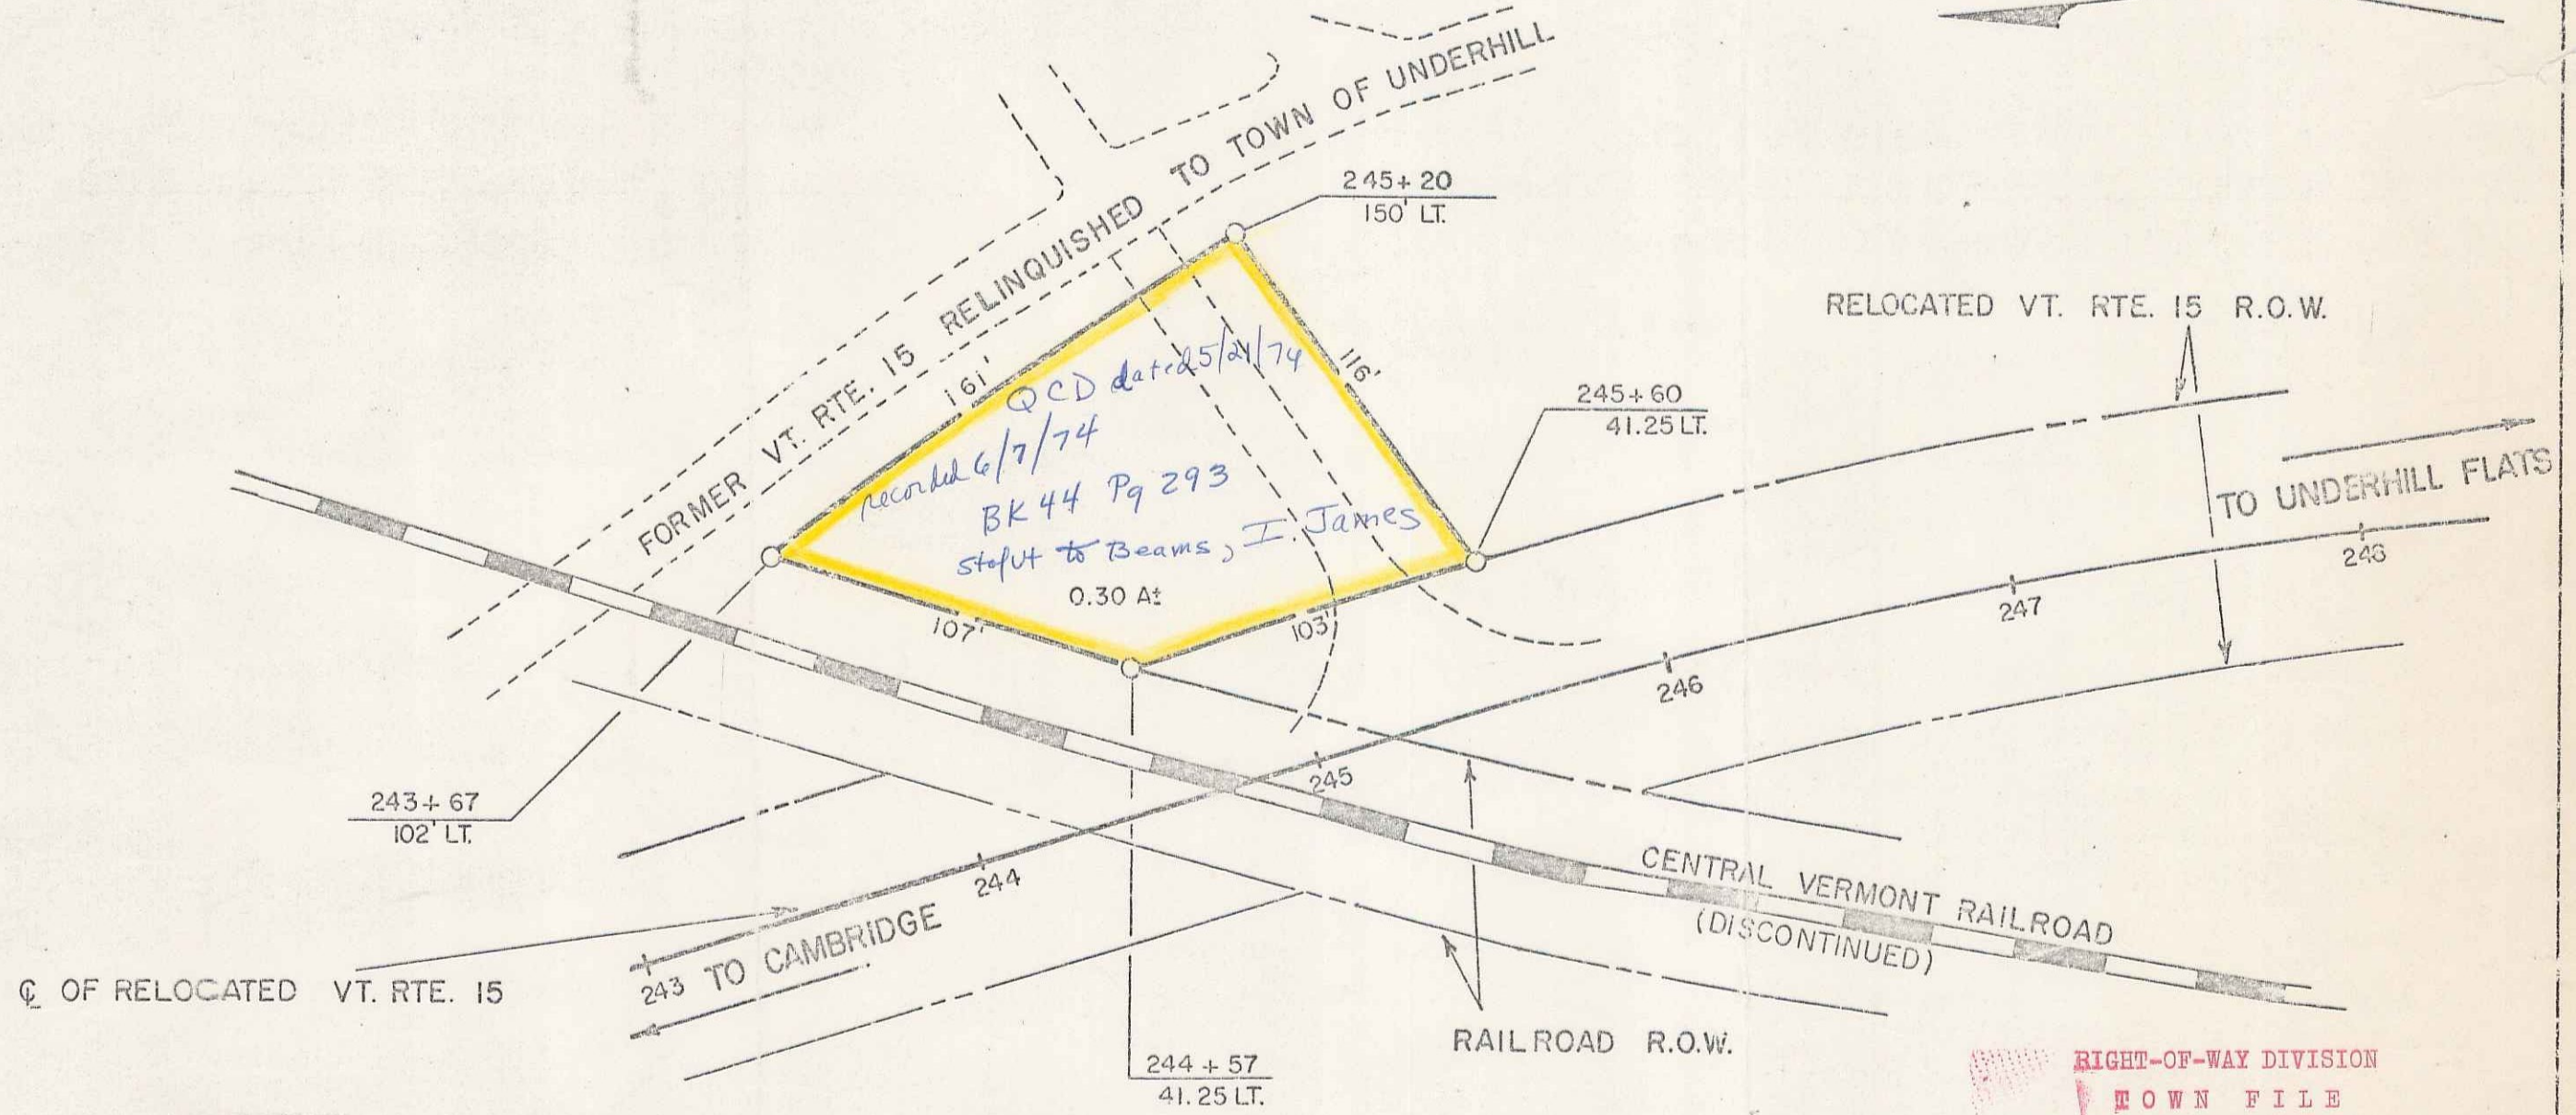

ACQUIRED FROM C.M. MEADE EST. BY: CCND. 4-16-38 BK. 32 PG. 537-539
ADMINISTRATORS DEED 6-11-38 BK. 33 PG. 16,17

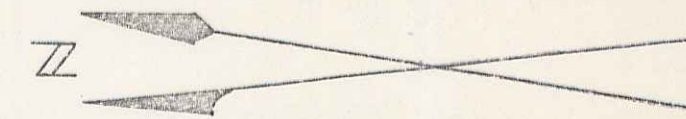

RIGHT-OF-WAY DIVISION
TOWN FILE
PERPETUAL
Town of U-15
(To Be Returned To R.O.W. Division)


SCALE 1" = 50'



STATE OF VERMONT
DEPT. OF HIGHWAYS
TOWN OF UNDERHILL
PROJECT UNDERHILL SHEET NAME 3
APPROX. SCALE 1" = 50' DATE 4-12-74 DRAWN BY KMD



CURVE
 Δ 29° 47' LT.
 3°
 1910.1
 507.9
 992.8
 66.9

98-H 1933-4 121

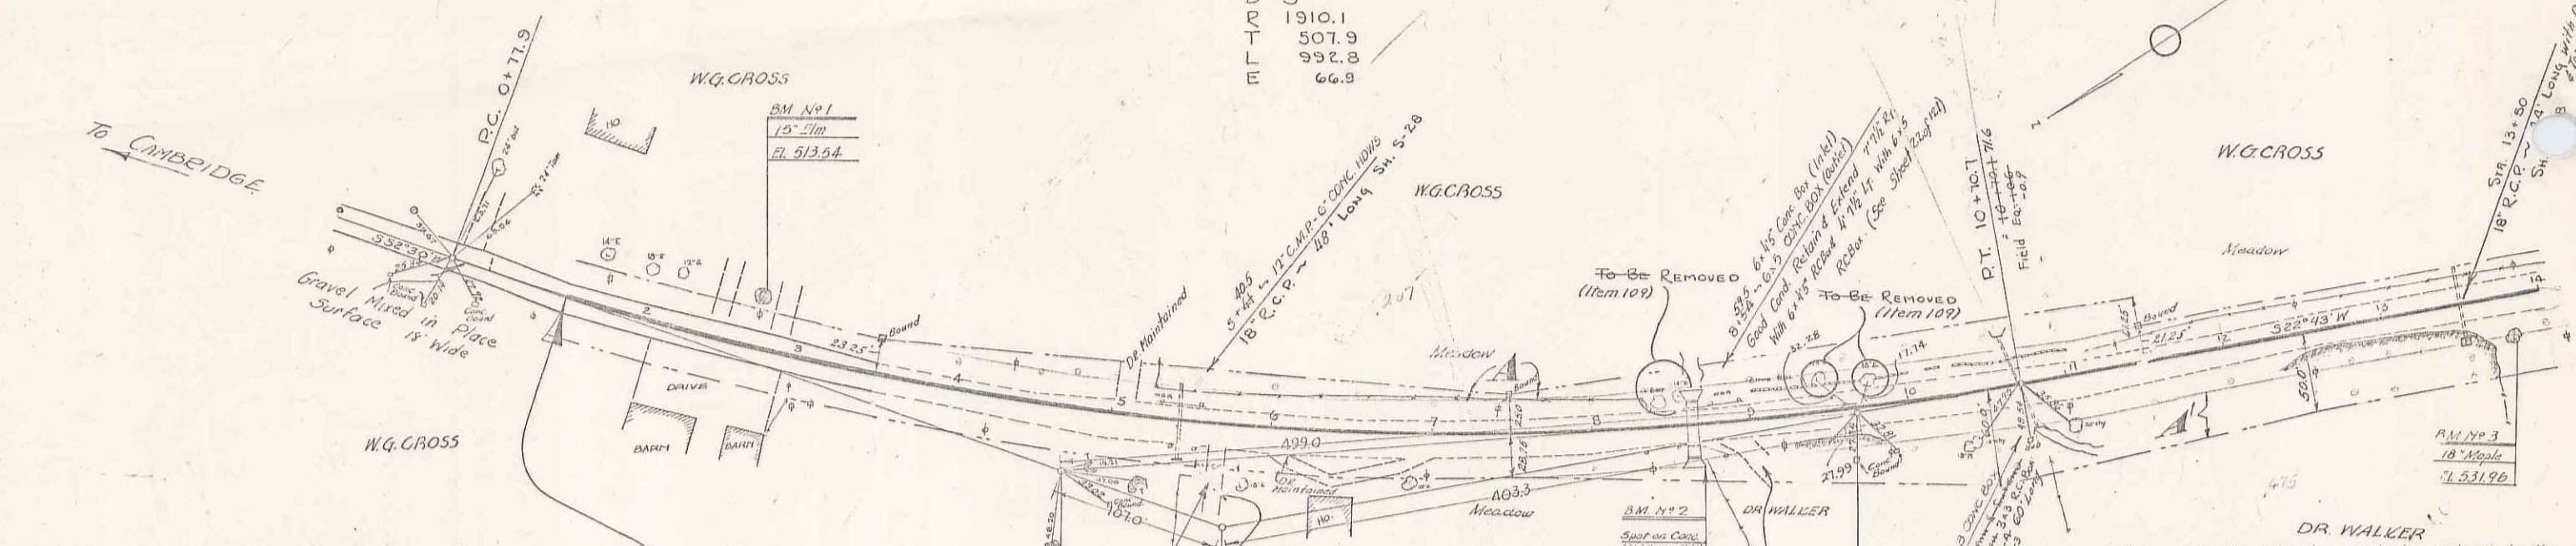

PARCEL	INSTRUMENT	DATE	GRANTOR	GRANTEE	RECORDED WESTFORD	REMARKS
A-B	Q.C.D.	4-12-33	W.G. CROSS	DR WALKER	200K 24	200' x 200' (CR. STA. 12+30)
A	Q.C.D.	7-8-33	W.G. CROSS	DR WALKER	24	200' x 200' (CR. STA. 12+30)

DR WALKER
 Where conc box culverts are to be extended, the extension shall be dowelled to the existing structure with (5) five eighth inch round deformed bars (5) feet long spaced twelve (12) inches center to center. The dowels shall extend into the existing structure a minimum distance of twelve (12) inches. The holes shall be filled with grout and the dowels forced into place. Payment for drilling holes and filling with grout shall be included in the contract unit price for "Reinforcing Steel" (Item 4.2)

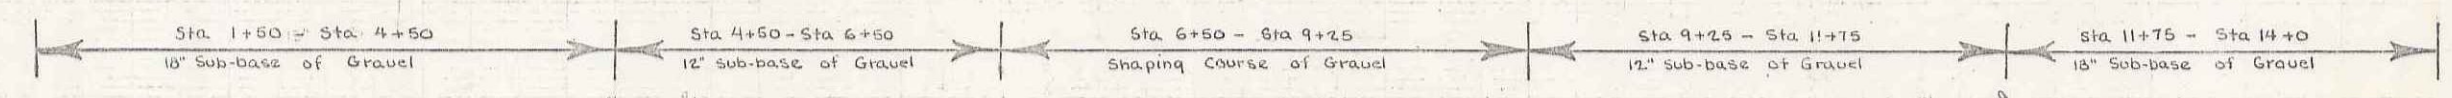
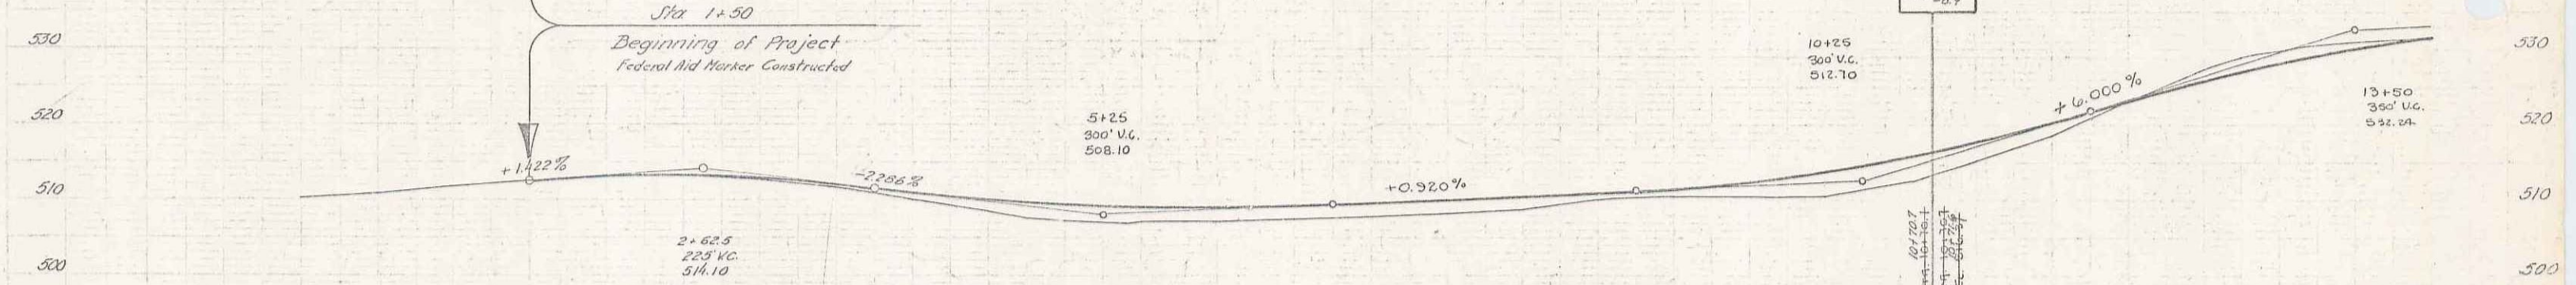


Station	Elevation	Station	Elevation	Station	Elevation	Station	Elevation	Station	Elevation
0+0	510.1	1+0	511.7	2+0	513.0	3+0	514.7	4+0	516.5
4+0	518.3	5+0	520.2	6+0	522.1	7+0	524.0	8+0	525.9
9+0	527.8	10+0	531.7	11+0	535.6	12+0	539.5	13+0	543.4
14+0	547.3								

BM No 1. Spike in root of 13" elm 29 ft left of Sta. 2+69; Elevation: 513.54.
 BM No 2. Point spot on concrete bridge rail 12 ft right of Sta. 8+00; Elevation: 513.19.
 BM No 3. Spike in root of 18" maple 23 ft right of Sta. 13+70; Elevation: 531.96.



SERIES PAP No. 98-H
 SHEET 4 OF 121



4

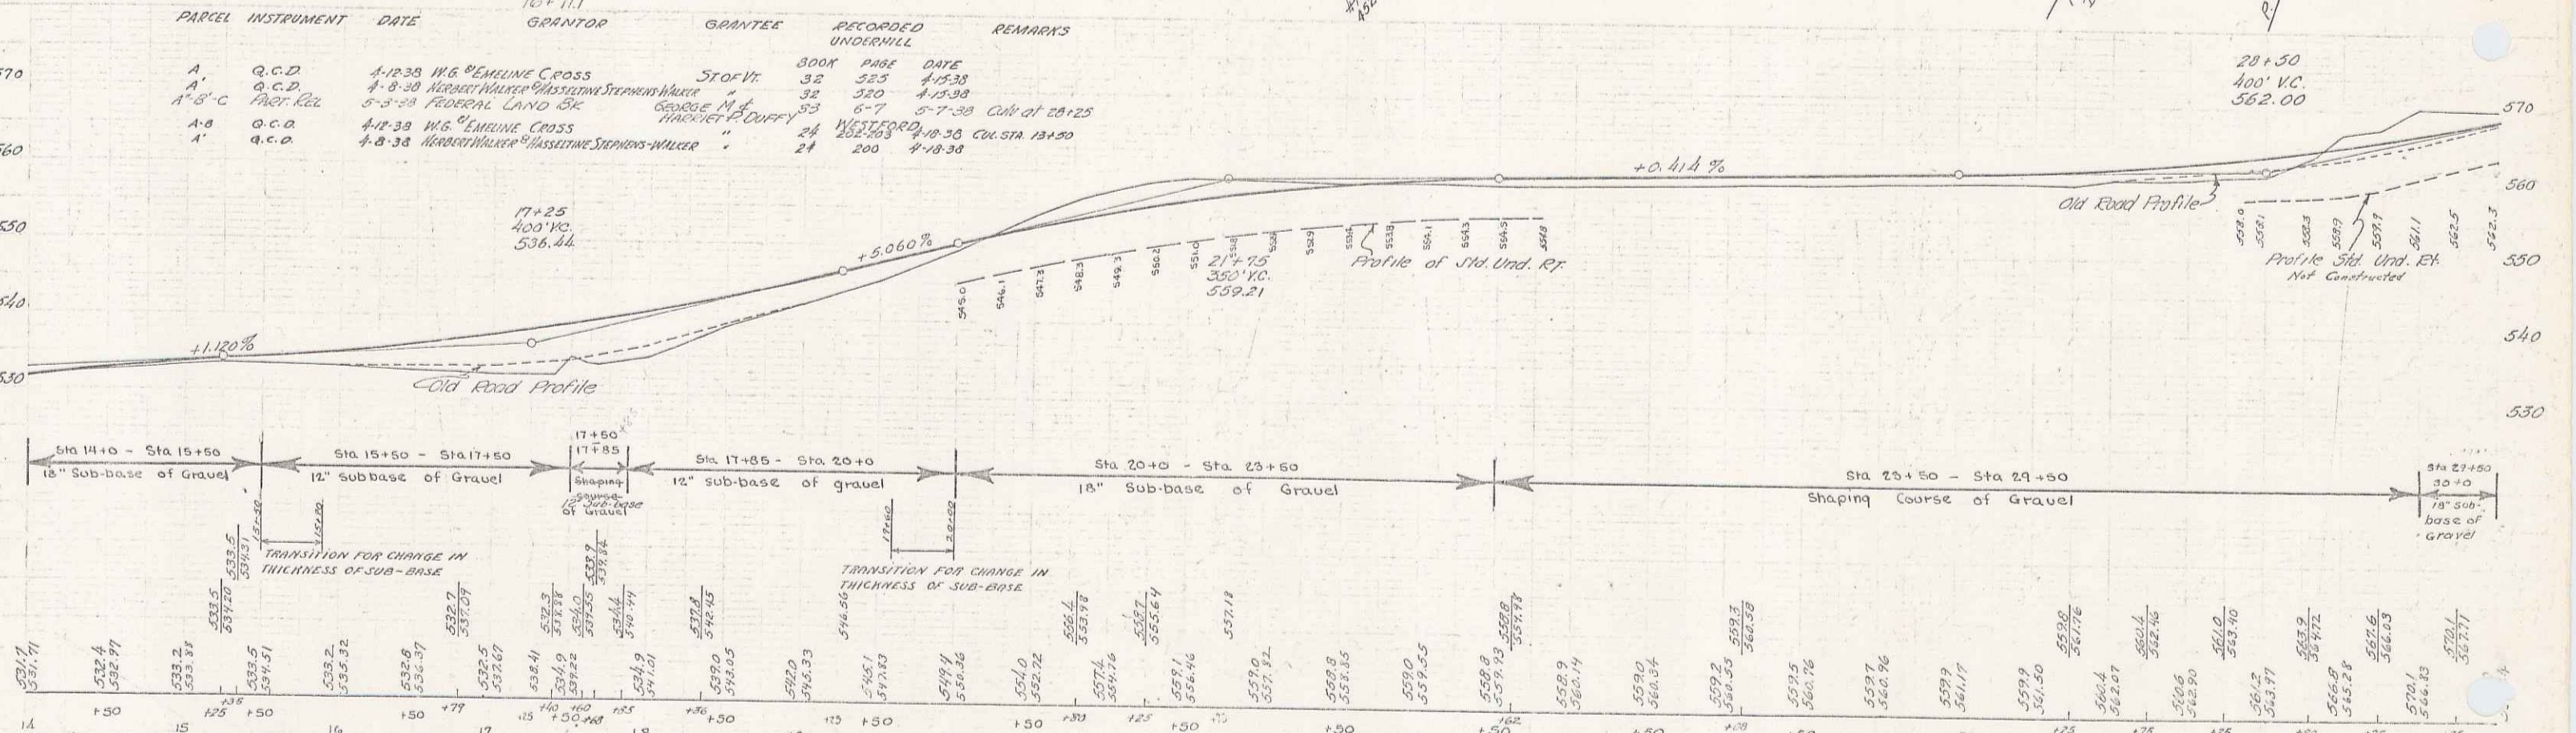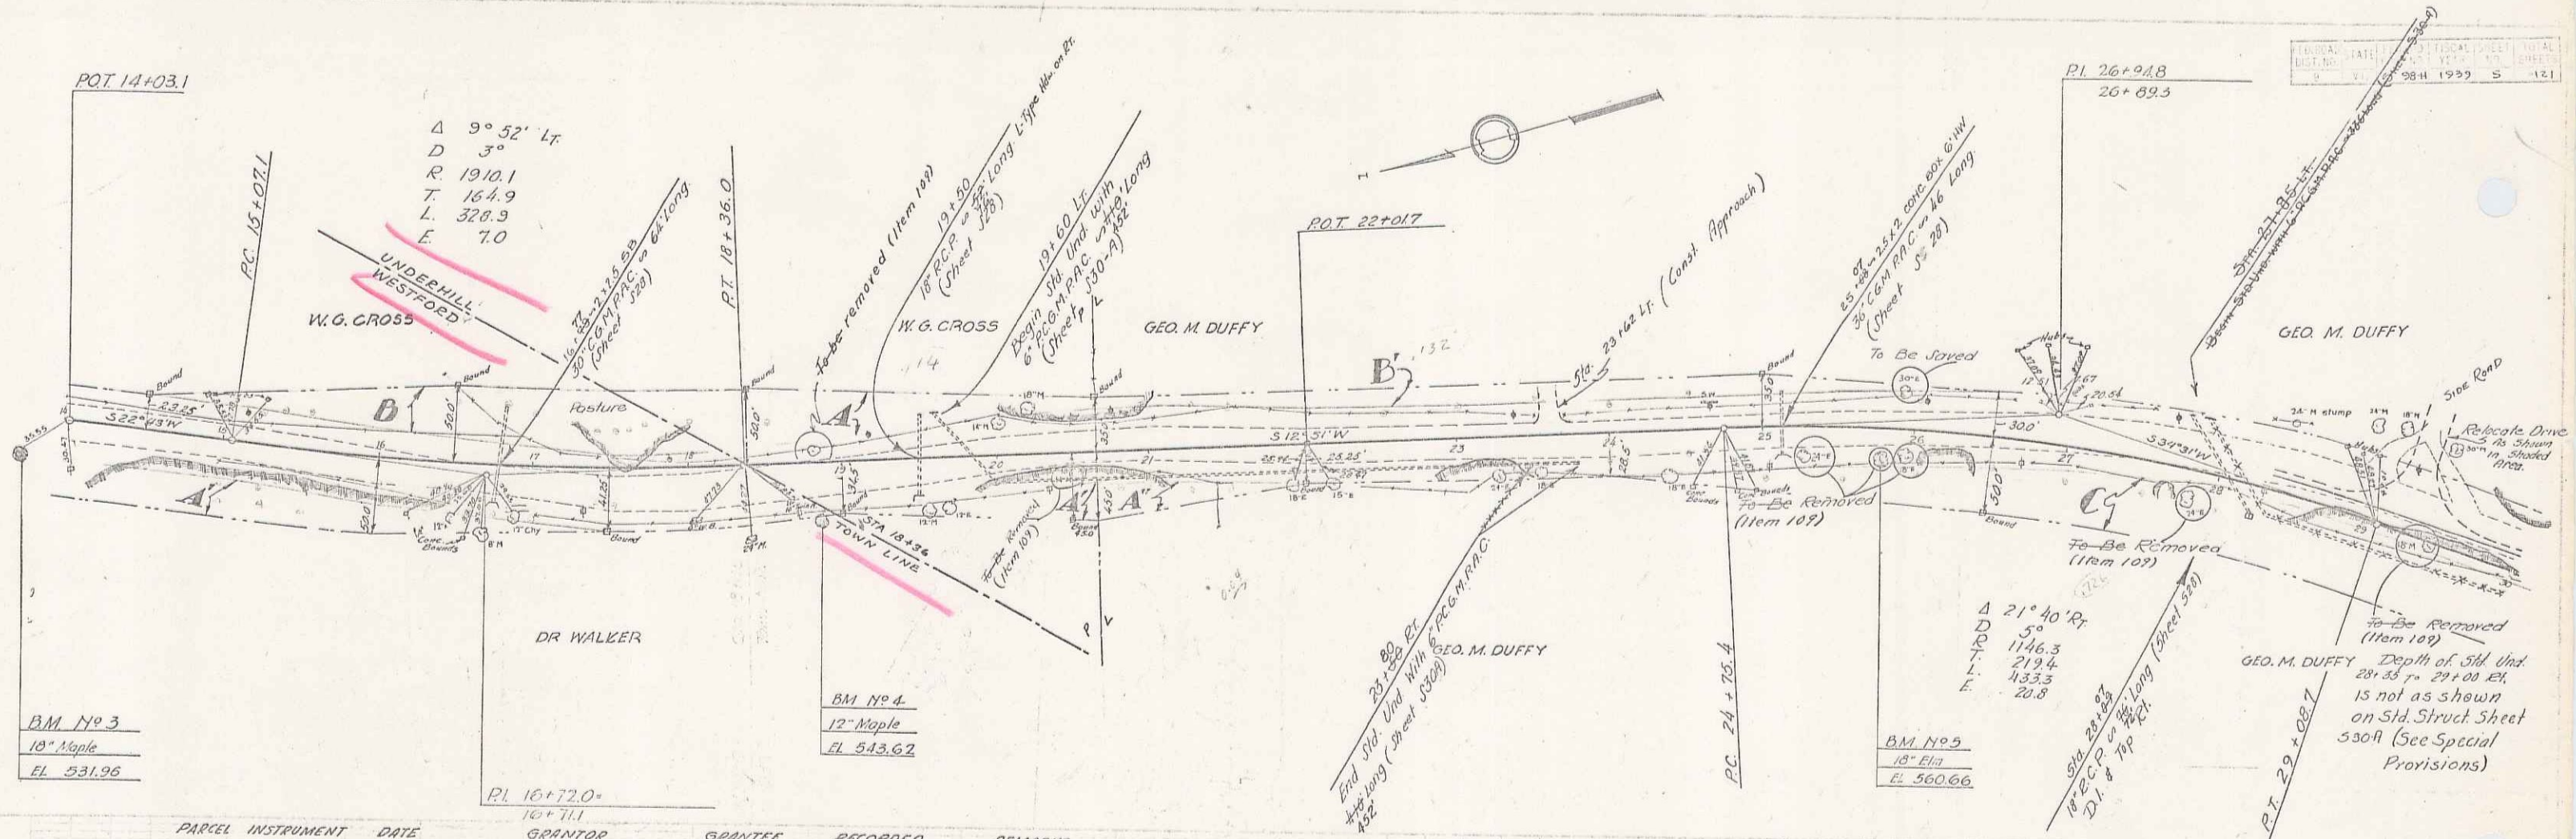

STATION	ELEVATION
14+50	531.71
15+00	532.4
15+50	532.17
16+00	533.2
16+50	533.14
17+00	533.5
17+50	534.1
18+00	533.2
18+50	533.32
19+00	532.6
19+50	532.17
20+00	532.5
20+50	532.67
21+00	532.4
21+50	531.9
22+00	531.9
22+50	532.2
23+00	531.0
23+50	530.72
24+00	531.4
24+50	531.76
25+00	531.76
25+50	531.7
26+00	531.5
26+50	531.4
27+00	531.0
27+50	530.9
28+00	530.7
28+50	530.6
29+00	530.6



B.M. #3 Spike in root of 18 Maple 23 Ft. Ht. of Sta. 13+76 Elev. 531.96
 B.M. #4 Spike in root of 12 Maple 33 Ft. Ht. of Sta. 18+86 Elev. 543.62
 B.M. #5 Spike in root of 18 Elm. 21 Ft. Ht. of Sta. 25+71 Elev. 560.66

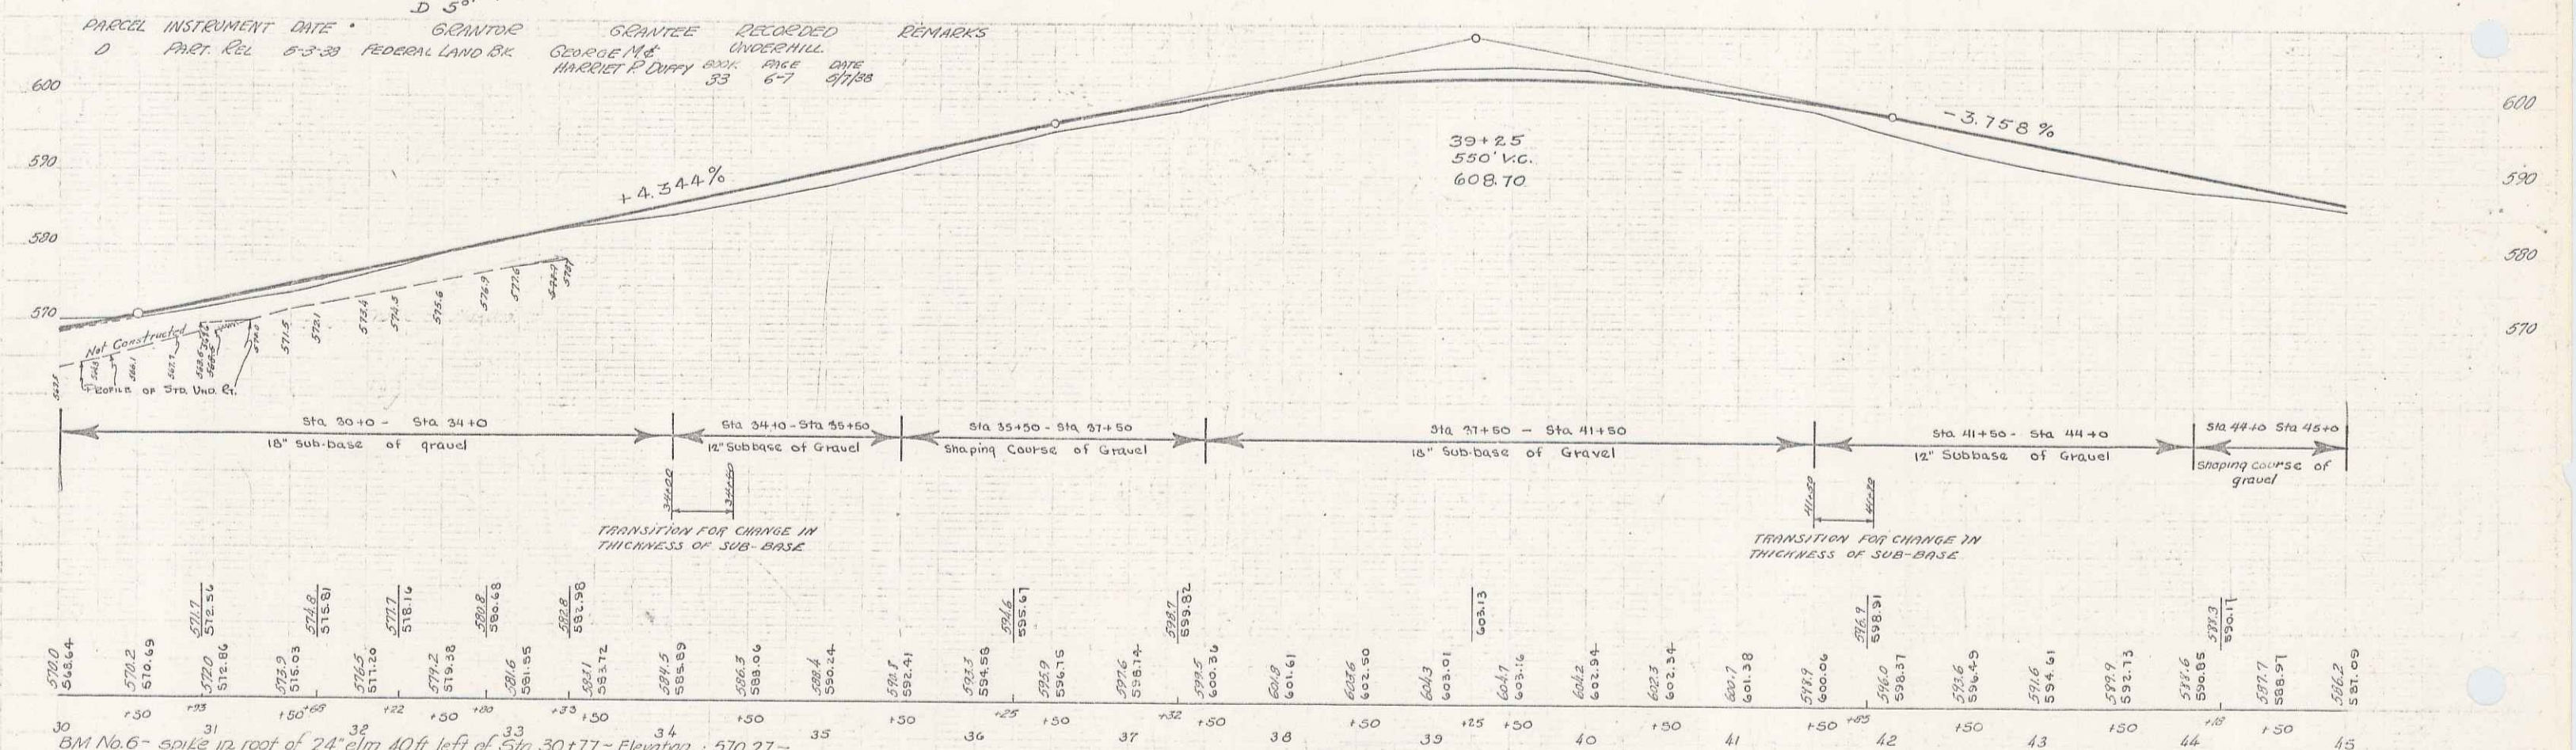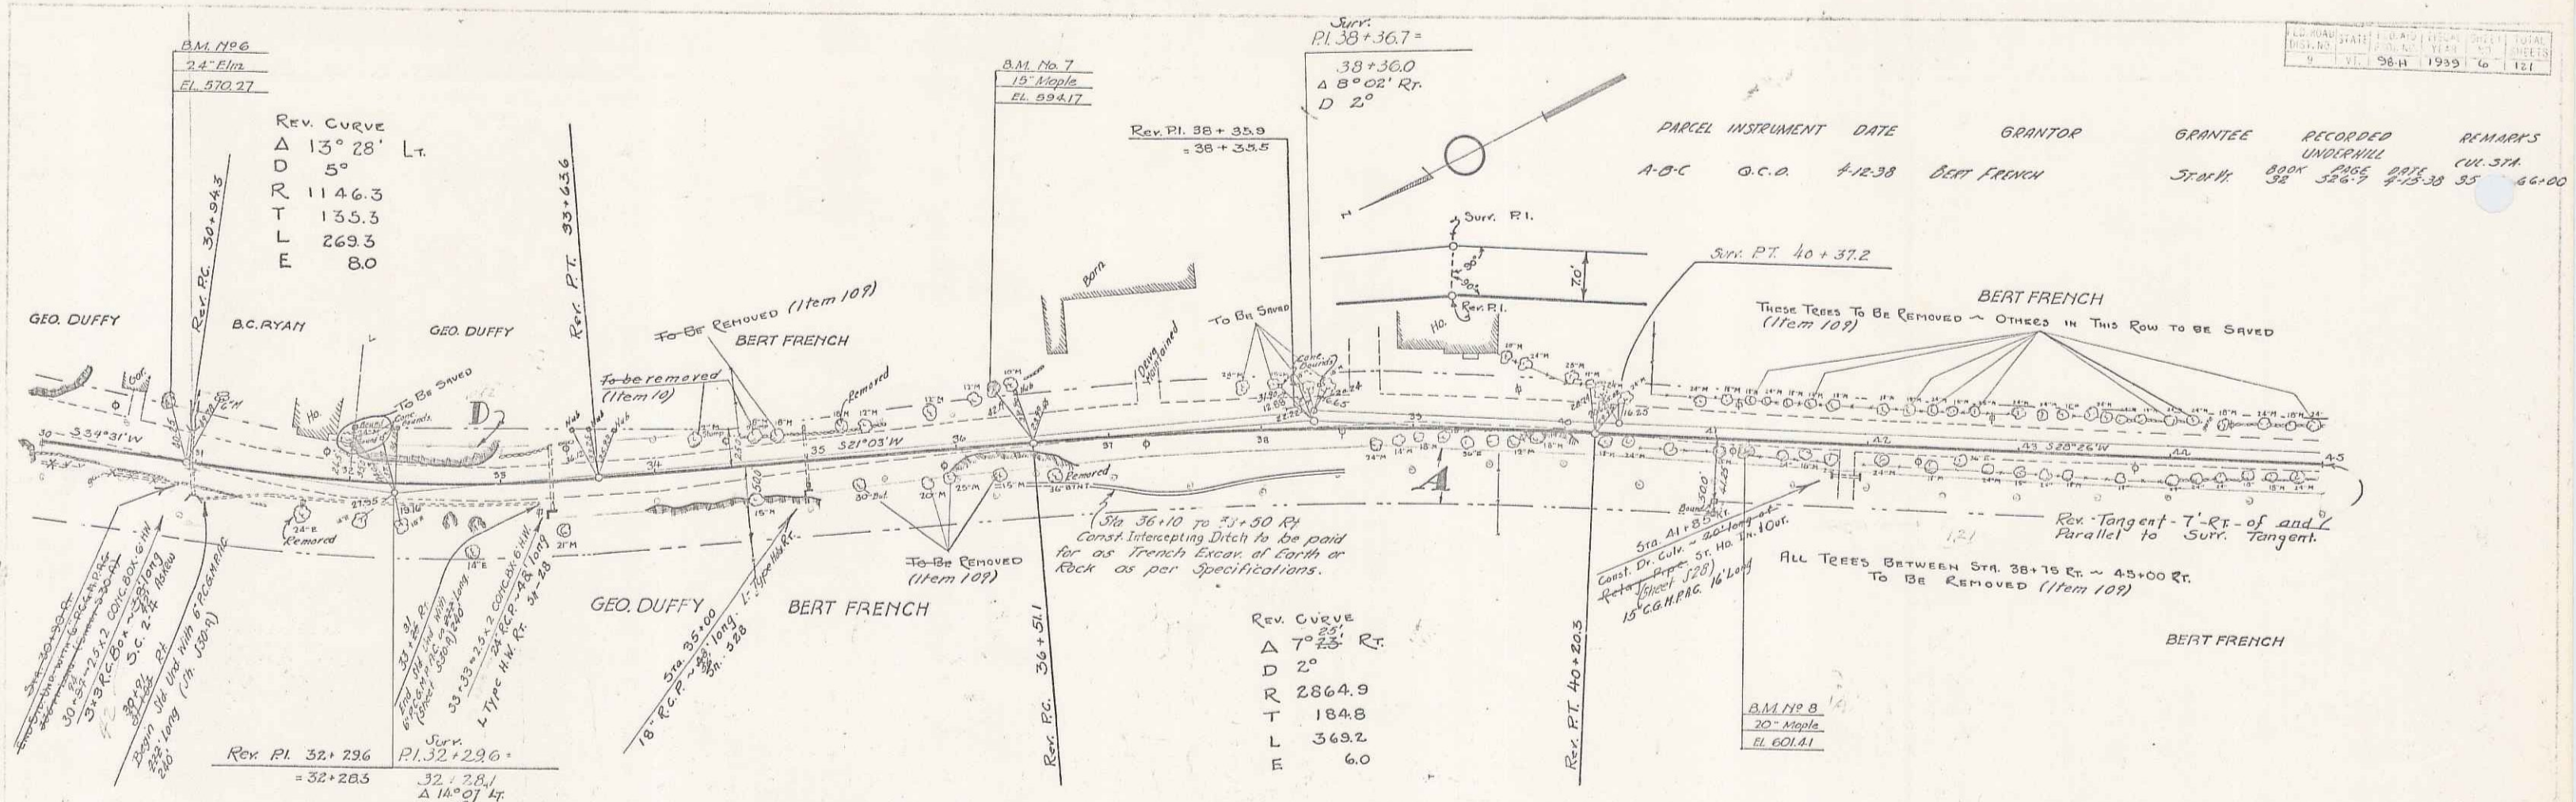

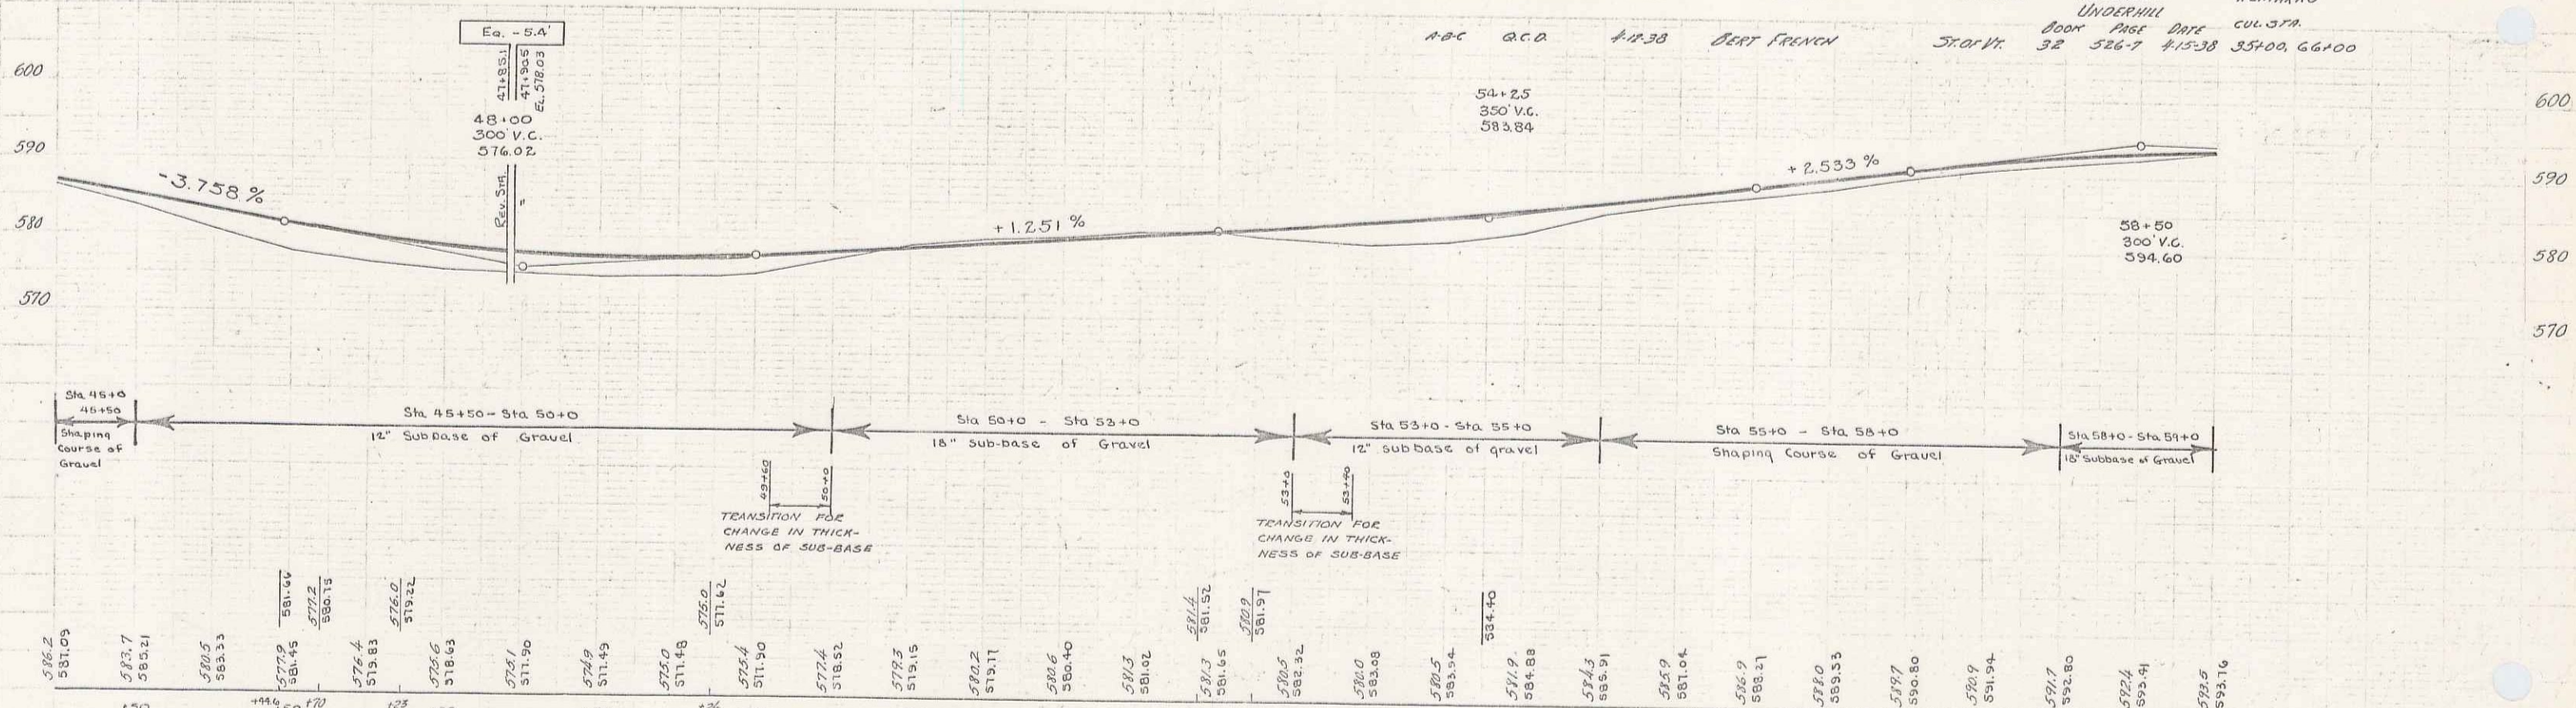
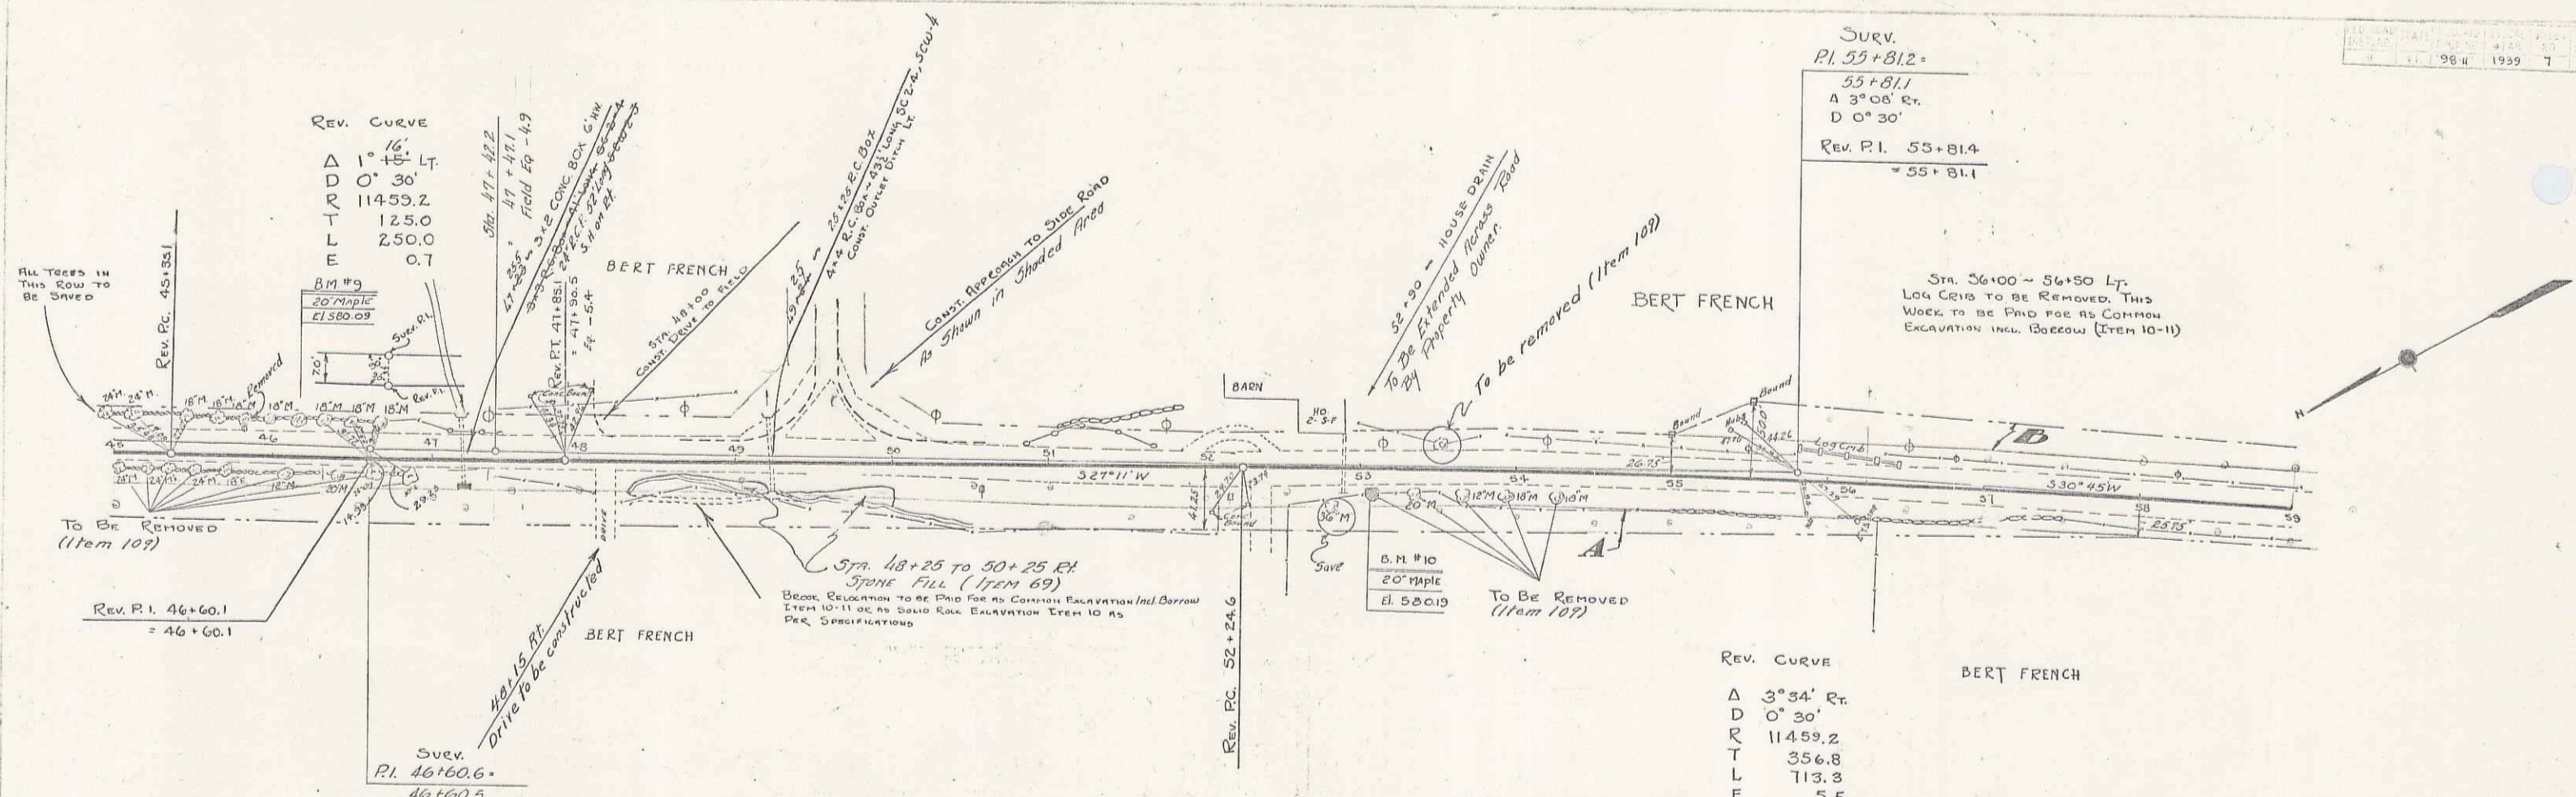


Station	Elevation
45+00	581.09
45+10	583.7
45+20	585.21
45+30	587.5
45+40	589.33
45+50	591.45
45+60	593.72
45+70	595.15
45+80	596.4
45+90	597.83
46+00	599.0
46+10	600.63
46+20	601.9
46+30	603.43
46+40	604.9
46+50	606.43
46+60	607.9
46+70	609.43
46+80	610.9
46+90	612.43
47+00	613.9
47+10	615.43
47+20	616.9
47+30	618.43
47+40	619.9
47+50	621.43
47+60	622.9
47+70	624.43
47+80	625.9
47+90	627.43
48+00	628.9
48+10	630.43
48+20	631.9
48+30	633.43
48+40	634.9
48+50	636.43
48+60	637.9
48+70	639.43
48+80	640.9
48+90	642.43
49+00	643.9
49+10	645.43
49+20	646.9
49+30	648.43
49+40	649.9
49+50	651.43
49+60	652.9
49+70	654.43
49+80	655.9
49+90	657.43
50+00	658.9
50+10	660.43
50+20	661.9
50+30	663.43
50+40	664.9
50+50	666.43
50+60	667.9
50+70	669.43
50+80	670.9
50+90	672.43
51+00	673.9
51+10	675.43
51+20	676.9
51+30	678.43
51+40	679.9
51+50	681.43
51+60	682.9
51+70	684.43
51+80	685.9
51+90	687.43
52+00	688.9
52+10	690.43
52+20	691.9
52+30	693.43
52+40	694.9
52+50	696.43
52+60	697.9
52+70	699.43
52+80	700.9
52+90	702.43
53+00	703.9
53+10	705.43
53+20	706.9
53+30	708.43
53+40	709.9
53+50	711.43
53+60	712.9
53+70	714.43
53+80	715.9
53+90	717.43
54+00	718.9
54+10	720.43
54+20	721.9
54+30	723.43
54+40	724.9
54+50	726.43
54+60	727.9
54+70	729.43
54+80	730.9
54+90	732.43
55+00	733.9
55+10	735.43
55+20	736.9
55+30	738.43
55+40	739.9
55+50	741.43
55+60	742.9
55+70	744.43
55+80	745.9
55+90	747.43
56+00	748.9
56+10	750.43
56+20	751.9
56+30	753.43
56+40	754.9
56+50	756.43
56+60	757.9
56+70	759.43
56+80	760.9
56+90	762.43
57+00	763.9
57+10	765.43
57+20	766.9
57+30	768.43
57+40	769.9
57+50	771.43
57+60	772.9
57+70	774.43
57+80	775.9
57+90	777.43
58+00	778.9
58+10	780.43
58+20	781.9
58+30	783.43
58+40	784.9
58+50	786.43
58+60	787.9
58+70	789.43
58+80	790.9
58+90	792.43
59+00	793.9
59+10	795.43
59+20	796.9
59+30	798.43
59+40	799.9
59+50	801.43
59+60	802.9
59+70	804.43
59+80	805.9
59+90	807.43
60+00	808.9



B.M. No. 9 - spike in root of 20m. maple 14 ft left of Sta. 46+26 - elevation: 580.09.
 B.M. No. 10 - spike in root of 20m. maple 13 ft right of Sta. 53+07 - elevation: 580.19.

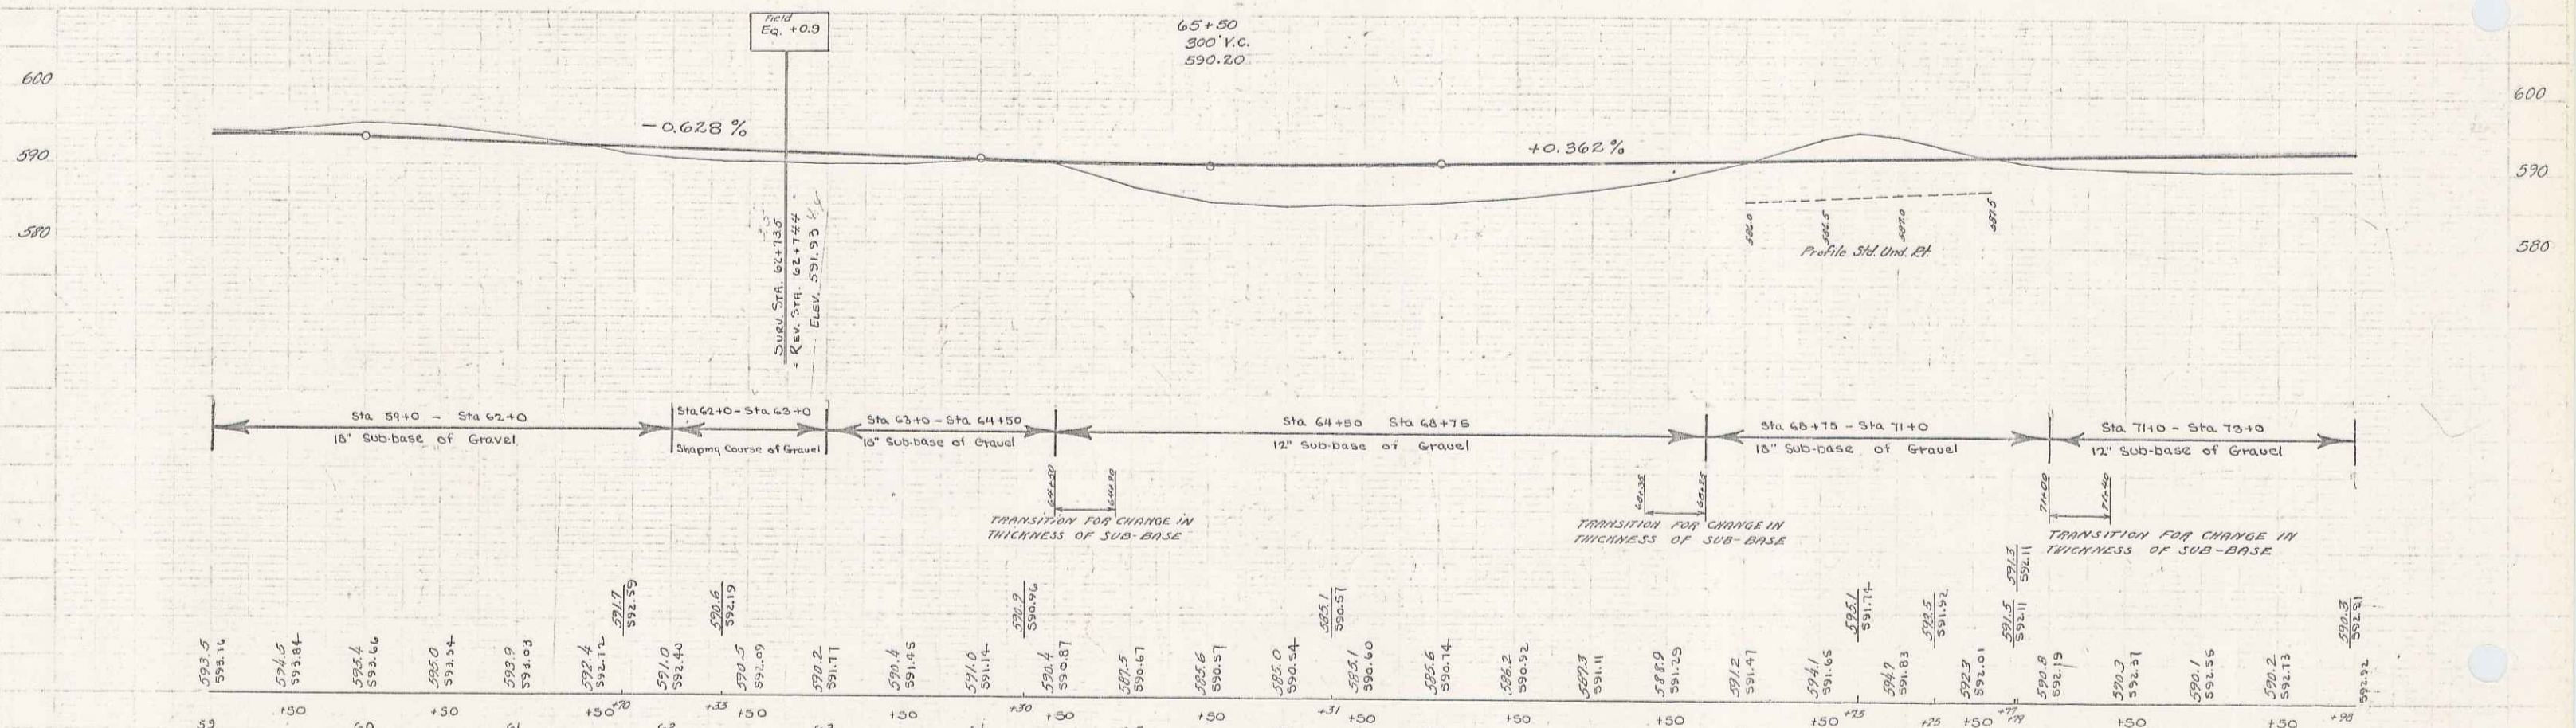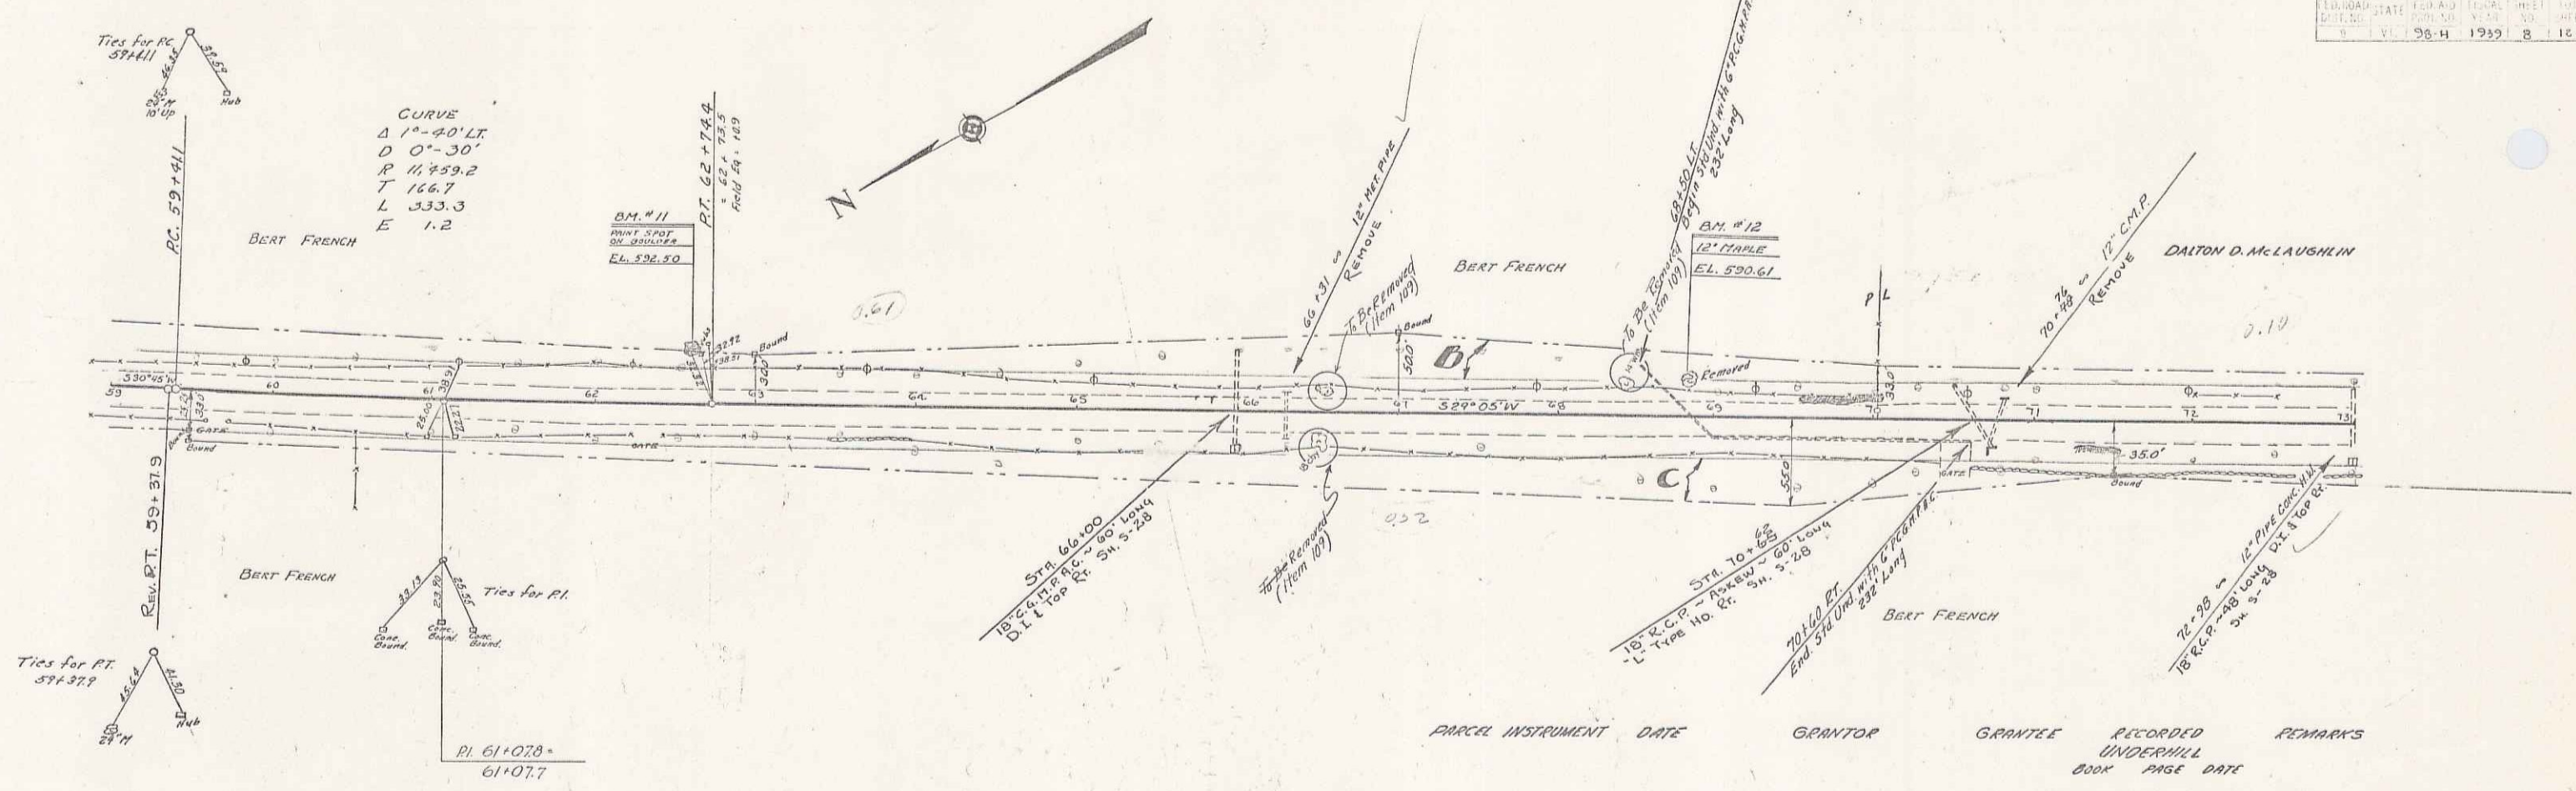

B.M. No 11 - point spot on boulder 29 ft. left of sta. 62+61 - elevation: 592.50.
 B.M. No 12 - spike in root of 12' maple 16 ft. left of sta. 63+82 - elevation: 590.61.

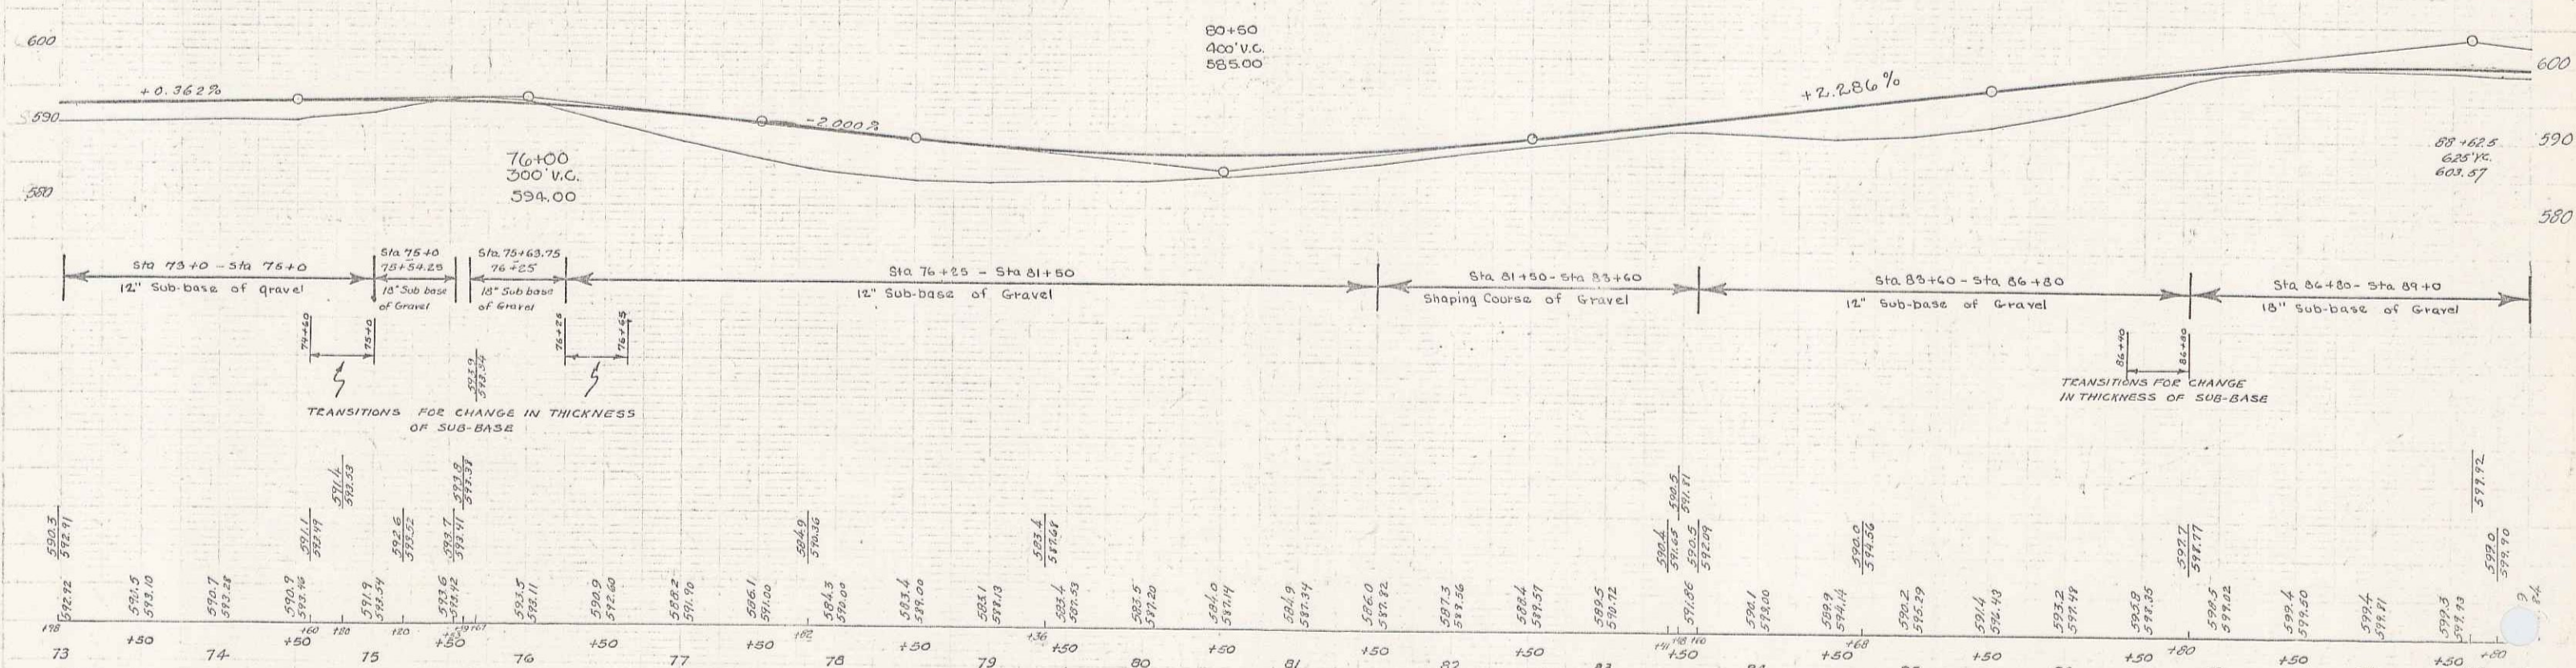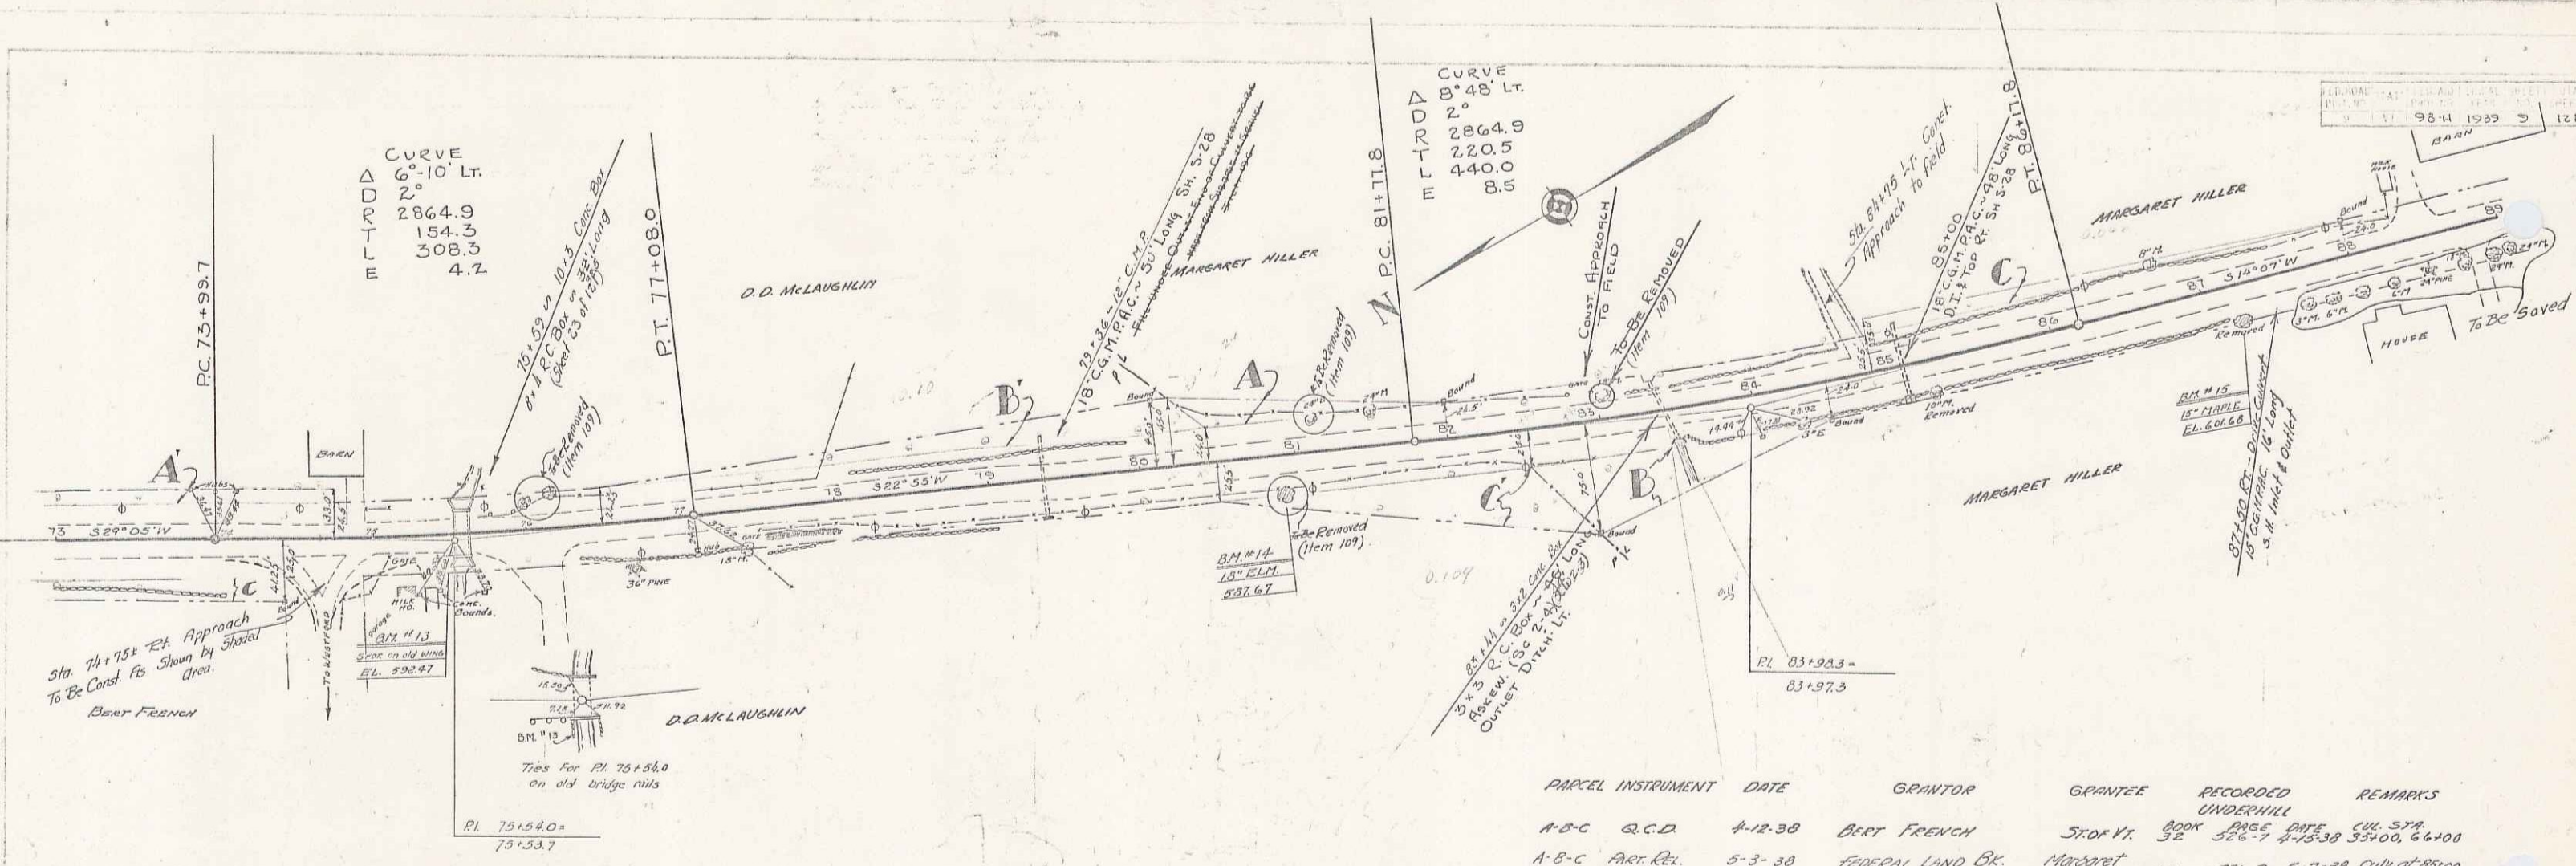

BM N° 13 - paint spot on wing of conc. bridge @ right of sta. 75+50. Elevation: 592.47 -
 BM N° 14 - nail in root of 18" elm 25' right of sta. 80+90. Elevation: 587.67 -
 BM N° 15 - nail in root of 15" maple 25' right of sta. 81+75. Elevation: 601.68 -

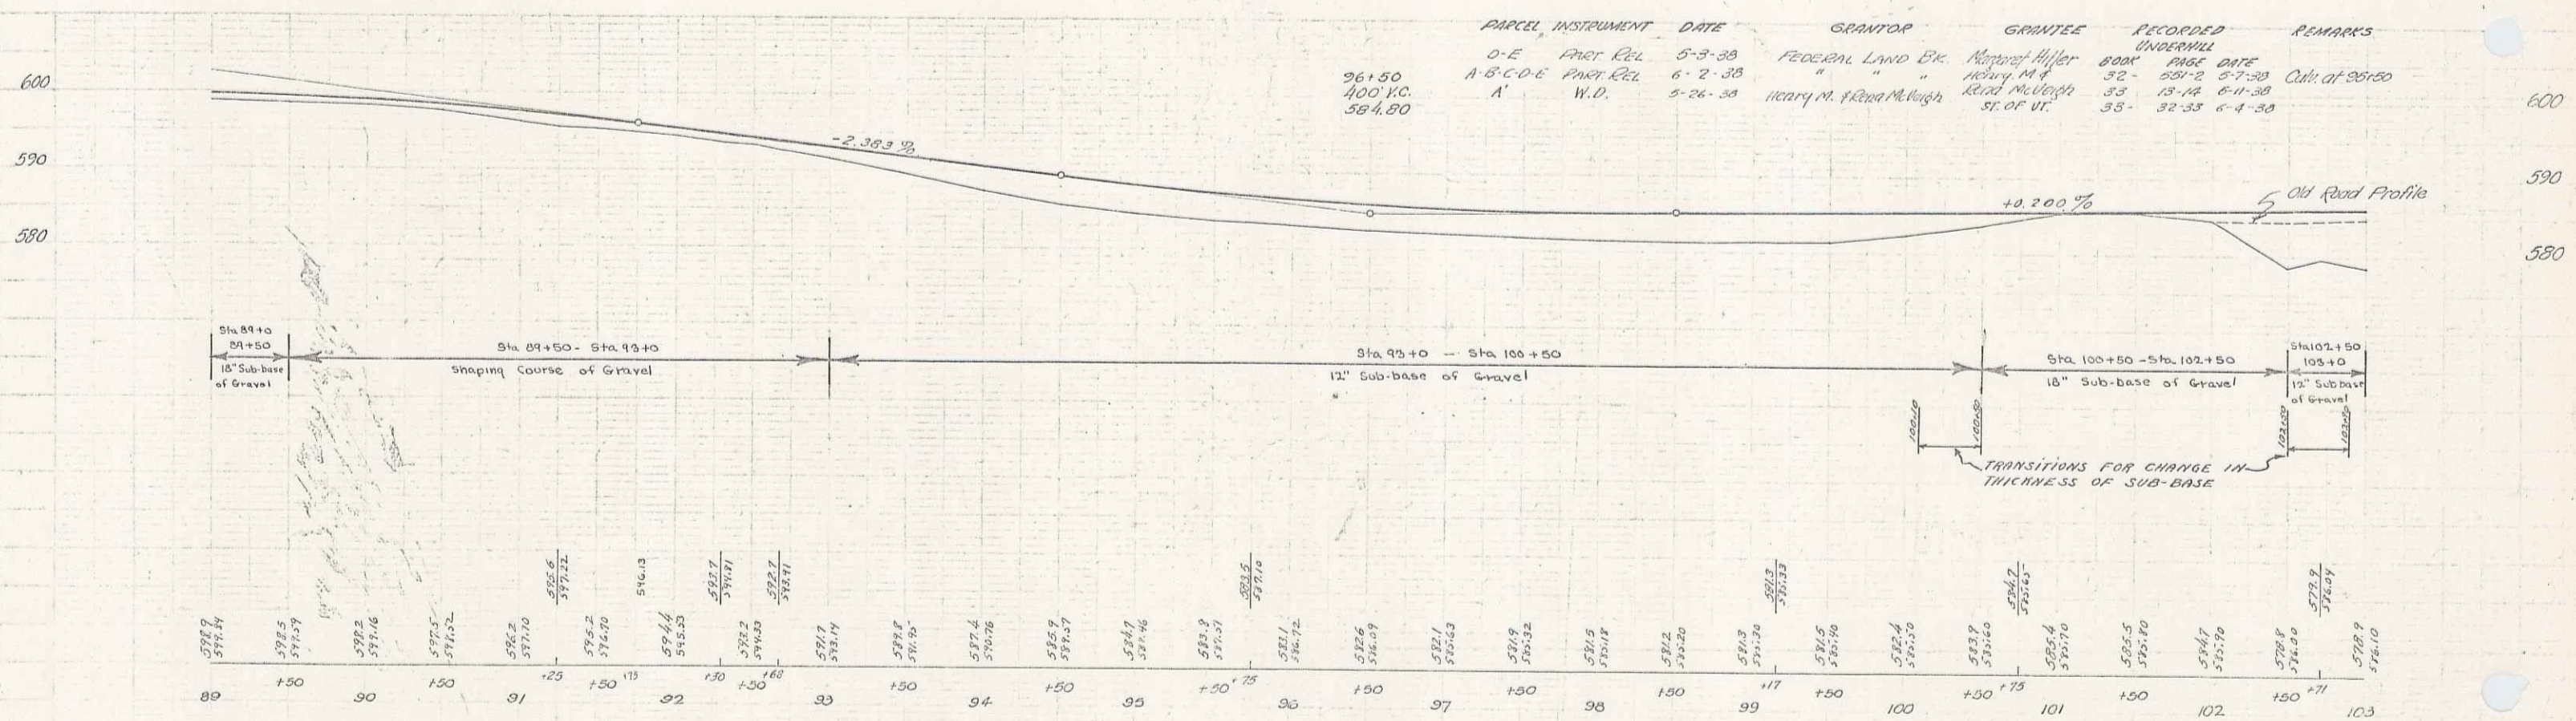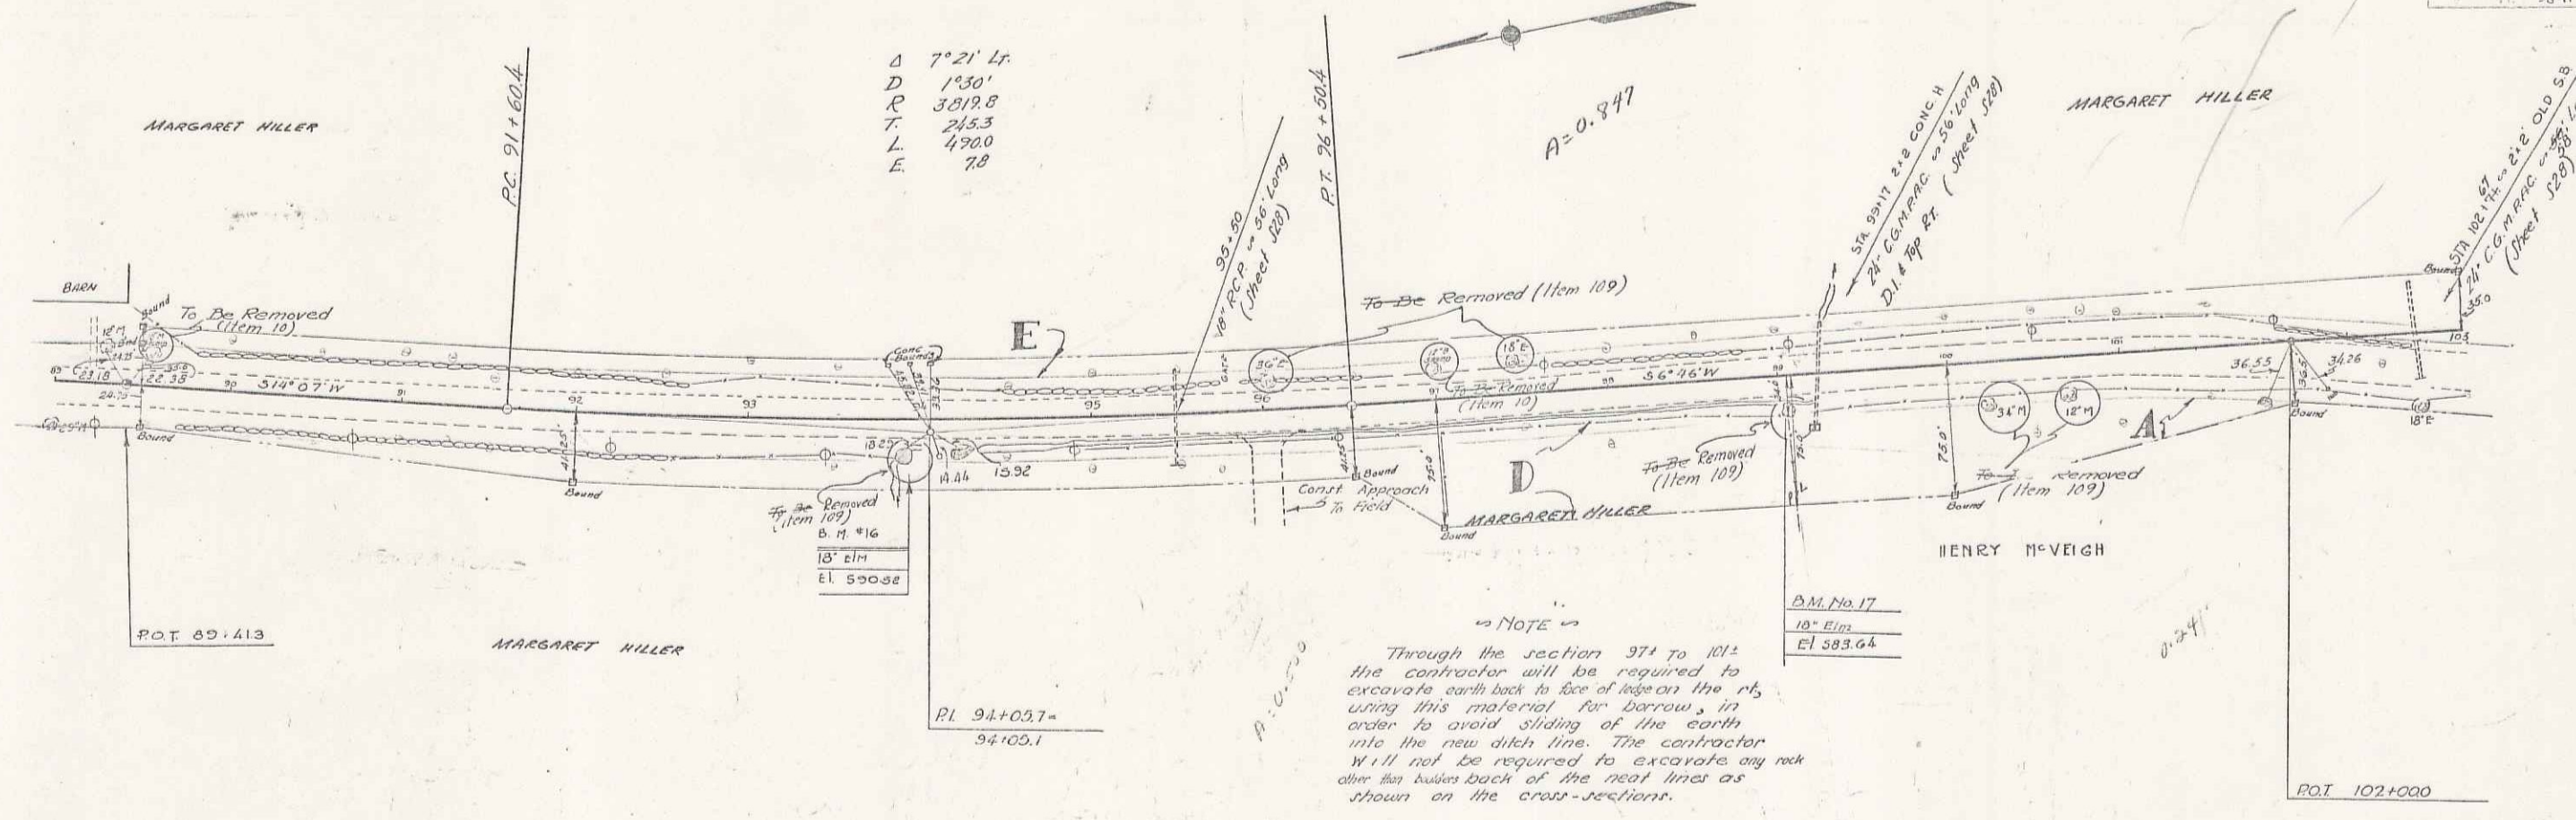

BM No 16 - spike in root of 18" elm 18 ft right of sta. 93+91. Elevation: 590.52 -
 BM No 17 - spike in root of 18" elm 20 ft right of sta. 93+02. Elevation: 583.64 -

WD 12/7/81 Book 50 Pg 346

LAND ~~TO BE~~ QUIT CLAIMED TO TOWN OF
UNDERHILL BY STATE OF VERMONT,
FORMERLY VT. RTE. 15 (0.92 A±)


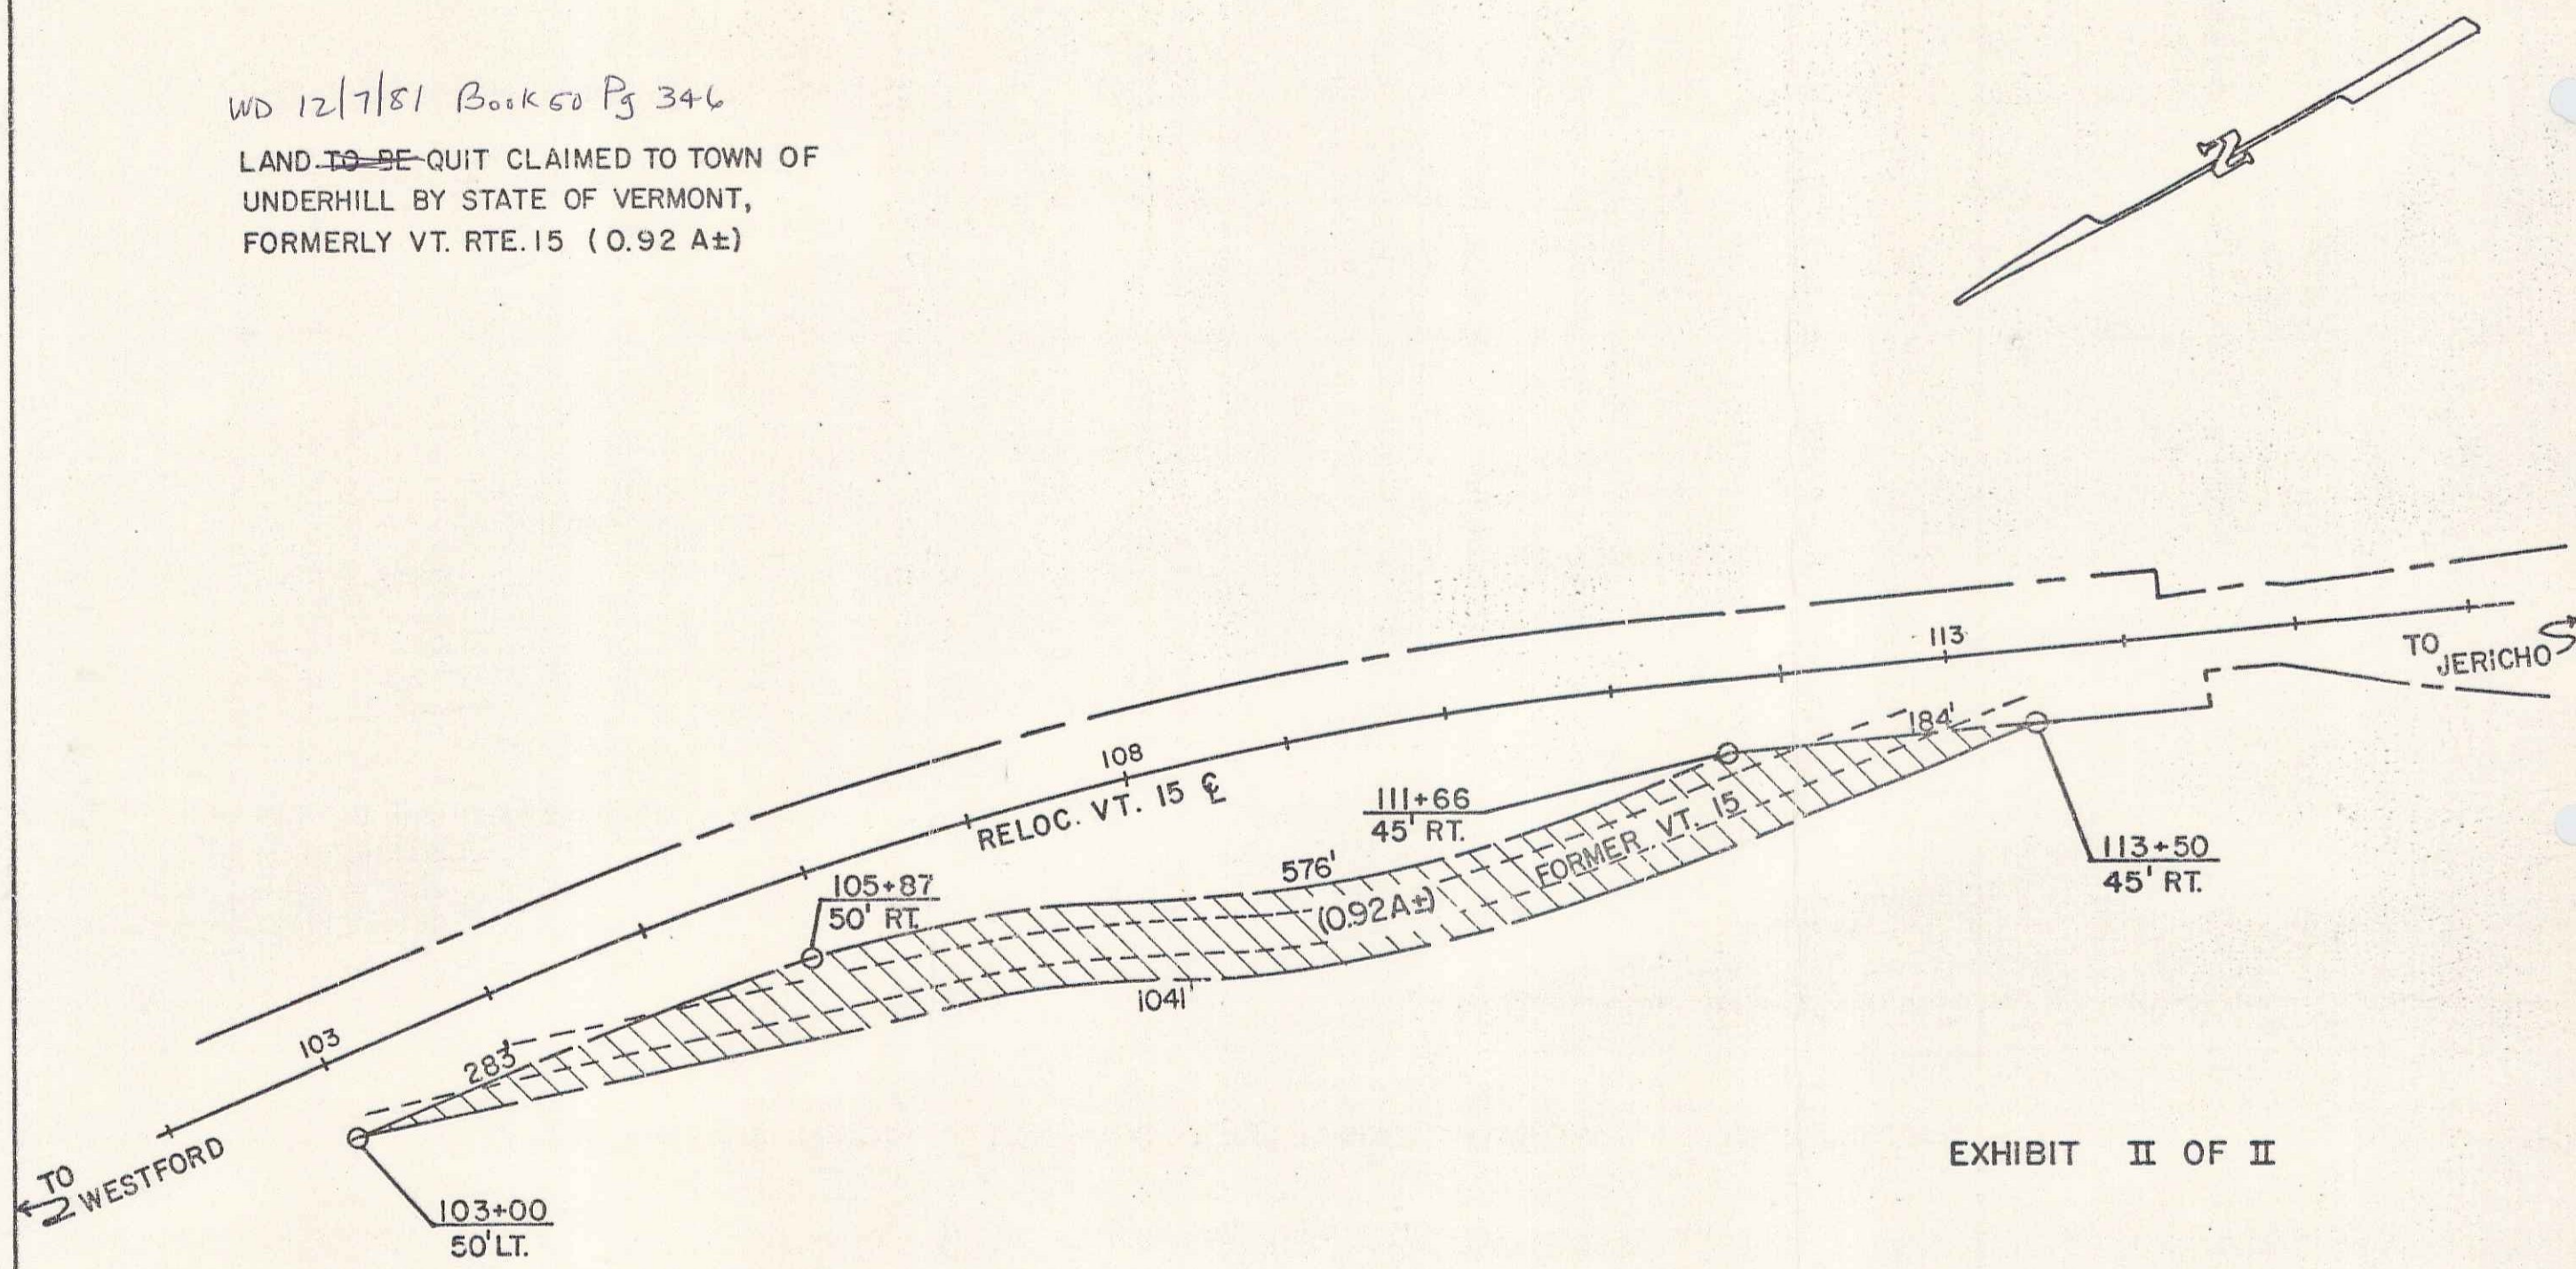


EXHIBIT II OF II

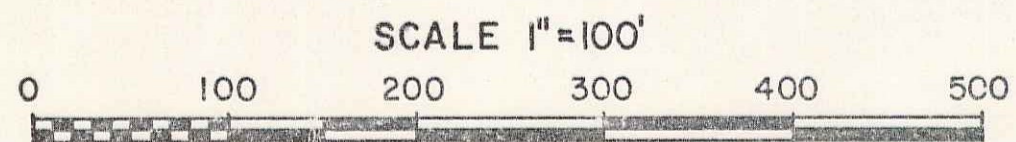


REF. FAP NO. 98H SHEET NO. 11A		
STATE OF VERMONT		
AGENCY OF TRANSPORTATION		
TOWN OF UNDERHILL		
PROJECT WESTFORD-UNDERHILL FAP. 98H		
APPROX. SCALE 1"=100'	DATE 10/26/81	DRAWN BY FJM

Sheet 112 11

NOTE
Any poor foundation material encountered sta 105+ to 108+ is to be removed and replaced with acceptable borrow or excavation. This work is to be paid for under the item of Common Excavation including Borrow (Item 10-11).

NOTE
All rock encountered in excavation between Sta 104+ to Sta 114+ is to be used in the bottom of the fill Sta 104+ to 110+. And paid for when excavated only.

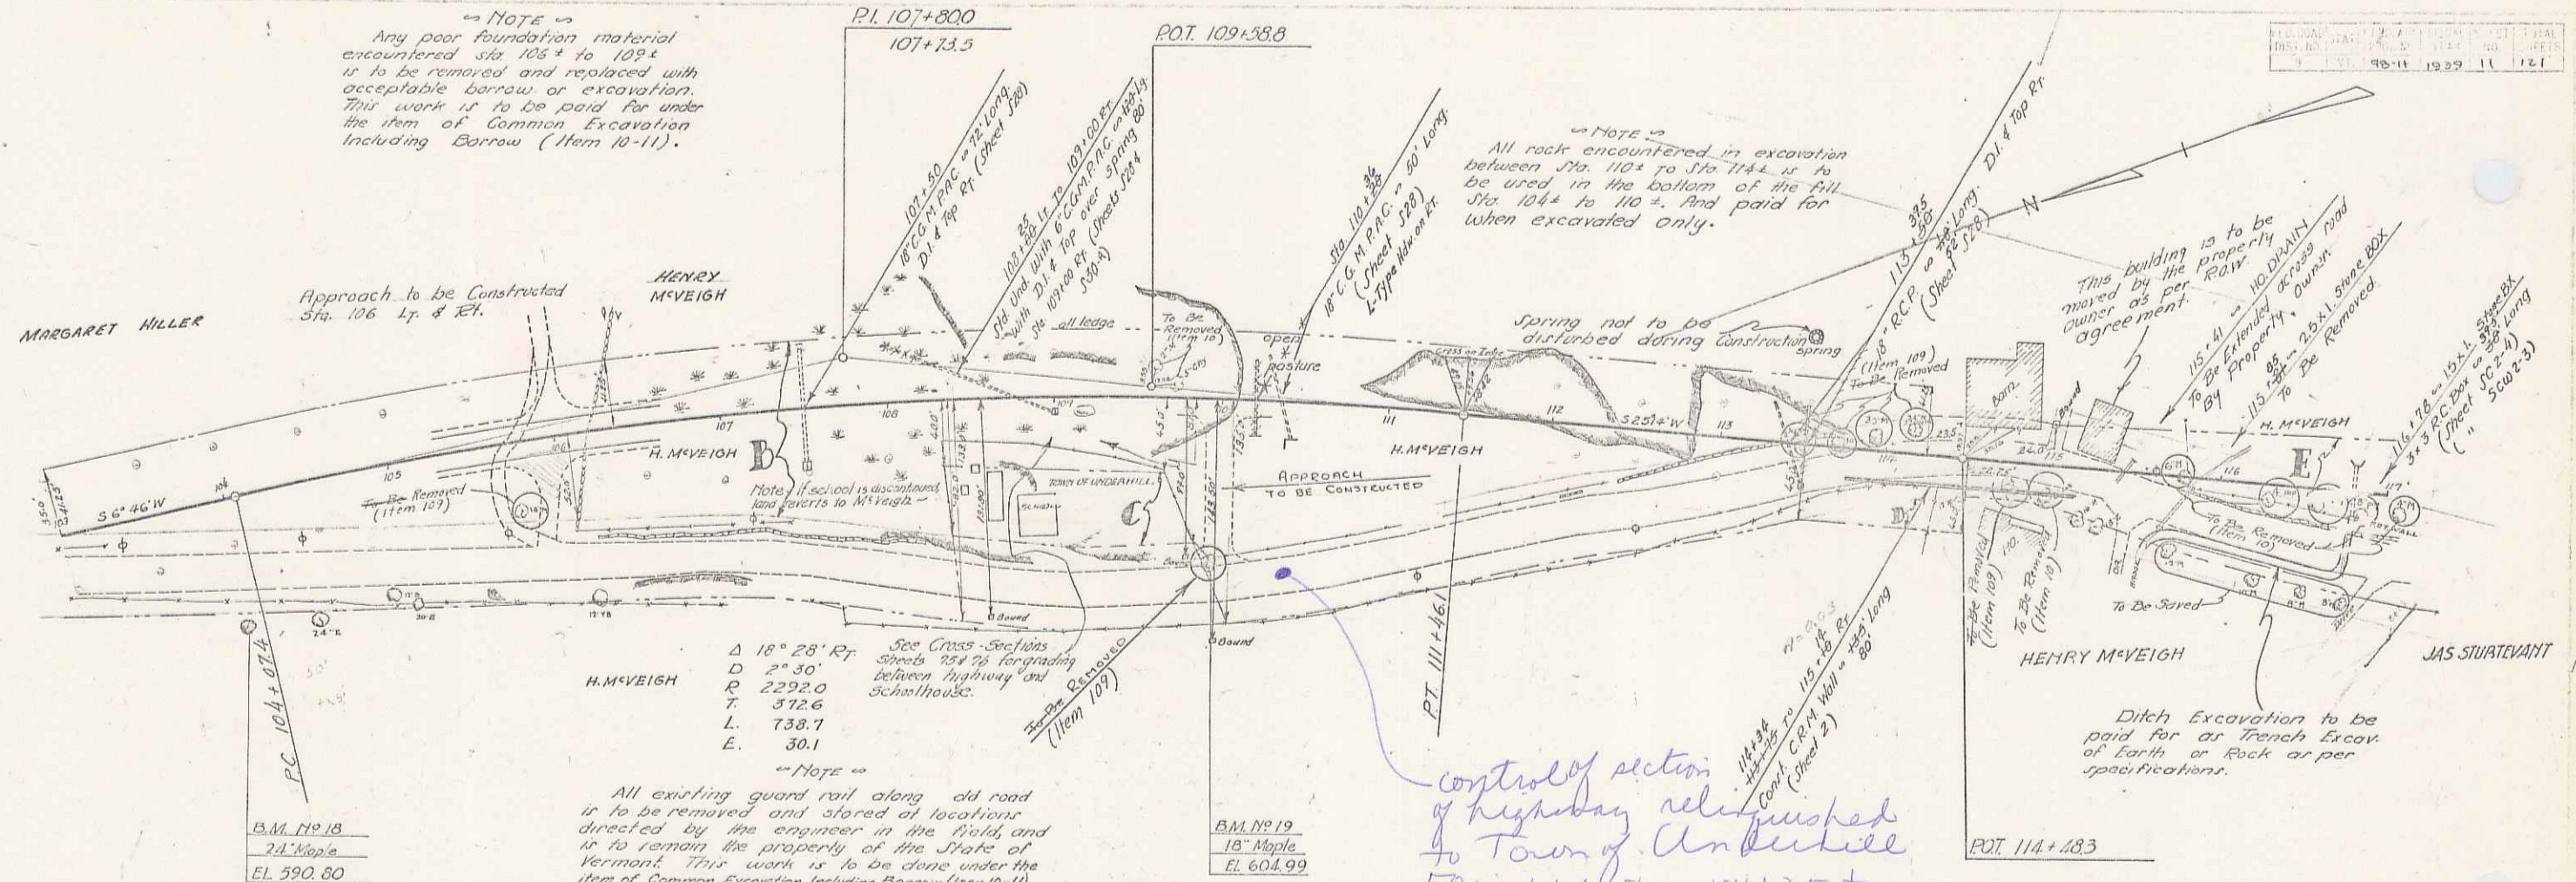


B.M. N° 18
24" Maple
EL. 590.80

B.M. N° 19
18" Maple
EL. 604.99



NOTE
All existing guard rail along old road is to be removed and stored at location directed by the engineer in the field, and is to remain the property of the State of Vermont. This work is to be done under the item of Common Excavation including Borrow (Item 10-11).

Control of section of highway relinquished to Town of Underhill
50' right of Sta 104+25 to 45' right of Sta 112+66
7/21/32 BK 33 Pg 132

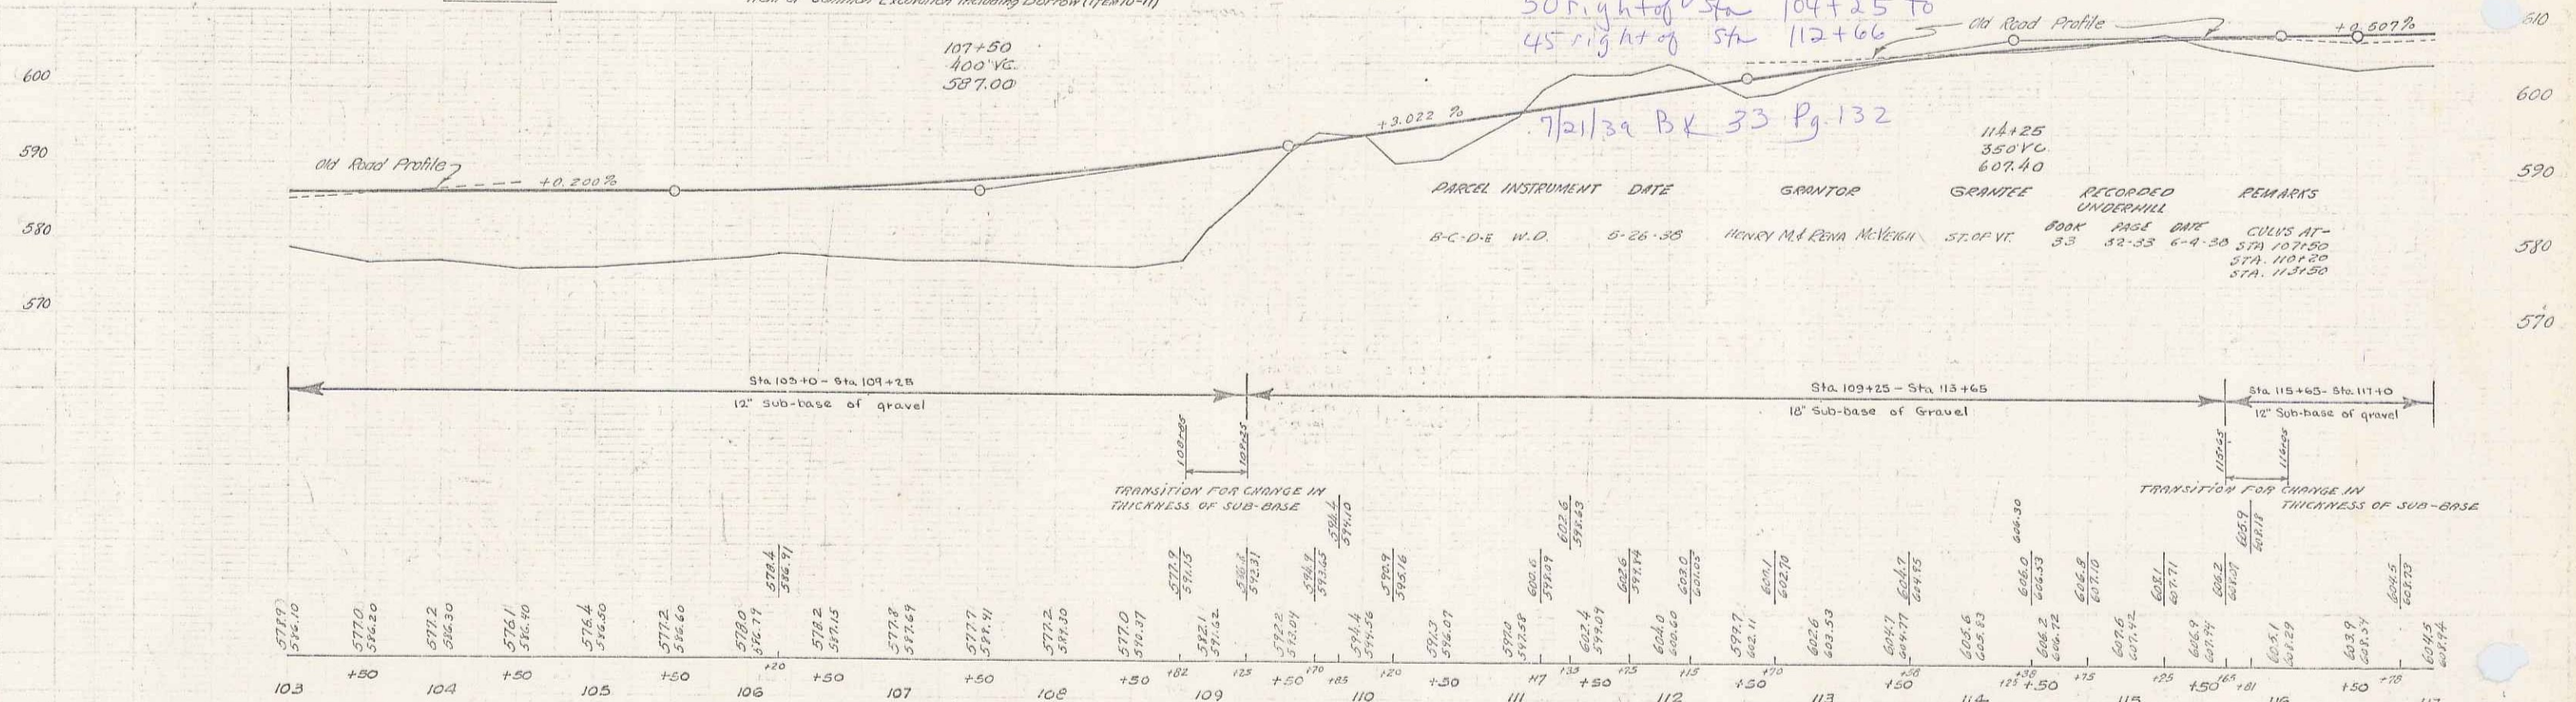

PARCEL INSTRUMENT DATE	GRANTOR	GRANTEE	RECORDED UNDERHILL	REMARKS
B-C-D-E W.D.	5-26-35	HENRY M. & RENA McVEIGH	ST. OF VT. BOOK PAGE DATE 33 32-33 6-4-30	CULVS AT STA 107+00 STA 107+20 STA 113+50



B.M. N° 18: spot in root of 24" maple 60 ft right of sta. 104+00: Elevation: 590.80 -
B.M. N° 19: spot in root of 18" maple 100 ft right of sta. 110+00: Elevation: 604.99 -

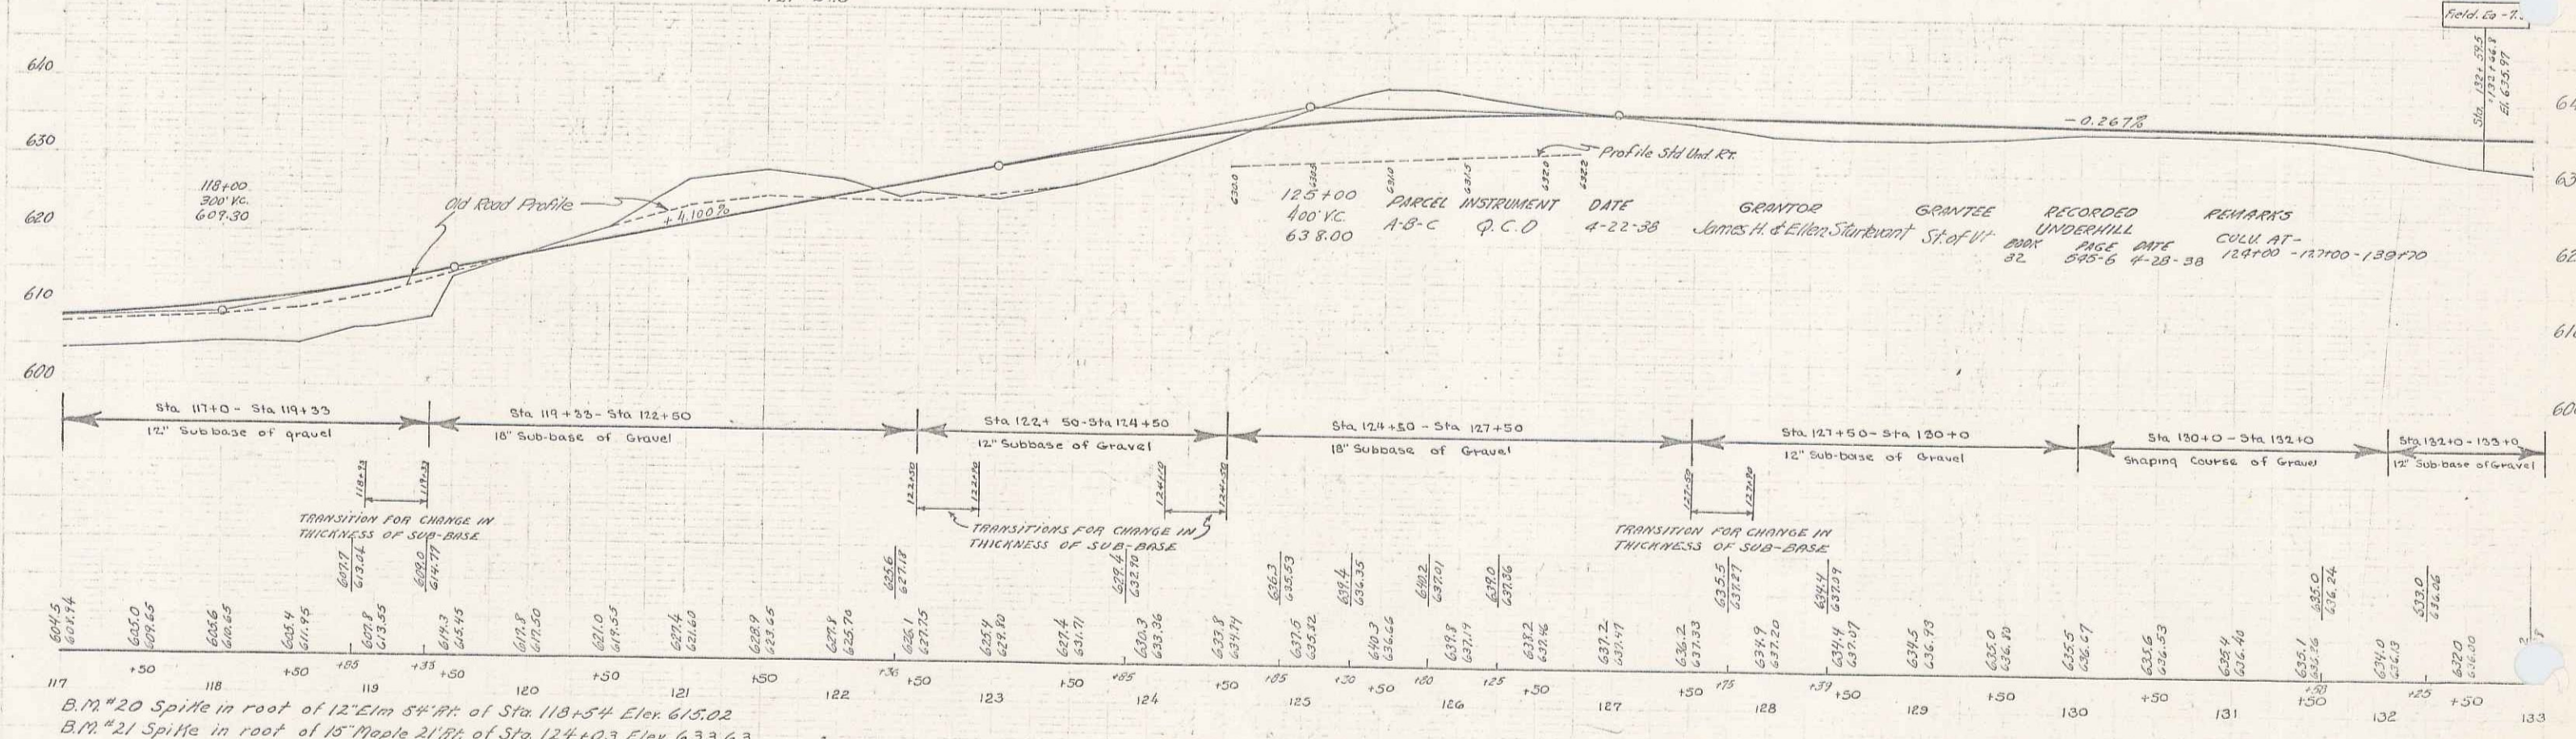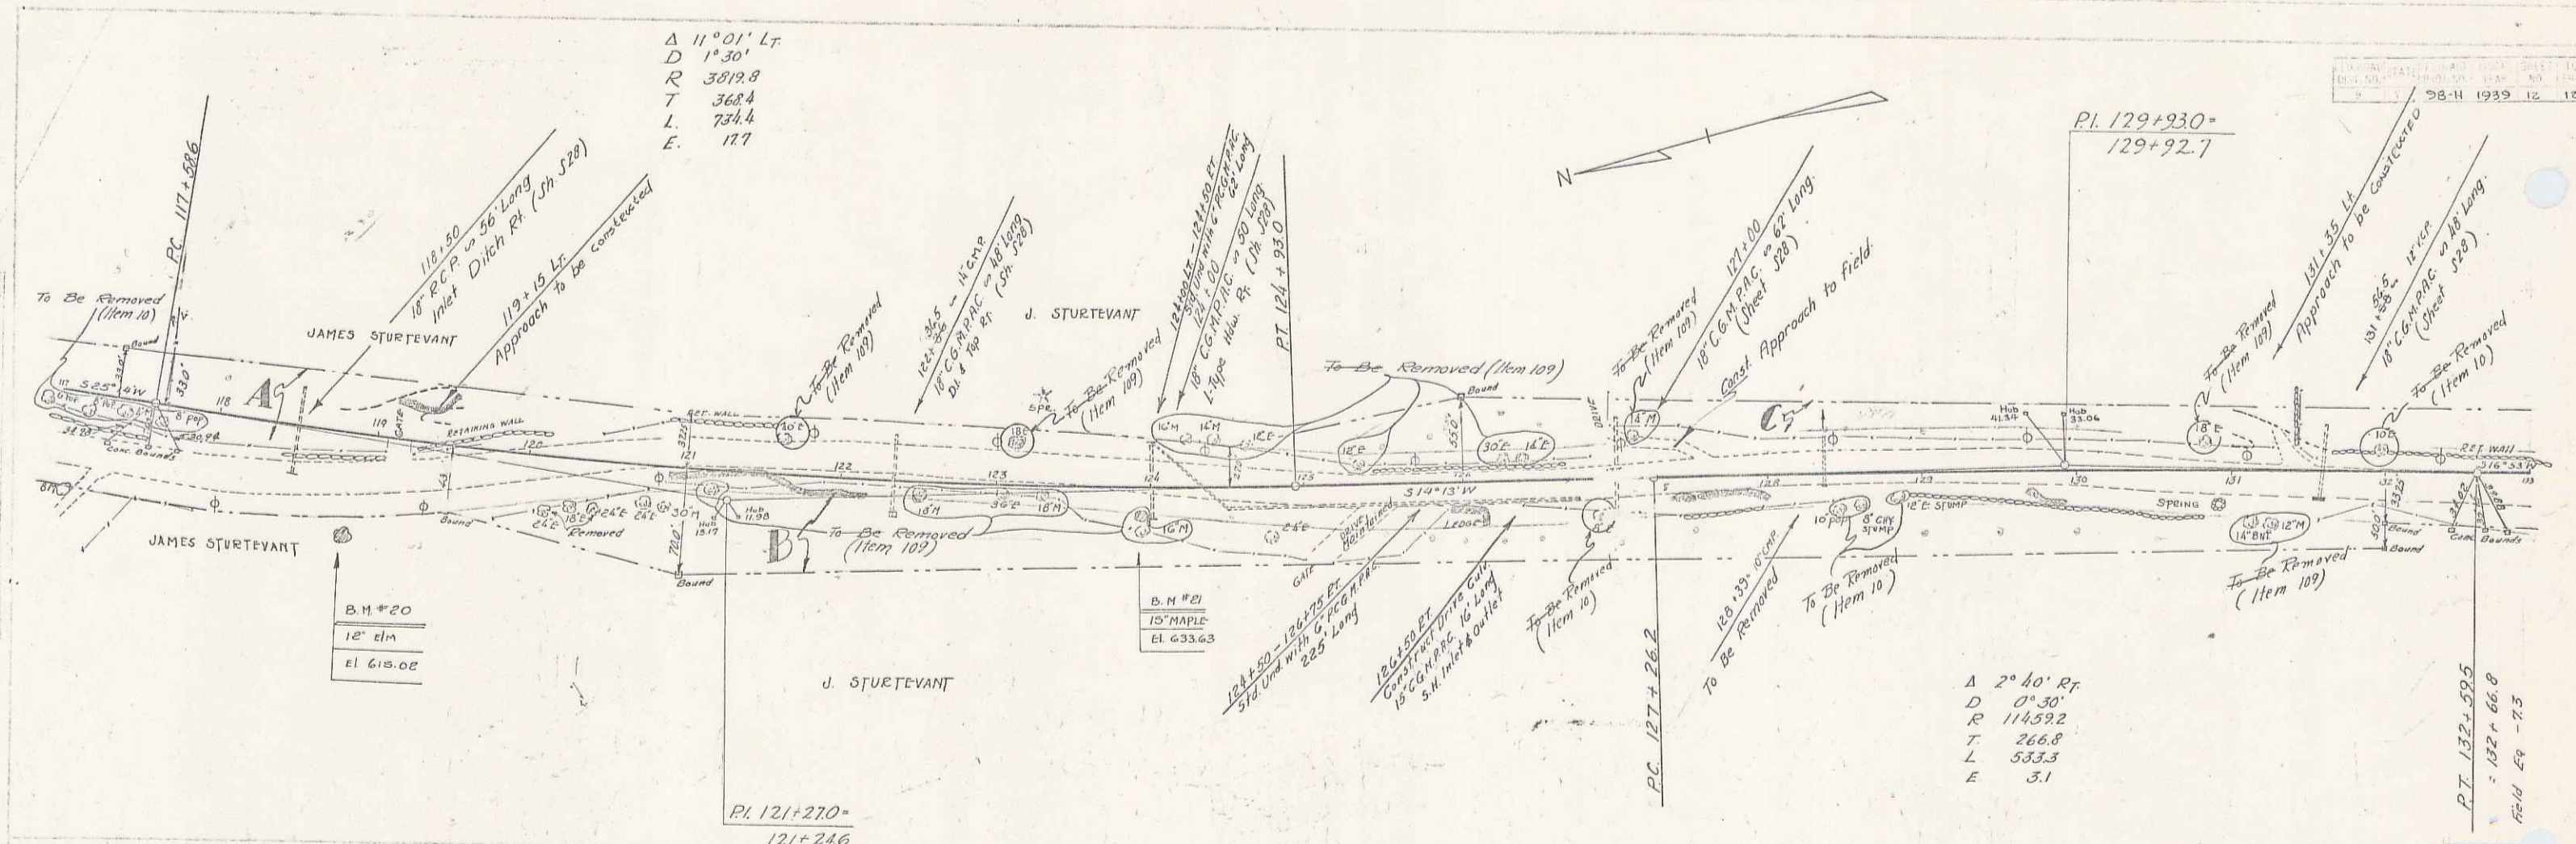

B.M. #20 Spike in root of 12" Elm 54' Rt. of Sta 118+54 Elev. 615.02
 B.M. #21 Spike in root of 15" Maple 21' Rt. of Sta 124+03 Elev. 633.63

STATION	PARCEL INSTRUMENT	DATE	GRANTOR	GRANTEE	RECORDED	REMARKS
123+00	400 VC	63 8.00	A-B-C	Q.C.D	4-22-38	James H. & Ellen Sturtevant St. of W
					BOOK PAGE DATE	UNDERHILL 32 645-6 4-28-38
						COLL. AT - 124+00 - 12700 - 138+70

38-H 1939 12 12.1

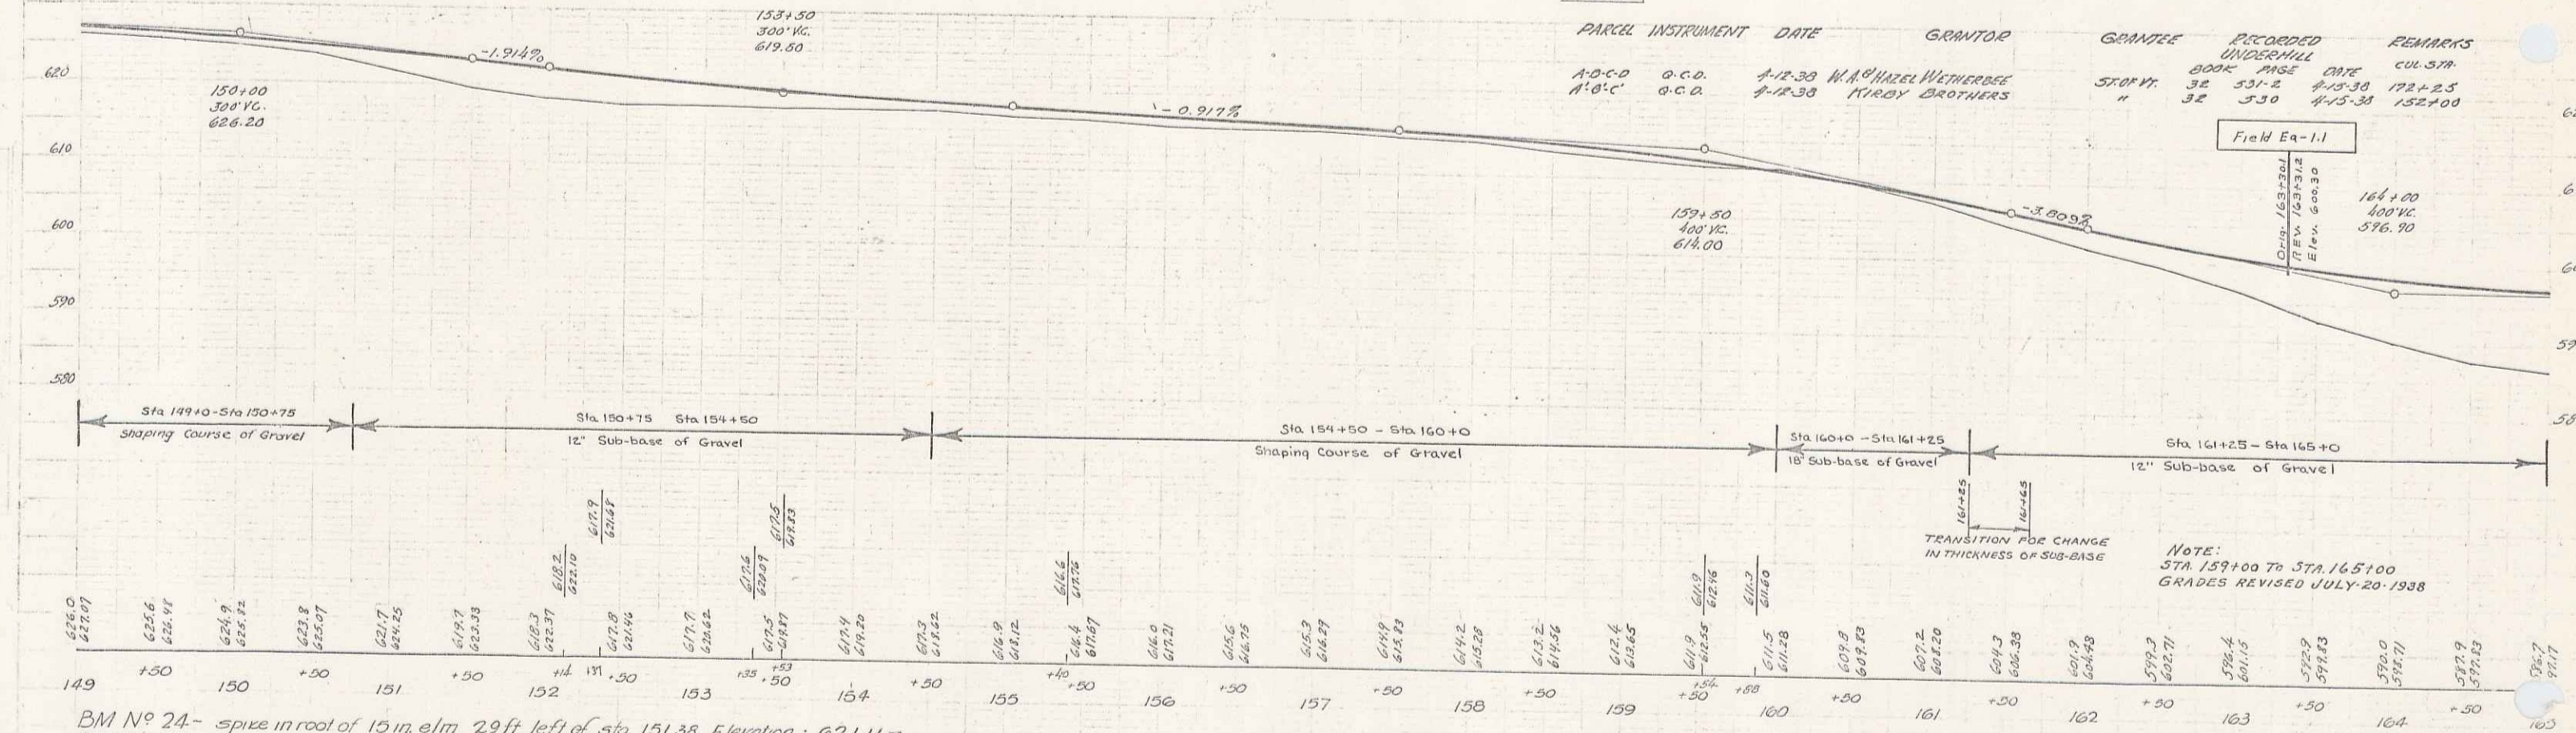
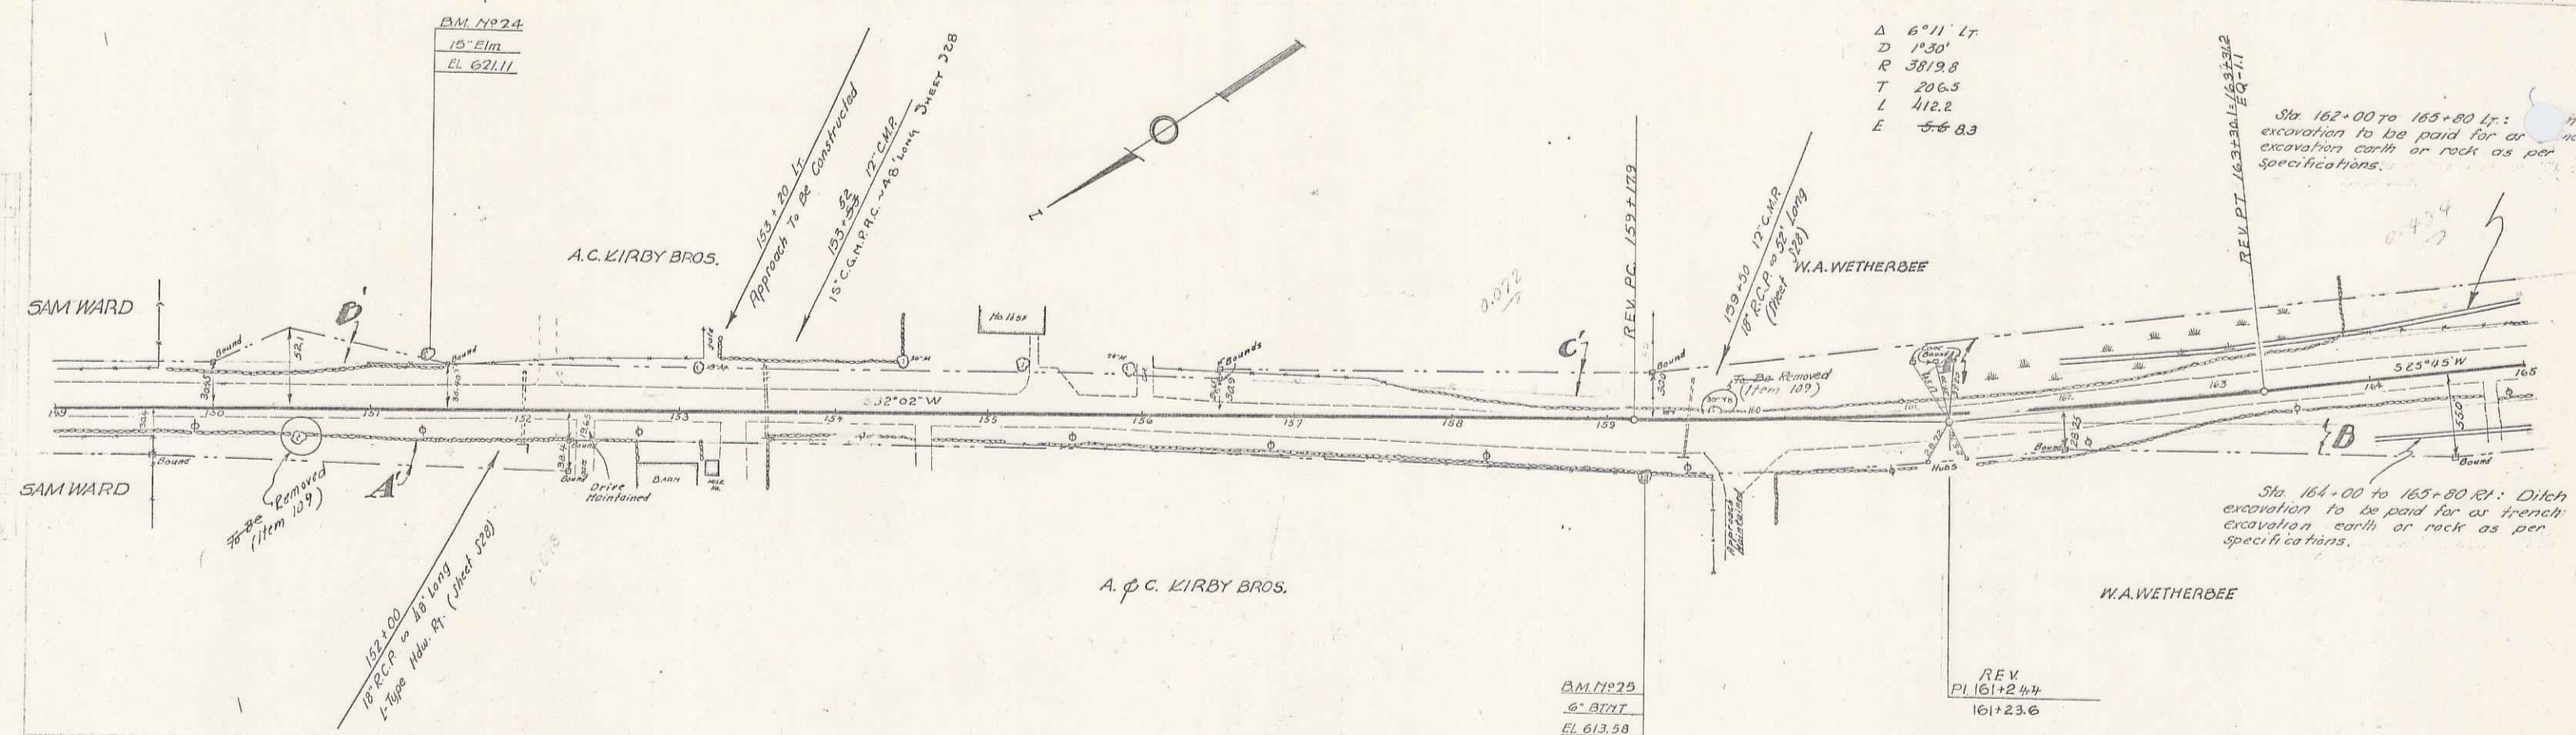


BM No 24 - spike in root of 15 in. elm 29 ft left of sta. 151.38. Elevation: 621.11 -
 BM No 25 - " " " 6 in butternut 34 ft right of sta. 159+20. Elevation: 613.58 -

15



PARCEL	INSTRUMENT	DATE	GRANTOR	GRANTEE	RECORDED	REMARKS
A-B-C-D	O.C.O.	4-12-38	W.A. HAZEL WETHERBEE	ST. 171	BOOK PAGE DATE	CUL. STA.
A-B-C-D	O.C.O.	4-12-38	H.M. DAVIS	"	32 528-9 4-15-38	172+00, 174+00, 172+00, 174+00

SCALE	STATE	FED. AID	PROJECT	DATE	SHEET
1" = 40'	VT	98-11	1933	15	121

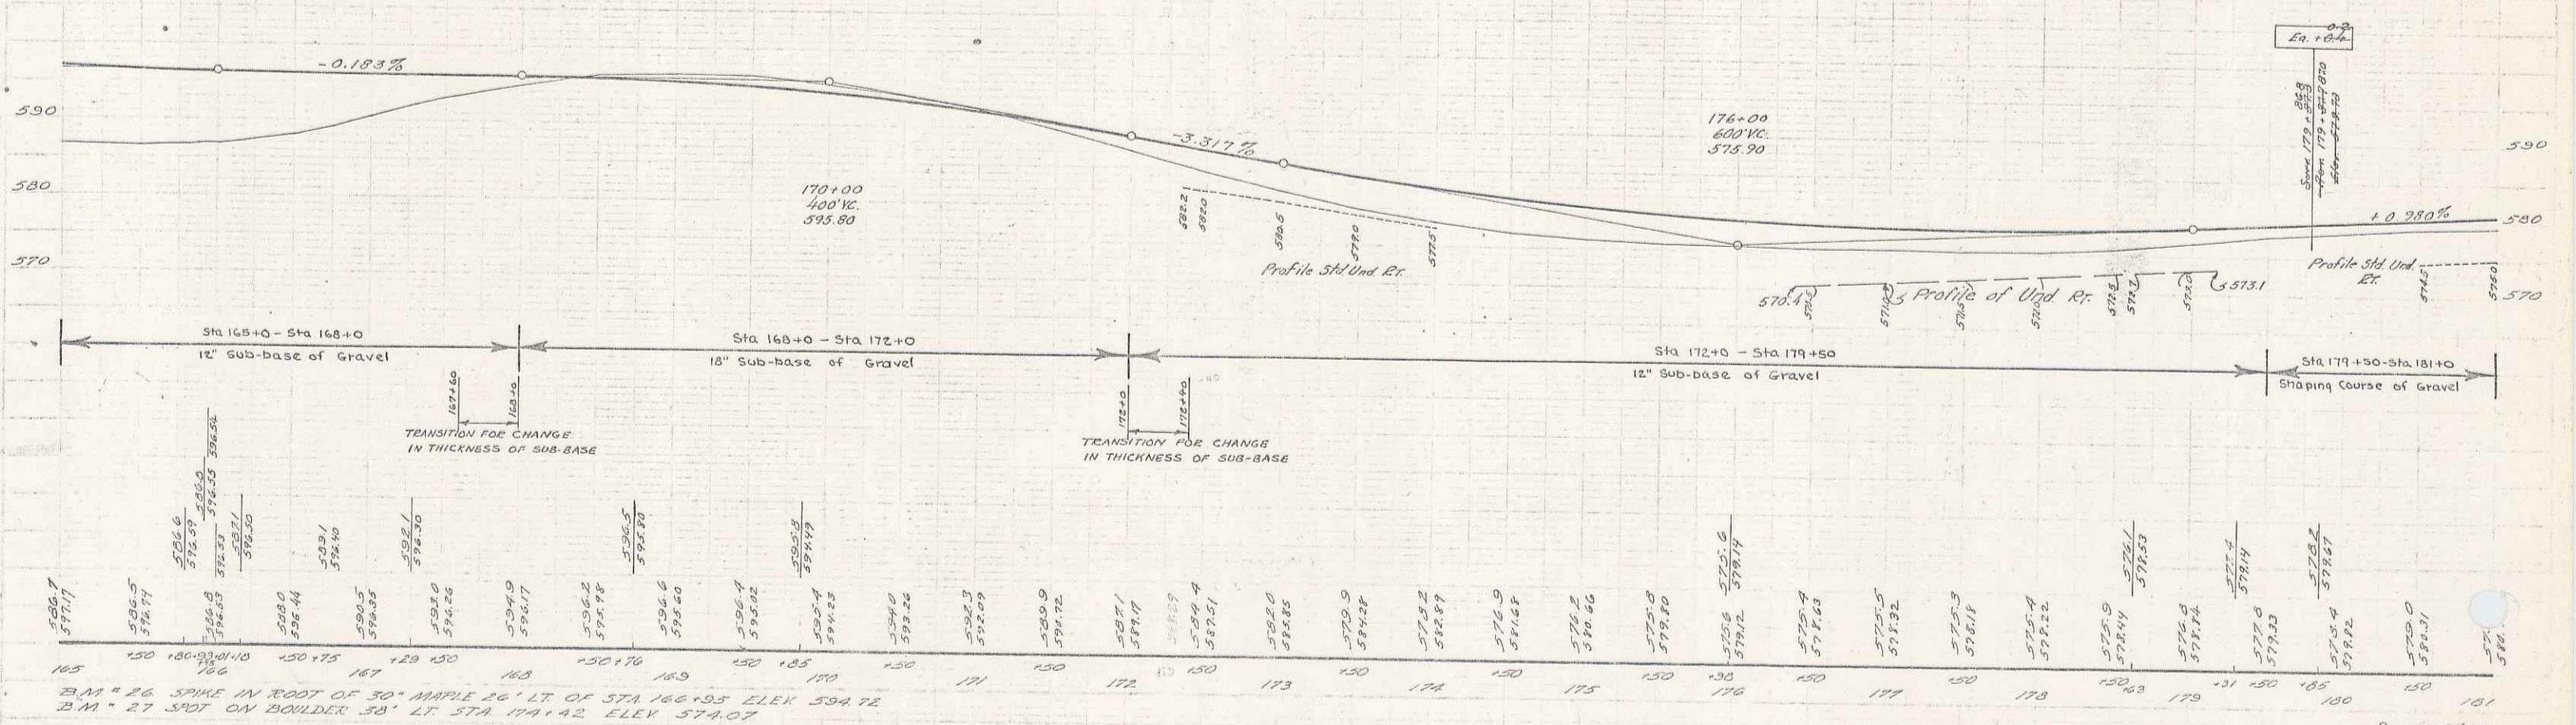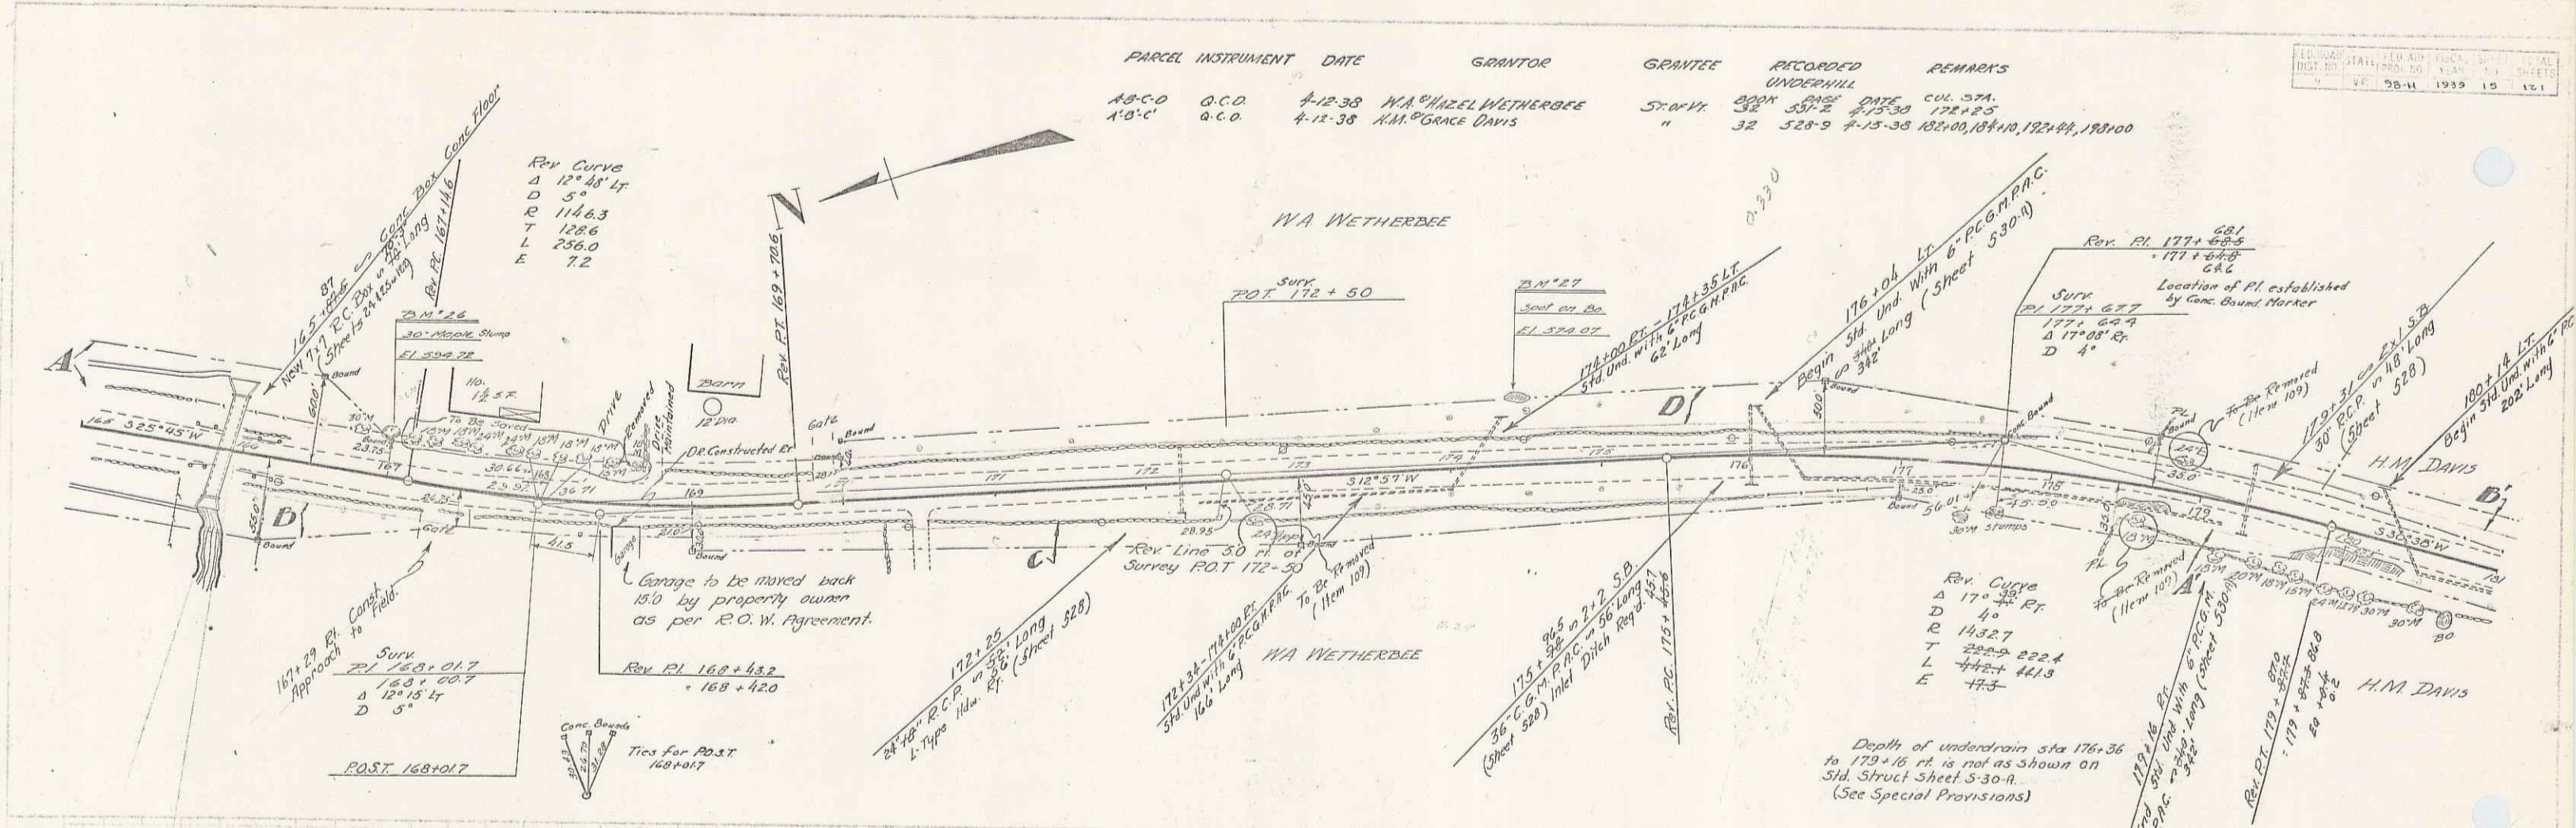

21 M * 26 SPIKE IN ROOT OF 30" MAPLE 26' LT. OF STA 166+53 ELEV 594.72
 21 M * 27 SPOT ON BOULDER 38' LT. STA 174+42 ELEV 574.07



SERIES P.R. 16 98H
 SHEET 15 OF 15

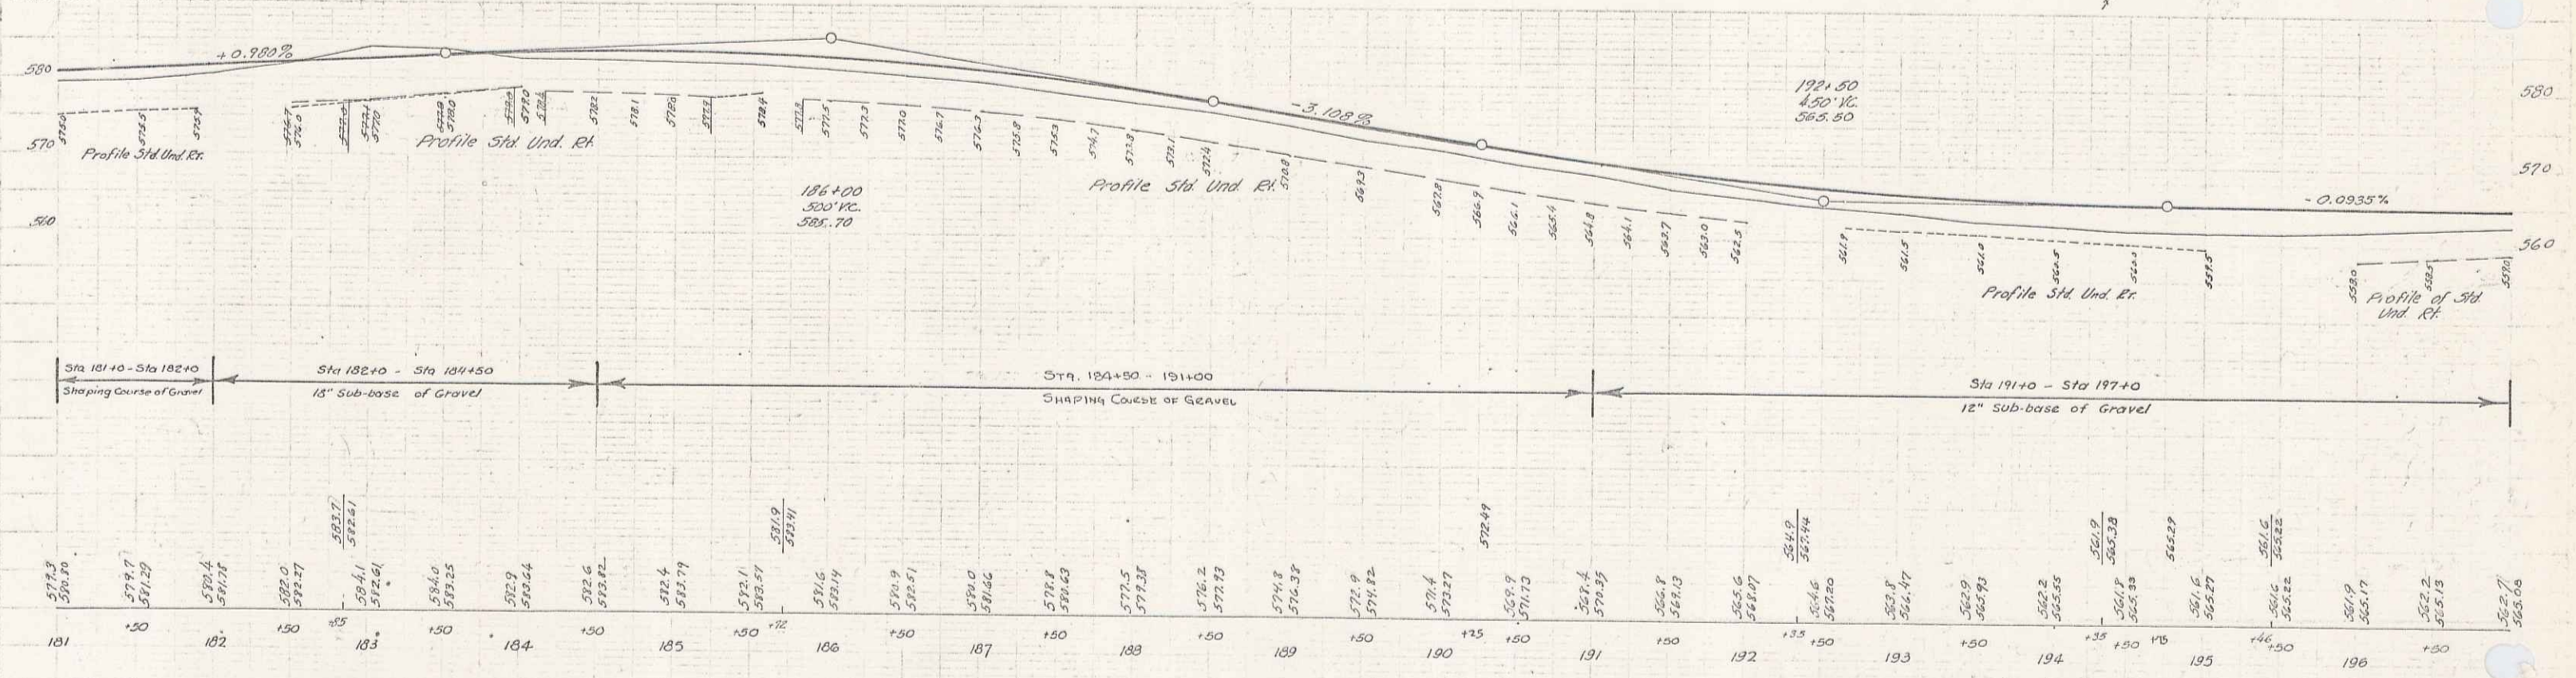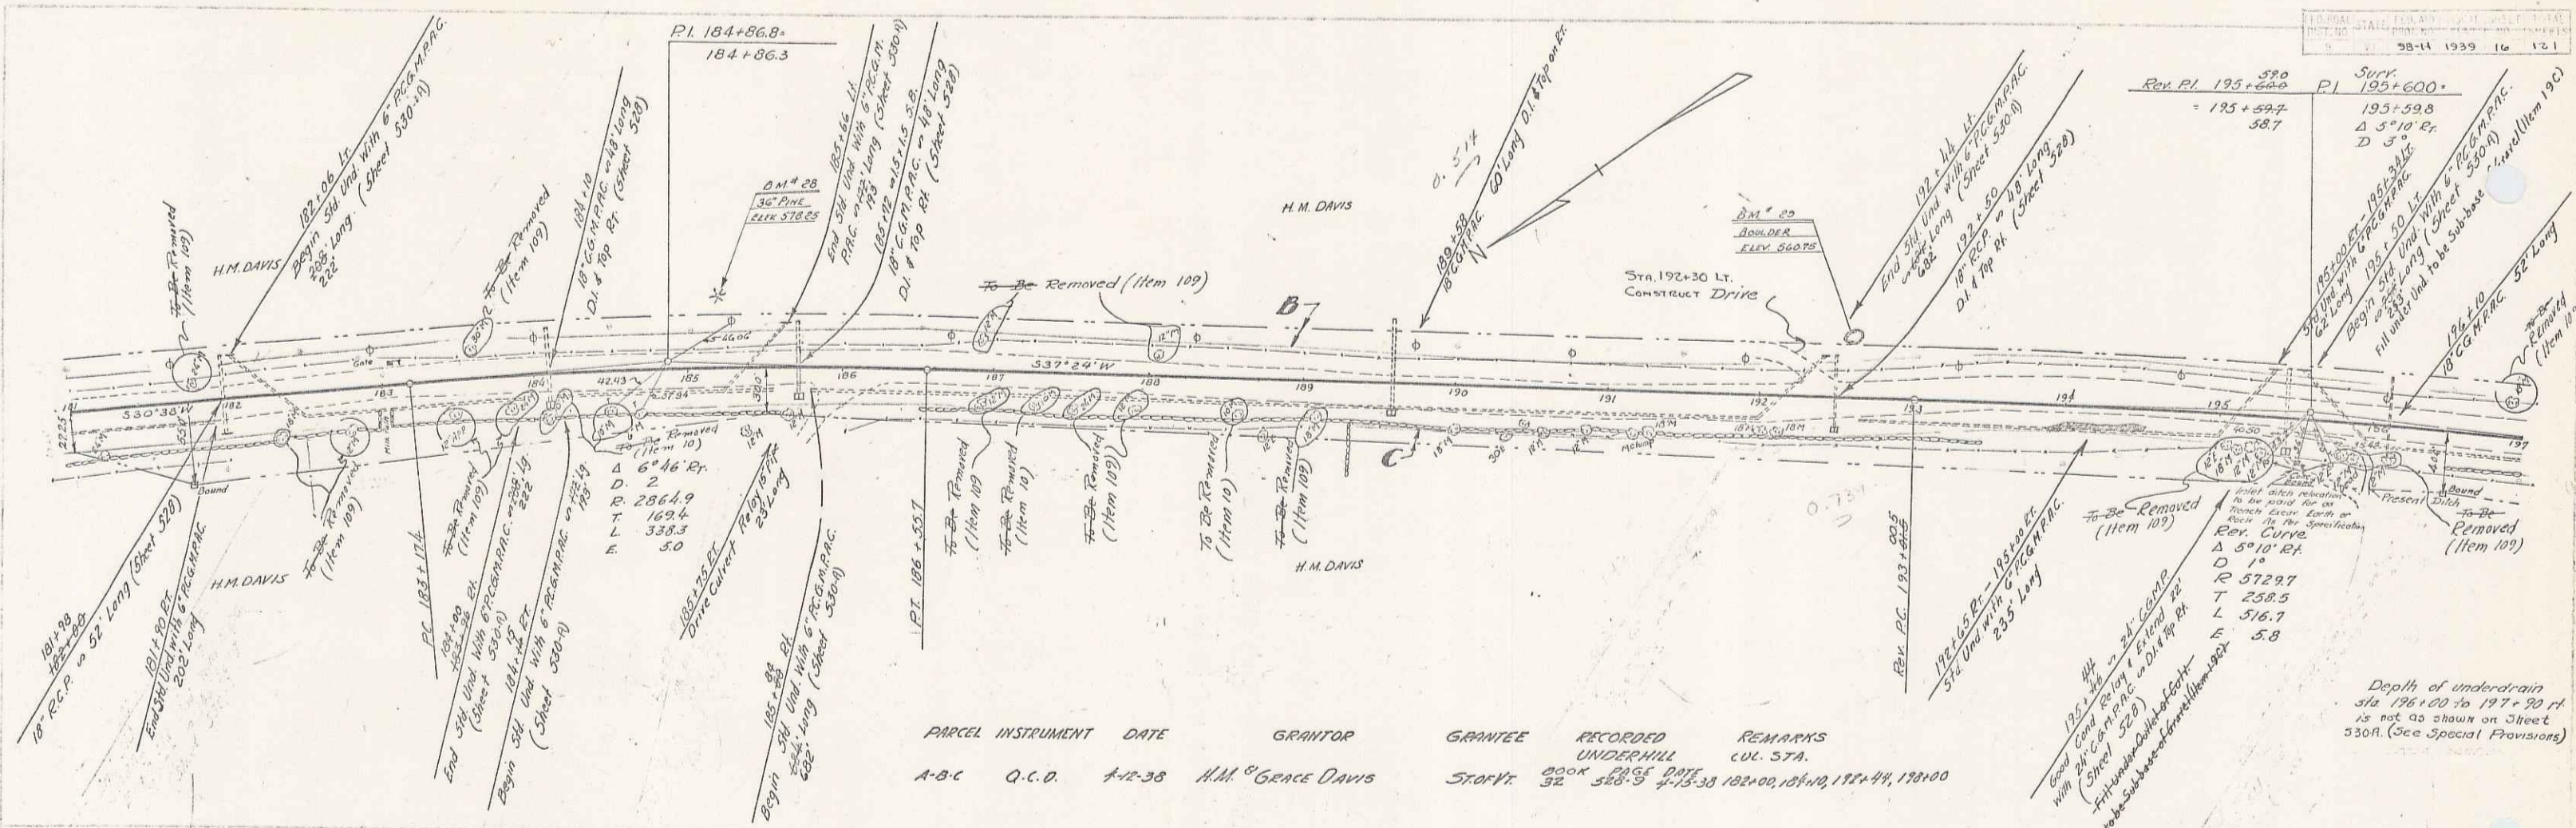

BM No 28 - spike in root of 36 in pine 425 ft left of sta 185+20 - elevation: 578.25.
 BM No 29 - paint spot on boulder 34 ft left of sta 192+61 - elevation: 560.75.

PARCEL INSTRUMENT	DATE	GRANTOR	GRANTEE	RECORDED UNDERHILL	REMARKS
ABC	Q.C.D.	4-12-38	H.M. DAVIS	31-07-41	820X 100 FT. 1821.00, 1821.00, 1721.00, 1781.00
A-B-C	Q.C.D.	4-12-38	P.J. BOLIO	32-04-33	4-22-38
					4-22-38

FILE NO.	DATE	BY	SCALE	SHEET NO.	TOTAL SHEETS
98-H	1939	17	12.1		

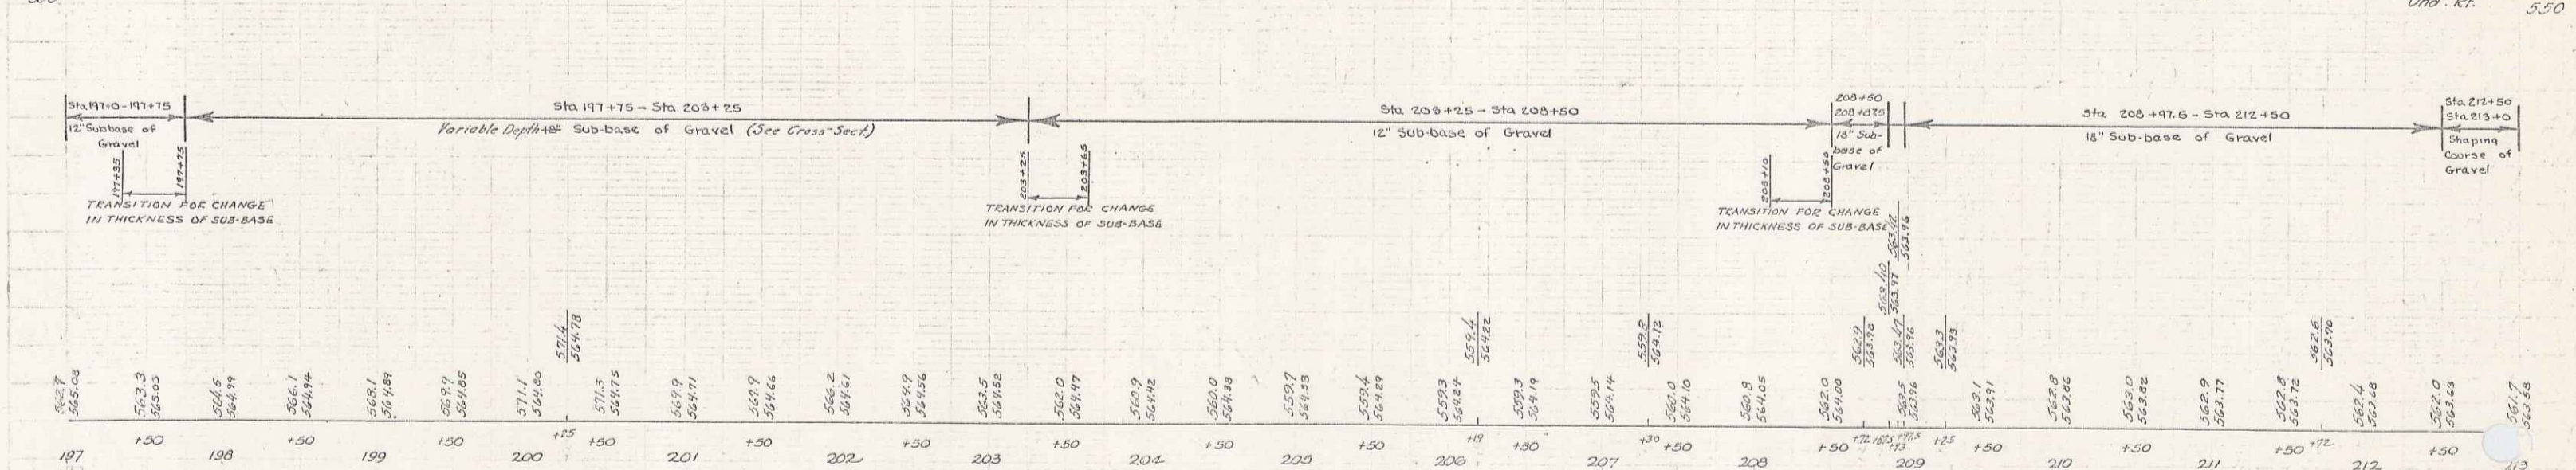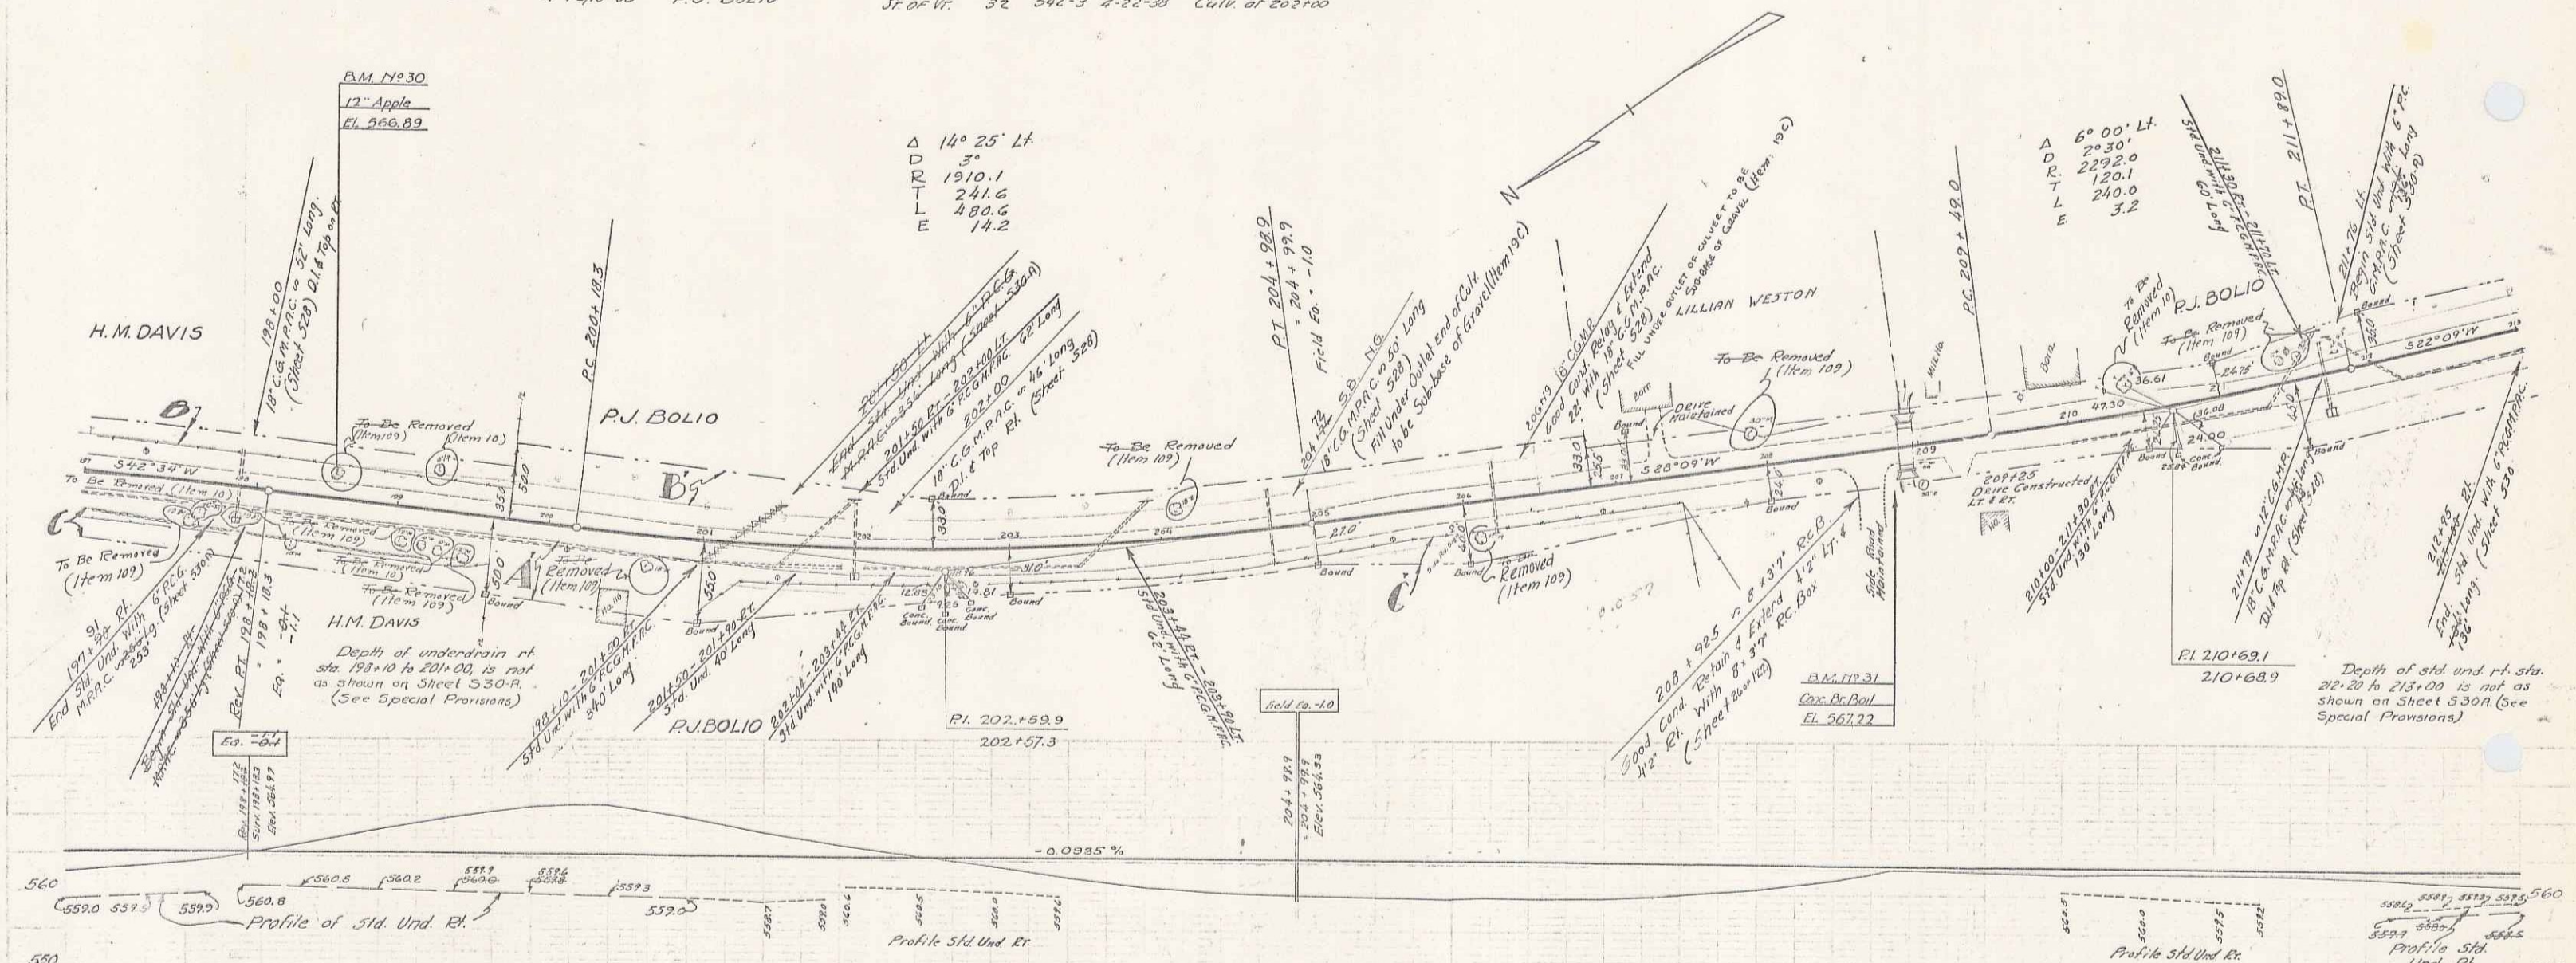




Sta 197+00 - 197+15: 12" Sub-base of Gravel
 Sta 197+15 - 200+25: Variable Depth 18" Sub-base of Gravel (See Cross-Section)
 Sta 200+25 - 208+50: 12" Sub-base of Gravel
 Sta 208+50 - 208+75: 18" Sub-base of Gravel
 Sta 208+75 - 212+50: 18" Sub-base of Gravel
 Sta 212+50 - 213+00: Shaping Course of Gravel

559.7	559.5	559.3	551.7			
197	198	199	200	201	202	203	204	205	206	207	208	209	210	211	212	213																											

BM No 30 - spike in root of 12" apple 25 ft left of sta. 196+60 - elevation: 566.89
 BM No 31 - point spot on conc. bridge rail 10 ft right of sta. 208+85 - elevation: 567.22


PARCEL	INSTRUMENT	DATE	GRANTOR	GRANTEE	RECORDED UNDERHILL	REMARKS
D-E	Q.C.D.	4-12/18-38	P.J. BOLIO		BOOK PAGE DATE	
A-B-C	W.D.	5-31-38	ORRILLA RAWSON		ST. OF VI. 32 542-3 4-22-38	
					ST. OF VI. 33 18-16 6-11-38	

NOTE: STA. 223+00 TO 225+00
 In accordance with the right of way agreement obtained from the property owner, the slope between the above station is to be covered with loam and seeded.

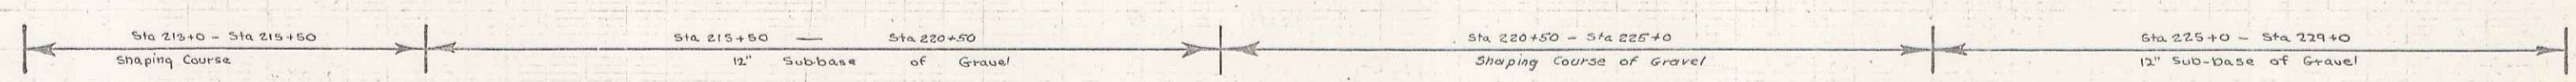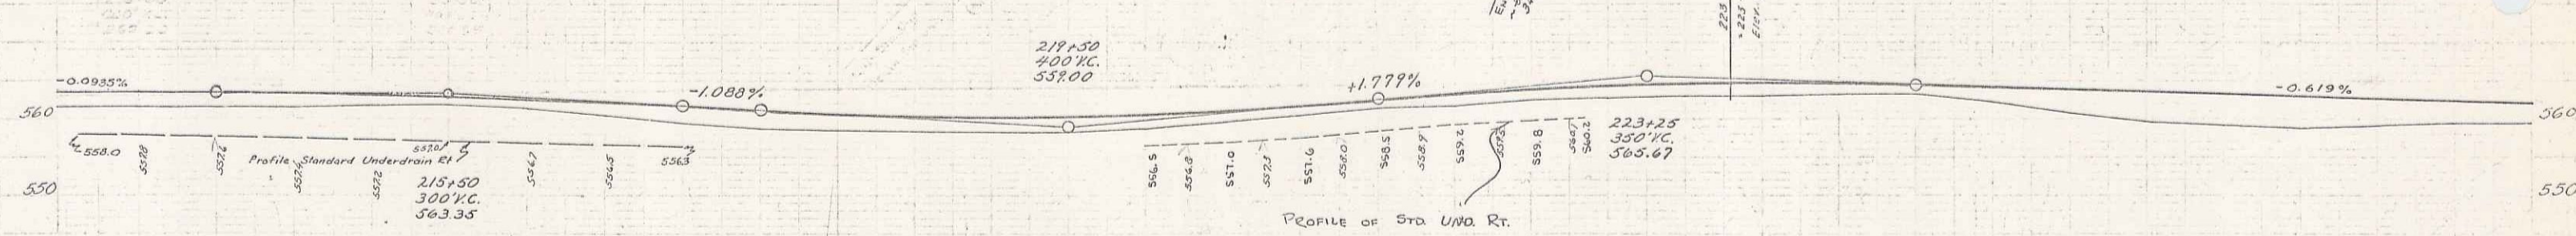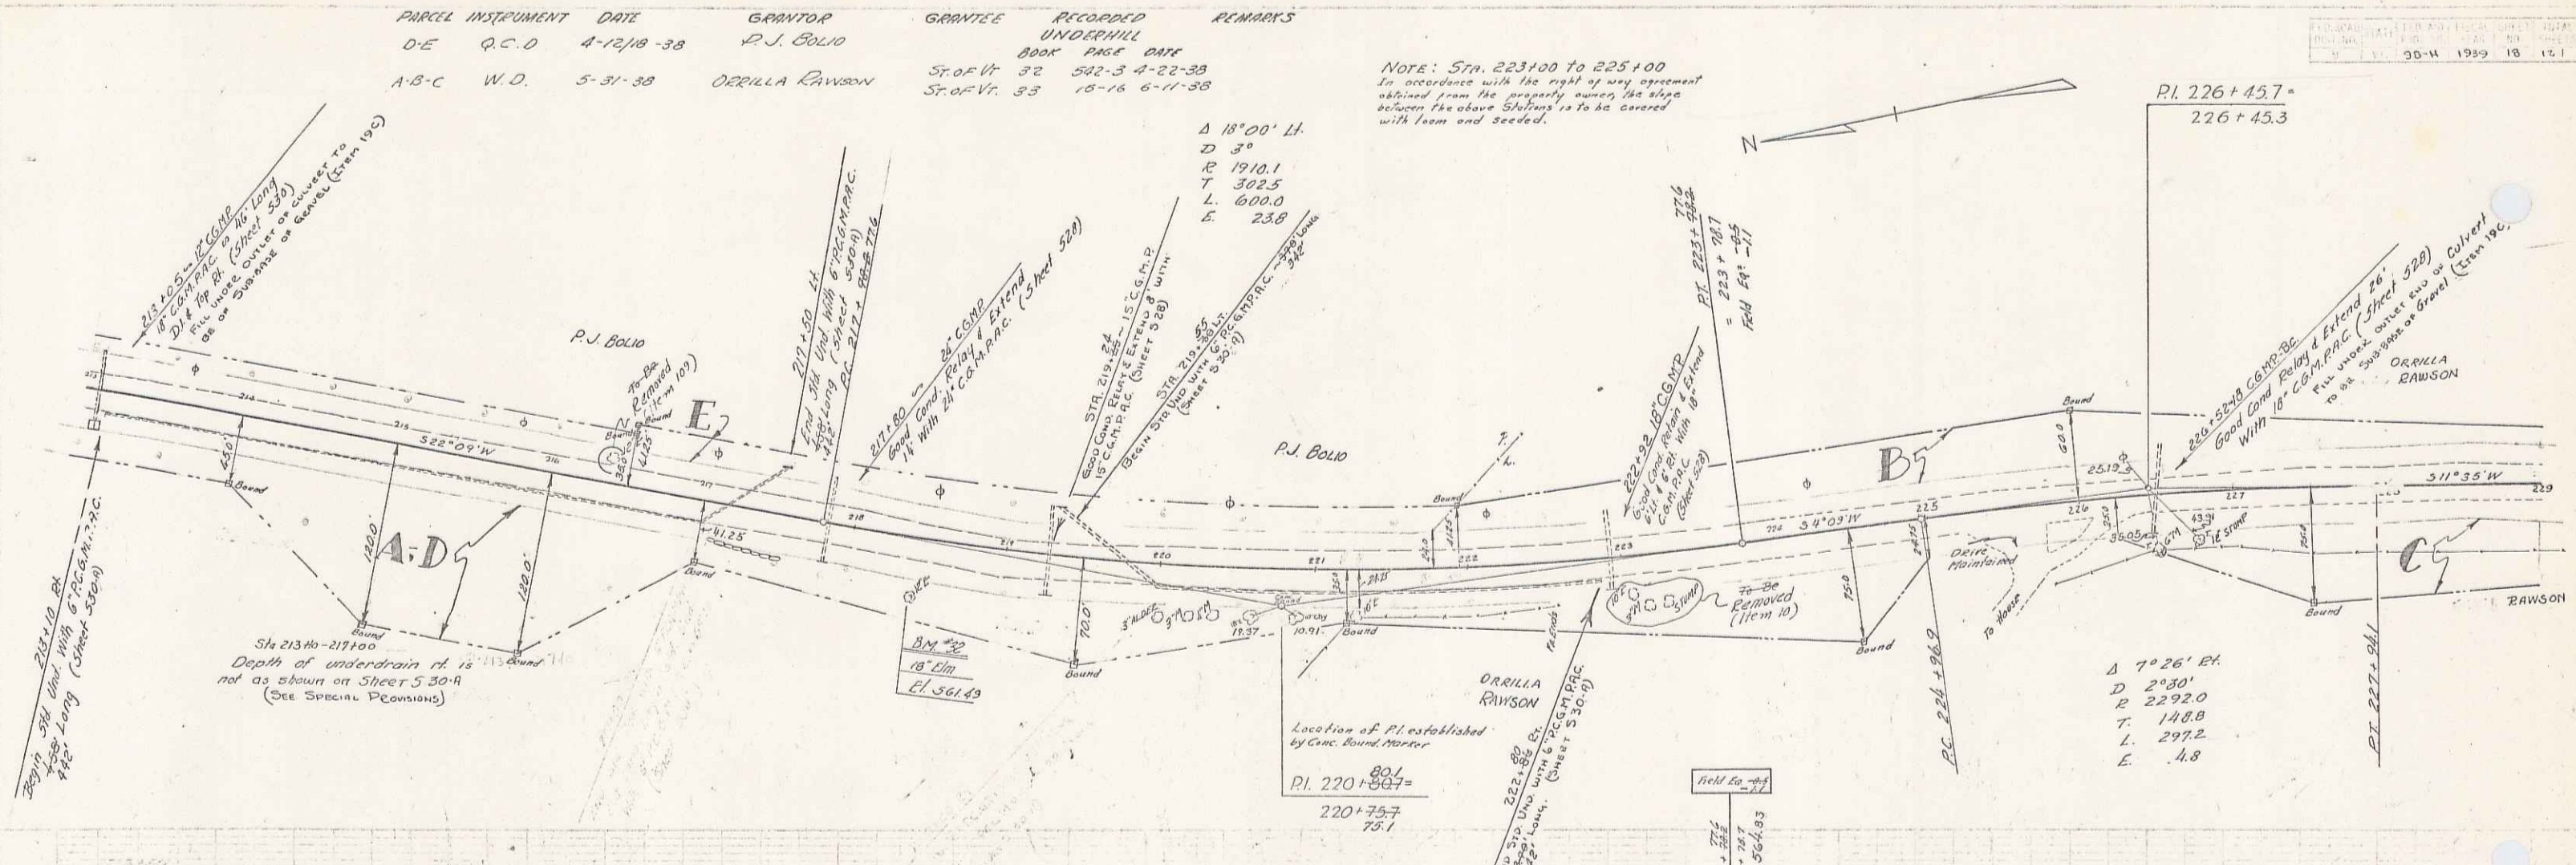

Station	Elevation	Station	Elevation	Station	Elevation	Station	Elevation
213	551.7	214	551.5	215	551.8	216	551.3
130	551.5	130	551.4	130	551.8	130	551.3
135	551.5	135	551.4	135	551.8	135	551.3
140	551.5	140	551.4	140	551.8	140	551.3
295	551.5	295	551.4	295	551.8	295	551.3

B.M. N° 32 - spike in root of 18" elm 40' right of sta. 218+36 - elevation: 561.49.

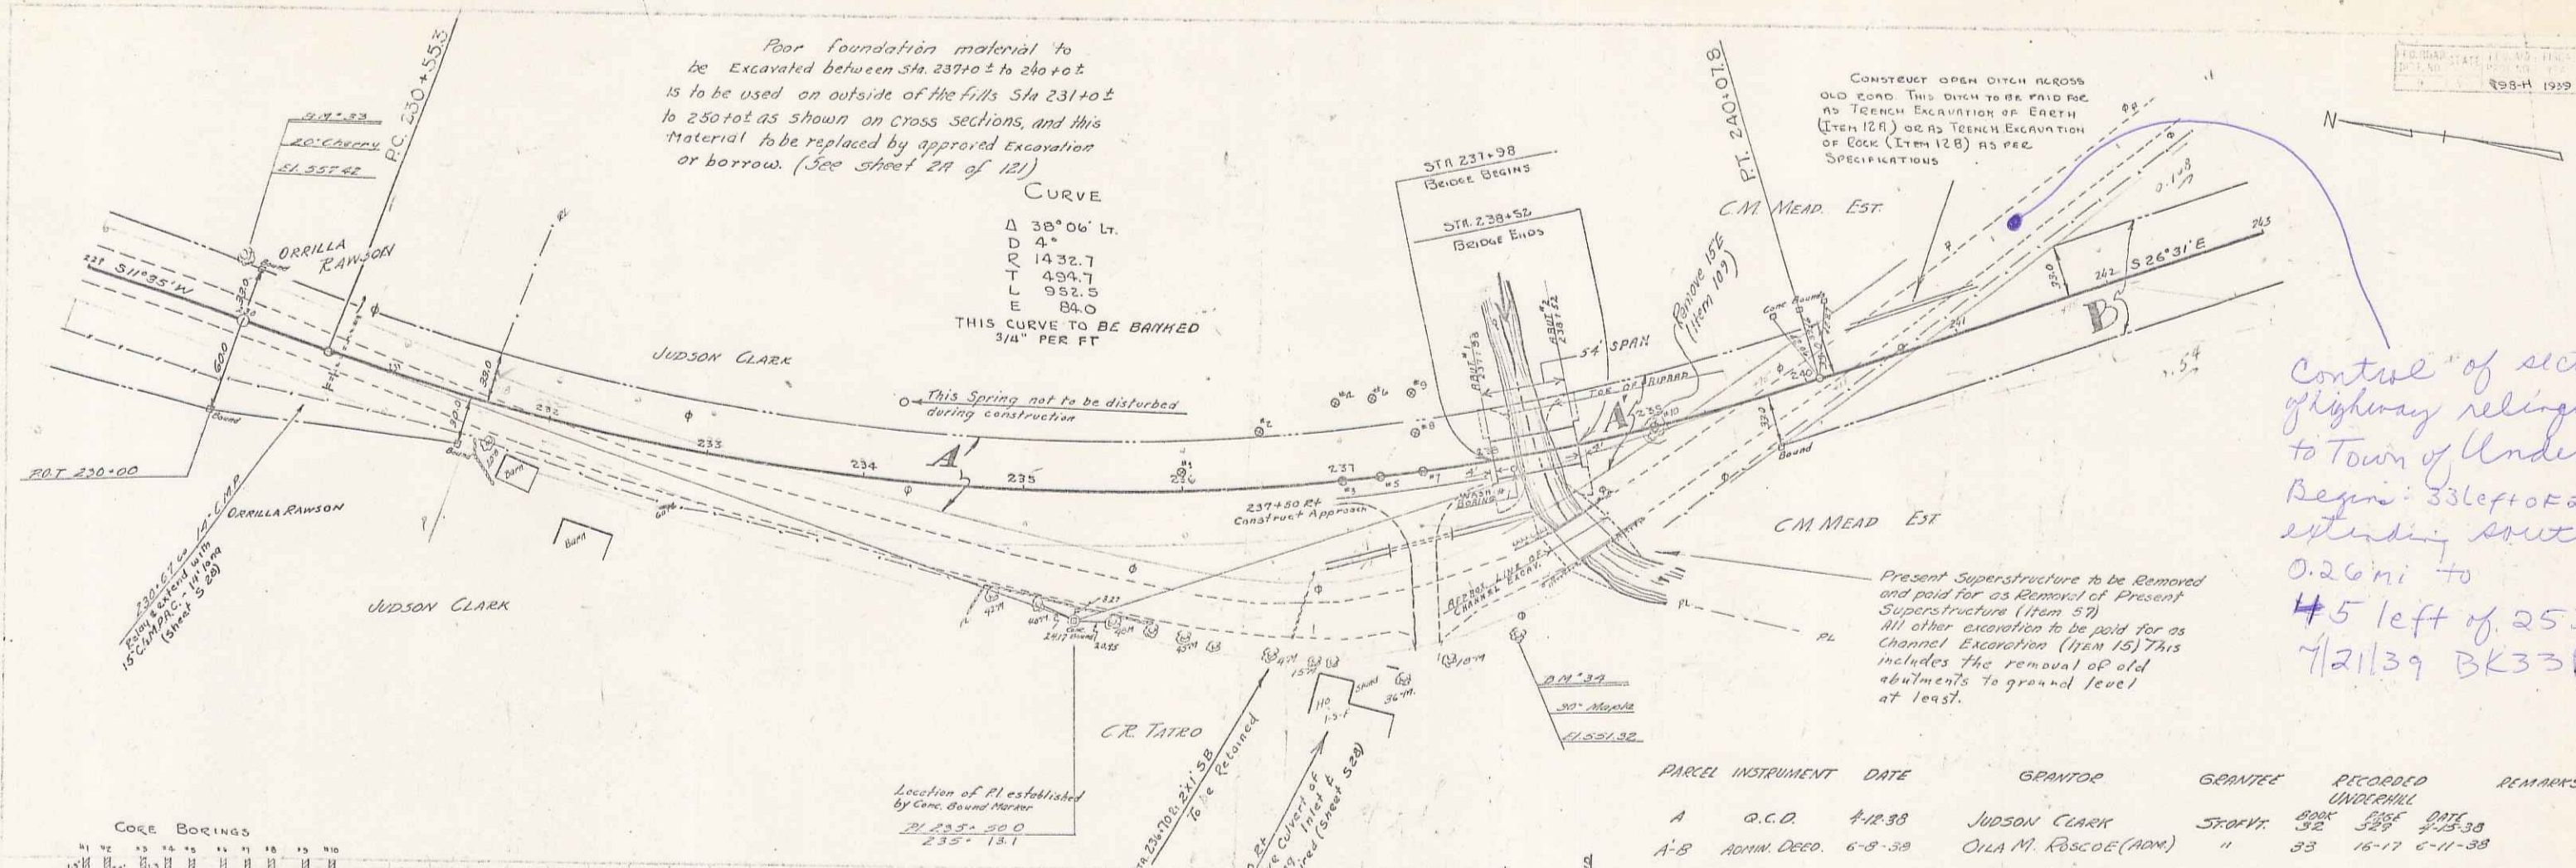

Poor foundation material to be Excavated between sta. 237+0± to 240+0± is to be used on outside of the fills Sta 231+0± to 250+0± as shown on cross sections, and this material to be replaced by approved Excavation or borrow. (See sheet 21 of 121)

CONSTRUCT OPEN DITCH ACROSS OLD ROAD THIS DITCH TO BE PAID FOR AS TRENCH EXCAVATION OF EARTH (ITEM 12A) OR AS TRENCH EXCAVATION OF ROCK (ITEM 12B) AS PER SPECIFICATIONS

Control of section of highway relinquished to Town of Underhill
 Begins: 33' left of E 240+97 extending southwly 0.26 mi to 45' left of 253+19.
 7/21/39 BK 33 Pg 132


CORE BORINGS

NO.	DEPTH	DESCRIPTION
1	10'	CLAY
2	15'	CLAY
3	20'	CLAY
199	1000'	CLAY

Location of P.I. established by Conc. Ground Marker
 P.I. 233+20.0
 235+13.1

PARCEL INSTRUMENT	DATE	GRANTOR	GRANTEE	RECORDED	REMARKS
A	G.C.D. 4-12-38	JUDSON CLARK	STATE	BOOK 335 PAGE 233-38	
A-B	ADMM. DECD. 6-8-38	OLA M. ROSCOE (ADM.)	"	33 16-17 6-11-38	



BRIDGE DATA (BANK & TYP)		
TYPE	EXISTING	PROPOSED
SPAN	1 @ 24'	2 @ 24'
CLEAR HT.	5'-0"	5'-0"
WATERWAY	120"	185"
OVERALL LTH	24'	54'
ROAD WIDTH	24'	24'
		242+00
		500' VC
		534.07

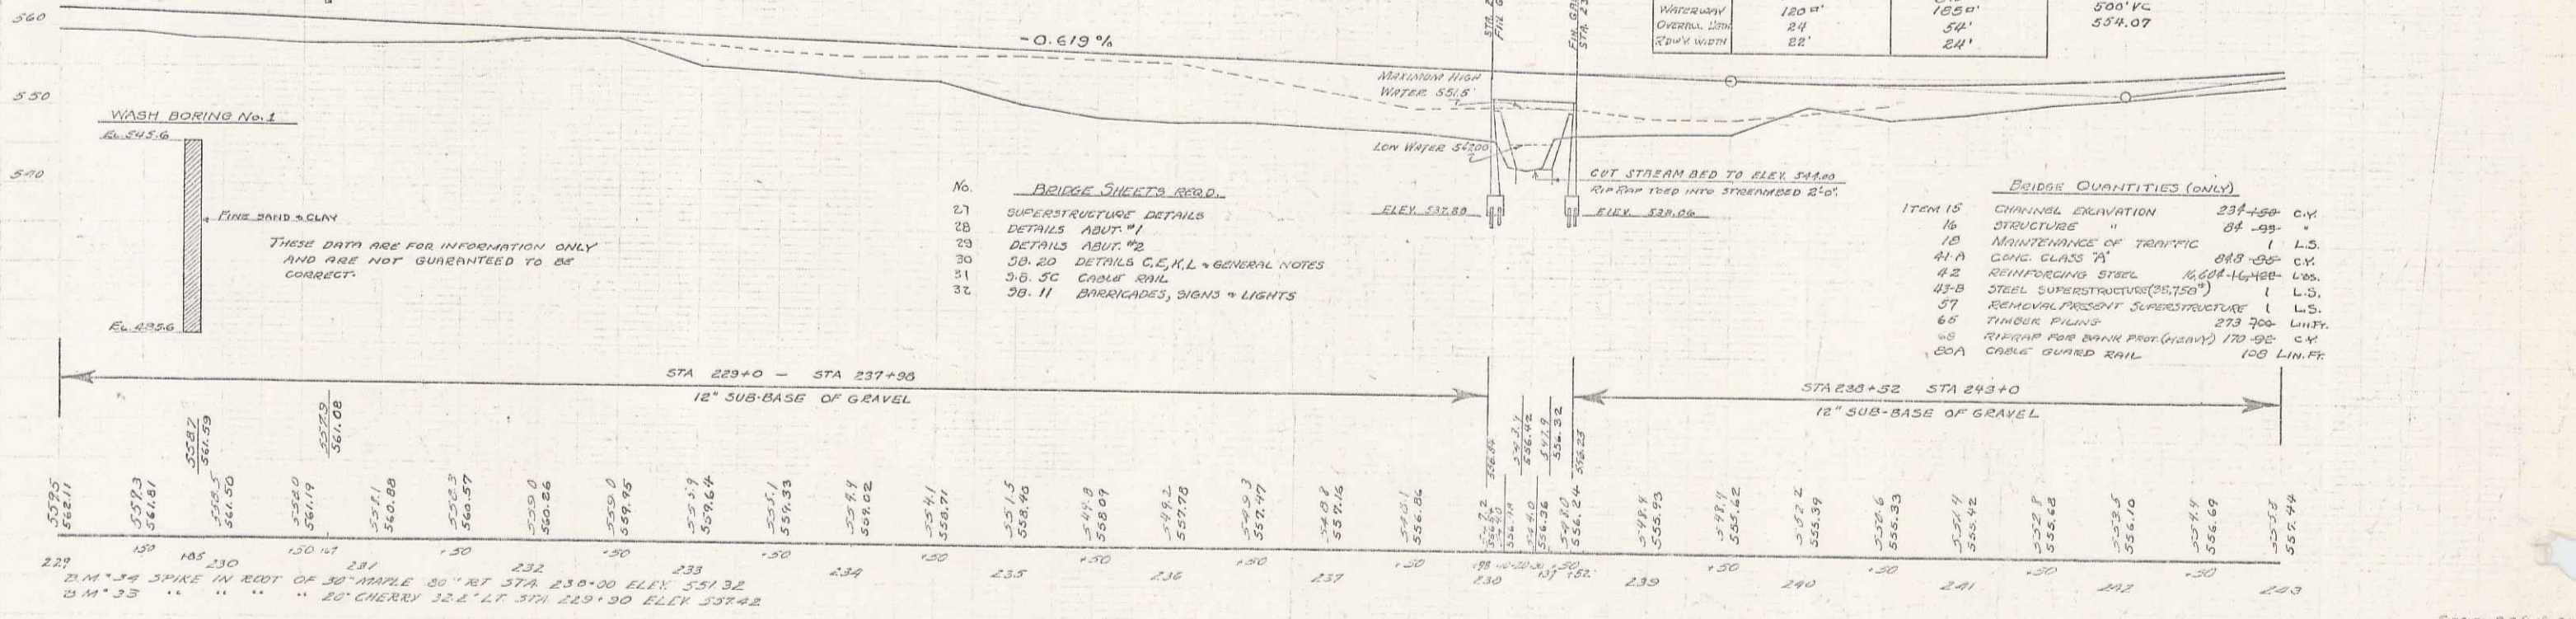


- BRIDGE SHEETS ROAD.
- 16. SUPERSTRUCTURE DETAILS
 - 17. DETAILS ABUT. #1
 - 18. DETAILS ABUT. #2
 - 19. 20. 21. DETAILS C.C.M.L. - GENERAL NOTES
 - 22. 23. 24. 1000.

BRIDGE QUANTITIES (ONLY)




| ITEM | DESCRIPTION | QUANTITY | UNIT |
|------|--------------------------------|--------------|-------------|
| 15 | CHANNEL EXCAVATION | 237+50 | C.Y. |
| 16 | STRUCTURE | 84 | SS. |
| 17 | MAINTENANCE OF TRAFFIC | 1 | L.S. |
| 41-A | CONC. CLASS "A" | 818 | CY. |
| 42 | REINFORCING STEEL | 4,684-14,488 | LB. |
| 43-B | STEEL SUPERSTRUCTURE (24,750') | 1 | L.S. |
| 57 | REMOVAL PRESENT SUPERSTRUCTURE | 1 | L.S. |
| 65 | THICKER PILING | 273 | 300 LB. WT. |
| 68 | SHARP POINT BARR. POST (HEAV | | |

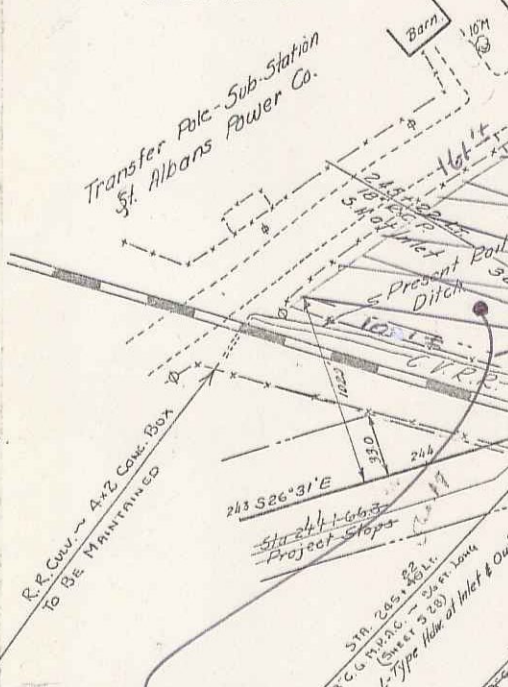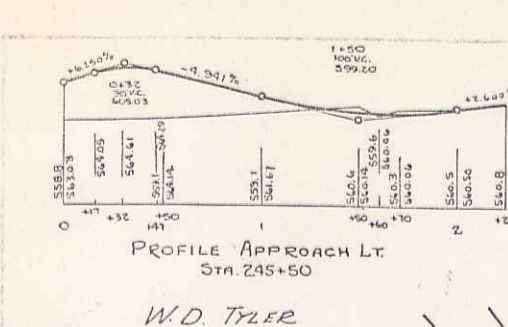

State of Vt to
I. James Beams
QCD 5/2/74
BK 44 Pg 293

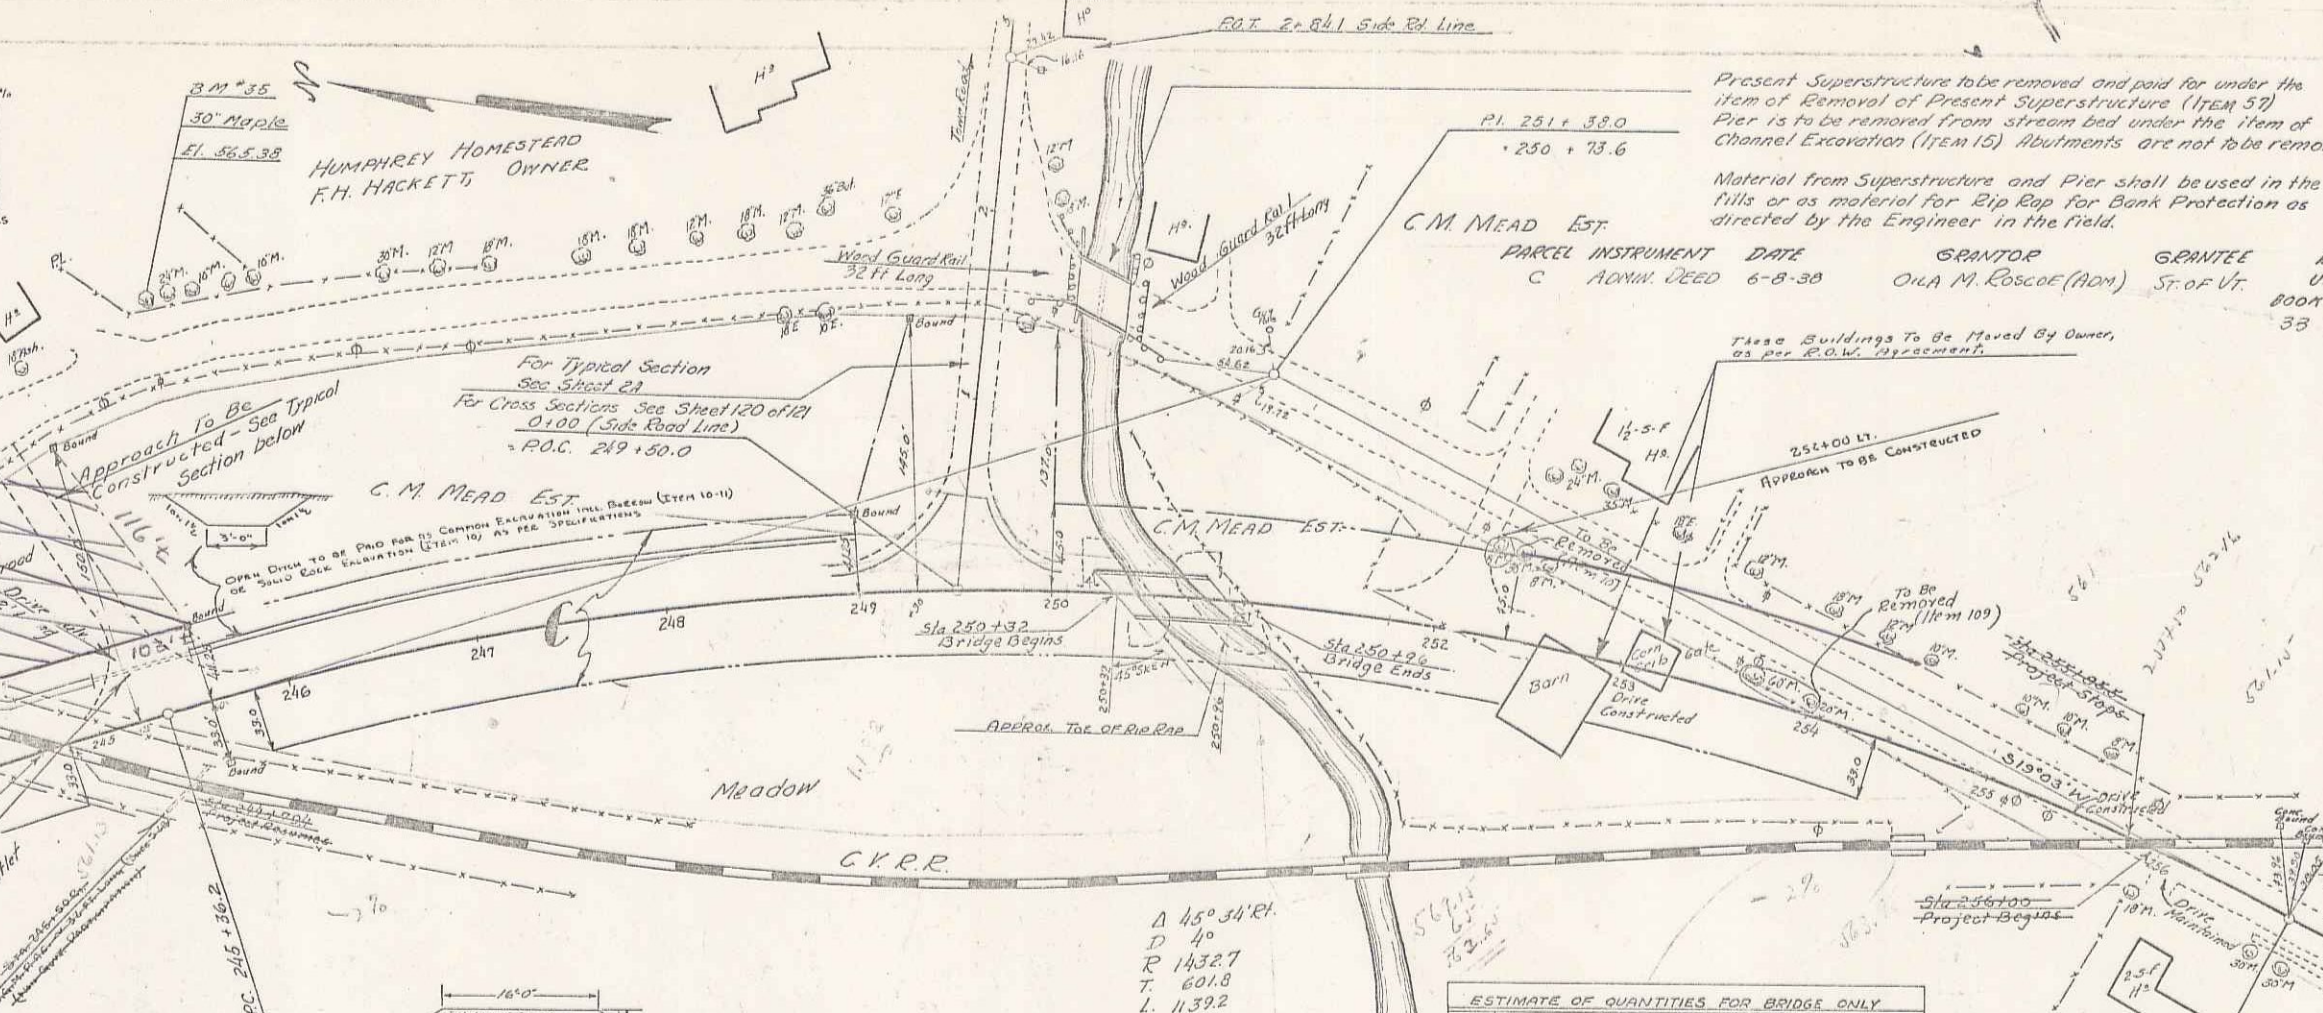

| NO. | ITEM | QUANTITY |
|-----|---------------------------------------|--------------|
| 15 | CHANNEL EXCAVATION | 328.49 CY |
| 16 | STRUCTURE EXCAVATION | 101.16 CY |
| 41A | CONCRETE CLASS 'B' | 127.46 CU YD |
| 42 | REINFORCING STEEL | 28,800 LBS |
| 43 | STEEL SUPERSTRUCTURE (S2A27) | 1 L.S. |
| 47 | REMOVAL OF PRESENT SUPERSTRUCTURE | 1 L.S. |
| 68 | RIP RAP FOR BANK PROTECT (HEAVY TYPE) | 172.18 CY |
| 68A | CABLE GUARD RAIL | 120 LF |

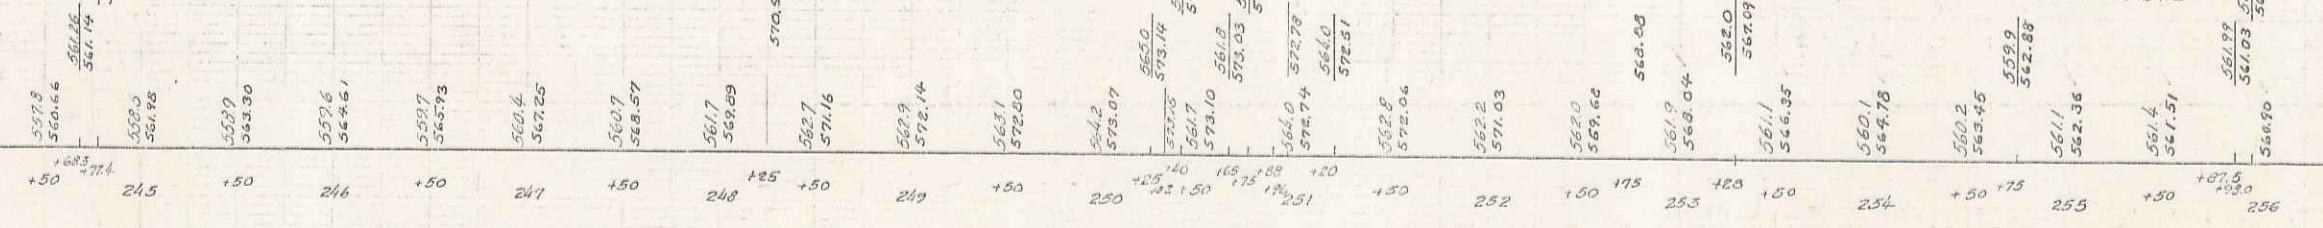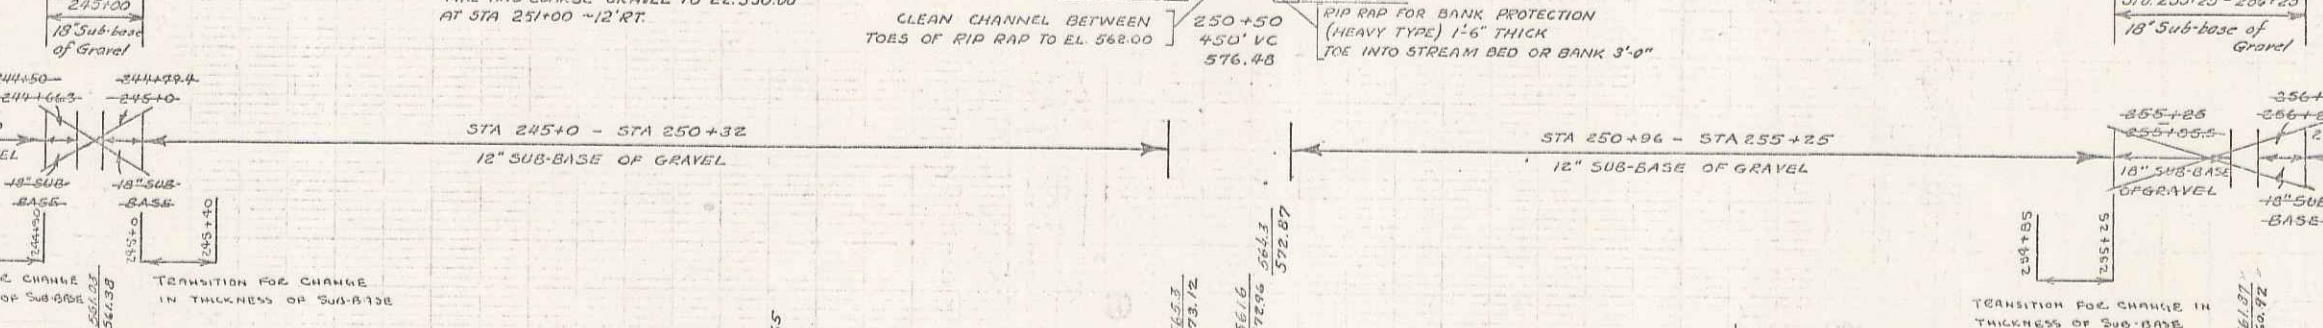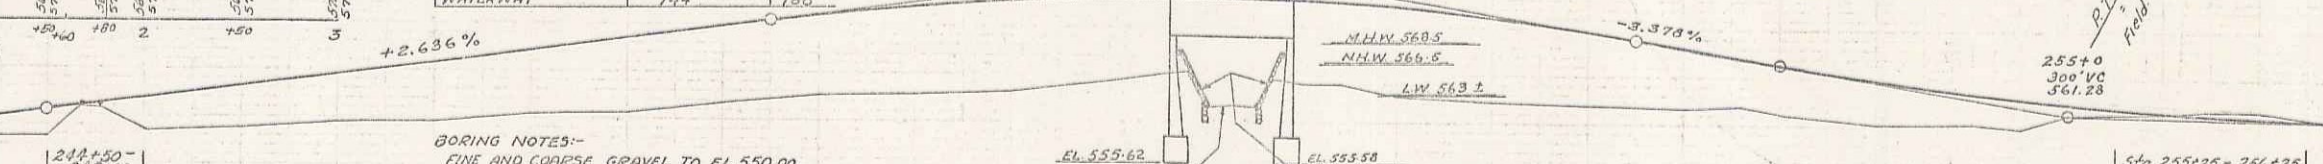

B.M. #35 Spike in Root 30' Maple 205' H. Sta. 243+82 Elev. 565.38

Present Superstructure to be removed and paid for under the Plan of Removal of Present Superstructure (Item 37). Pier is to be removed from stream bed under the Plan of Channel Excavation (Item 15). Abutments are not to be removed. Material from Superstructure and Pier shall be used in the fills or as material for Rip Rap for Bank Protection as directed by the Engineer in the field.

These Buildings To be Moved By Owner, as per E.O.W. Instrument.

Field Eq. = 189.0'

NOTE: STA. 252+00 TO 263+00 GRADES REVISED JULY 20, 1938


| SHEET NO. | DESCRIPTION |
|-----------|-------------------------|
| 33 | SUPERSTRUCTURE DETAILS |
| 34 | DETAILS OF ABUT. #1 |
| 35 | DETAILS OF ABUT. #2 |
| 36 | S&S - CURBS & RAIL |
| 37 | S&S - DETAILS (GENERAL) |
| 38 | S&S - BRIDGES & LIGHTS |

REVISIONS:


| NO. | DATE | DESCRIPTION |
|-----|---------|-------------|
| 1 | 6-11-38 | AS SHOWN |

Series MAP No. 90-H
Sheet 21 of 21


B.M. No 37 - Spike in root of 30m maple 27th right of sta 259+04 - elevation: 558.79.
B.M. No 38 - Spike in root of 15m white birch 31st of sta 265+96 - elevation: 558.72.

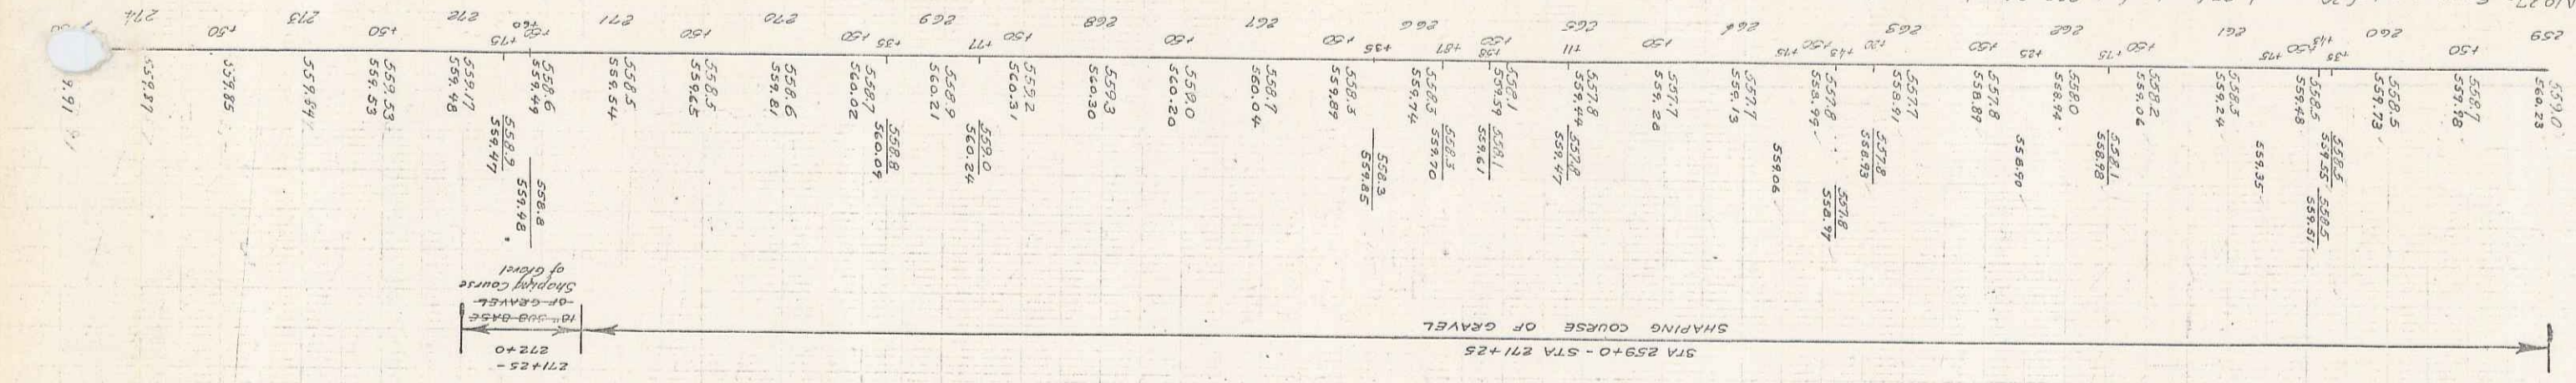


NOTE: CHANGES REVISIONS TO THE GOVERNMENT IN FRONT OF THE HOUSE 2586 AFTER APPROVED TO SETTLE THE CONDITIONS SUBMITTED TO THE GOVERNMENT. THE RAILROAD HAS BEEN DISCONTINUED.

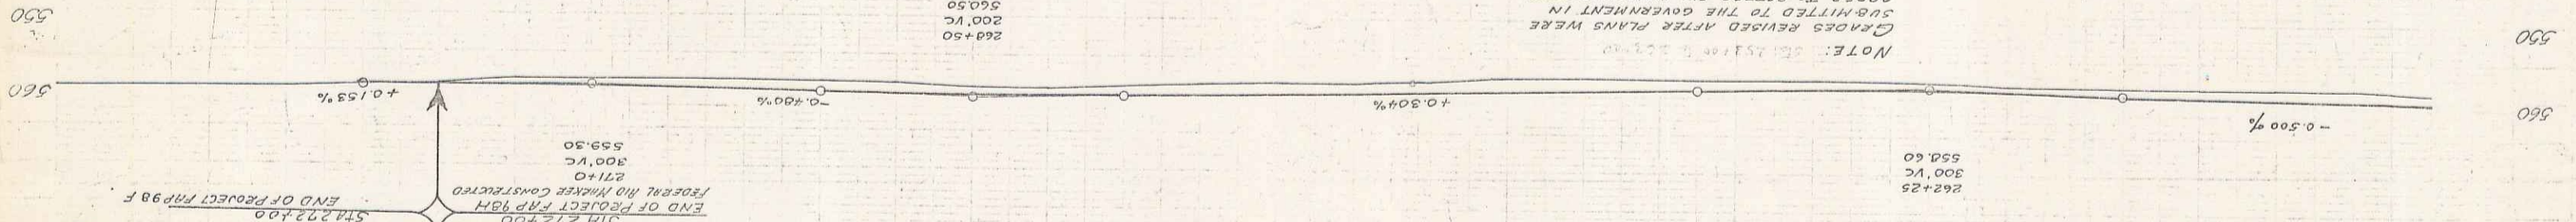

259+00 STA 259+00 to 272+00 RT. New Gravel side work to be completed. This to be paid for as subpart of gravel (from 190)

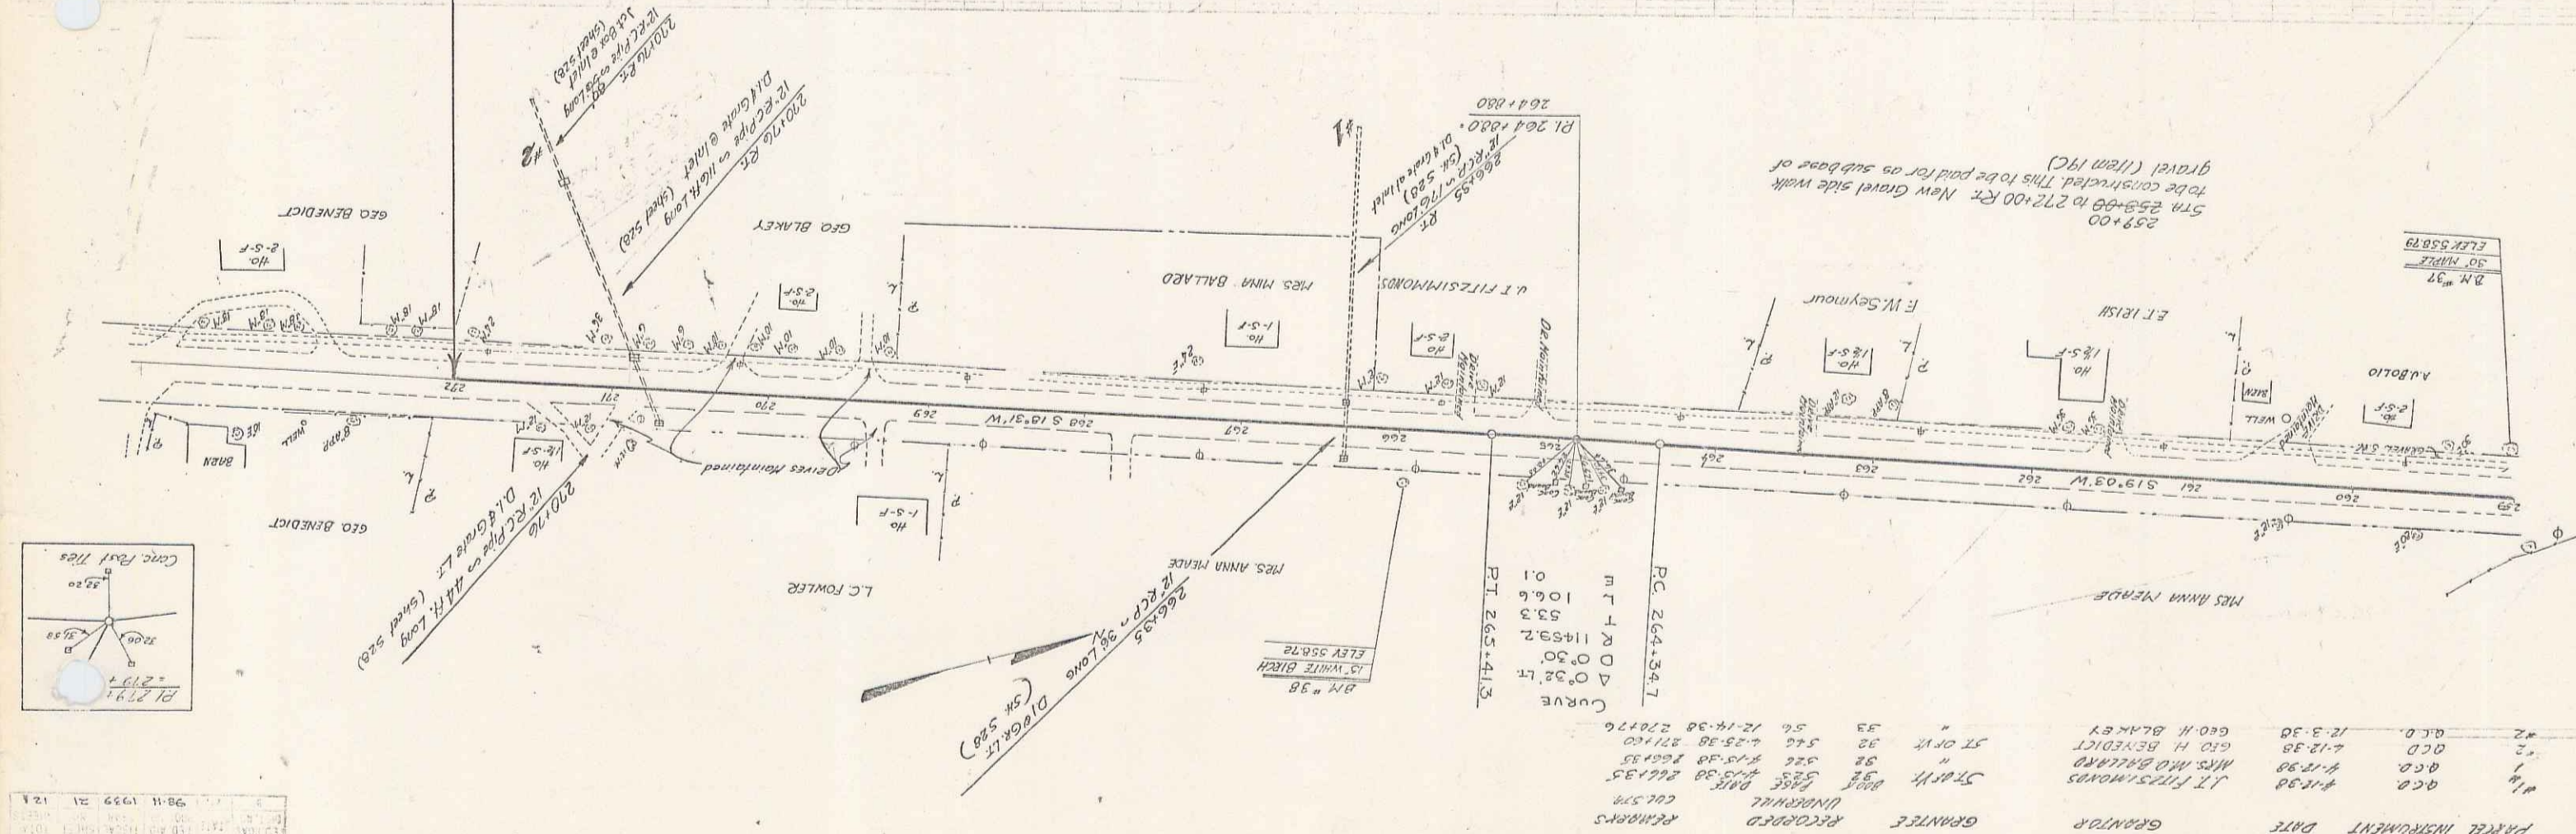

| GRANTOR | DATE | REMARKS |
|--------------------|---------|------------------------|
| J.T. FITZSIMMONS | 4-18-98 | 12.80' on 12-1/2' Long |
| Mrs. Minn. Ballard | 4-18-98 | 12.80' on 12-1/2' Long |
| Geo. H. Benedict | 4-18-98 | 12.80' on 12-1/2' Long |
| Geo. H. Benedict | 12-3-30 | 12.80' on 12-1/2' Long |

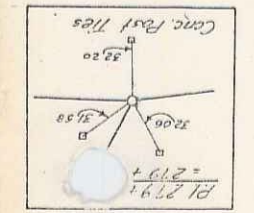

PL 279
279
9th 11 1939 21 12 8