

WD 12/7/81 Book 50 Pg 346

LAND ~~TO BE~~ QUIT CLAIMED TO TOWN OF  
UNDERHILL BY STATE OF VERMONT,  
FORMERLY VT. RTE. 15 (0.92 A±)


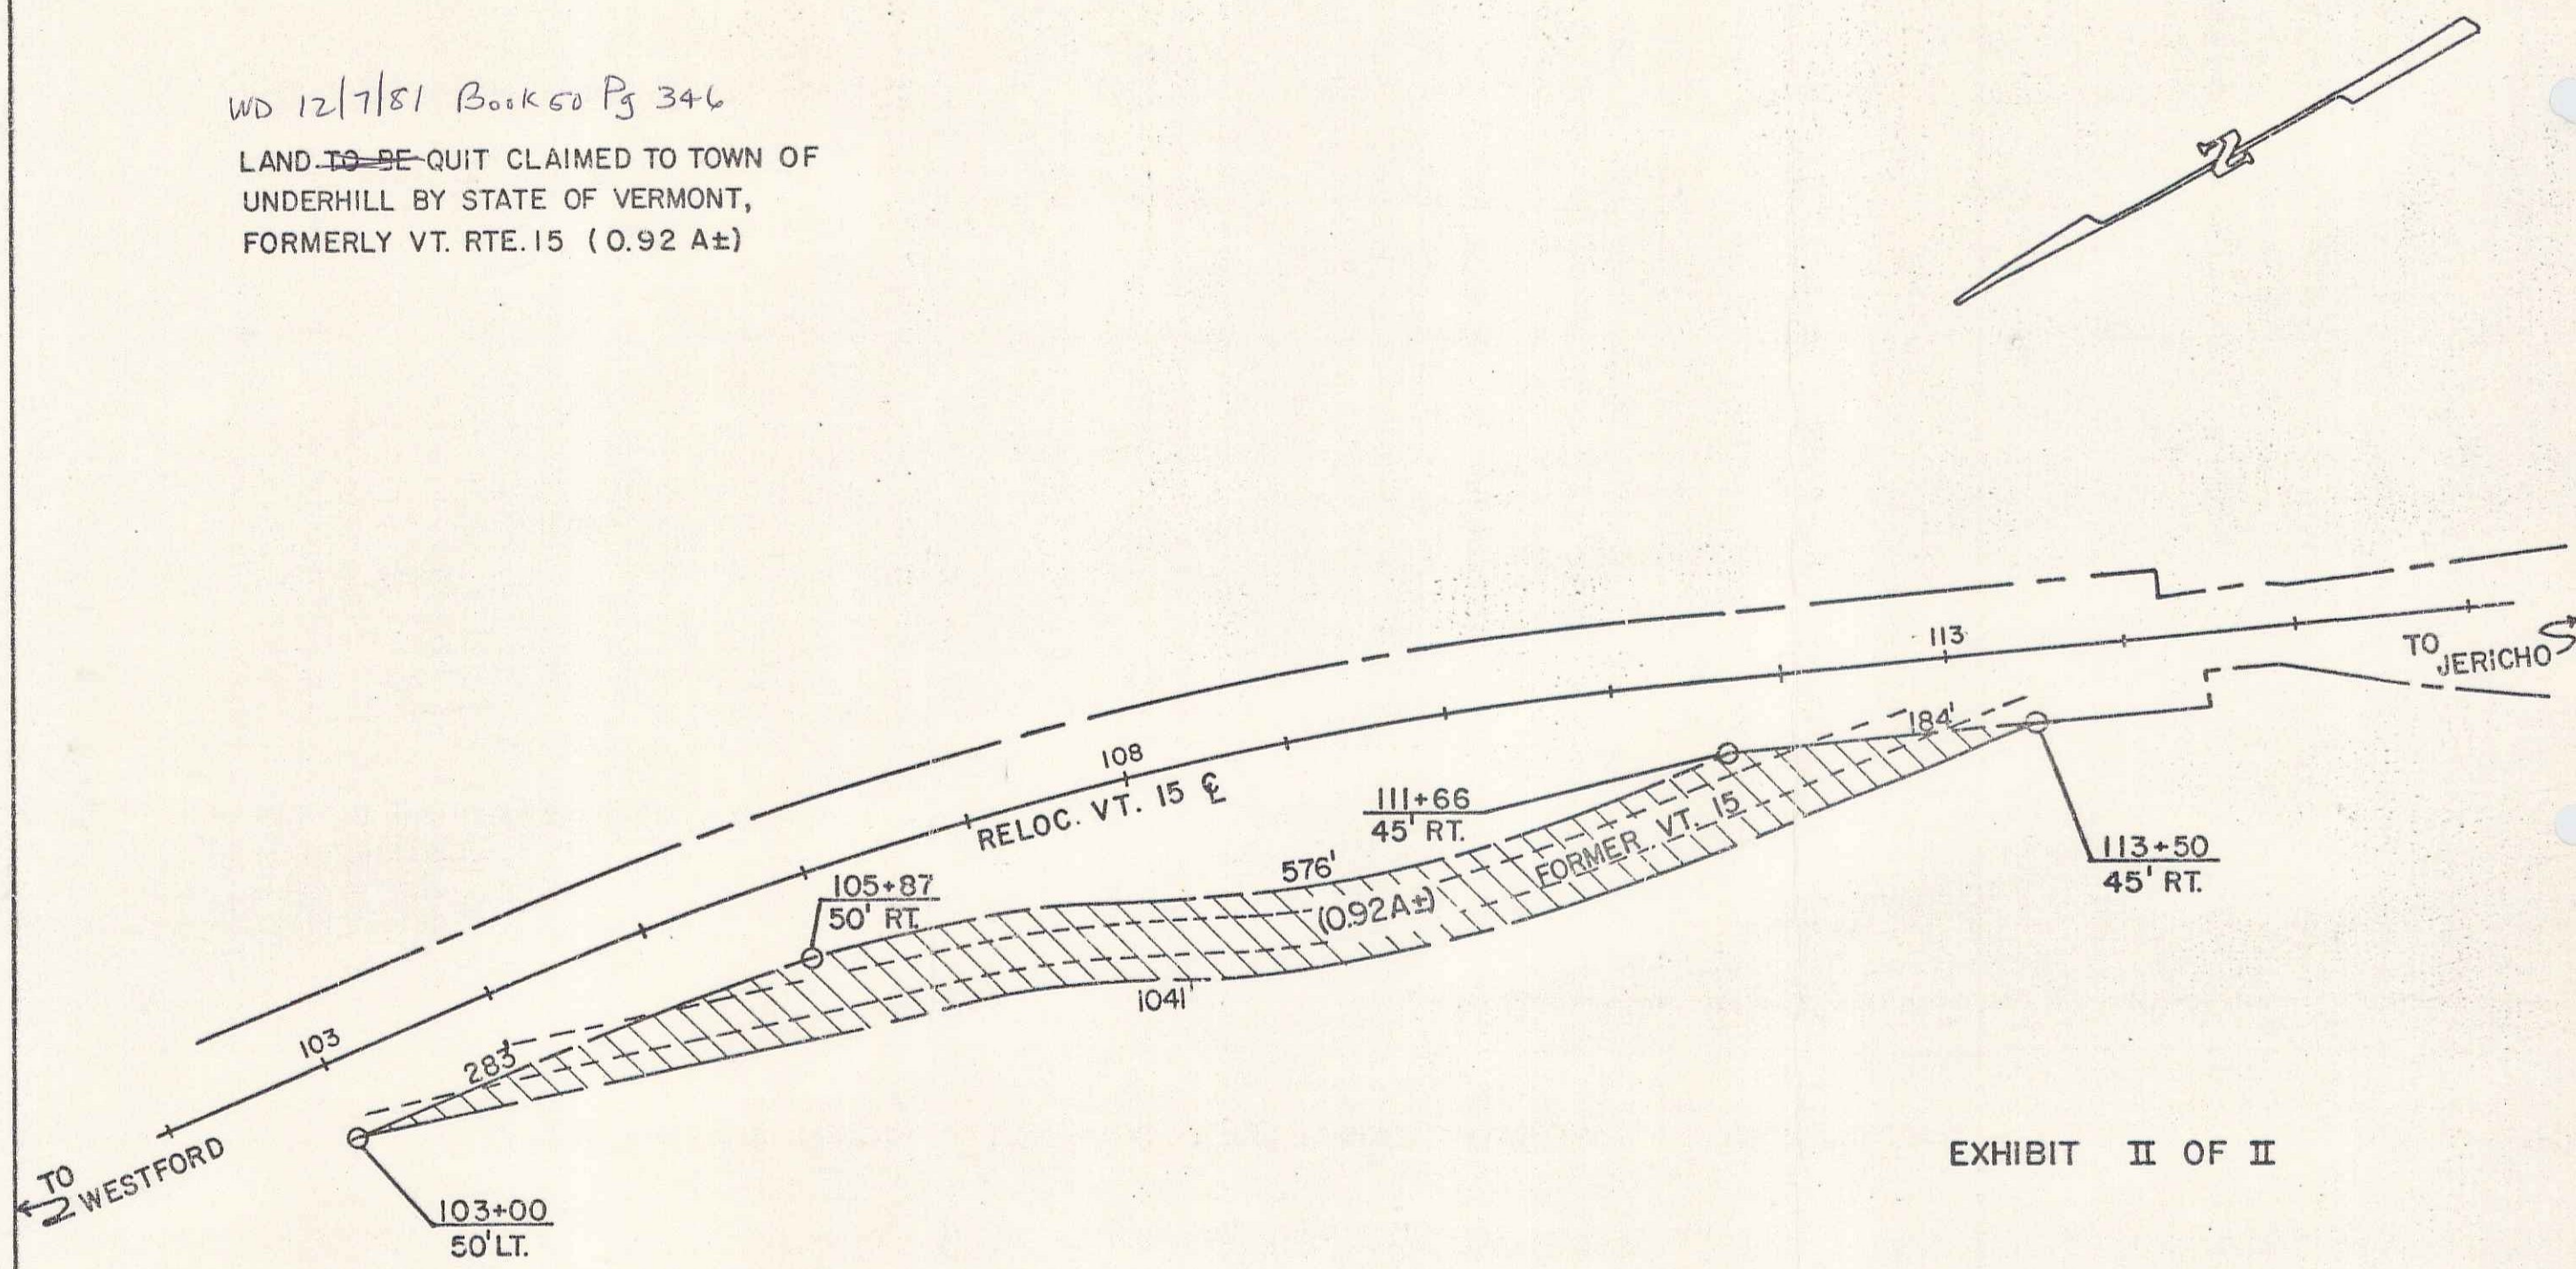


EXHIBIT II OF II

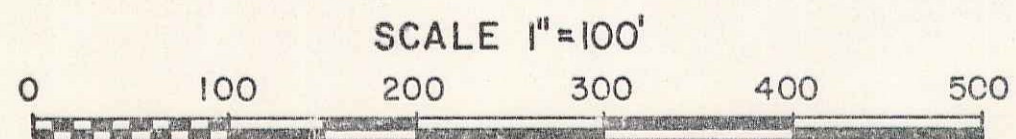

REF. FAP NO. 98H SHEET NO. 11A		
STATE OF VERMONT		
AGENCY OF TRANSPORTATION		
TOWN OF UNDERHILL		
PROJECT WESTFORD-UNDERHILL FAP. 98H		
APPROX. SCALE 1"=100'	DATE 10/26/81	DRAWN BY FJM

Sheet 112 11