


NOTE  
Any poor foundation material encountered sta 105+ to 108+ is to be removed and replaced with acceptable borrow or excavation. This work is to be paid for under the item of Common Excavation including Borrow (Item 10-11).

NOTE  
All rock encountered in excavation between Sta 104+ to Sta 114+ is to be used in the bottom of the fill Sta 104+ to 110+. And paid for when excavated only.

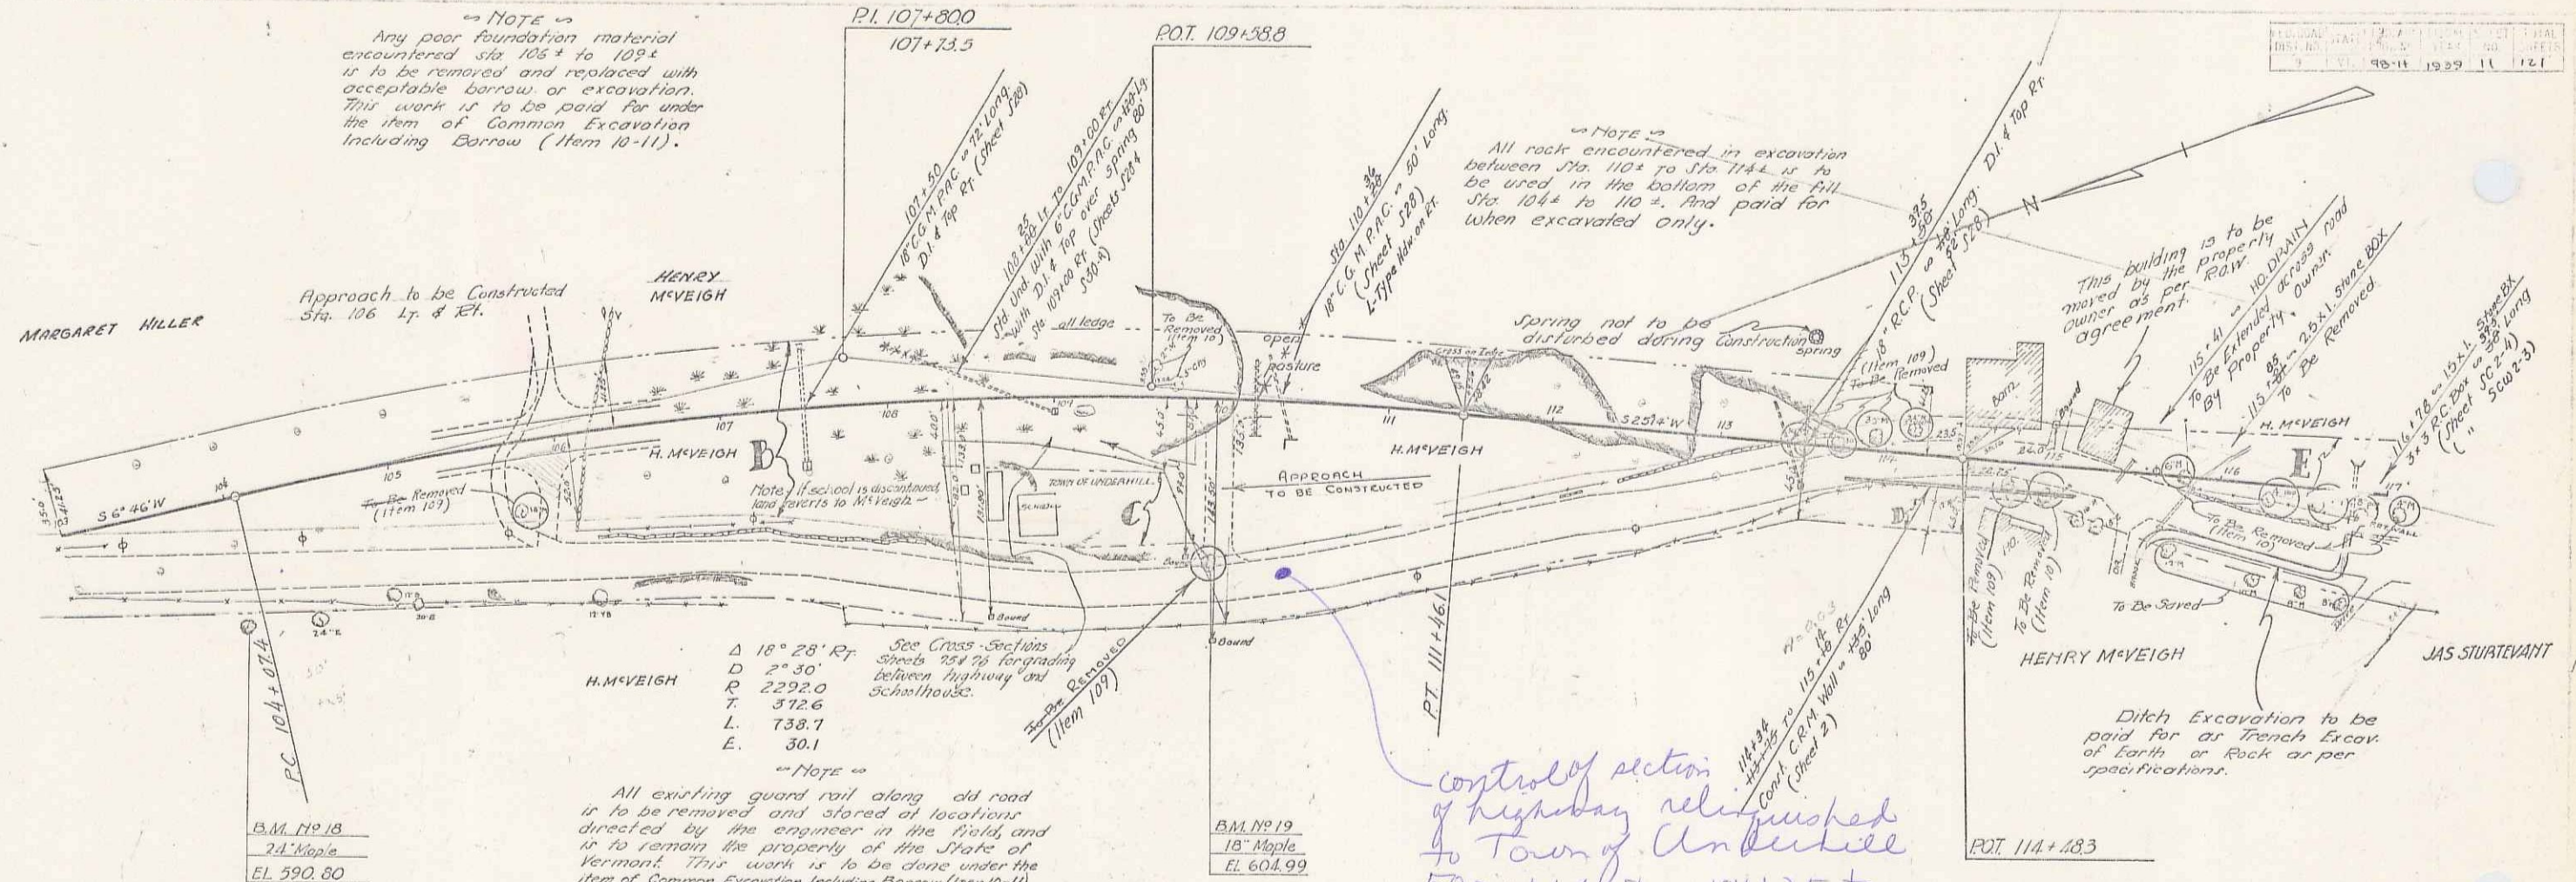


B.M. N° 18  
24" Maple  
EL. 590.80

B.M. N° 19  
18" Maple  
EL. 604.99

NOTE  
All existing guard rail along old road is to be removed and stored at location directed by the engineer in the field, and is to remain the property of the State of Vermont. This work is to be done under the item of Common Excavation including Borrow (Item 10-11).

Control of section of highway relinquished to Town of Underhill  
50' right of Sta 104+25 to 45' right of Sta 112+66  
7/21/32 BK 33 Pg 132

Ditch Excavation to be paid for as Trench Excav. of Earth or Rock as per specifications.

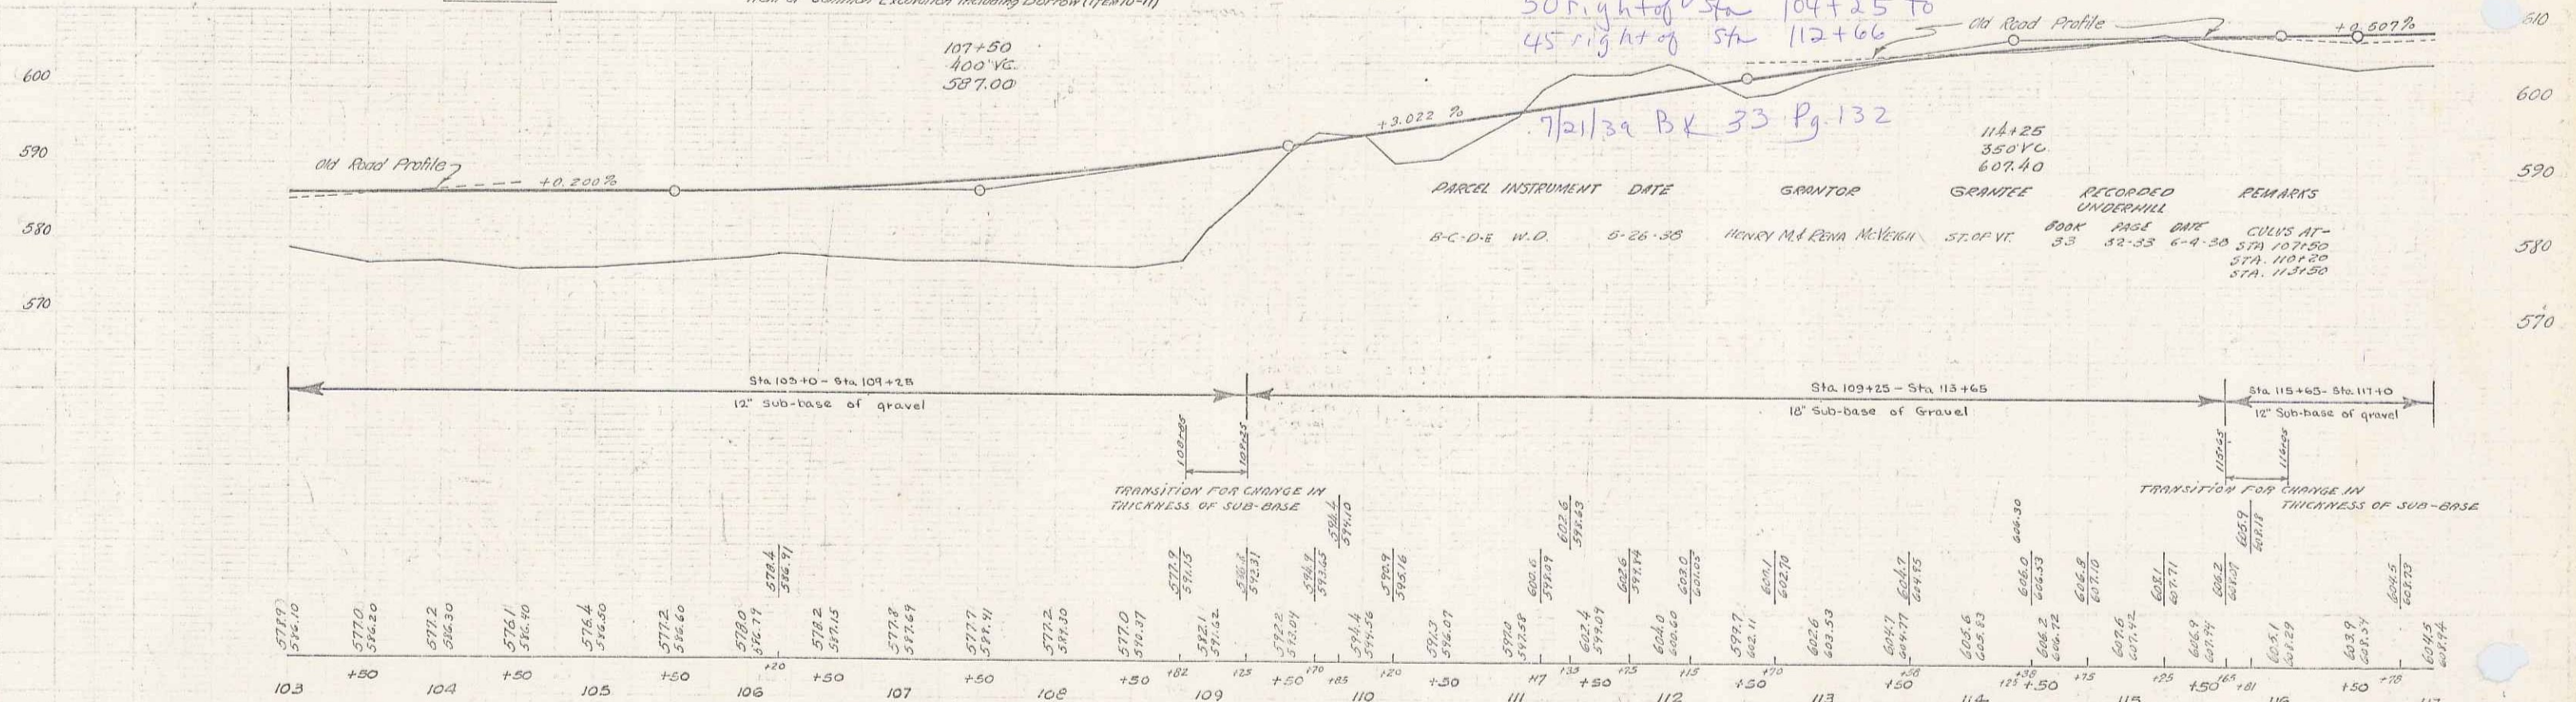

PARCEL INSTRUMENT DATE	GRANTOR	GRANTEE	RECORDED UNDERHILL	REMARKS
B-C-D-E W.D.	5-26-35	HENRY M. & REVA McVEIGH	ST. OF VT. BOOK PAGE DATE 33 32-33 6-4-30	CULVS AT STA 107+00 STA 107+00 STA 107+00 STA 113+50

B.M. N° 18: spot in root of 24" maple 60 ft right of sta. 104+00: Elevation: 590.80 -  
B.M. N° 19: spot in root of 18" maple 100 ft right of sta. 110+00: Elevation: 604.99 -