
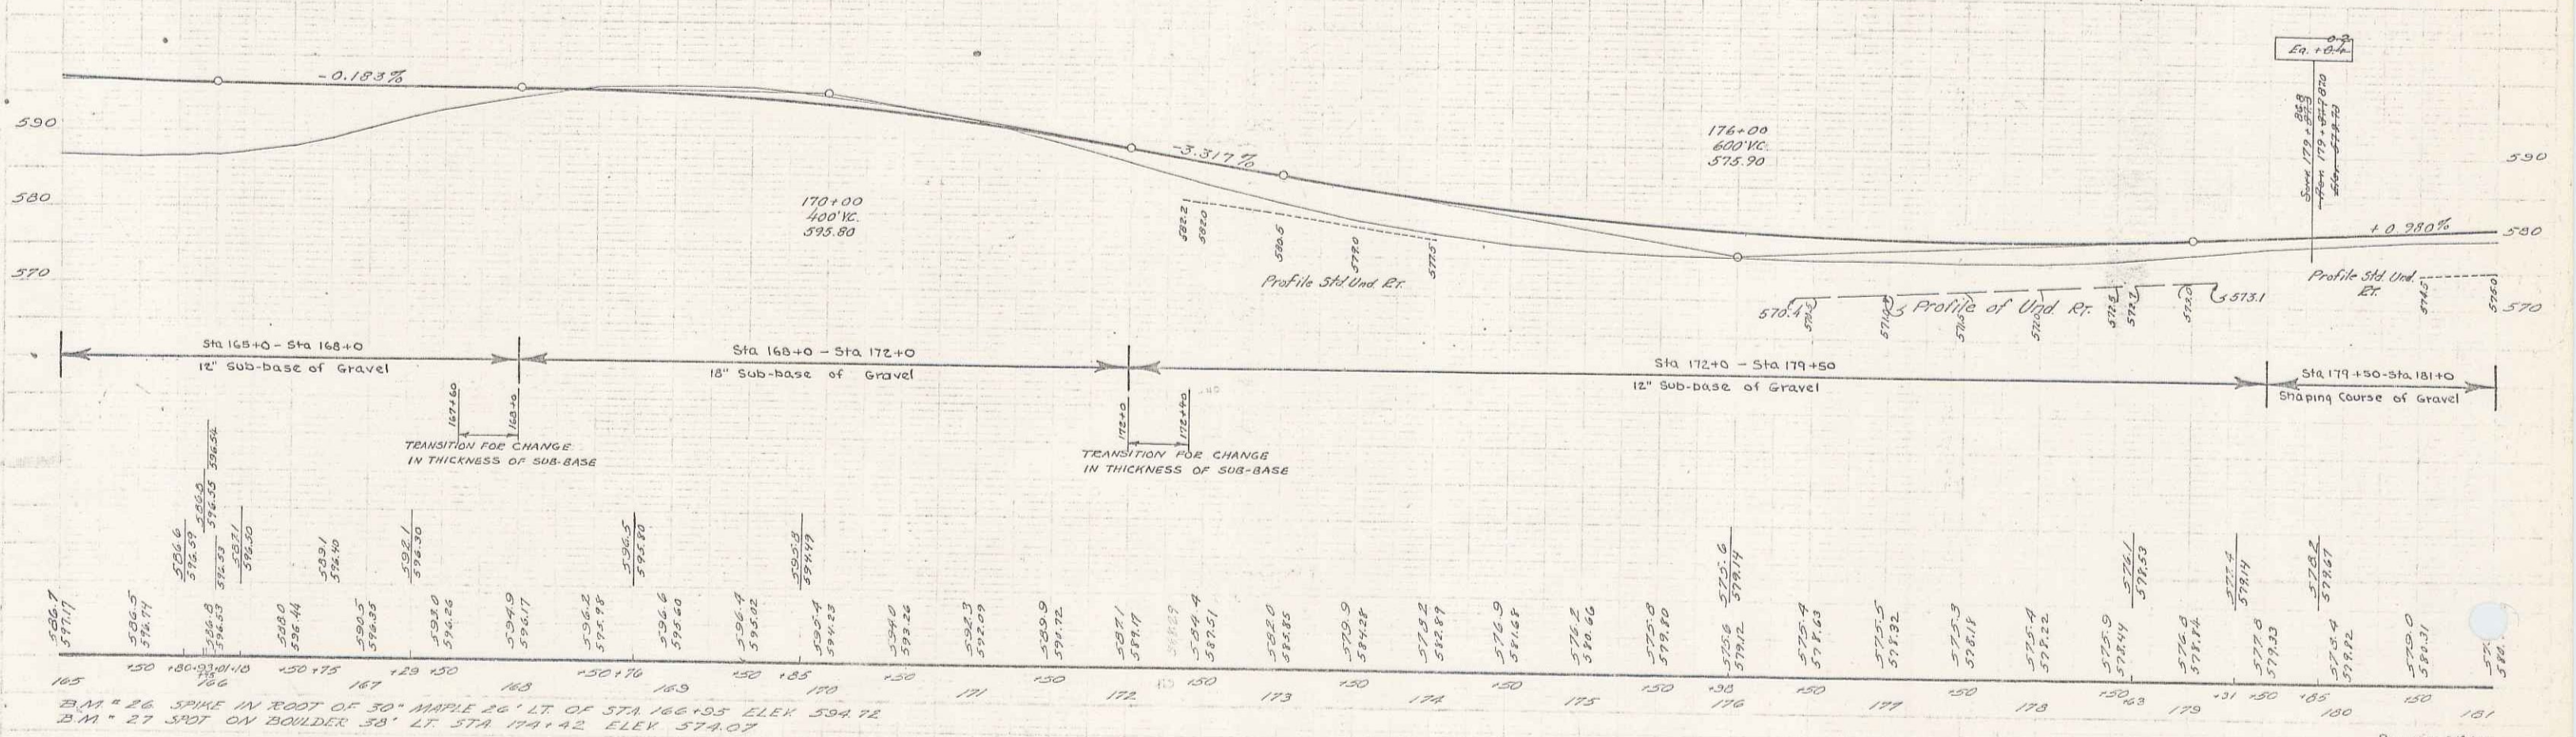


PARCEL	INSTRUMENT	DATE	GRANTOR	GRANTEE	RECORDED	REMARKS
A-B-C-D	O.C.O.	4-12-38	W.A. HAZEL WETHERBEE	ST. 171	BOOK PAGE DATE	CUL. STA.
A-B-C-D	O.C.O.	4-12-38	H.M. DAVIS	"	32 528-9 4-15-38	172+25
					122+00, 124+00, 122+00, 124+00	

ALL RIGHTS RESERVED
 STATE OF ILLINOIS
 DEPT. OF TRANSPORTATION
 DIVISION OF HIGHWAYS
 PROJECT NO. 1933
 SHEET NO. 15 OF 15

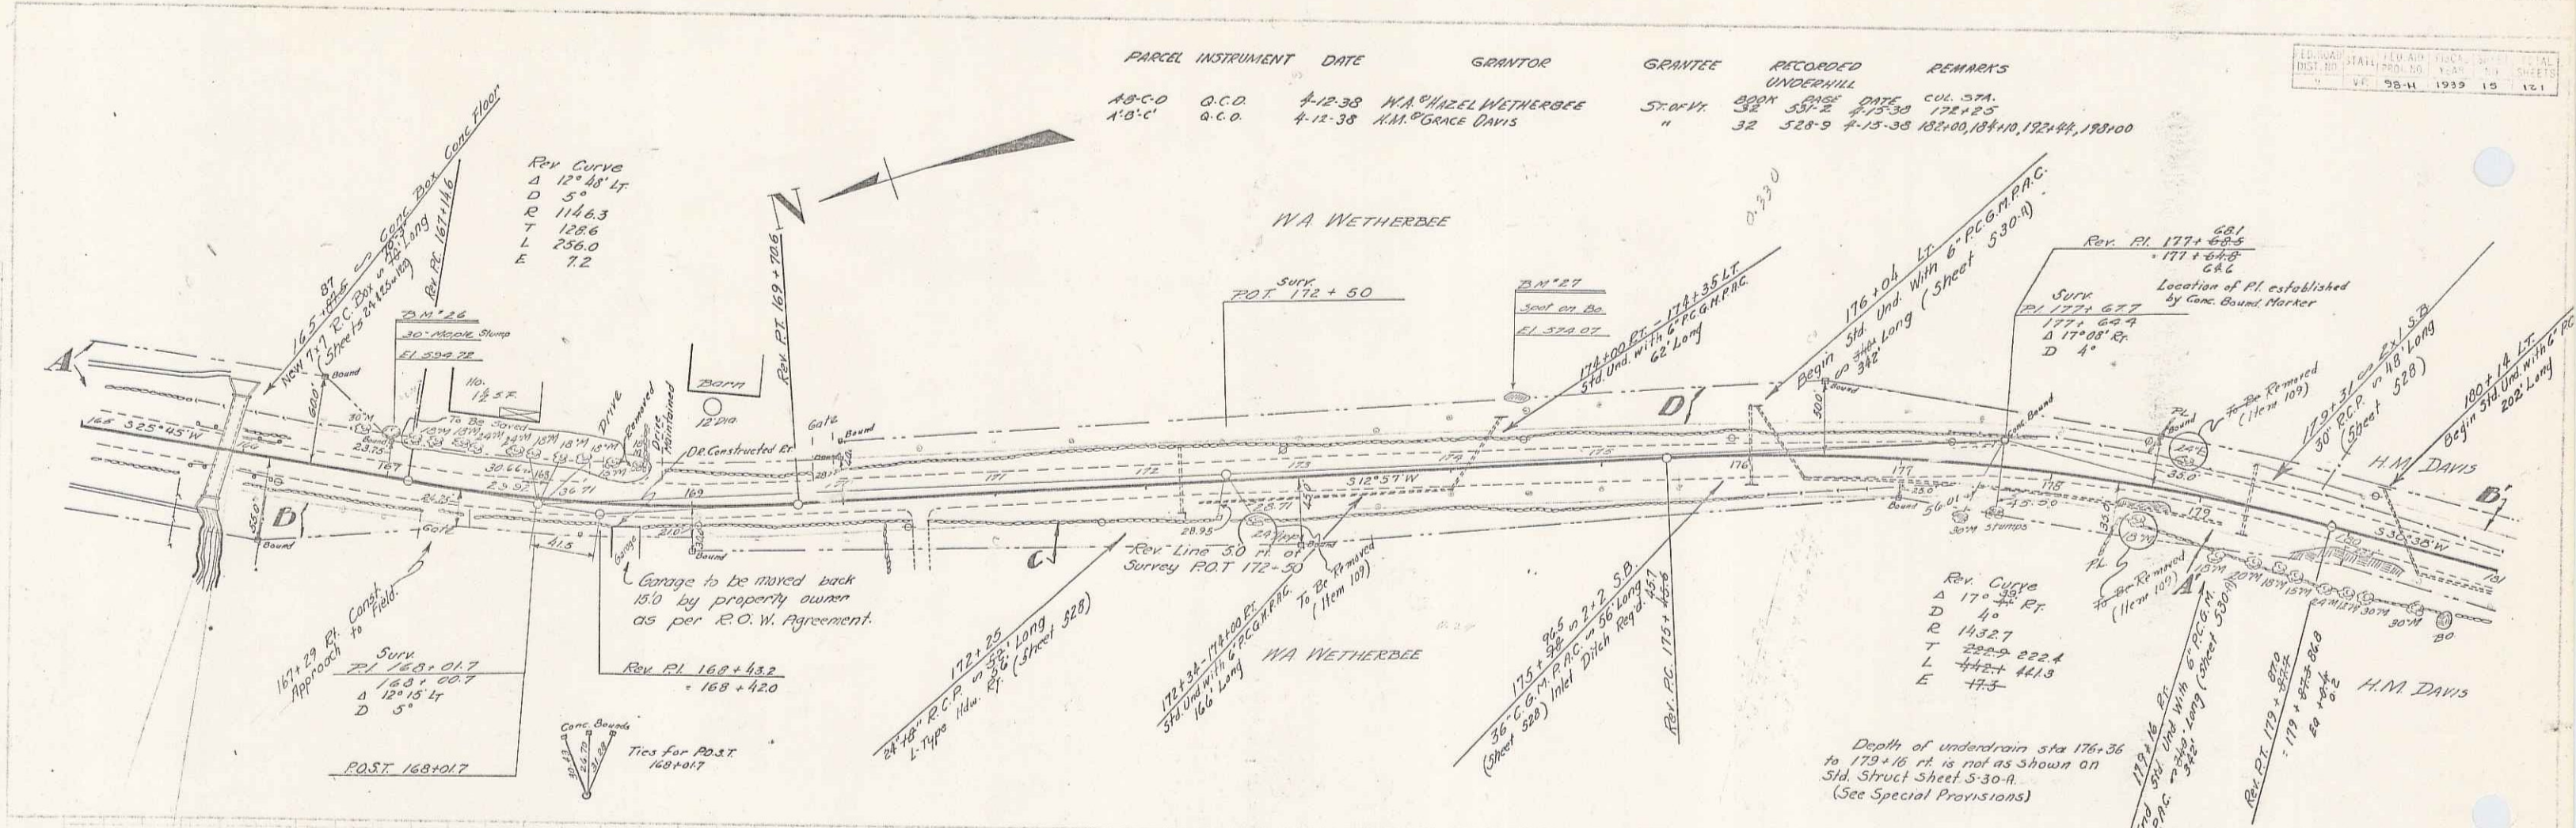

21 M * 26 SPIKE IN ROOT OF 30" MAPLE 26' LT. OF STA 166+53 ELEV 594.72
 21 M * 27 SPOT ON BOULDER 38' LT. STA 174+42 ELEV 574.07

SERIES P.R. 16 98H
 SHEET 15 OF 15