


Control of section of highway relinquished to Town of Underhill  
 Begins: 33' left of E440+97 extending southwly 0.26 mi to 45' left of 253+19.  
 7/21/39 BK 33 Pg 132

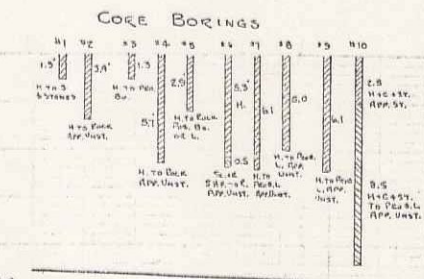

Location of P.I. established by Conc. Ground Marker  
 P.I. 233+20.0  
 235+13.1

PARCEL INSTRUMENT	DATE	GRANTOR	GRANTEE	RECORDED UNDERFILE	REMARKS
A	G.C.D. 4-12-38	JUDSON CLARK	STATE	32	
A-B	ADMM. DECD. 6-8-38	OLA M. ROSCOE (ADM.)	"	33	16-17 6-11-38

BRIDGE DATA (BANK & TYP)		
TYPE	EXISTING	PROPOSED
SPAN	1 @ 24'	2 BEAM CONC. SLAB
CLEAR HT.	5.0'	5.0'
WATERWAY	180"	185"
OVERALL WID.	24'	24'
ROAD WID.	24'	24'

242+00  
500' VC  
534.07

