


State of Vt to
I. James Beams
QCD 5/2/74
BK 44 Pg 293

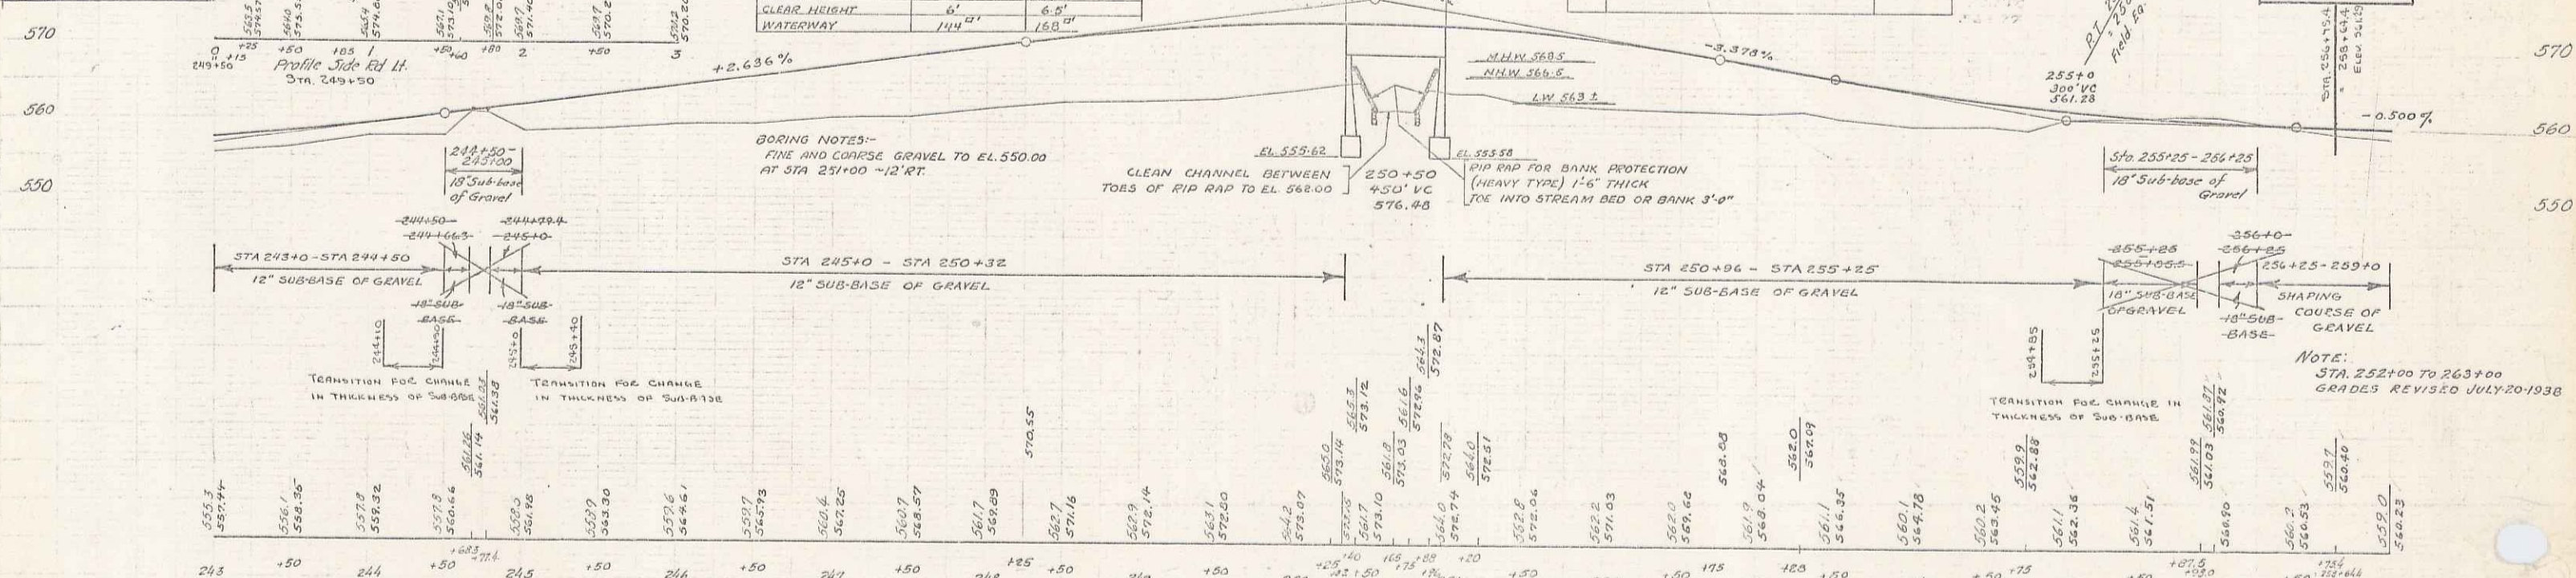

B.M. #35 Spike in Root 30' Maple 205' H. Sta. 243+82 Elev. 565.38

RECORDED UNDERHILL

BOOK	PAGE	DATE
33	16-17	6-11-38

LIST OF SHEETS FOR BRIDGE ONLY

SHEET NO.	DESCRIPTION
53	SUPERSTRUCTURE DETAILS
54	DETAILS OF ABUT. #1
55	DETAILS OF ABUT. #2
56	SS SC - CURBS & RAIL
57	SS SC - DETAILS
58	SS SC - DETAILS

NOTE: STA. 252+00 TO 263+00 GRADES REVISED JULY 20 1938

SEE ALSO R.A.P. No. 98-H SHEET ZONE 1-1