



PLAN  
 BARRETT  
 D. MACCHI  
 4/25/34  
 TACID

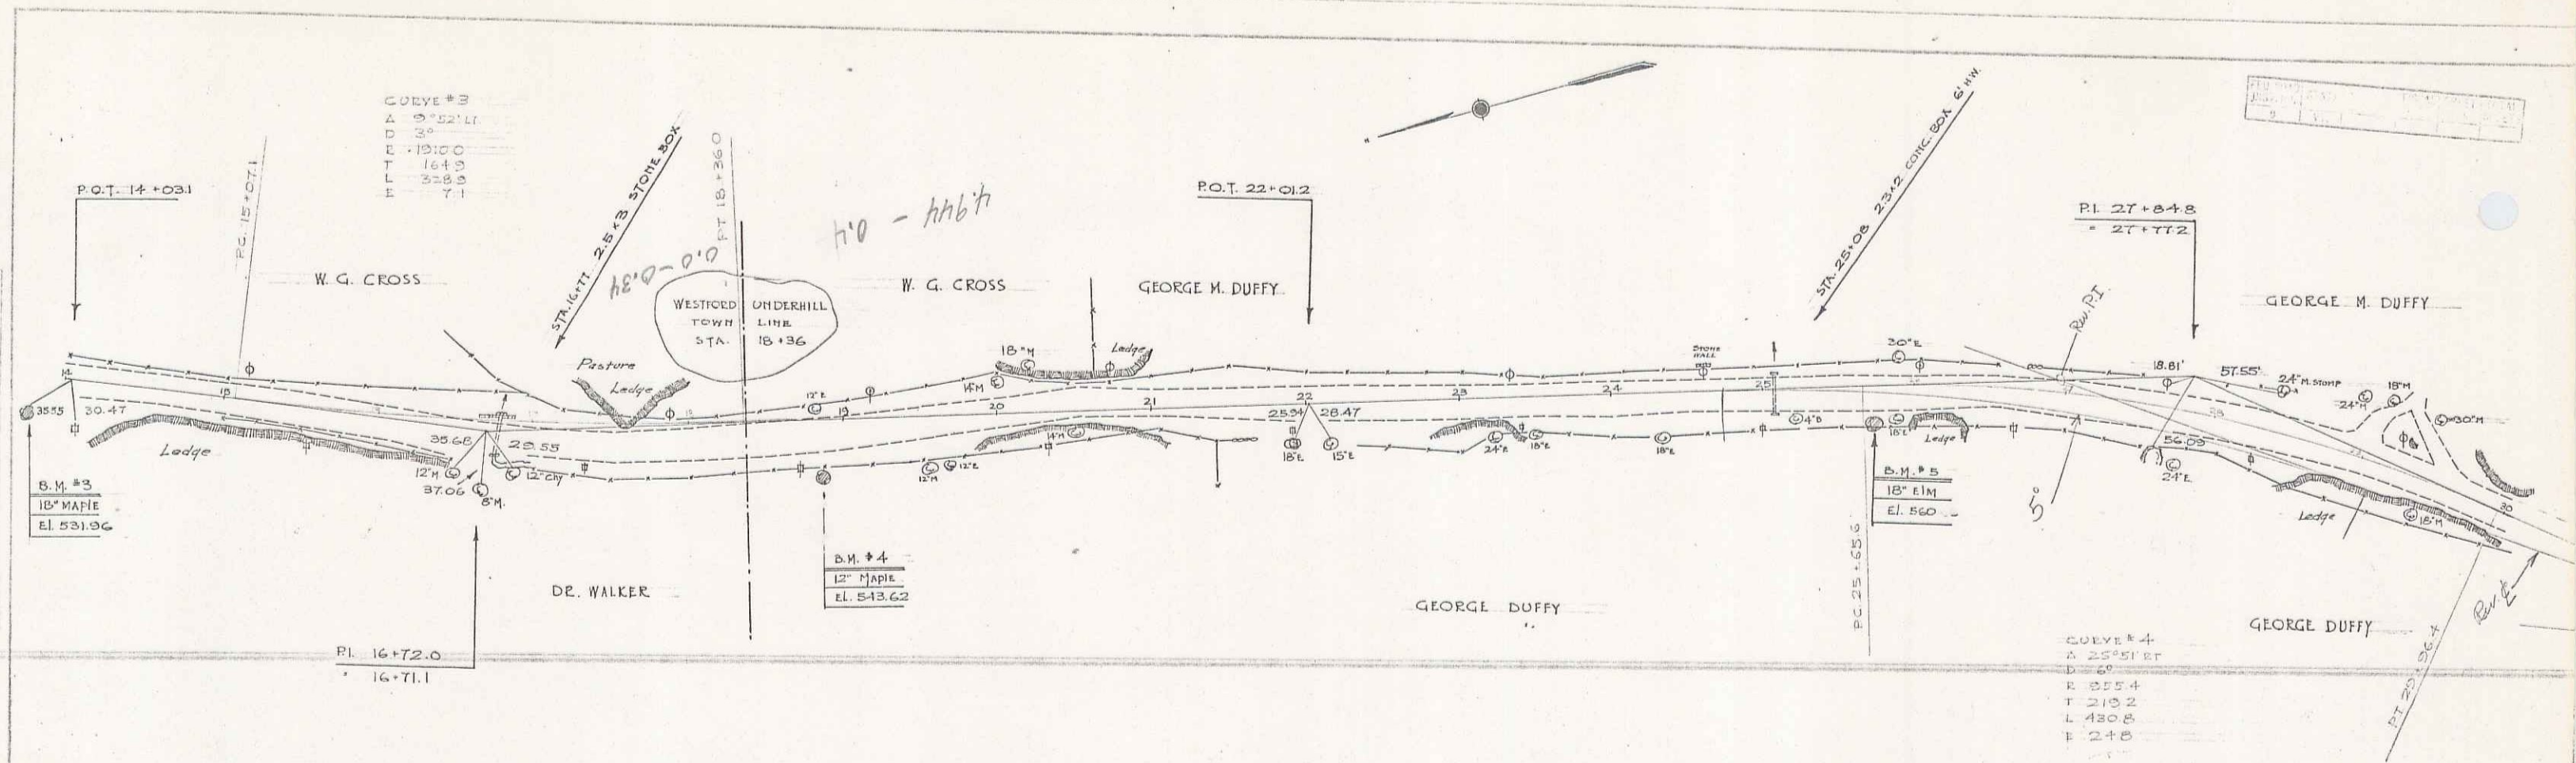

PROFILE  
 WOOD  
 BRUCE

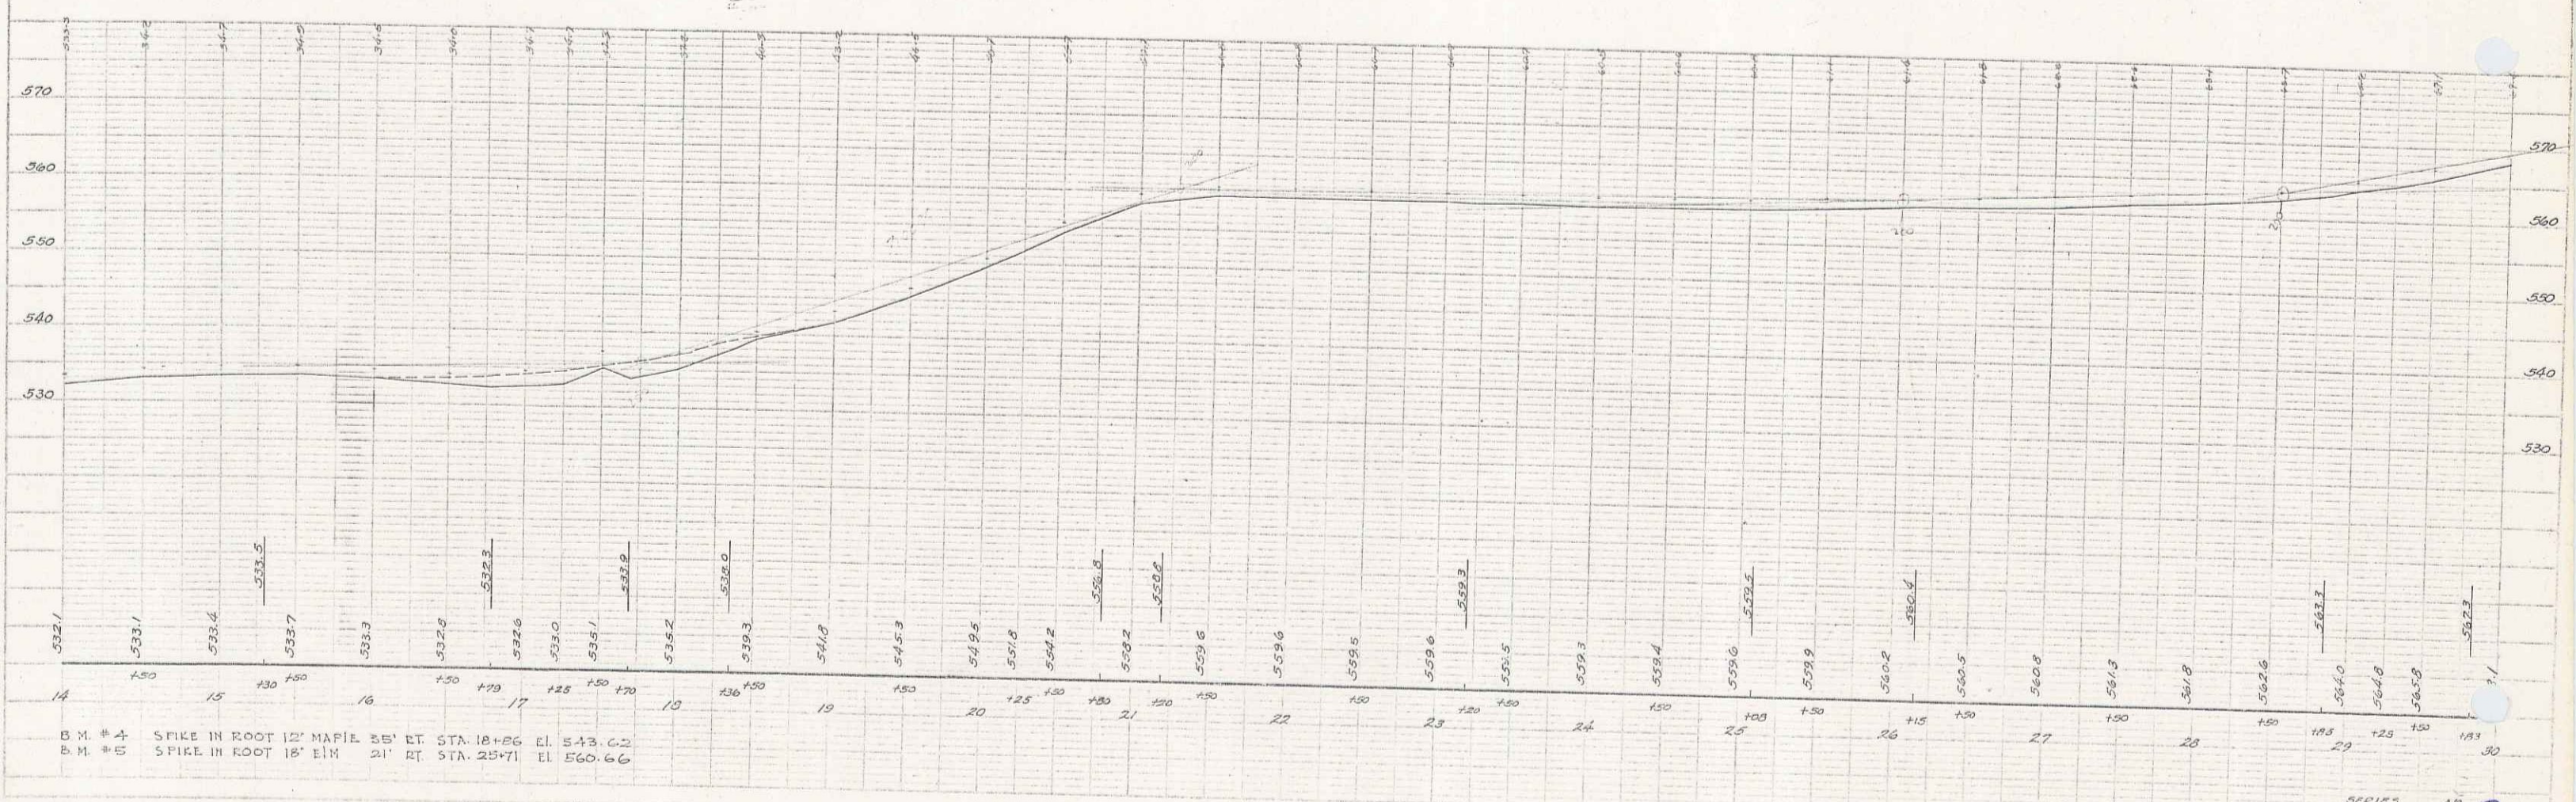

SERIES NO. 17  
 SHEET 2 OF 17

2