
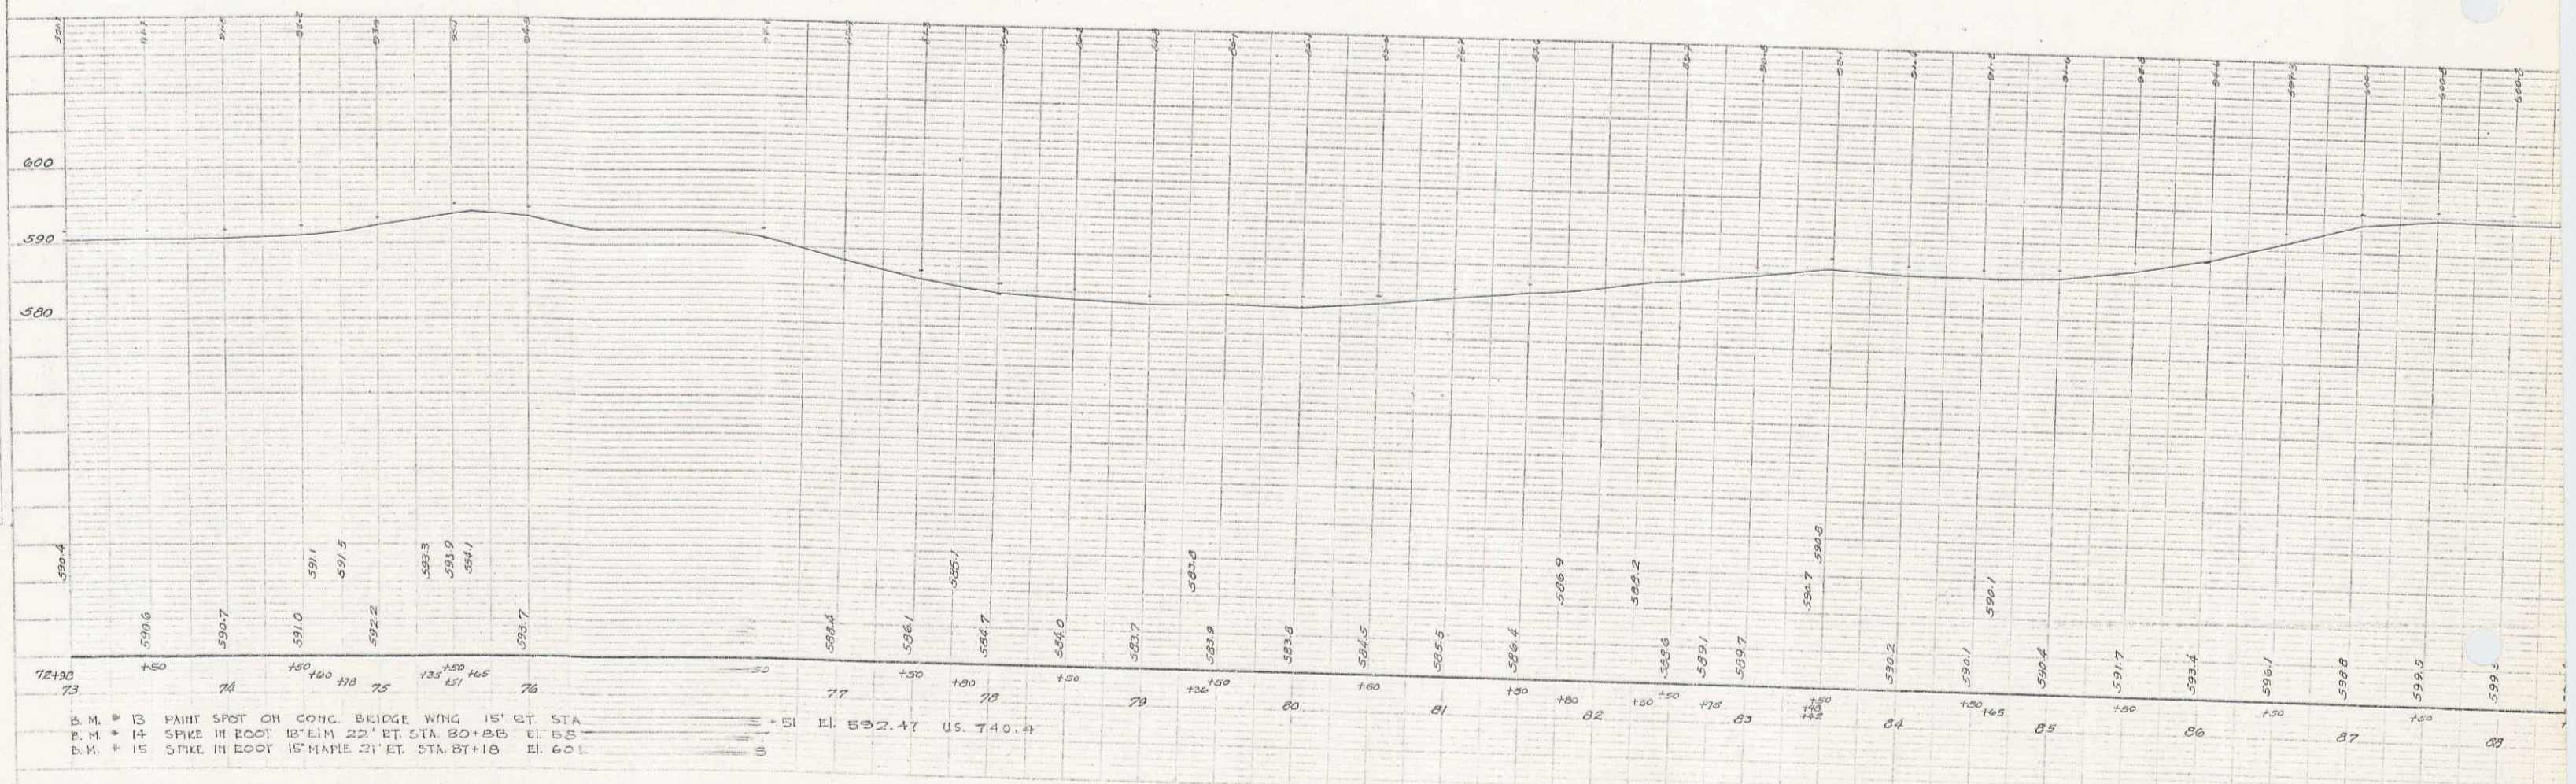


PLAN
 DATE 4/27/54
 DRAWN BY D. MACCHI
 CHECKED BY D. MACCHI

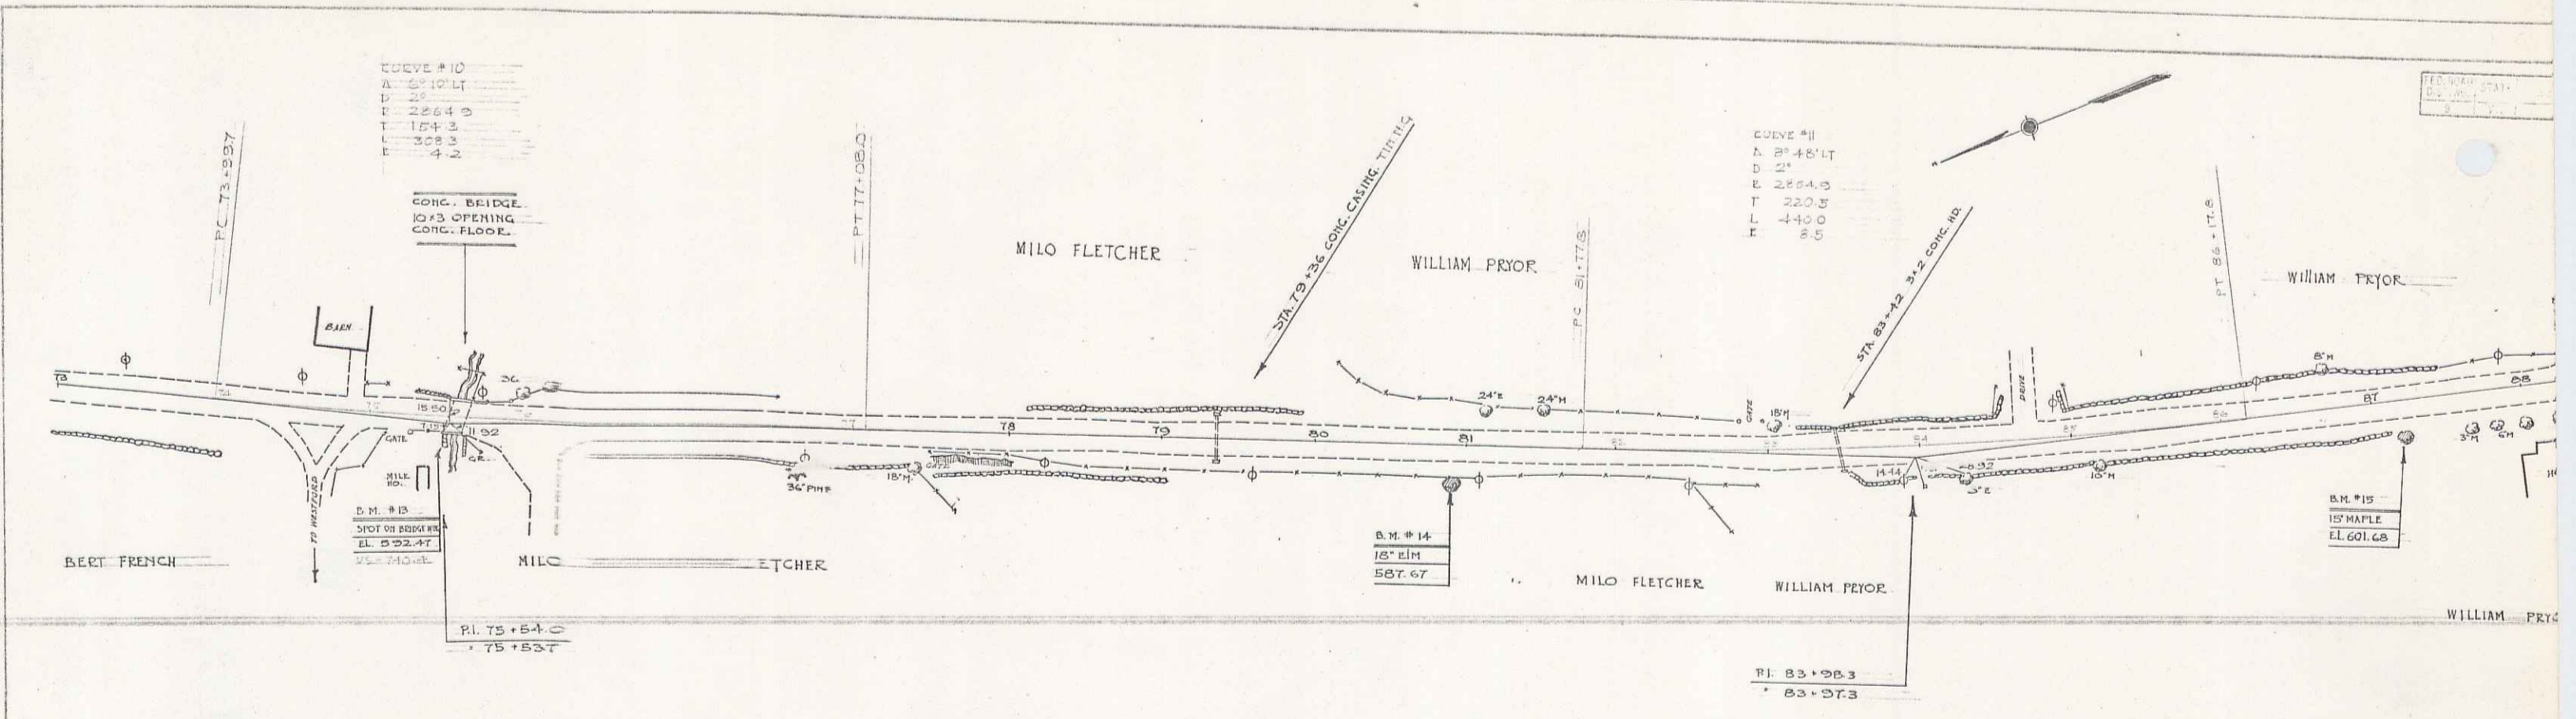

SERIES
 SHEET 5
 17
 6