
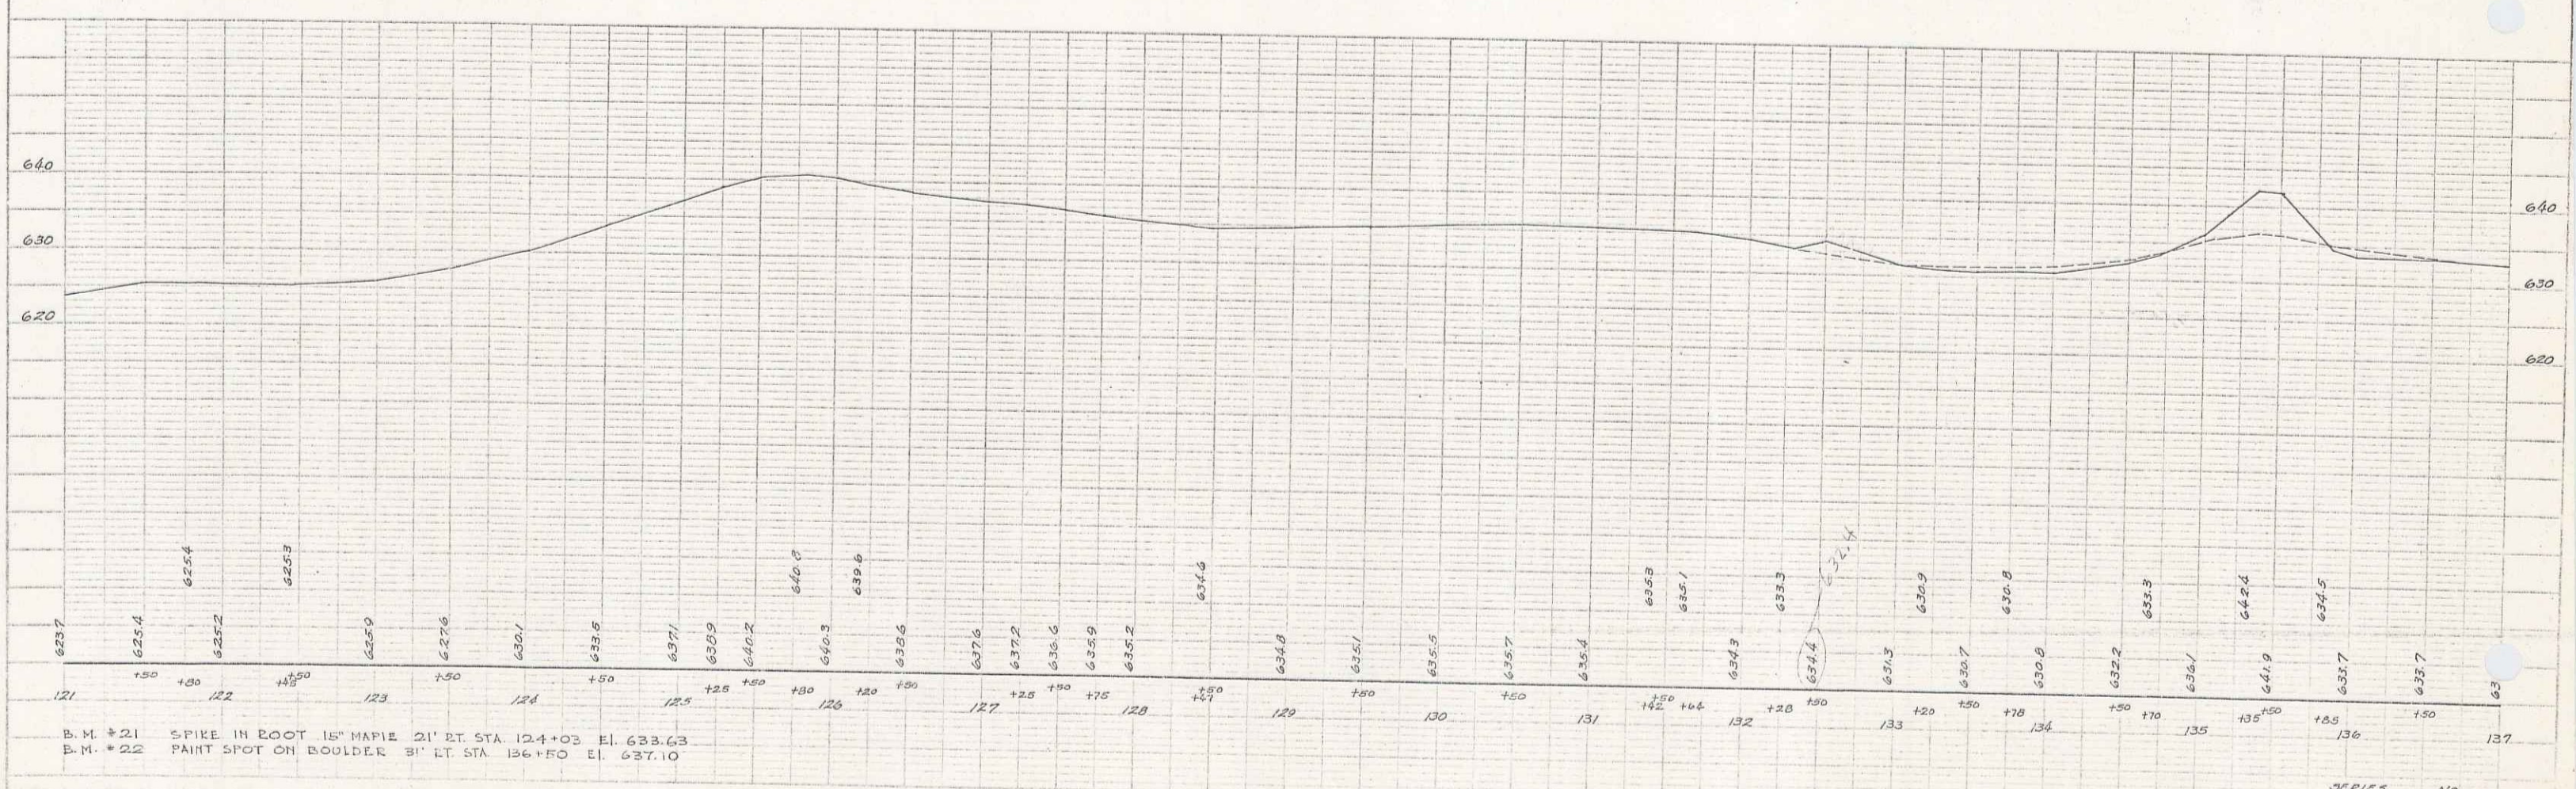


BARRETT  
 D. MACCHI  
 4/27/54  
 TRACED  
 D. MACCHI

WOOD  
 SECT.  
 10' x 12'

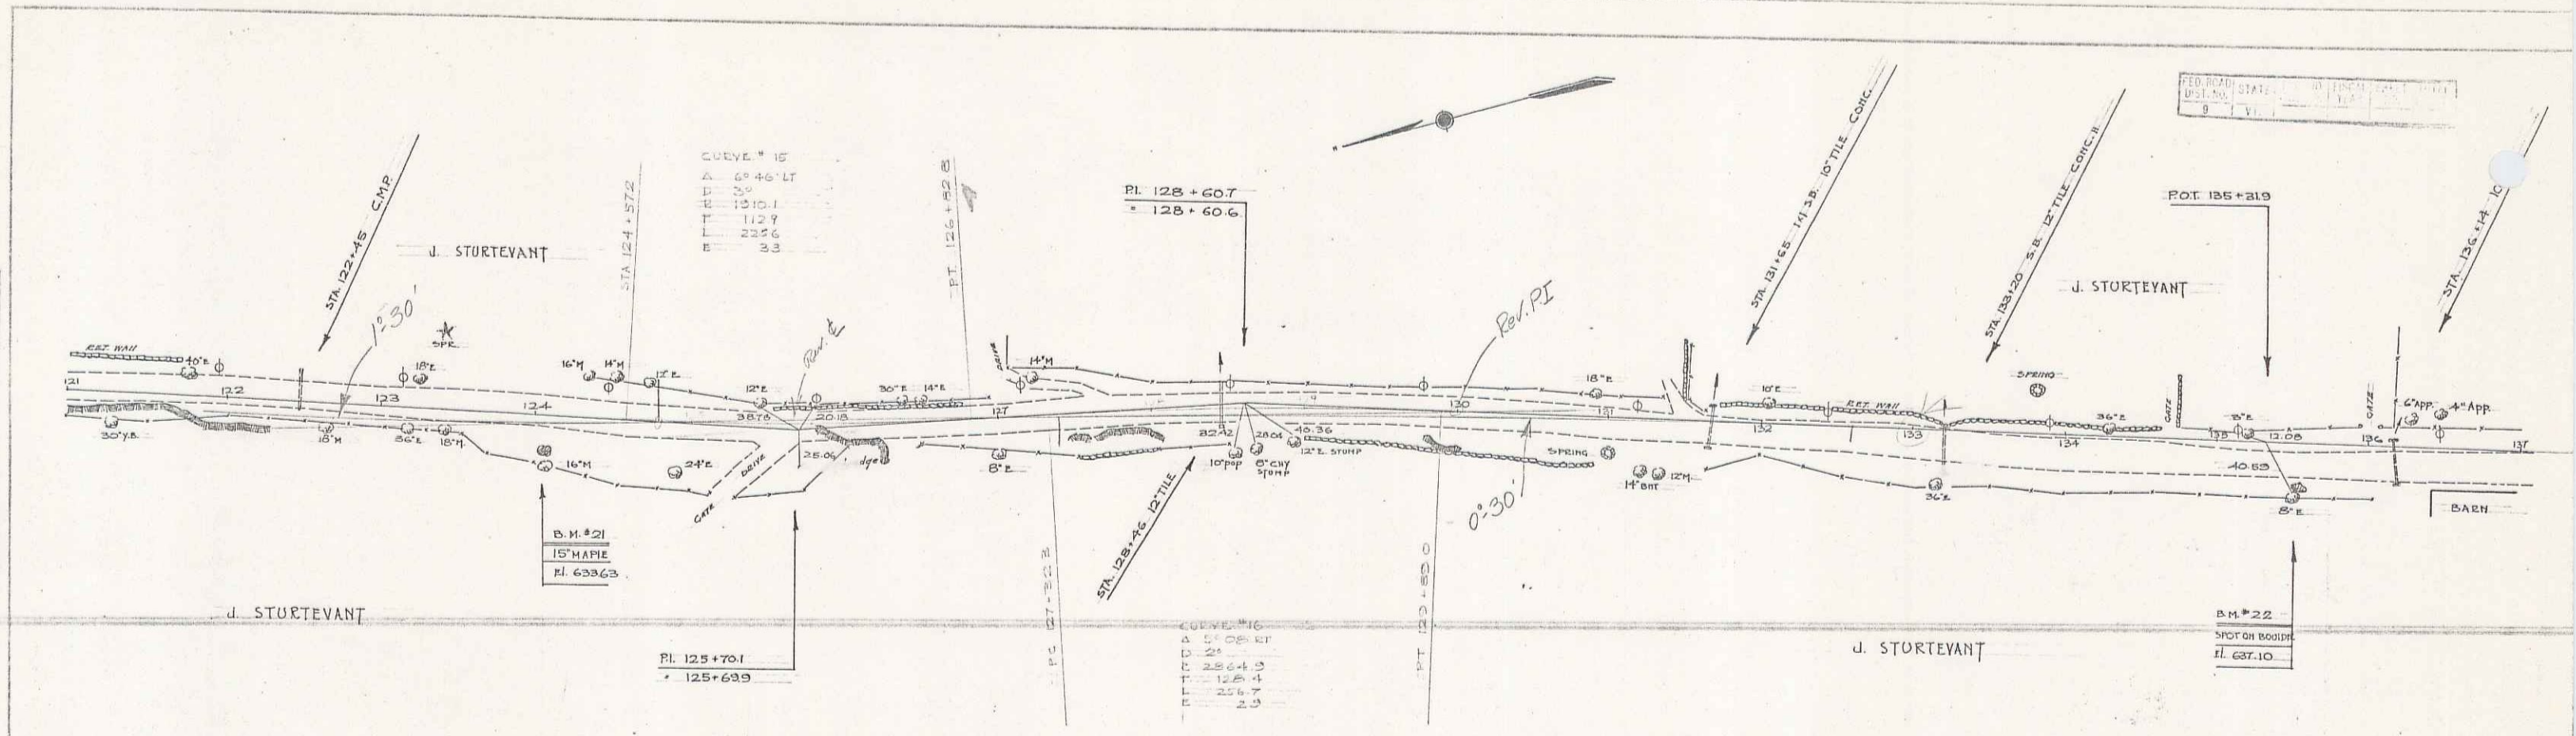

B.M. #21 SPIKE IN ROOT 15' MAPLE 21' ST. STA. 124+03 EL. 633.63  
 B.M. #22 PAINT SPOT ON BOULDER 31' EL. STA. 136+50 EL. 637.10

SERIES NO. 8  
 SHEET 8 OF 17