
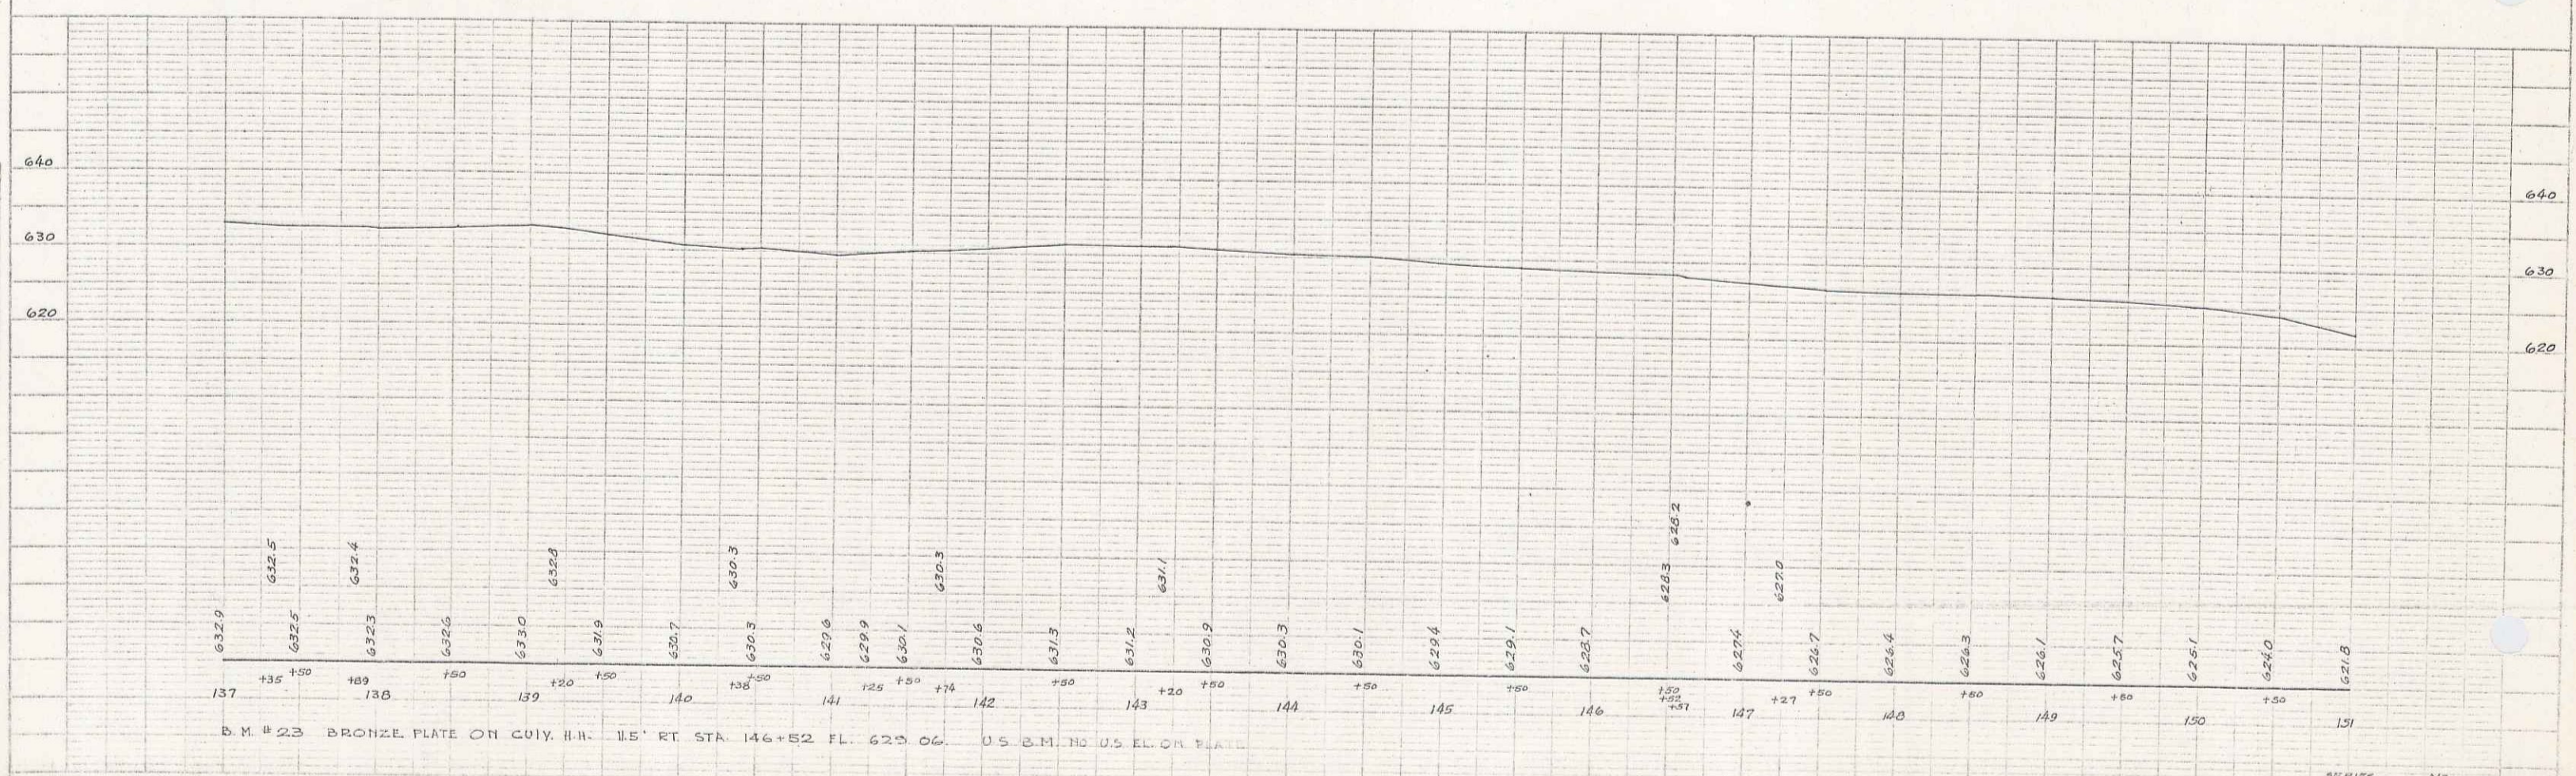


PLAN
 DRAWN BY
 B. MACCHI
 CHECKED BY
 D. MACCHI
 DATE
 11/14/12

WOOD
 BLOCK
 NO. 23

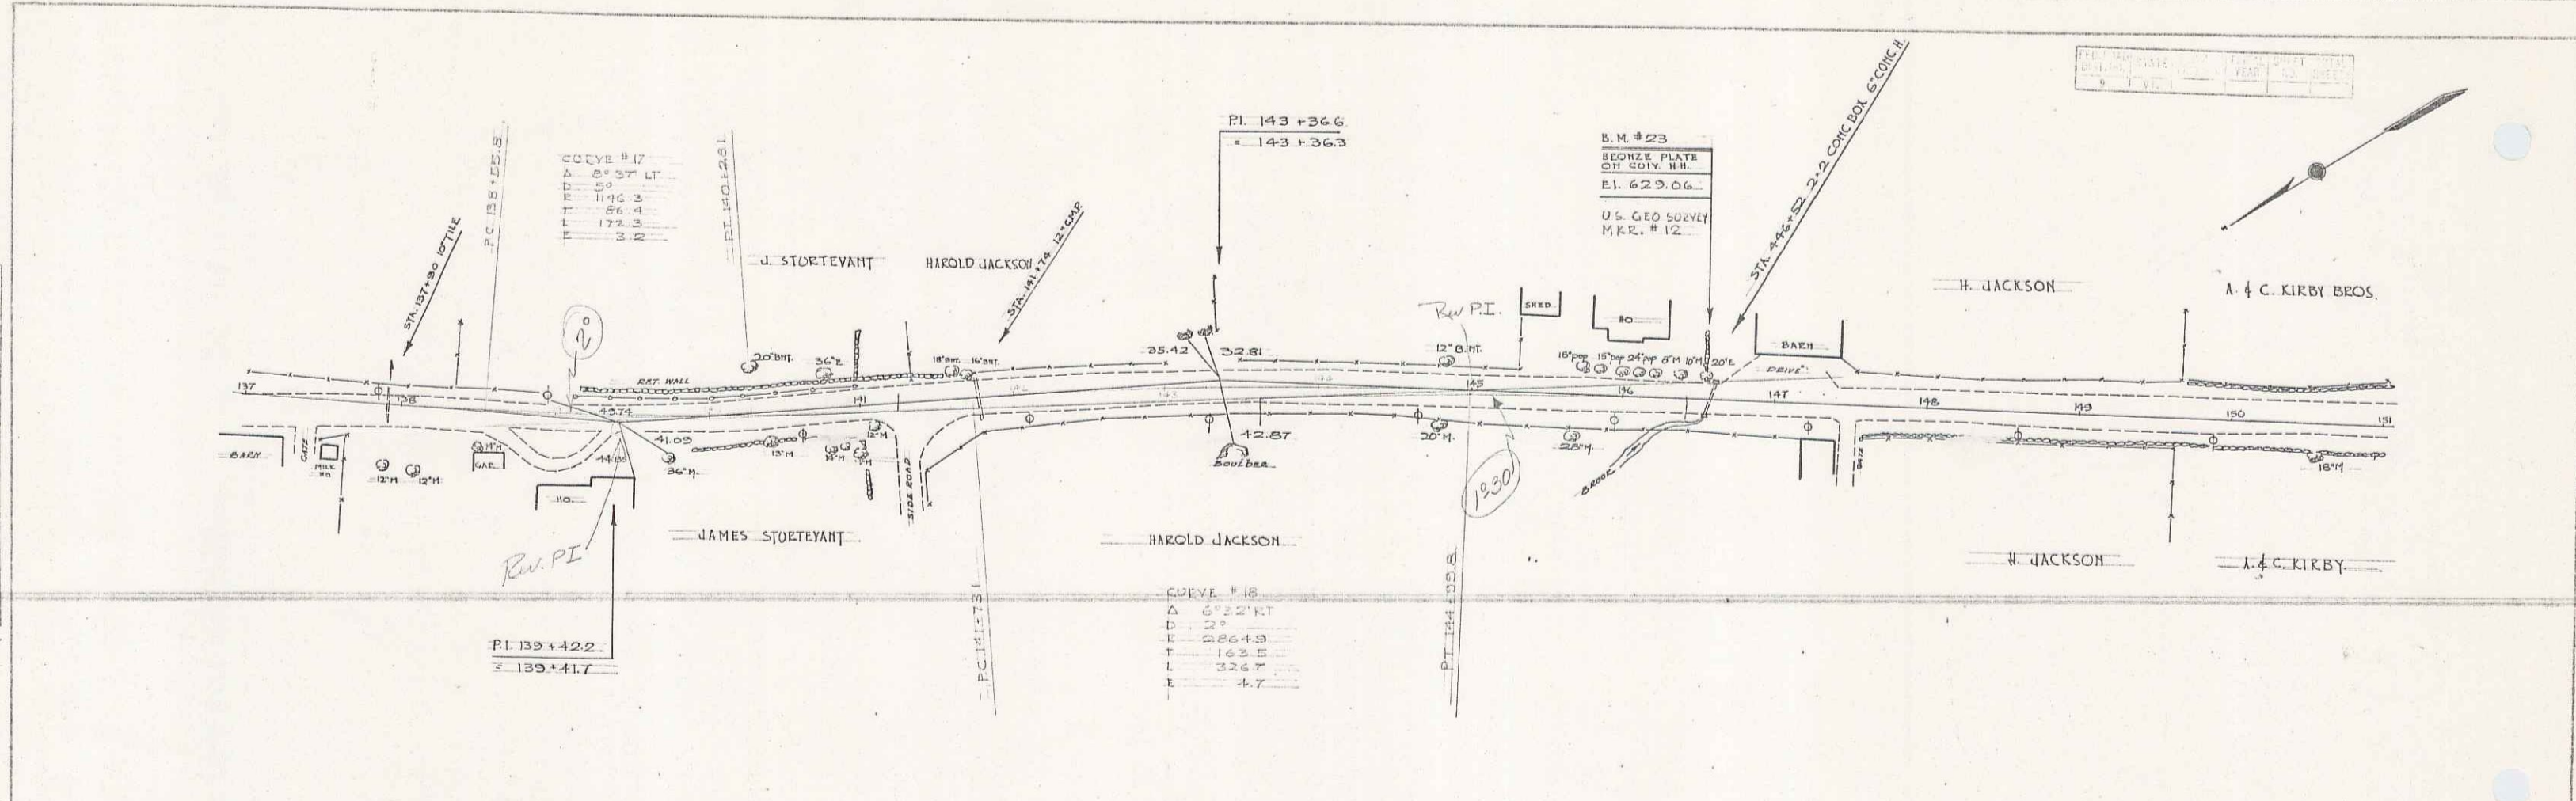

B.M. #23 BRONZE PLATE ON CURB 15' RT. STA. 146+52 FL. 623.06 U.S. G.S. SURVEY M.K.R. # 12

PLATE # 23 - PROFILE OF ROAD
 DATE: 11/14/12

SERIES NO. 9 OF 17
 SHEET 9 OF 17
 13