


CURVE #7
 A 2'-17" RT
 D 0'51"
 R 22.20.03
 T 412.7
 L 312.3
 E 4.6

STA 66720
 ELEV 259.2
 300 V.C.

STA 66720
 ELEV 261.74
 200 V.C.

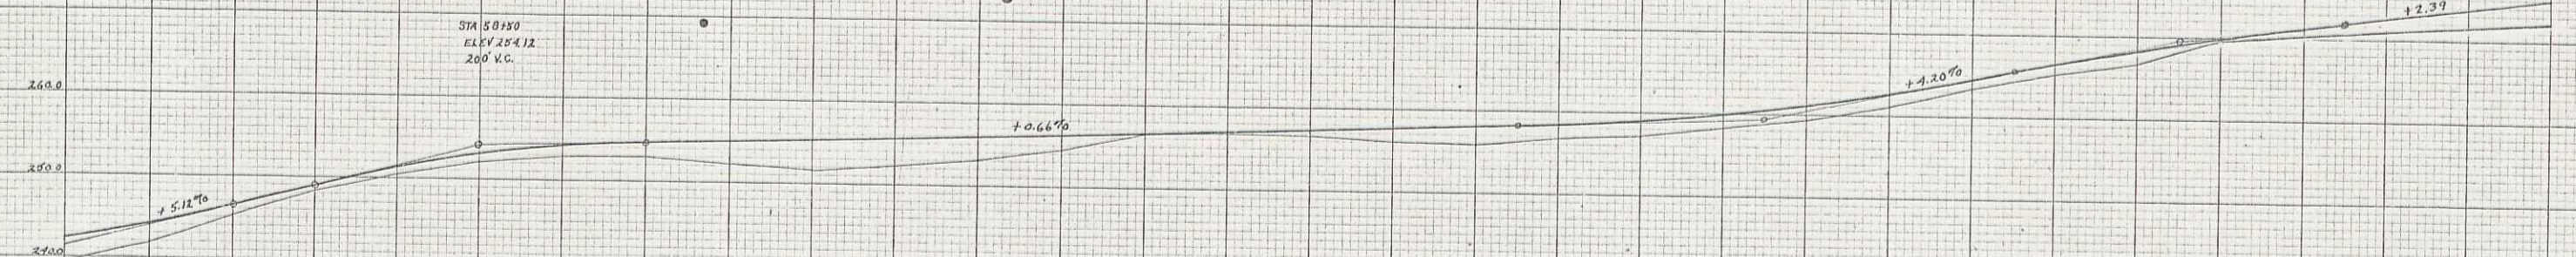

WESTFORD-CAMBRIDGE
 CLOVERDALE ROAD
 STONE BASE COURSE GRAP

MAY 7-12-30 PUTMAN

E.H.S.

STANDARD CROSS SECTION 10 X 10
 KUEPPEL & EBER - NEW YORK

MADE IN U.S.A.

STANDARD CROSS SECTION 10 X 10
 KUEPPEL & EBER - NEW YORK

MADE IN U.S.A.

STANDARD CROSS SECTION 10 X 10
 KUEPPEL & EBER - NEW YORK

5