



NOTE: For Stone Fill is to be obtained from the ledge on the right of Sta 63+00-70+00.

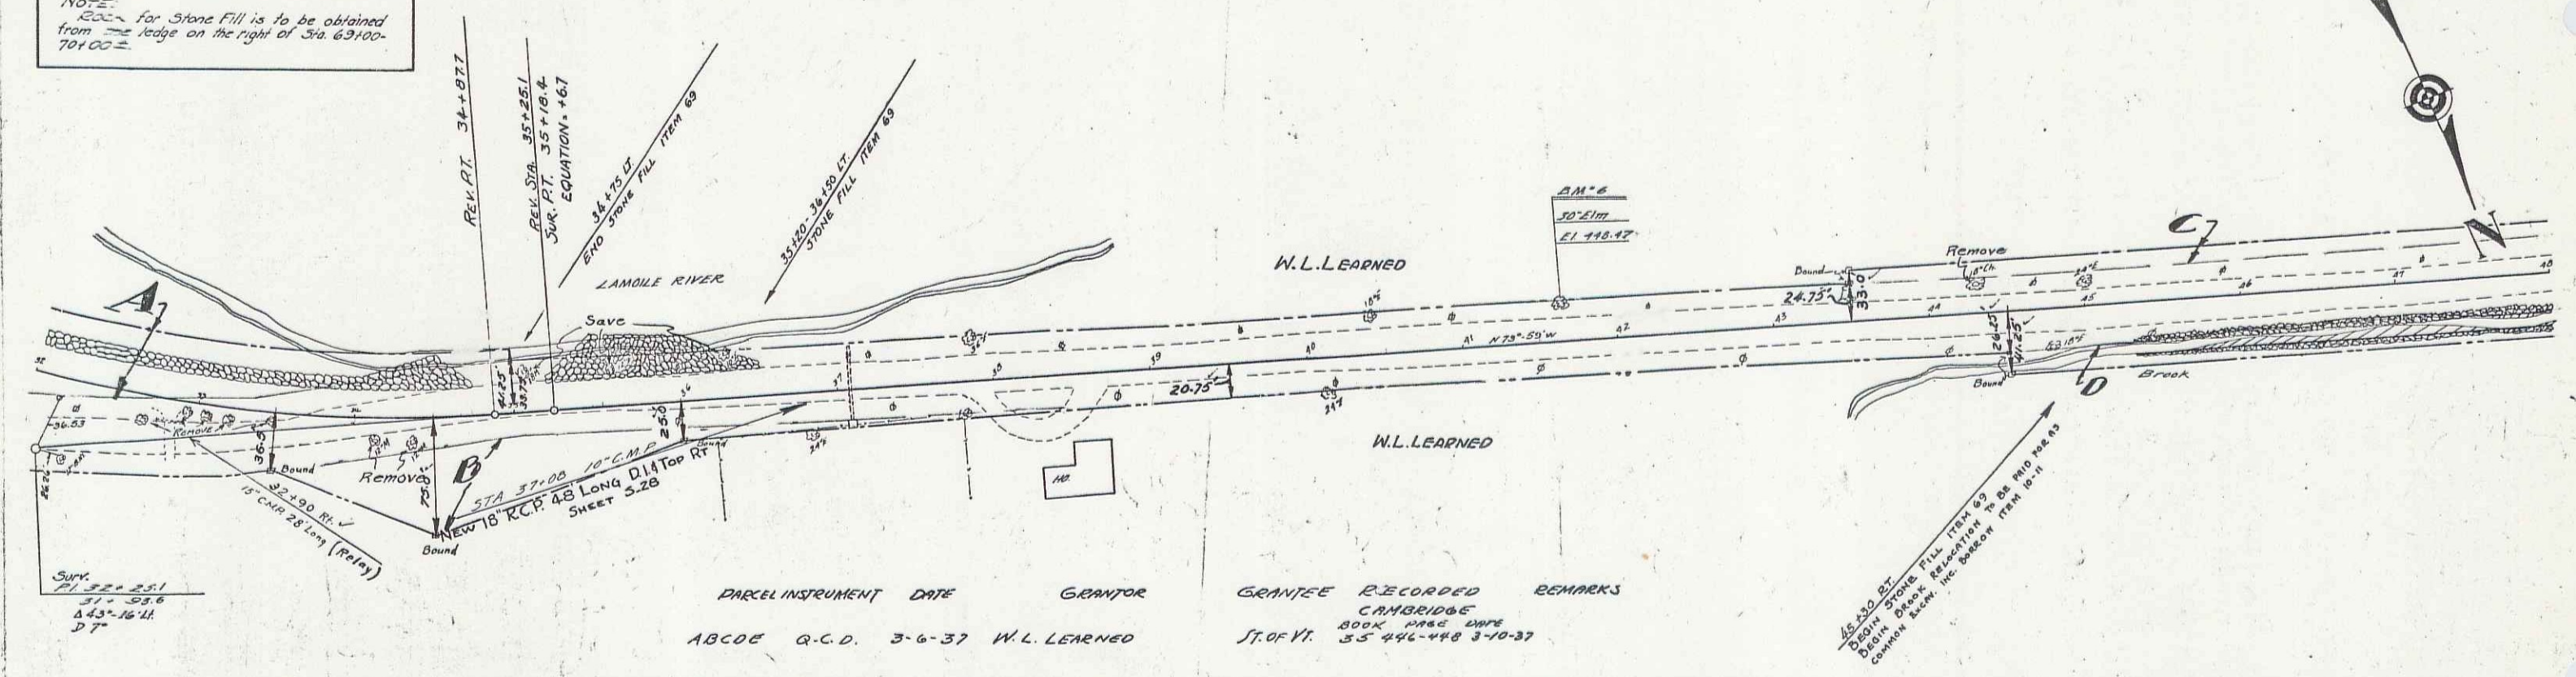

PARCEL INSTRUMENT	DATE	GRANTOR	GRANTEE	RECORDED	REMARKS
ABCDE	Q.C.D.	3-6-37	W.L. LEARNED	ST. OF VT.	35-446-448 3-10-37

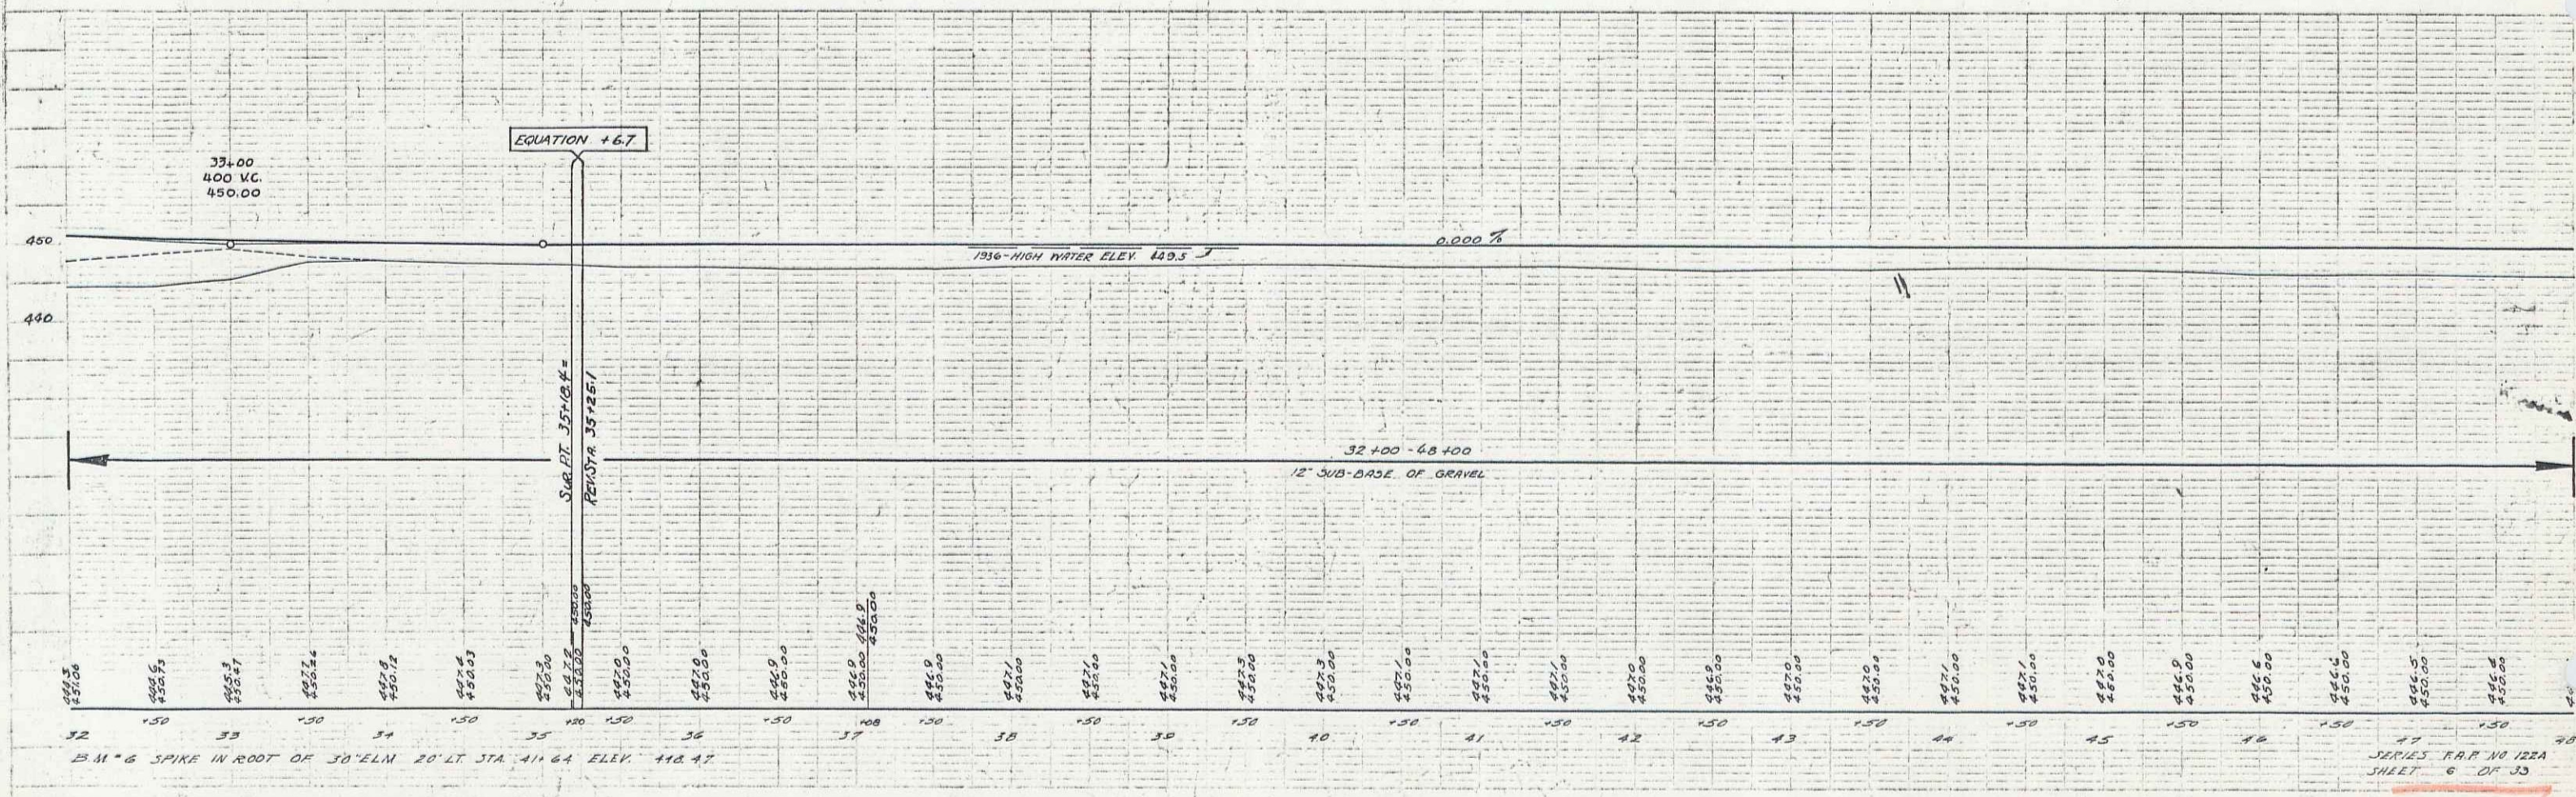

32+00  
400.00  
450.00

33+00  
400.00  
450.00

34+00  
400.00  
450.00

35+00  
400.00  
450.00

36+00  
400.00  
450.00

37+00  
400.00  
450.00

38+00  
400.00  
450.00

39+00  
400.00  
450.00

40+00  
400.00  
450.00

41+00  
400.00  
450.00

42+00  
400.00  
450.00

43+00  
400.00  
450.00

44+00  
400.00  
450.00

45+00  
400.00  
450.00

46+00  
400.00  
450.00

47+00  
400.00  
450.00

48+00  
400.00  
450.00

38  
SERIES R.P.R. NO 122A  
SHEET 6 OF 33

4