


Lone R. Griffith  
 Jan. 7 1937

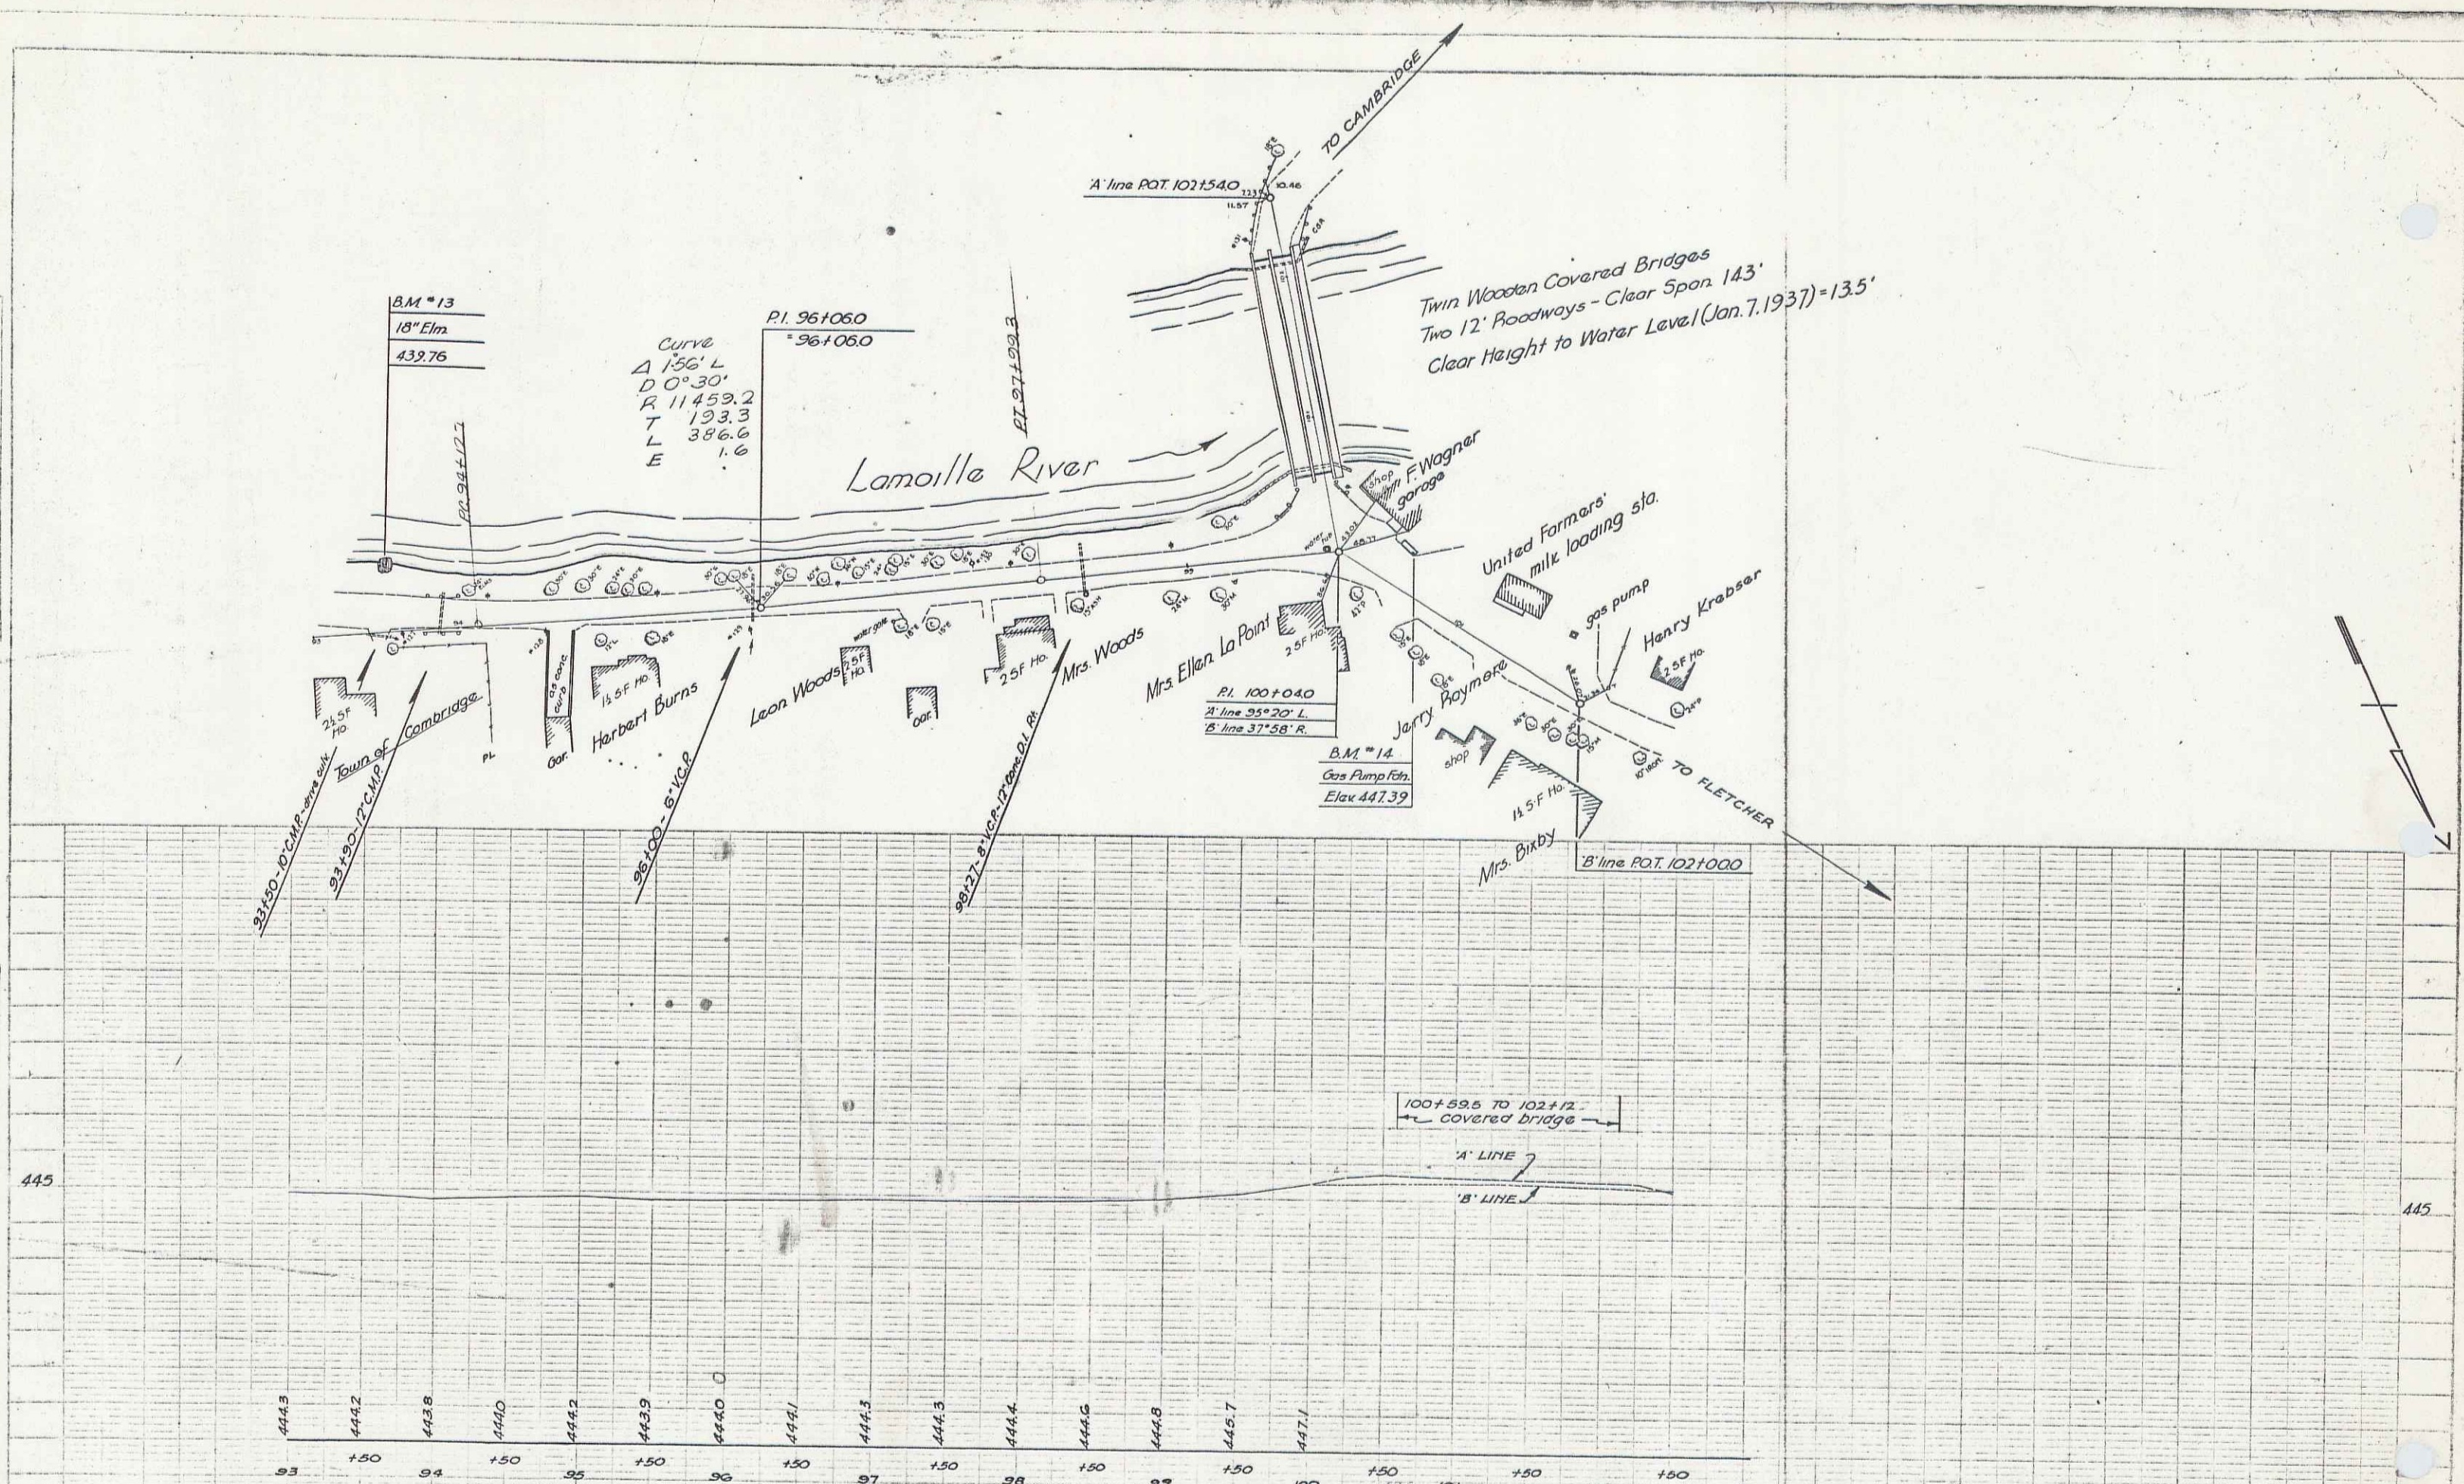

B.M. # 13 - Spike in 18" elm - 47' left of sta. 93+52 - Elev: 439.76  
 B.M. # 14 - Spot on gasoline pump foundation 25' left of 'B' line sta. 100+49 - Elev: 447.39