


PARCEL	INSTRUMENT	DATE	GRANTOR	GRANTEE	RECORDED	REMARKS
A	G.C.O.	2-23-37	ZENO E. M. KNEELAND	ST. OF VT.	BOOK PAGE DATE	
A'	G.C.O.	10-28-37	DONALD F. BERTRAND	"	35 447-50 3-10-37	
					35 501-2 10-30-37	

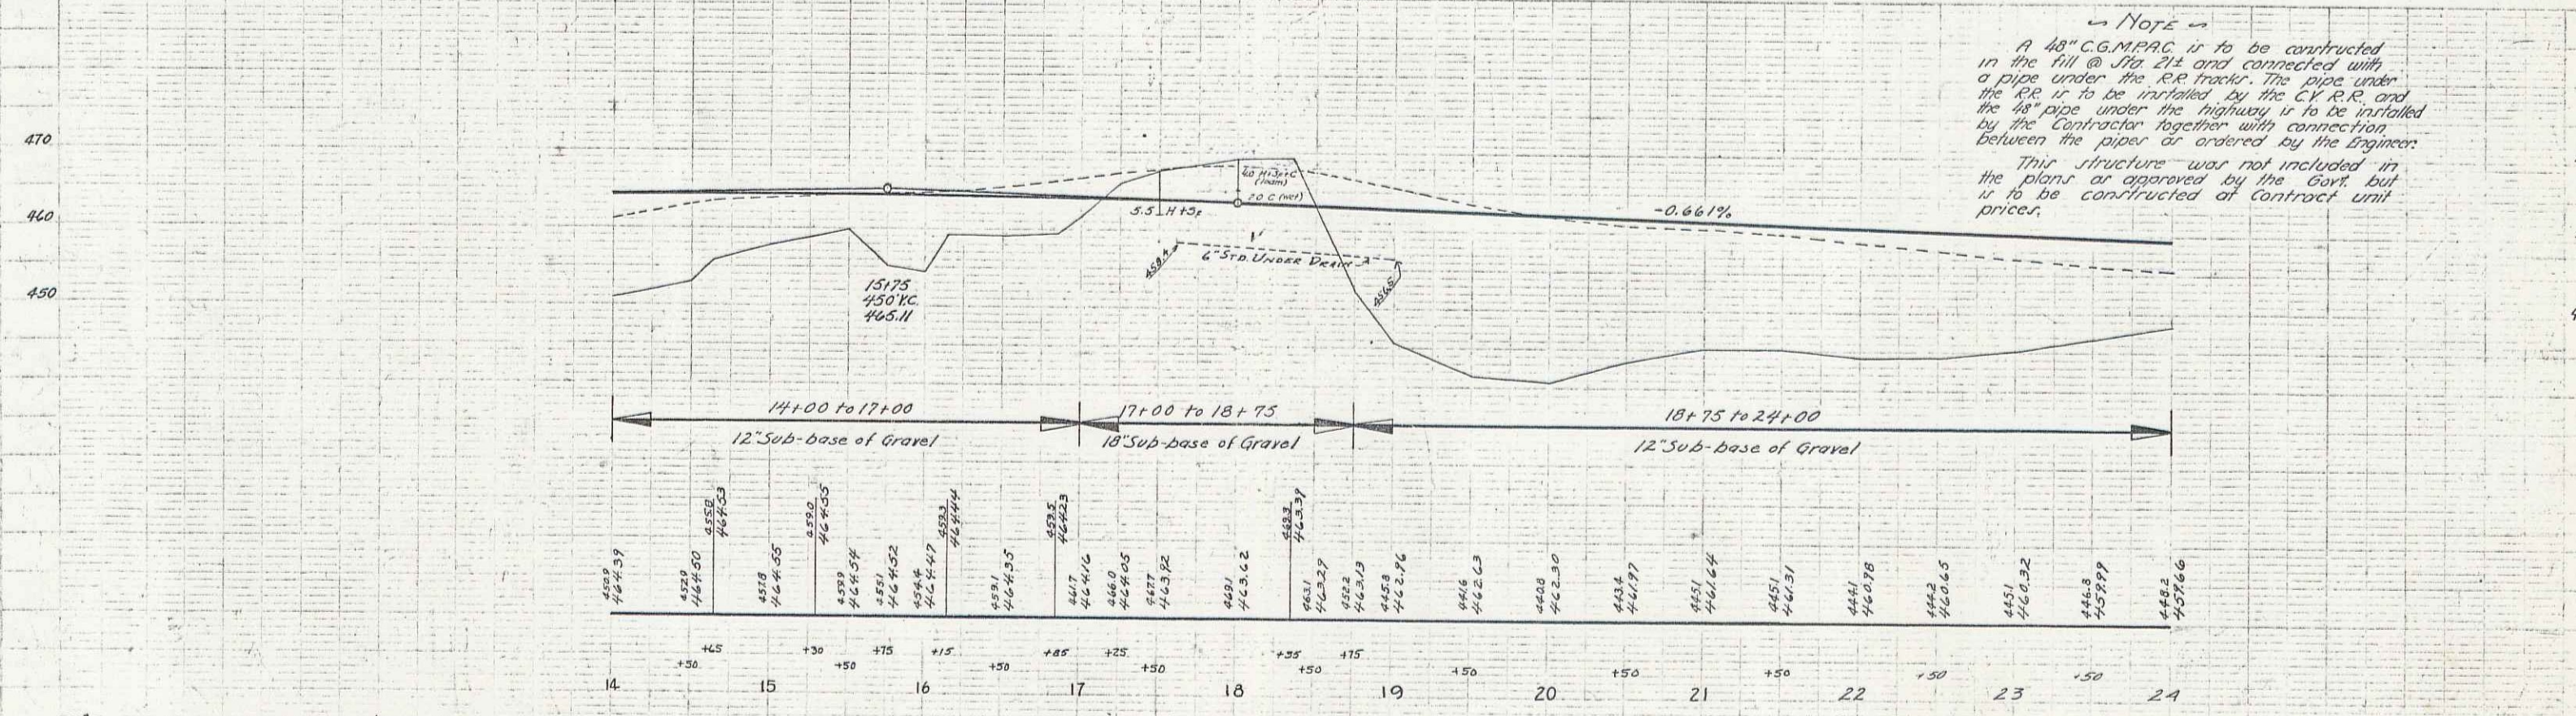

**NOTE**  
A 48" CGMPAC is to be constructed in the fill @ Sta 21+ and connected with a pipe under the RR tracks. The pipe under the RR is to be installed by the C.V. R.R. and the 48" pipe under the highway is to be installed by the Contractor together with connection between the pipes as ordered by the Engineer.  
This structure was not included in the plans as approved by the Govt. but is to be constructed at Contract unit prices.

B.M. #3 SPOT ON CULVERT HEADWALL 73' R.F. STA 15+30 ELEV. 463.47  
B.M. #4 SPIKE IN ROOT 10' WHITE BIRCH 130' R.F. STA 19+00 ELEV. 464.90