


Rev. Curve
 Δ 8° 07' 41"
 D 1"
 T 372.87
 L 406.3
 E 144

Δ 11° 01' 11"
 D 3"
 R 1910.1
 L 1842
 T 342.2
 E 8.9

SURF.
 PI 80+05.4
 Δ 8° 07' 41"
 D 2"

PARCEL	INSTRUMENT	DATE	GRANTOR	GRANTEE	RECORDED	REMARKS
A-B-C	O.C.D.	10-25-37	R.H. FULLER	ST. OF VT.	35	579-301 10-30-37
A'-B'-C'	O.C.D.	10-25-37	FRANK MARCHA	"	35	574-579 10-25-37

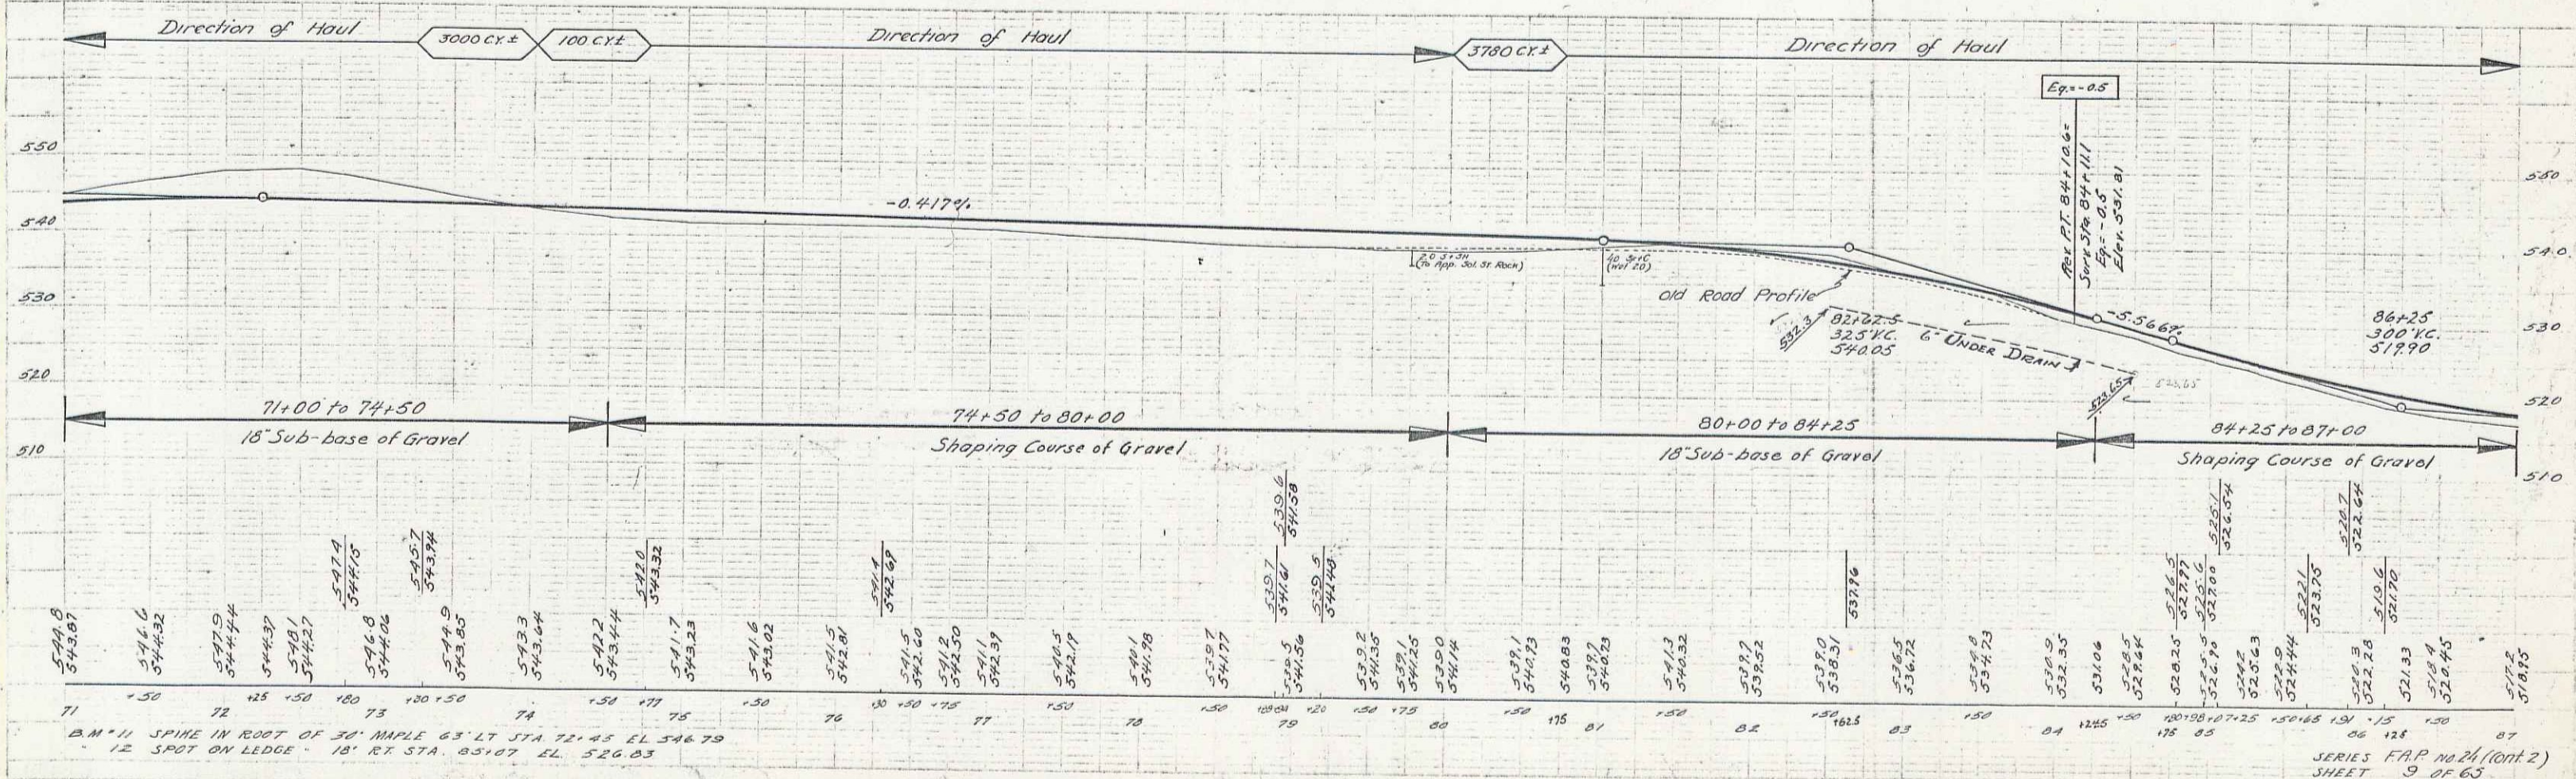

B.M. 11 SPIRE IN ROOT OF 34' MAPLE 63' LT STA 72+45 EL 546.79
 12 SPOT ON LEDGE - 18' RT STA 85+07 EL 526.03

SERIES F.A.P. No. 24 (Part 2)
 SHEET 9 OF 63