



24 1938 11 65  
 CAP 2

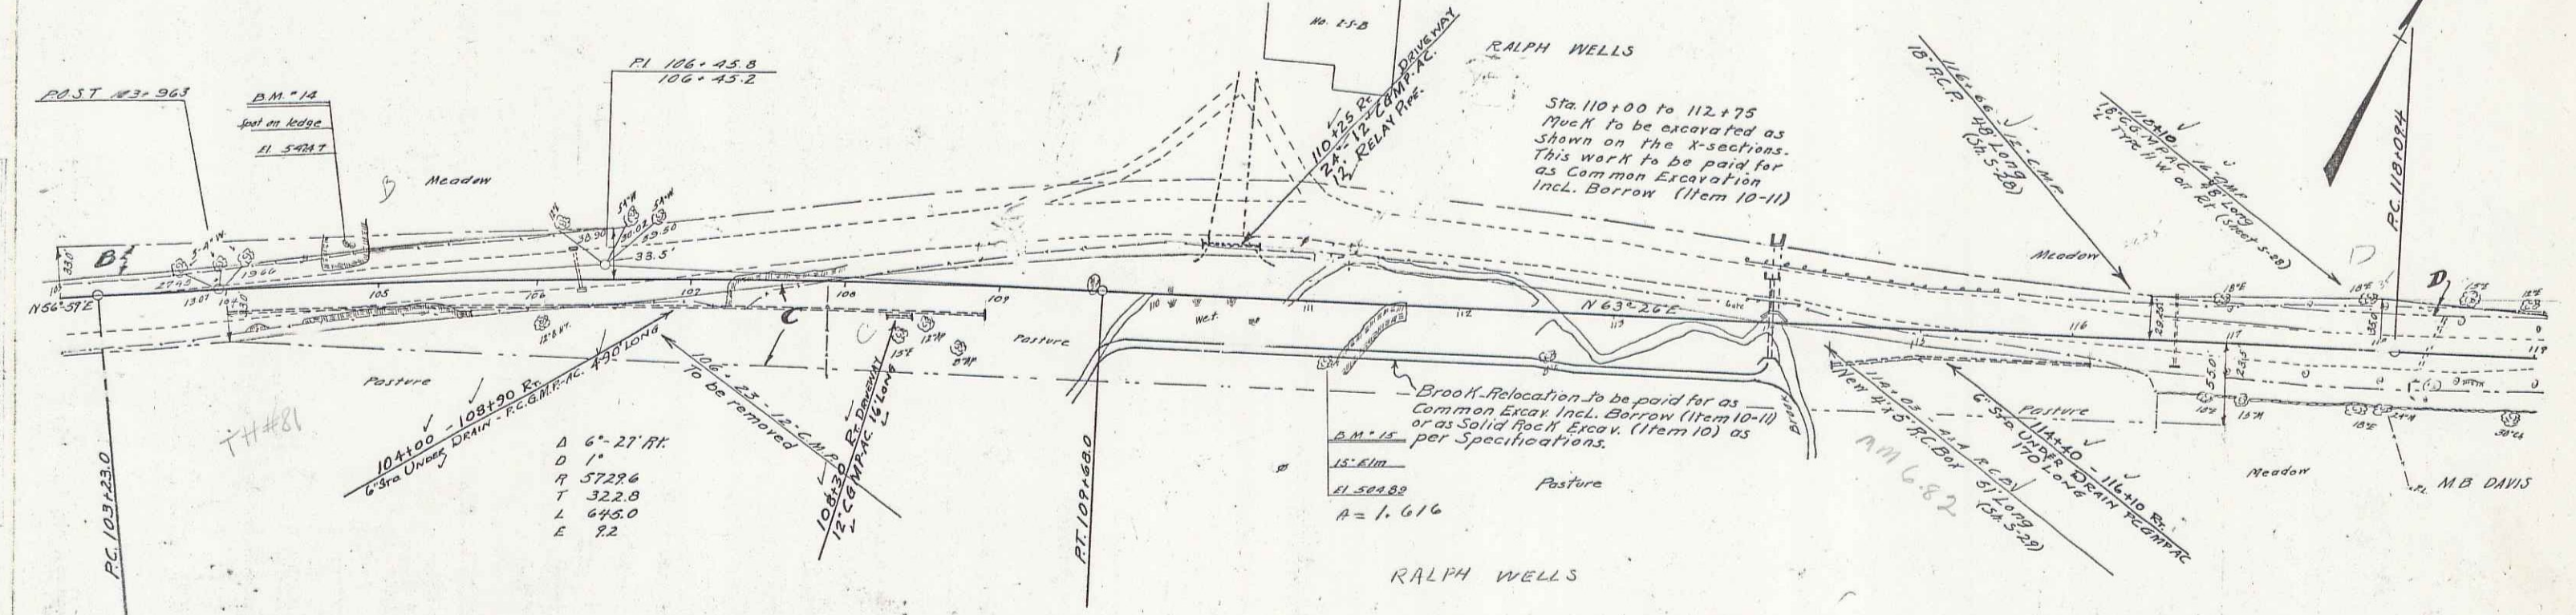

104+100 - 108+90 P.C.  
 6" STA UNDER DRAIN P.C. 104+100  
 A 6'-27" RT.  
 D 1'  
 P 5722.6  
 T 322.8  
 L 645.0  
 E 22

Brook Relocation to be paid for as  
 Common Excav. Incl. Borrow (Item 10-11)  
 or as Solid Rock Excav. (Item 10) as  
 per Specifications.  
 15' RIM  
 EL 502.80  
 R = 1.616

PARCEL	INSTRUMENT	DATE	GRANTOR	GRANTEE	RECORDED	REMARKS
A-B-C-D	G.C.O.	11-9-37	RALPH E. WELLS	STOF. VT.	BOOK PAGE DATE 35 548-549 11/2/37	CH. STA 89100

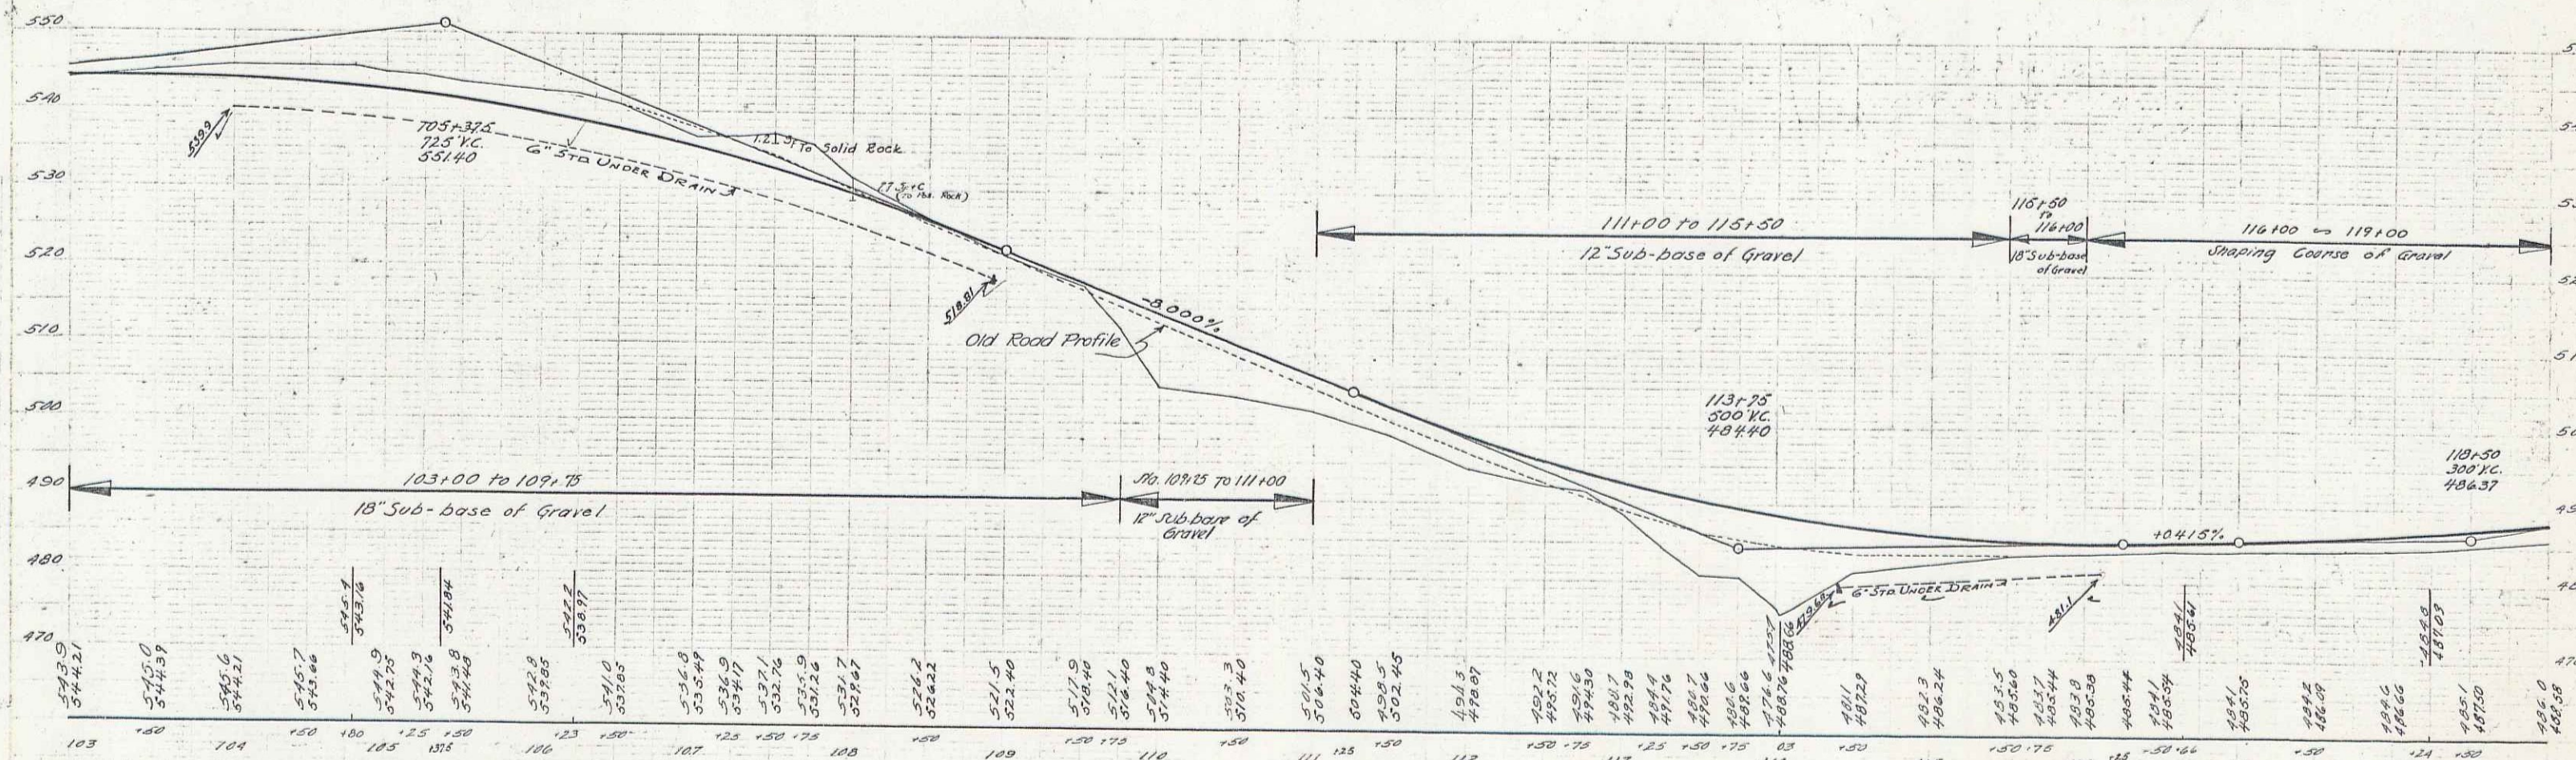

STATION	ELEVATION	STATION	ELEVATION	STATION	ELEVATION	STATION	ELEVATION
103	543.9	107	521.5	111	504.4	115	487.3
104	544.21	108	522.40	112	504.40	116	486.24
105	545.0	109	521.9	113	502.85	117	485.75
106	545.6	110	517.9	114	502.66	118	485.0
107	546.2	111	516.40	115	481.6	119	484.58
108	546.7	112	514.40	116	480.6		
109	547.4	113	512.3	117	479.6		
110	548.1	114	510.40	118	478.6		
111	548.8	115	508.3	119	477.6		
112	549.5	116	506.40				
113	550.2	117	504.40				
114	550.9	118	502.40				
115	551.6	119	500.40				
116	552.3						
117	553.0						
118	553.7						
200	611.1						

SERIES F.A.P. No 24 (cont 2)  
 SHEET 11 OF 65