
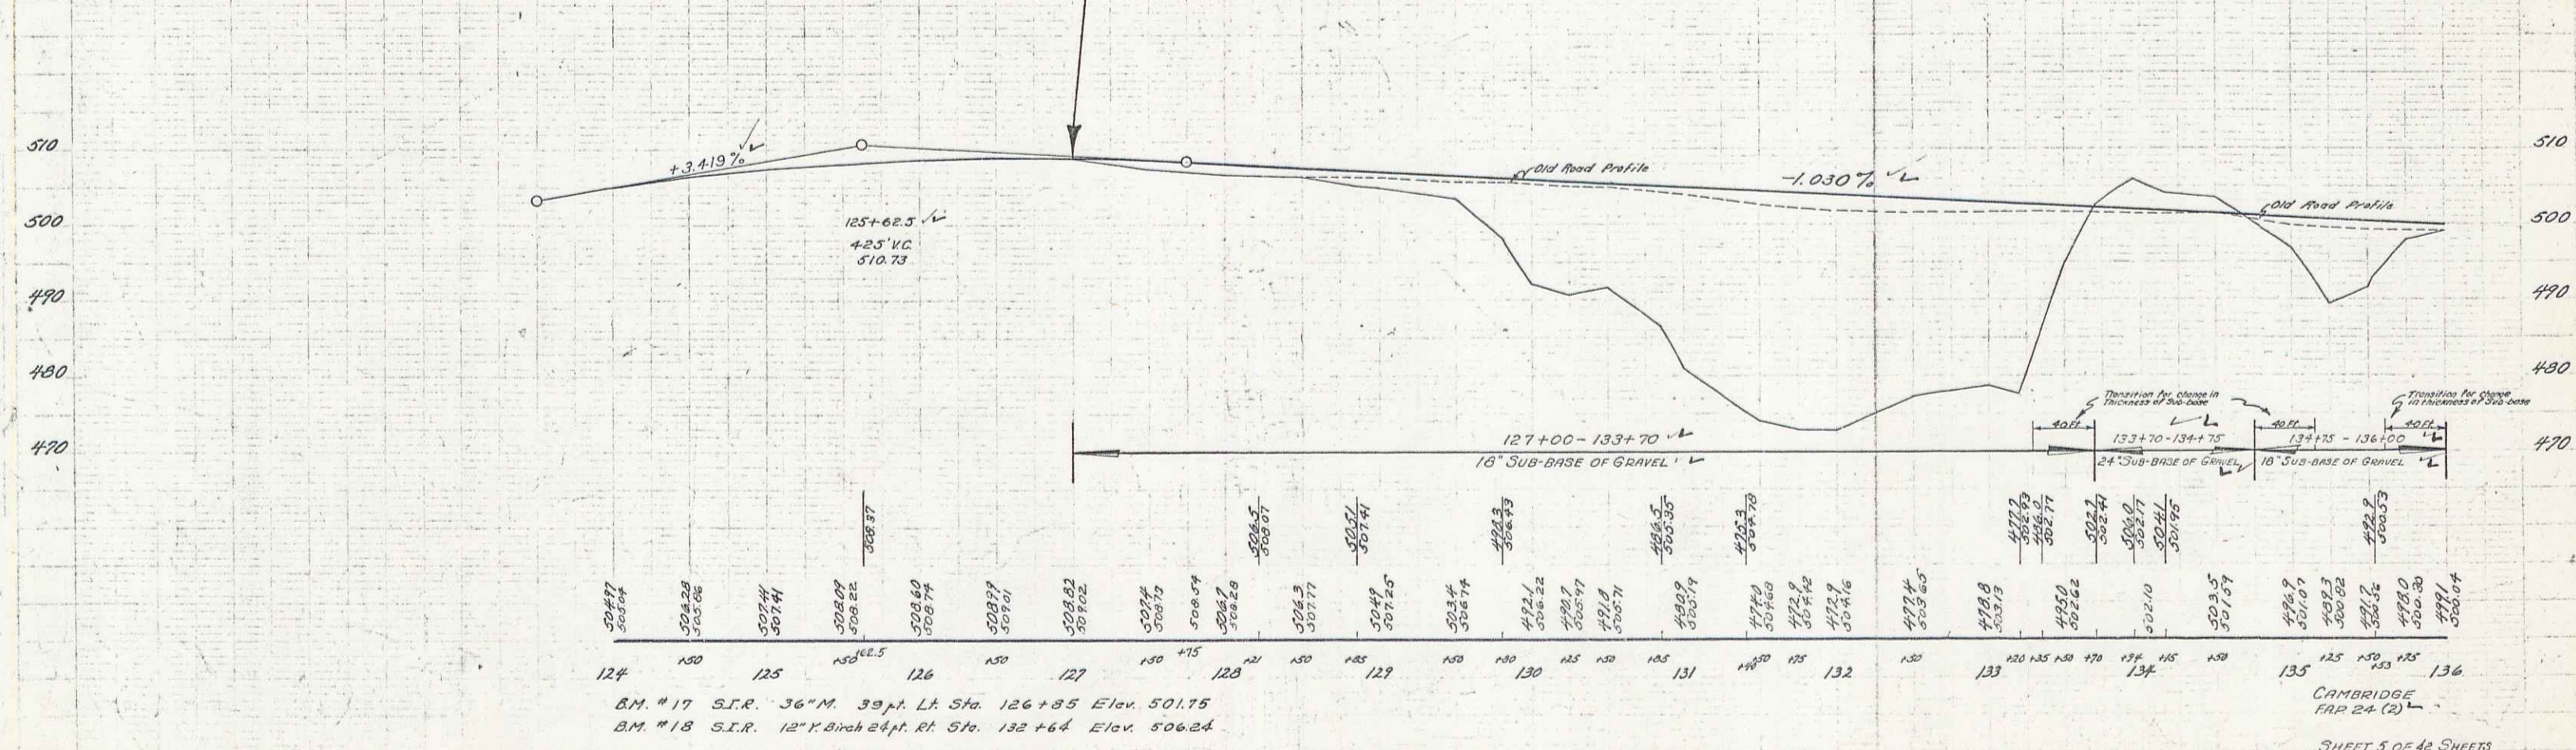


PARCEL	INSTRUMENT	DATE	GRANTOR	GRANTEE	RECORDED	REMARKS
A-B-C-D	Q.C.D.	11-9-37	RALPH E. WELLS	ST of VT	Book Page Date	594-595 11-12-37 CUL. STA. 99+00
A-B-C	Q.C.D.	5-18-38	MORTON & EMILY DAVIS	ST of VT	36 70-71 5-24-38	
A-B-C-D	Part Rel.	2-4-38	FED. FARM MORT. CORP.	M.B. & E. DAVIS	36 14-15-16 5-24-38	MORTGAGE
A-B-C-D	Part Rel.	2-4-38	FEDERAL LAND BANK	M.B. & E. DAVIS	36 12-13 5-24-38	MORTGAGE

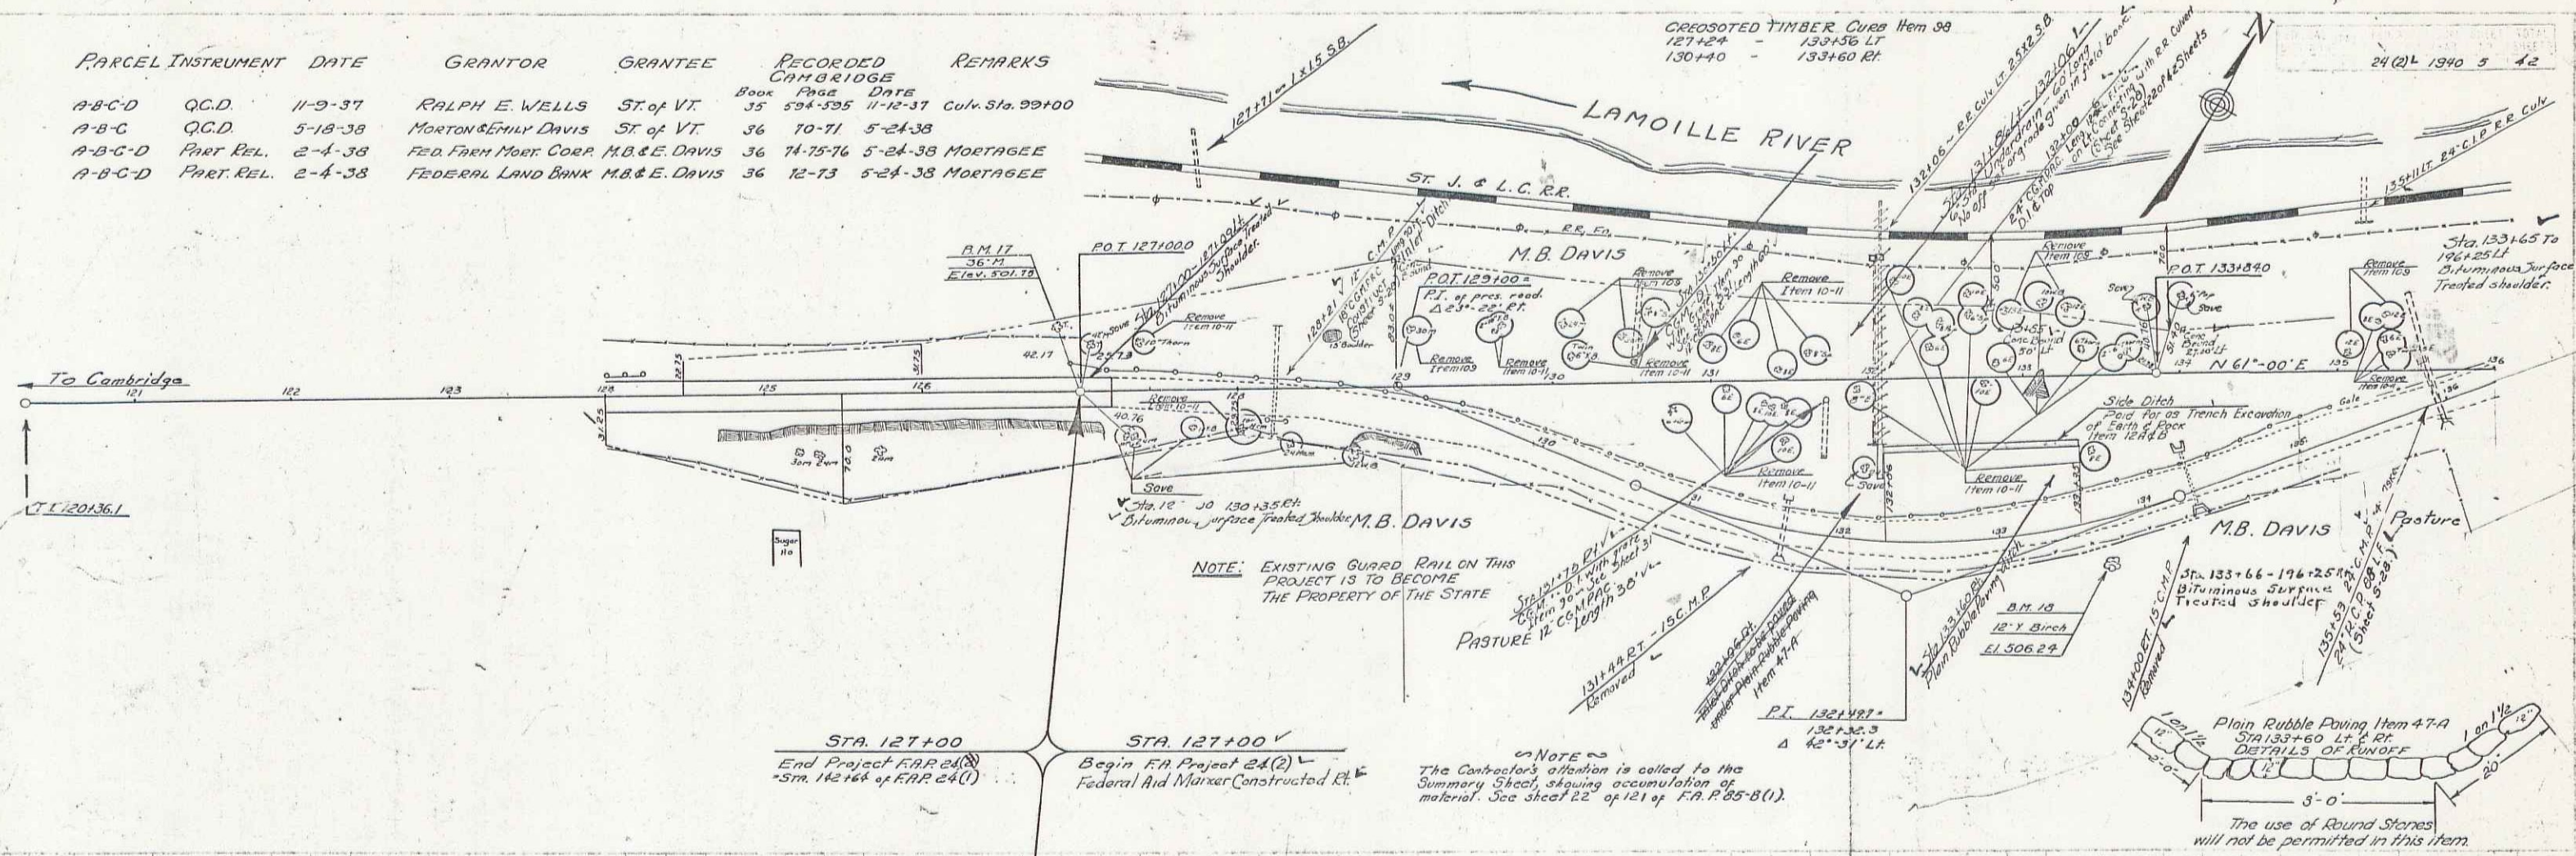

B.M. #17 S.I.R. 36" M. 39 ft. Lt. Sta. 126+85 Elev. 501.75  
 B.M. #18 S.I.R. 12" X Birch 24 ft. Rt. Sta. 132+64 Elev. 506.24