


PARCEL INSTRUMENT	DATE	GRANTOR	GRANTEE	RECORDED BOOK	RECORDED PAGE	RECORDED DATE	REMARKS
B	W.D.	9-28-39	EDWARD J. HANLEY & KATHERINE HANLEY	ST OF VT	31	577-578	10-6-39

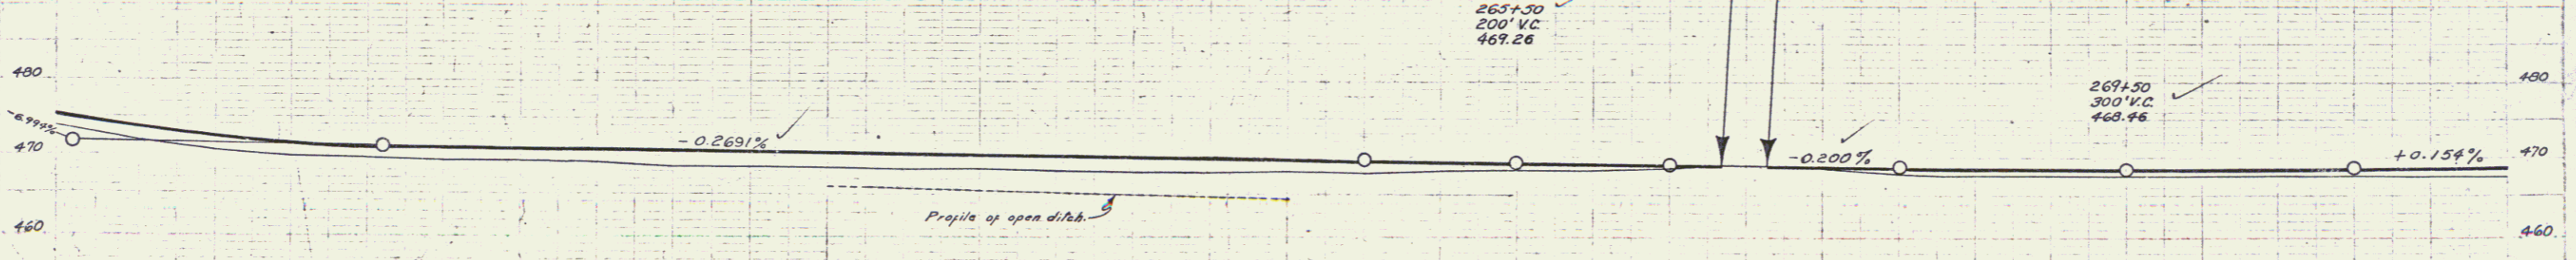

Station	Elevation	Station	Elevation	Station	Elevation	Station	Elevation	Station	Elevation
256+00	471.79	256+10	470.00	256+20	469.50	256+30	469.26	256+40	469.00
256+50	468.50	256+60	468.00	256+70	467.50	256+80	467.00	256+90	466.50
256+100	466.00	256+110	465.50	256+120	465.00	256+130	464.50	256+140	464.00
256+150	463.50	256+160	463.00	256+170	462.50	256+180	462.00	256+190	461.50
256+200	461.00	256+210	460.50	256+220	460.00	256+230	459.50	256+240	459.00
256+250	458.50	256+260	458.00	256+270	457.50	256+280	457.00	256+290	456.50
256+300	456.00	256+310	455.50	256+320	455.00	256+330	454.50	256+340	454.00
256+350	453.50	256+360	453.00	256+370	452.50	256+380	452.00	256+390	451.50
256+400	451.00	256+410	450.50	256+420	450.00	256+430	449.50	256+440	449.00
256+450	447.50	256+460	447.00	256+470	446.50	256+480	446.00	256+490	445.50
256+500	443.00	256+510	442.50	256+520	442.00	256+530	441.50	256+540	441.00
256+550	438.50	256+560	438.00	256+570	437.50	256+580	437.00	256+590	436.50
256+600	434.00	256+610	433.50	256+620	433.00	256+630	432.50	256+640	432.00
256+650	428.50	256+660	428.00	256+670	427.50	256+680	427.00	256+690	426.50
256+700	424.00	256+710	423.50	256+720	423.00	256+730	422.50	256+740	422.00
256+750	418.50	256+760	418.00	256+770	417.50	256+780	417.00	256+790	416.50
256+800	412.00	256+810	411.50	256+820	411.00	256+830	410.50	256+840	410.00
256+850	407.50	256+860	407.00	256+870	406.50	256+880	406.00	256+890	405.50
256+900	403.00	256+910	402.50	256+920	402.00	256+930	401.50	256+940	401.00
256+950	397.50	256+960	397.00	256+970	396.50	256+980	396.00	256+990	395.50
257+000	391.00	257+010	390.50	257+020	390.00	257+030	389.50	257+040	389.00
257+050	384.50	257+060	384.00	257+070	383.50	257+080	383.00	257+090	382.50
257+100	378.00	257+110	377.50	257+120	377.00	257+130	376.50	257+140	376.00
257+150	371.50	257+160	371.00	257+170	370.50	257+180	370.00	257+190	369.50
257+200	365.00	257+210	364.50	257+220	364.00	257+230	363.50	257+240	363.00
257+250	358.50	257+260	358.00	257+270	357.50	257+280	357.00	257+290	356.50
257+300	352.00	257+310	351.50	257+320	351.00	257+330	350.50	257+340	350.00
257+350	345.50	257+360	345.00	257+370	344.50	257+380	344.00	257+390	343.50
257+400	339.00	257+410	338.50	257+420	338.00	257+430	337.50	257+440	337.00
257+450	332.50	257+460	332.00	257+470	331.50	257+480	331.00	257+490	330.50
257+500	326.00	257+510	325.50	257+520	325.00	257+530	324.50	257+540	324.00
257+550	319.50	257+560	319.00	257+570	318.50	257+580	318.00	257+590	317.50
257+600	313.00	257+610	312.50	257+620	312.00	257+630	311.50	257+640	311.00
257+650	306.50	257+660	306.00	257+670	305.50	257+680	305.00	257+690	304.50
257+700	300.00	257+710	299.50	257+720	299.00	257+730	298.50	257+740	298.00
257+750	293.50	257+760	293.00	257+770	292.50	257+780	292.00	257+790	291.50
257+800	287.00	257+810	286.50	257+820	286.00	257+830	285.50	257+840	285.00
257+850	280.50	257+860	280.00	257+870	279.50	257+880	279.00	257+890	278.50
257+900	274.00	257+910	273.50	257+920	273.00	257+930	272.50	257+940	272.00
257+950	267.50	257+960	267.00	257+970	266.50	257+980	266.00	257+990	265.50
258+000	261.00	258+010	260.50	258+020	260.00	258+030	259.50	258+040	259.00
258+050	254.50	258+060	254.00	258+070	253.50	258+080	253.00	258+090	252.50
258+100	248.00	258+110	247.50	258+120	247.00	258+130	246.50	258+140	246.00
258+150	241.50	258+160	241.00	258+170	240.50	258+180	240.00	258+190	239.50
258+200	235.00	258+210	234.50	258+220	234.00	258+230	233.50	258+240	233.00
258+250	228.50	258+260	228.00	258+270	227.50	258+280	227.00	258+290	226.50
258+300	222.00	258+310	221.50	258+320	221.00	258+330	220.50	258+340	220.00
258+350	215.50	258+360	215.00	258+370	214.50	258+380	214.00	258+390	213.50
258+400	209.00	258+410	208.50	258+420	208.00	258+430	207.50	258+440	207.00
258+450	202.50	258+460	202.00	258+470	201.50	258+480	201.00	258+490	200.50
258+500	196.00	258+510	195.50	258+520	195.00	258+530	194.50	258+540	194.00
258+550	189.50	258+560	189.00	258+570	188.50	258+580	188.00	258+590	187.50
258+600	183.00	258+610	182.50	258+620	182.00	258+630	181.50	258+640	181.00
258+650	176.50	258+660	176.00	258+670	175.50	258+680	175.00	258+690	174.50
258+700	170.00	258+710	169.50	258+720	169.00	258+730	168.50	258+740	168.00
258+750	163.50	258+760	163.00	258+770	162.50	258+780	162.00	258+790	161.50
258+800	157.00	258+810	156.50	258+820	156.00	258+830	155.50	258+840	155.00
258+850	150.50	258+860	150.00	258+870	149.50	258+880	149.00	258+890	148.50
258+900	144.00	258+910	143.50	258+920	143.00	258+930	142.50	258+940	142.00
258+950	137.50	258+960	137.00	258+970	136.50	258+980	136.00	258+990	135.50
259+000	131.00	259+010	130.50	259+020	130.00	259+030	129.50	259+040	129.00
259+050	124.50	259+060	124.00	259+070	123.50	259+080	123.00	259+090	122.50
259+100	118.00	259+110	117.50	259+120	117.00	259+130	116.50	259+140	116.00
259+150	111.50	259+160	111.00	259+170	110.50	259+180	110.00	259+190	109.50
259+200	105.00	259+210	104.50	259+220	104.00	259+230	103.50	259+240	103.00
259+250	98.50	259+260	98.00	259+270	97.50	259+280	97.00	259+290	96.50
259+300	92.00	259+310	91.50	259+320	91.00	259+330	90.50	259+340	90.00
259+350	85.50	259+360	85.00	259+370	84.50	259+380	84.00	259+390	83.50
259+400	79.00	259+410	78.50	259+420	78.00	259+430	77.50	259+440	77.00
259+450	72.50	259+460	72.00	259+470	71.50	259+480	71.00	259+490	70.50
259+500	66.00	259+510	65.50	259+520	65.00	259+530	64.50	259+540	64.00
259+550	59.50	259+560	59.00	259+570	58.50	259+580	58.00	259+590	57.50
259+600	53.00	259+610	52.50	259+620	52.00	259+630	51.50	259+640	51.00
259+650	46.50	259+660	46.00	259+670	45.50	259+680	45.00	259+690	44.50
259+700	40.00	259+710	39.50	259+720	39.00	259+730	38.50	259+740	38.00
259+750	33.50	259+760	33.00	259+770	32.50	259+780	32.00	259+790	31.50
259+800	27.00	259+810	26.50	259+820	26.00	259+830	25.50	259+840	25.00
259+850	20.50	259+860	20.00	259+870	19.50	259+880	19.00	259+890	18.50
259+900	14.00	259+910	13.50	259+920	13.00	259+930	12.50	259+940	12.00
259+950	7.50	259+960	7.00	259+970	6.50	259+980	6.00	259+990	5.50
260+000	1.00	260+010	0.50	260+020	0.00	260+030	-0.50	260+040	-1.00

6