


**MODIFICATION OF DESIGN FOR UNDERDRAIN**  
 The contractor's attention is called to the depth of Underdrain as designed, as in many cases the depth of the trench differs from that shown on the Standard Structure Sheet (SSOP). The Contractor shall be required to dig the trench to the depths as shown on the cross sections and make all necessary backfill of gravel. This excavation shall be paid for as Trench Excavation of Earth or Trench Excavation of Rock as per the Specifications, and all Backfill shall be included in the bid price for Standard Underdrain.

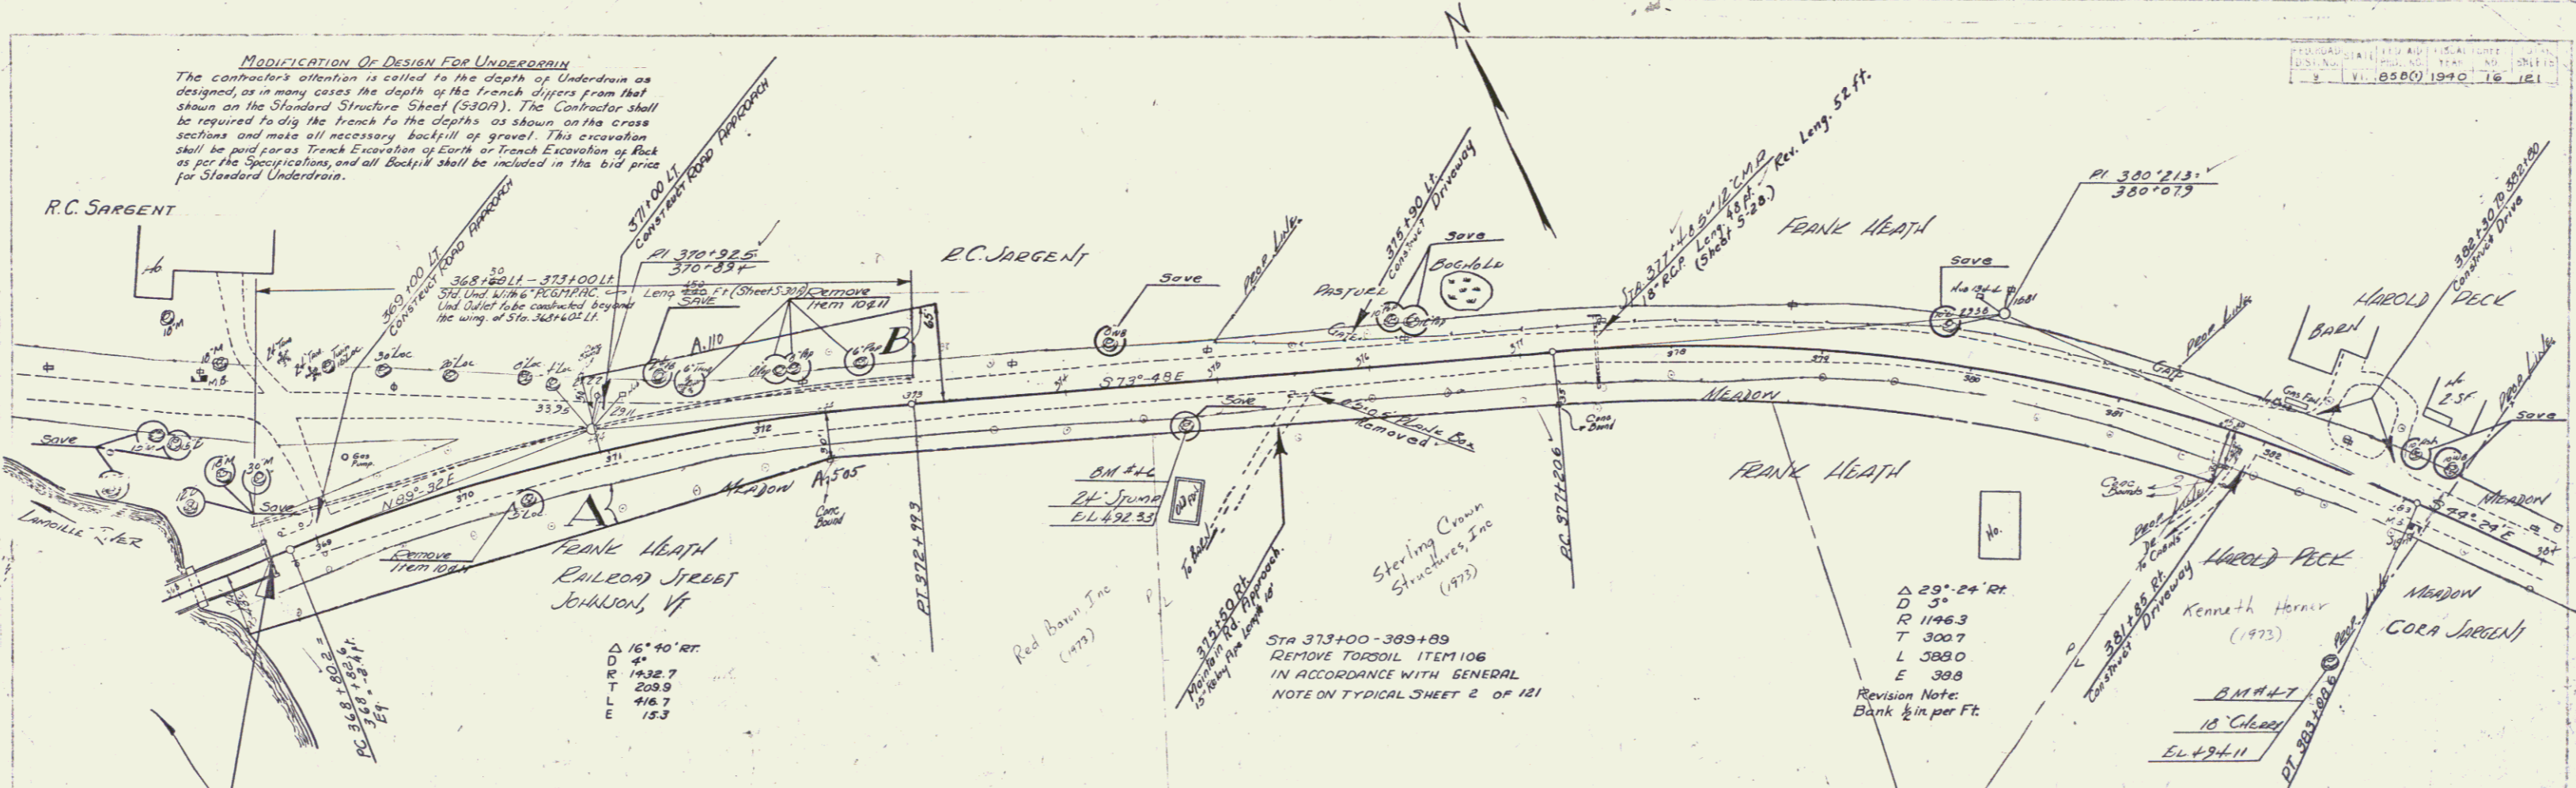

STA 3+13.0 = STA 368+650 FAP 85B(1)  
 OF FR 11F (1928) F.A. FROM 85B(1) RESUMES

PARCEL INSTRUMENT	DATE	GRANTOR	GRANTEE	RECORDED	DATE	STATION	ELEVATION
A	10-3-39	FRANK S. AND MAUD L. HEATH	ST. OF VT.	306	10-4-39	374	498.7
B	10-9-39	ROLLIN AND ESELLE SARGENT	ST. OF VT.	311	11-13-39	375	498.2
						376	497.5
						377	496.8
						378	496.1
						379	495.4
						380	494.7
						381	494.0
						382	493.3
						383	492.6
						384	491.9

368+25 369 370 371 372 373 374 375 376 377 378 379 380 381 382 383 384  
 12' Sub-base of Gravel      Shaping Course of Gravel      18' Sub Base of Gravel

368+25 369 370 371 372 373 374 375 376 377 378 379 380 381 382 383 384  
 498.7 498.2 497.5 496.8 496.1 495.4 494.7 494.0 493.3 492.6 491.9

SERIES F.A.P. NO. 85B(1)  
 SHEET 16 OF 121 SHEETS