


PARCEL	INSTRUMENT	DATE	GRANTOR	GRANTEE	RECORDED	REMARKS
A'	W.D.	10-3-39	BERT C. STEARNS AND STELLA STEARNS	STOF.VL.	BOOK PAGE DATE 31 5911592 10-10-39	

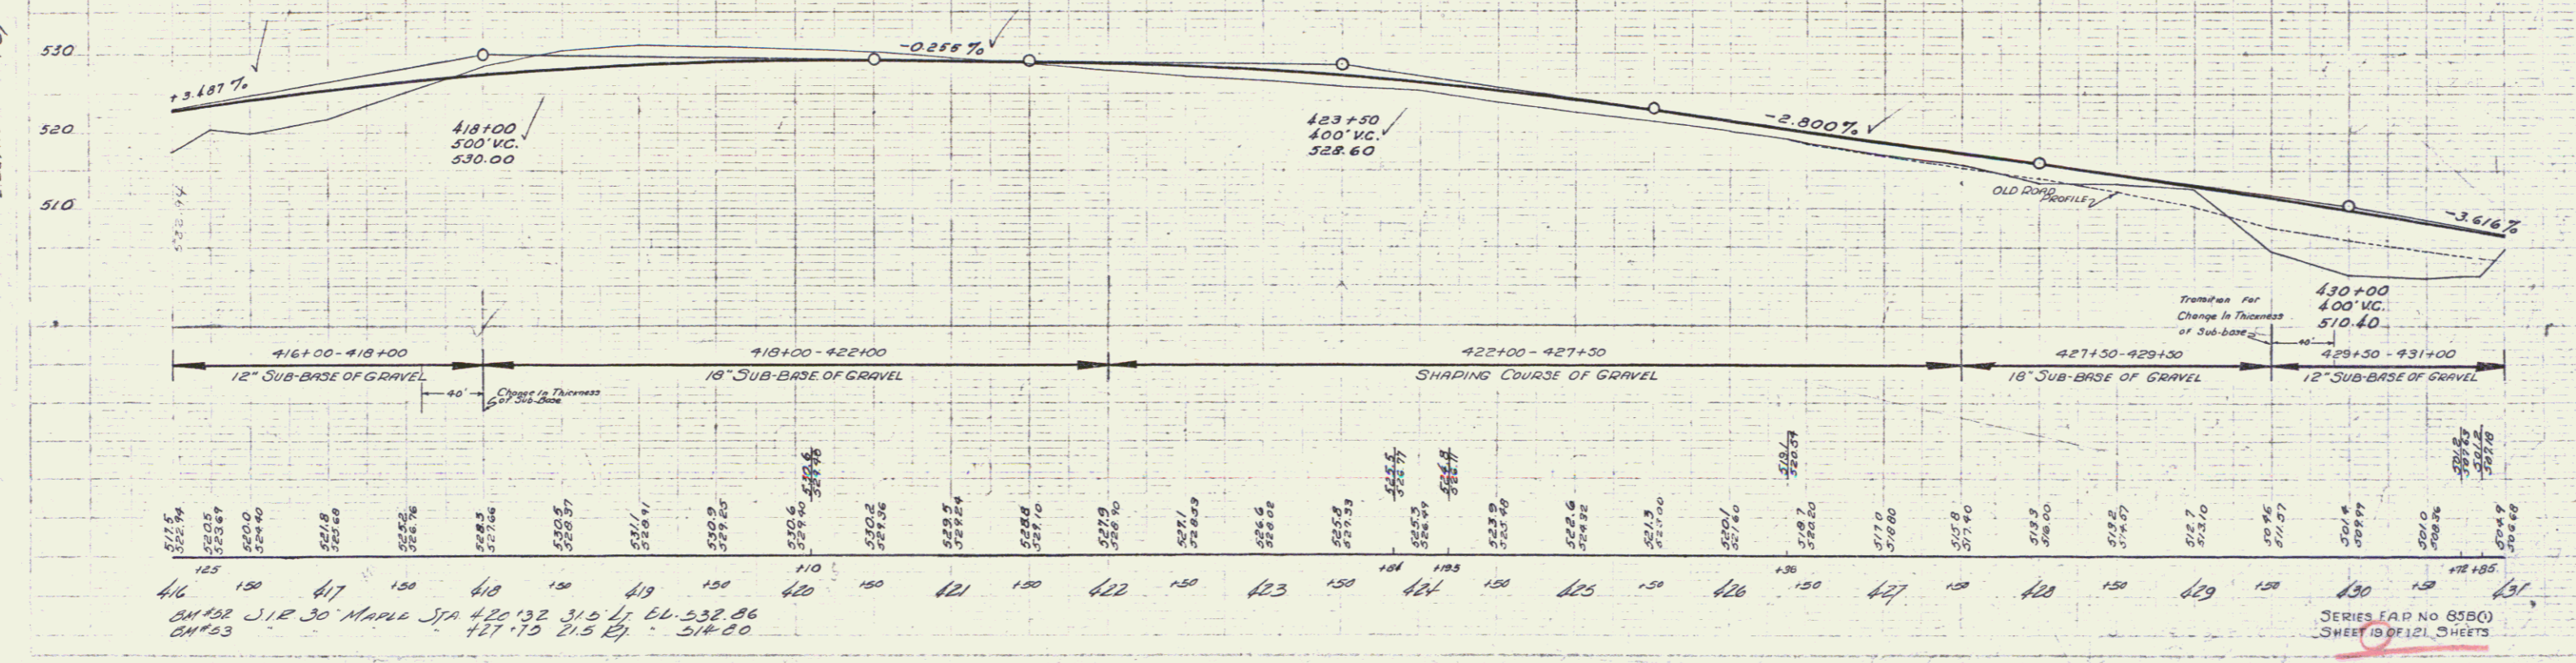

416+00 S.I.R. 30' MARLE STA
 427+50 21.5 R.I. 514.00

SERIES EAP NO 658(C)
 SHEET 10 OF 121 SHEETS

16