
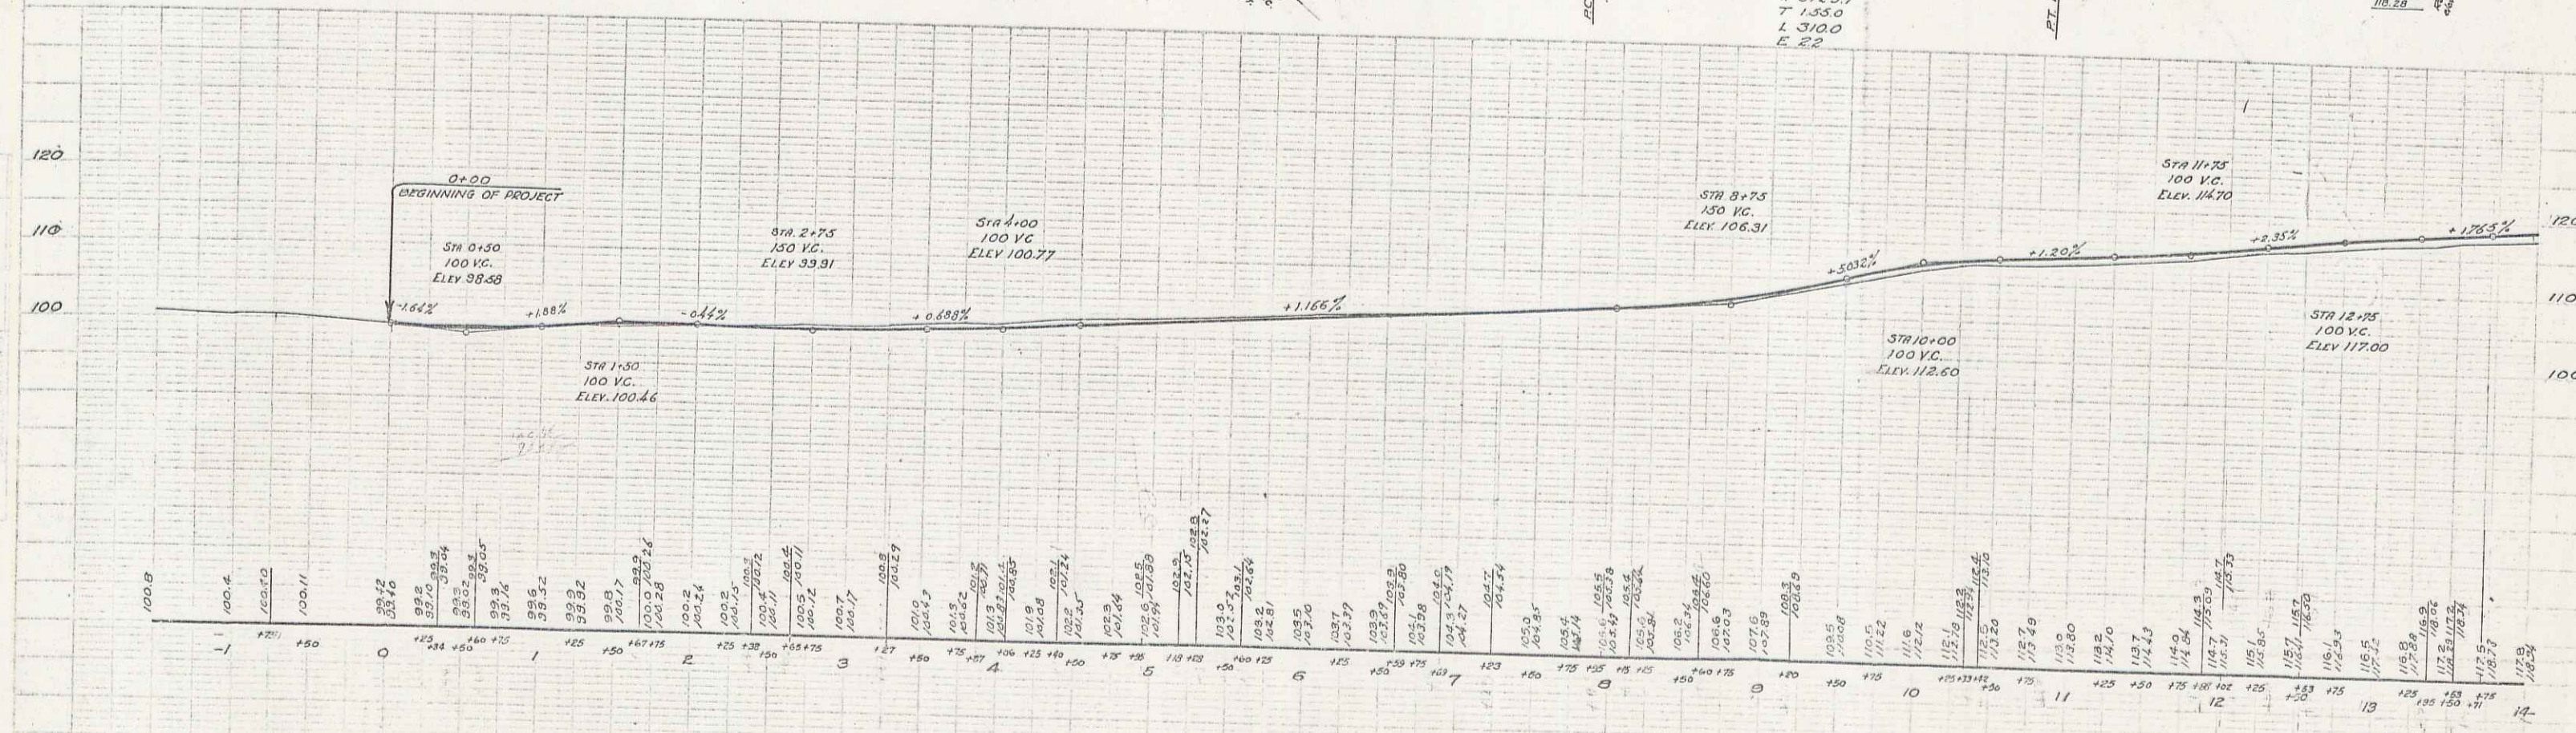


CHANGING ELEVATIONS OF CATCH BASINS

STATION	Gr. or Ex.
8+60	Gr.
8+75	Gr.
10+33	Gr.
10+40	Gr.
11+88	Gr.
12+02	Gr.
12+53	Gr.
13+53	Gr.

THE END OF THE BRIDGE STA 0+00 IS TO BE "JACKED" BY STATE FORCE ACCOUNT AND THE CONCRETE PAVEMENT AS CONSTRUCTED IS TO CONFORM TO THE PROPOSED BRIDGE GRADE.

DRAINAGE SYSTEM BETWEEN BRIDGE & STA 8+00 IS NOT INCLUDED IN THIS CONTRACT OR AS PART OF CONSTRUCTION BY THE STATE.

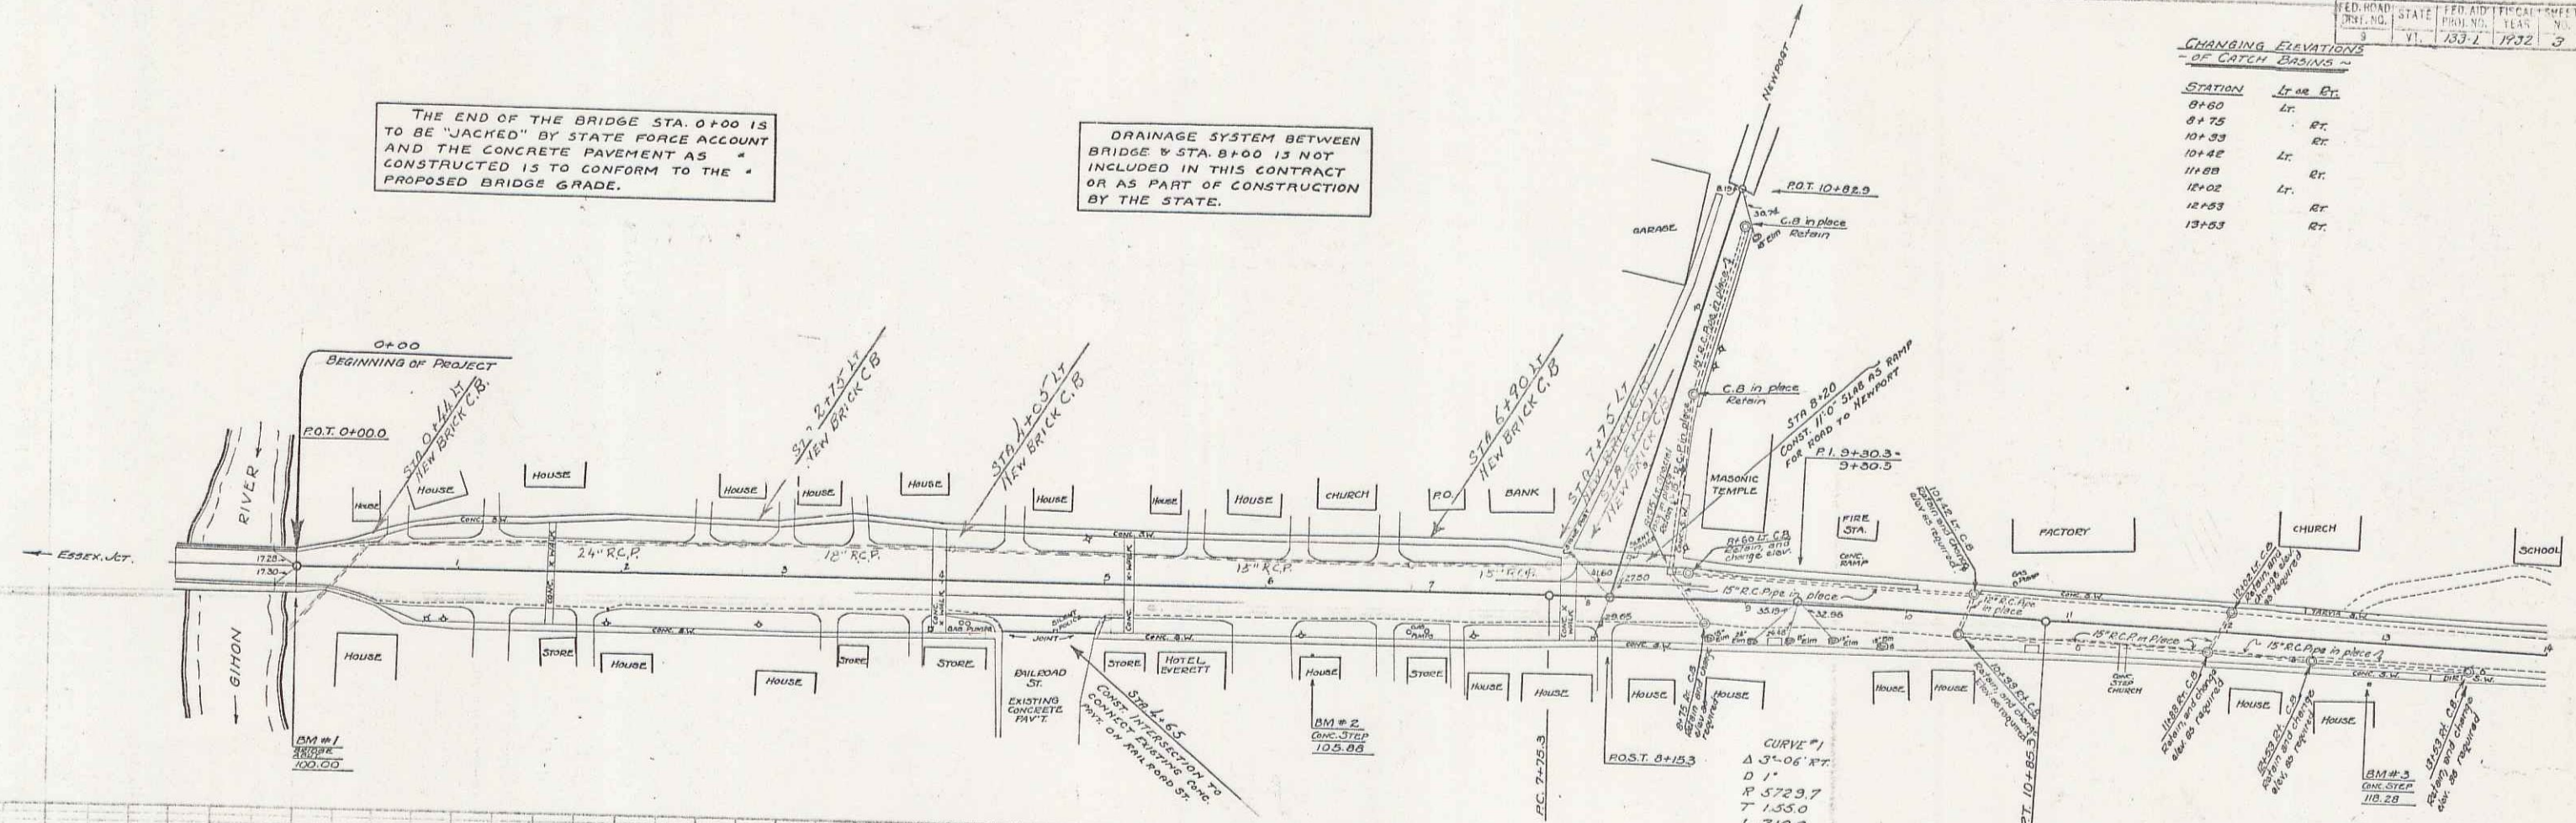

1337

S/12
S/102
S/101

5