
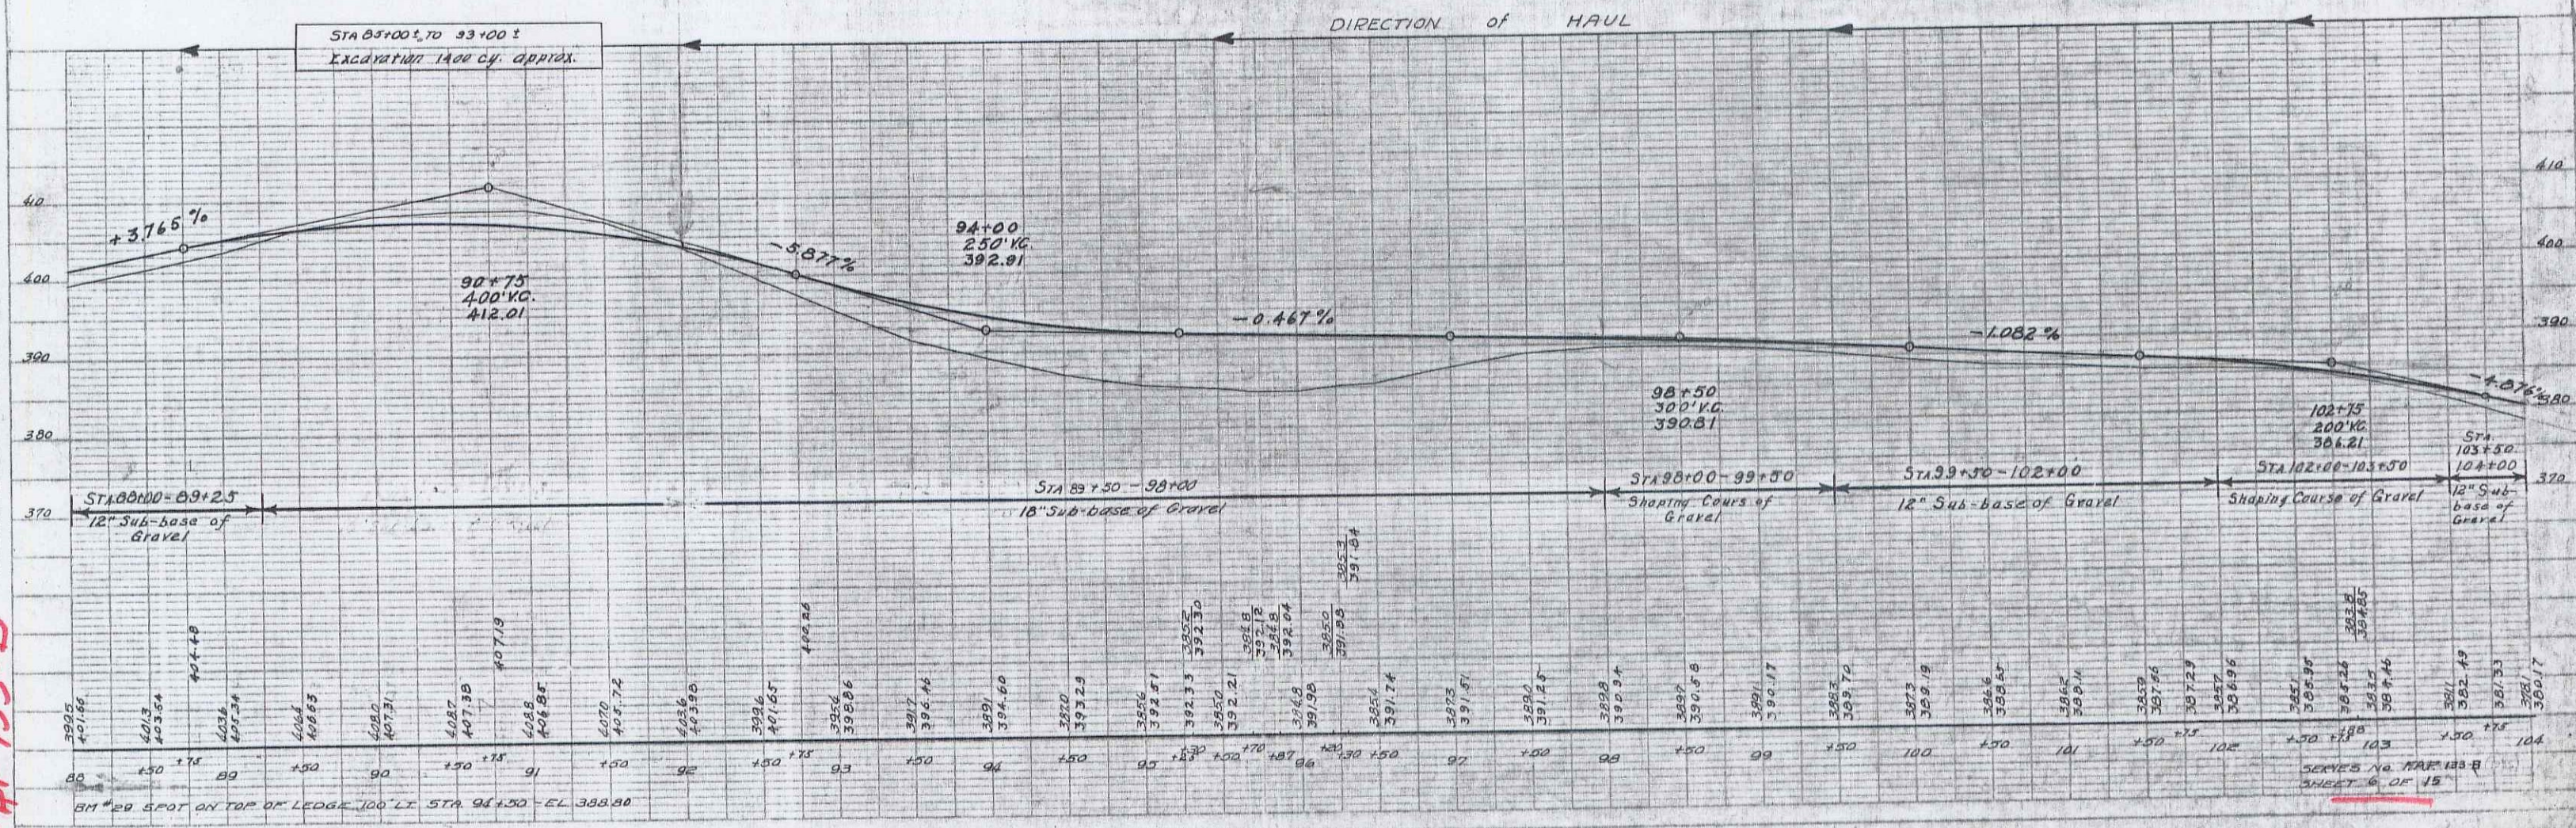


Parcel kind of Date of Grantor Grantee Recorded Remarks  
 Instrument Instrument Johnson  
 A-B-C Q.C.D. R.H. 35 Elbert Emile Best Edge Oak  
 Barvin Sta 30 450 4-6-35

FED. ROAD INST. NO.	STATE	FED. AID FUND NO.	FISCAL YEAR	SHEET NO.	TOTAL SHEETS
9	VT.	133-A	1936	6	15

FAP 133-B  
WOOD GUARD RAIL

STATION TO STATION	LT	RT
93+00	94+00	126
94+00	96+00	200

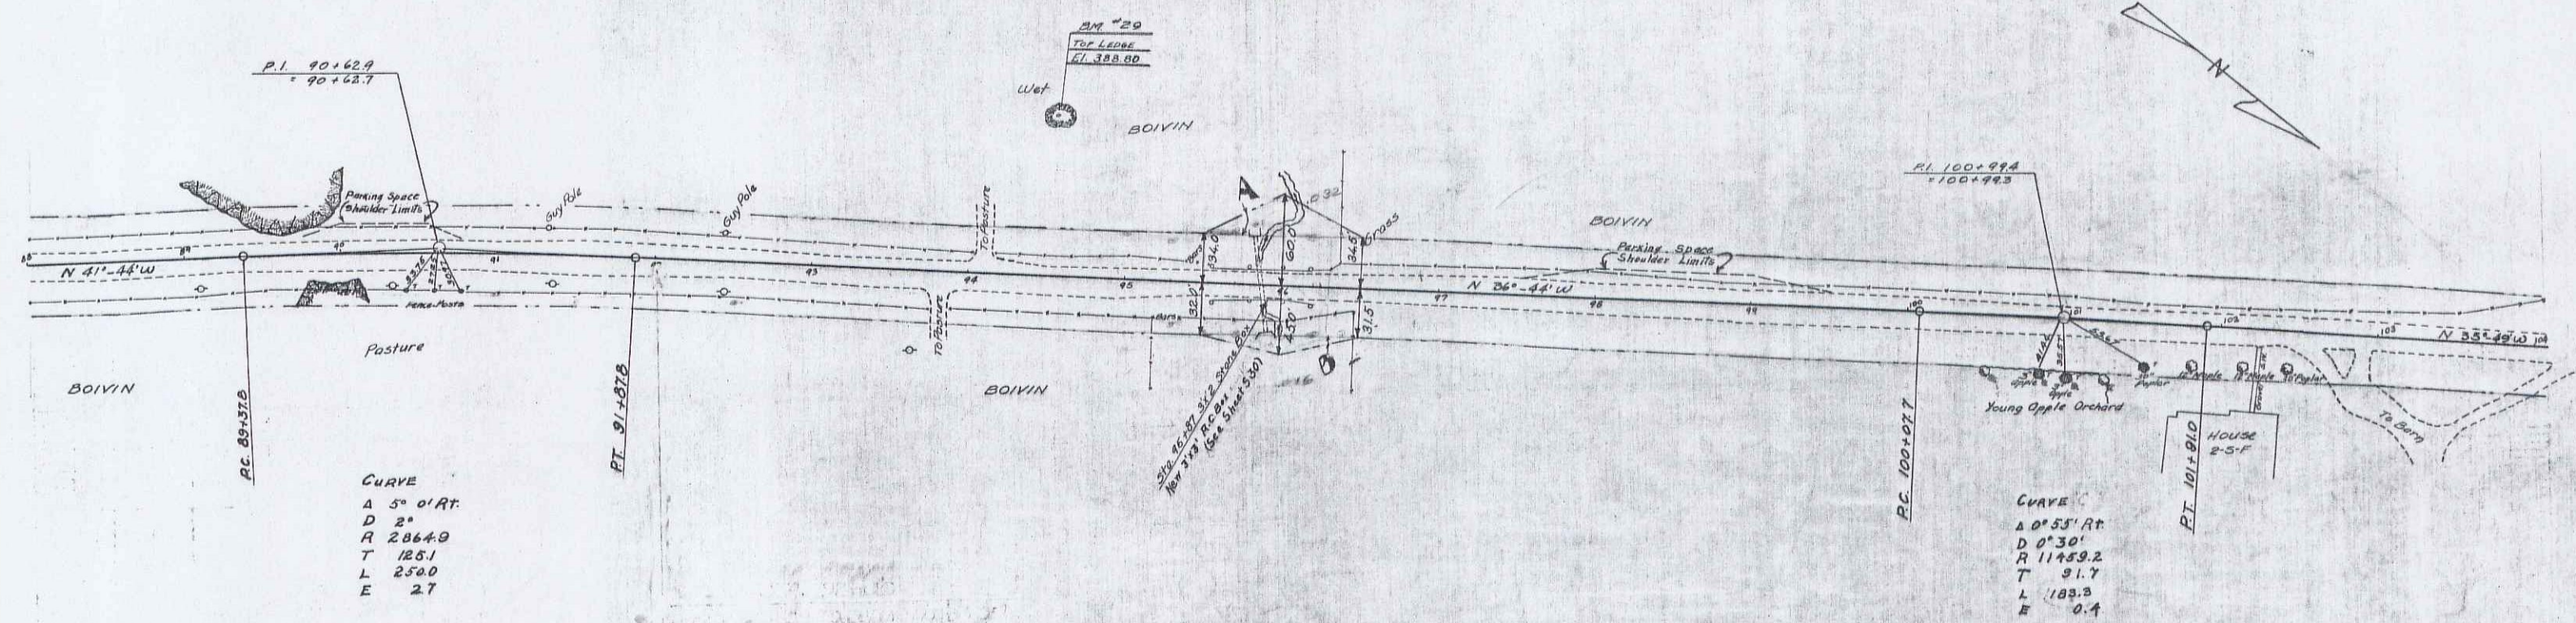

John son  
 FAP 133-B