



F.P. 133-B

Station	17	21
102+00	19	25
113+00	12	24

Fed. Aid  
133-B 1936 7 15

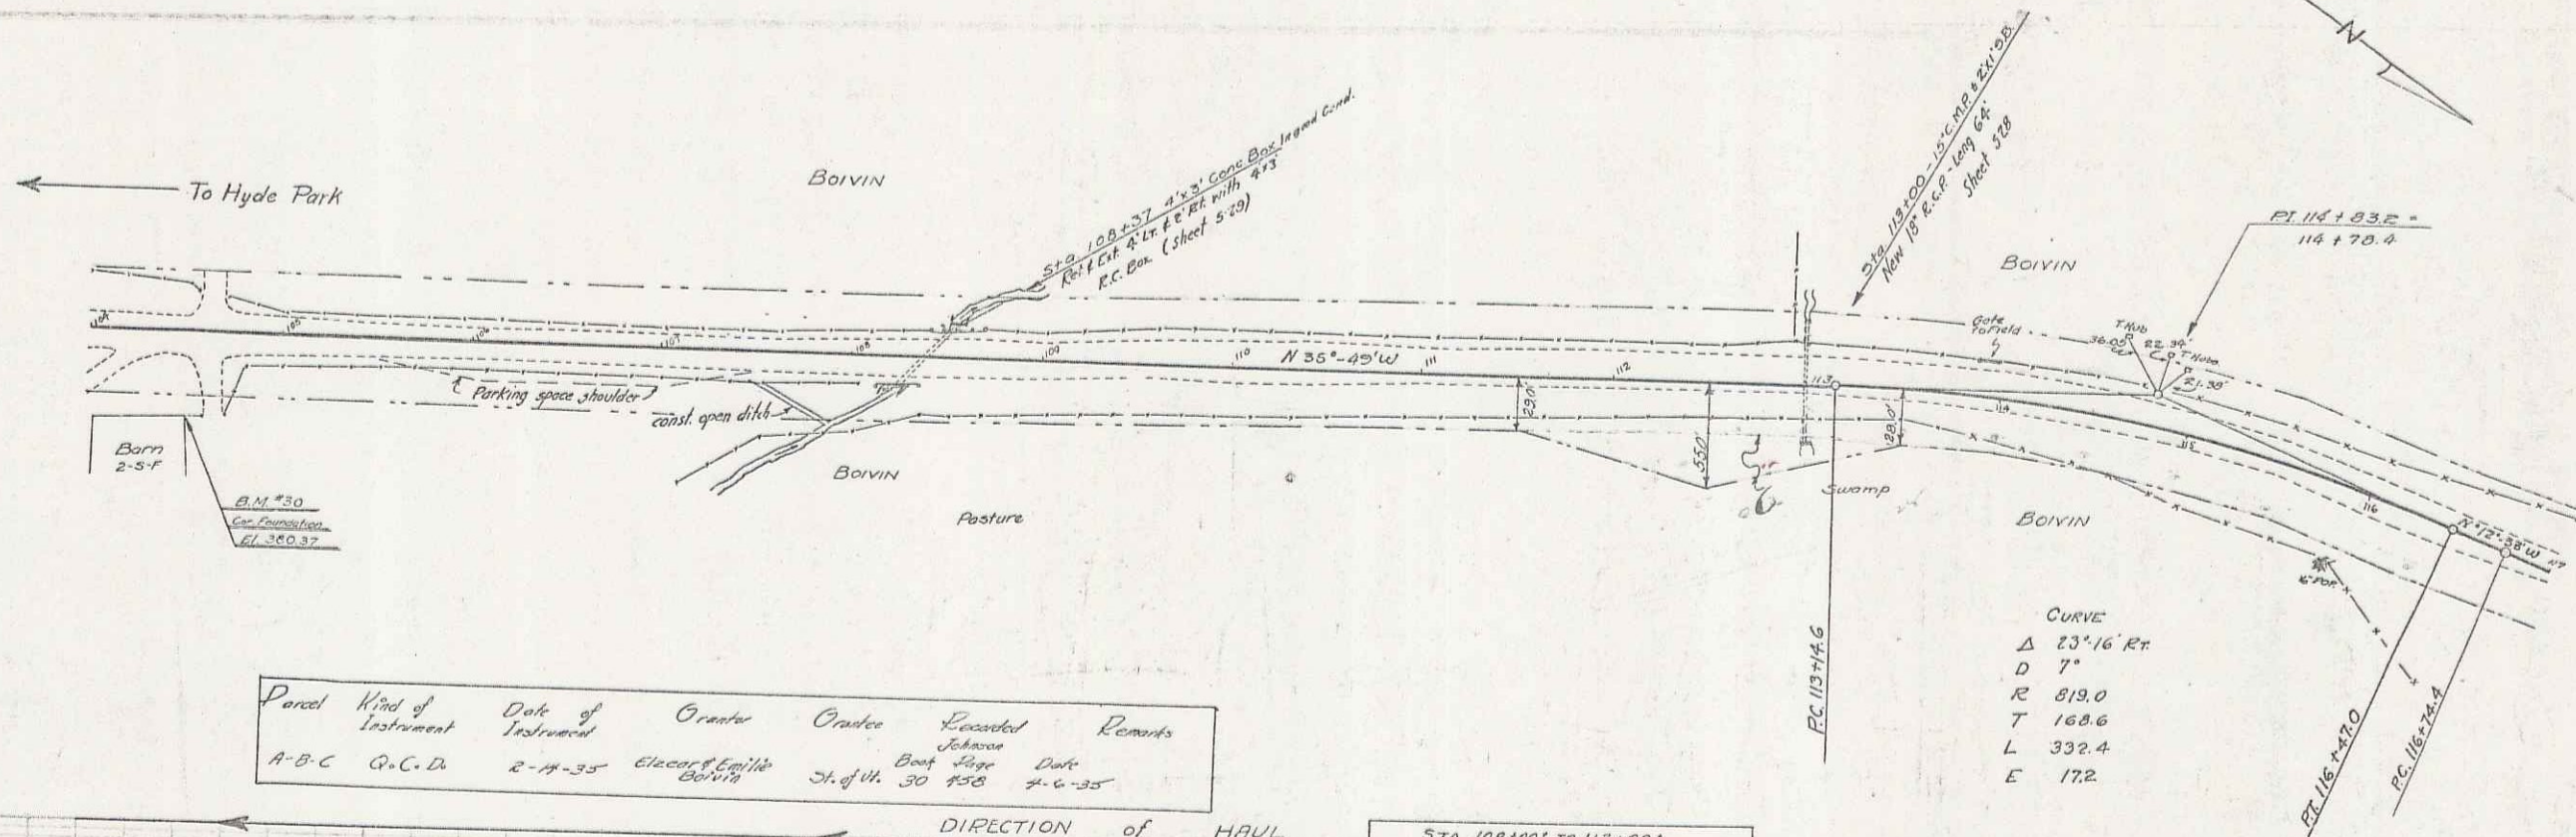

Parcel	Kind of Instrument	Date of Instrument	Ordnance	Ordnance	Located	Remarks
A-B-C	Q.C.D.	2-14-35	Electrod. Equip.	St. of W. 30	1930	Dist. 24.6-35

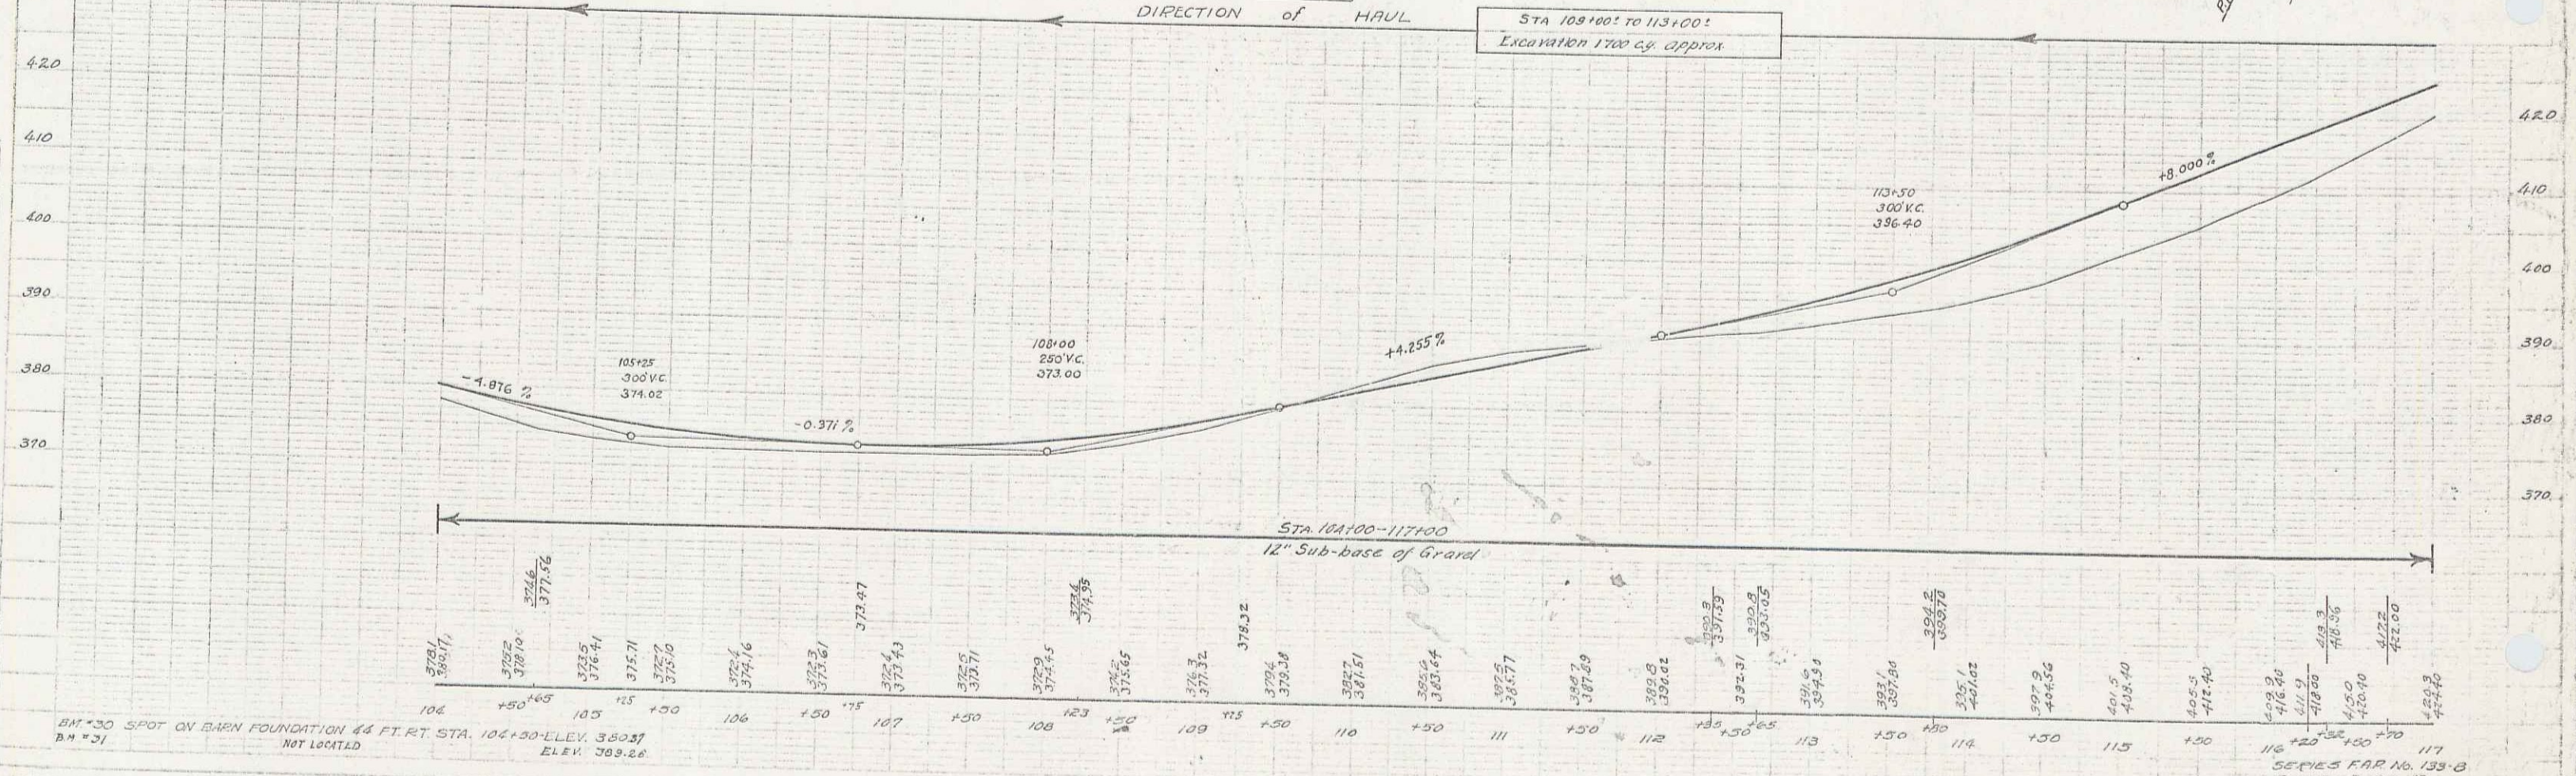

B.P. 30 SPOT ON BARN FOUNDATION 44 FT. RT. STA. 102+20 - L.E.V. 390.31  
NOT LOCATED  
ELEV. 393.26

SERIES F.P. No. 133-B  
SHEET 7 OF 15

5