


Parcel	Kind of Instrument	Date of Instrument	Grantor	Grantee	Record	Reference
A-B-C-D-E	W.D.	1-2-33	John & Nellie Finnegan Jr. of W.	Hyde	30	2-11-33
A-B-C-D	W.D.	5-8-33	Cyprien & Dolina Audet	"	30	2-1-33

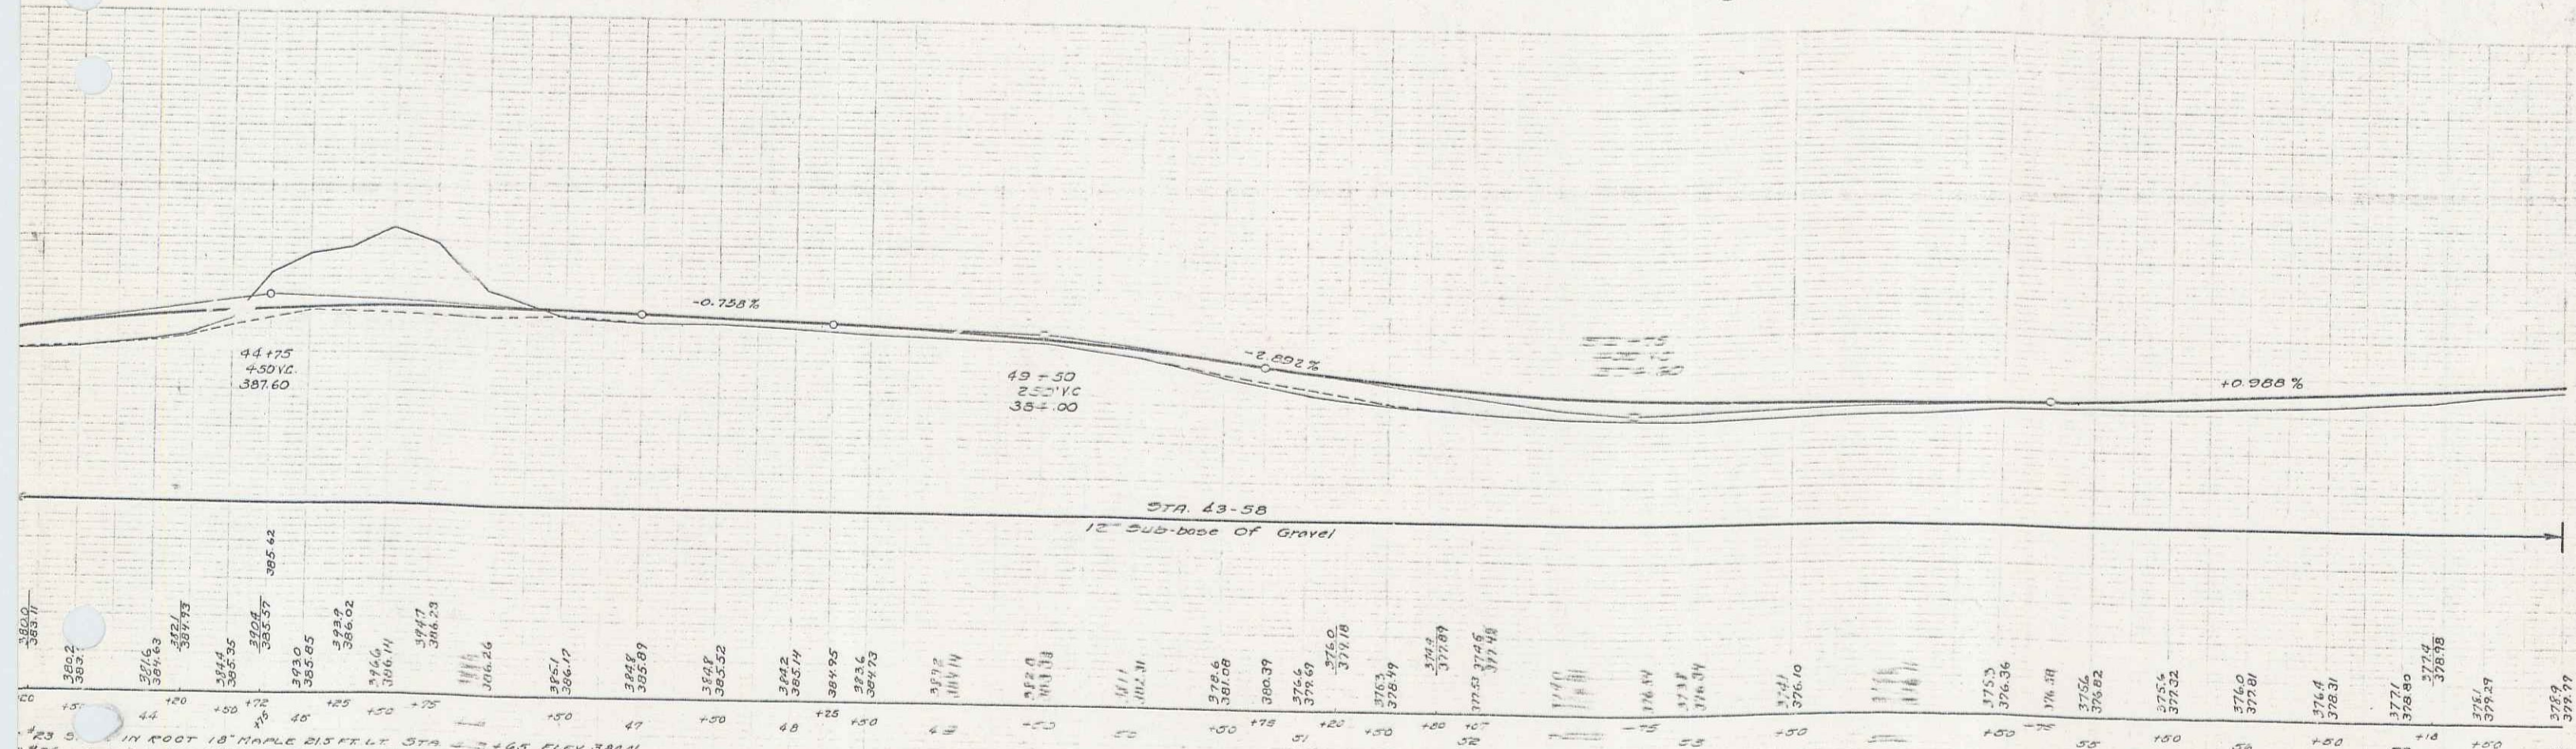

18" MAPLE DISK STA. 43+65 ELEV. 380.01
 12" ELM DISK STA. 52+02 ELEV. 376.19
 STA. 43-58
 12" Sub-base of Gravel