


CONSTRUCT DRIVES

LT	RT
3+25	2+20
4+50	7+00
4+25	1+25
7+15	4+70
	7+15
	8+45

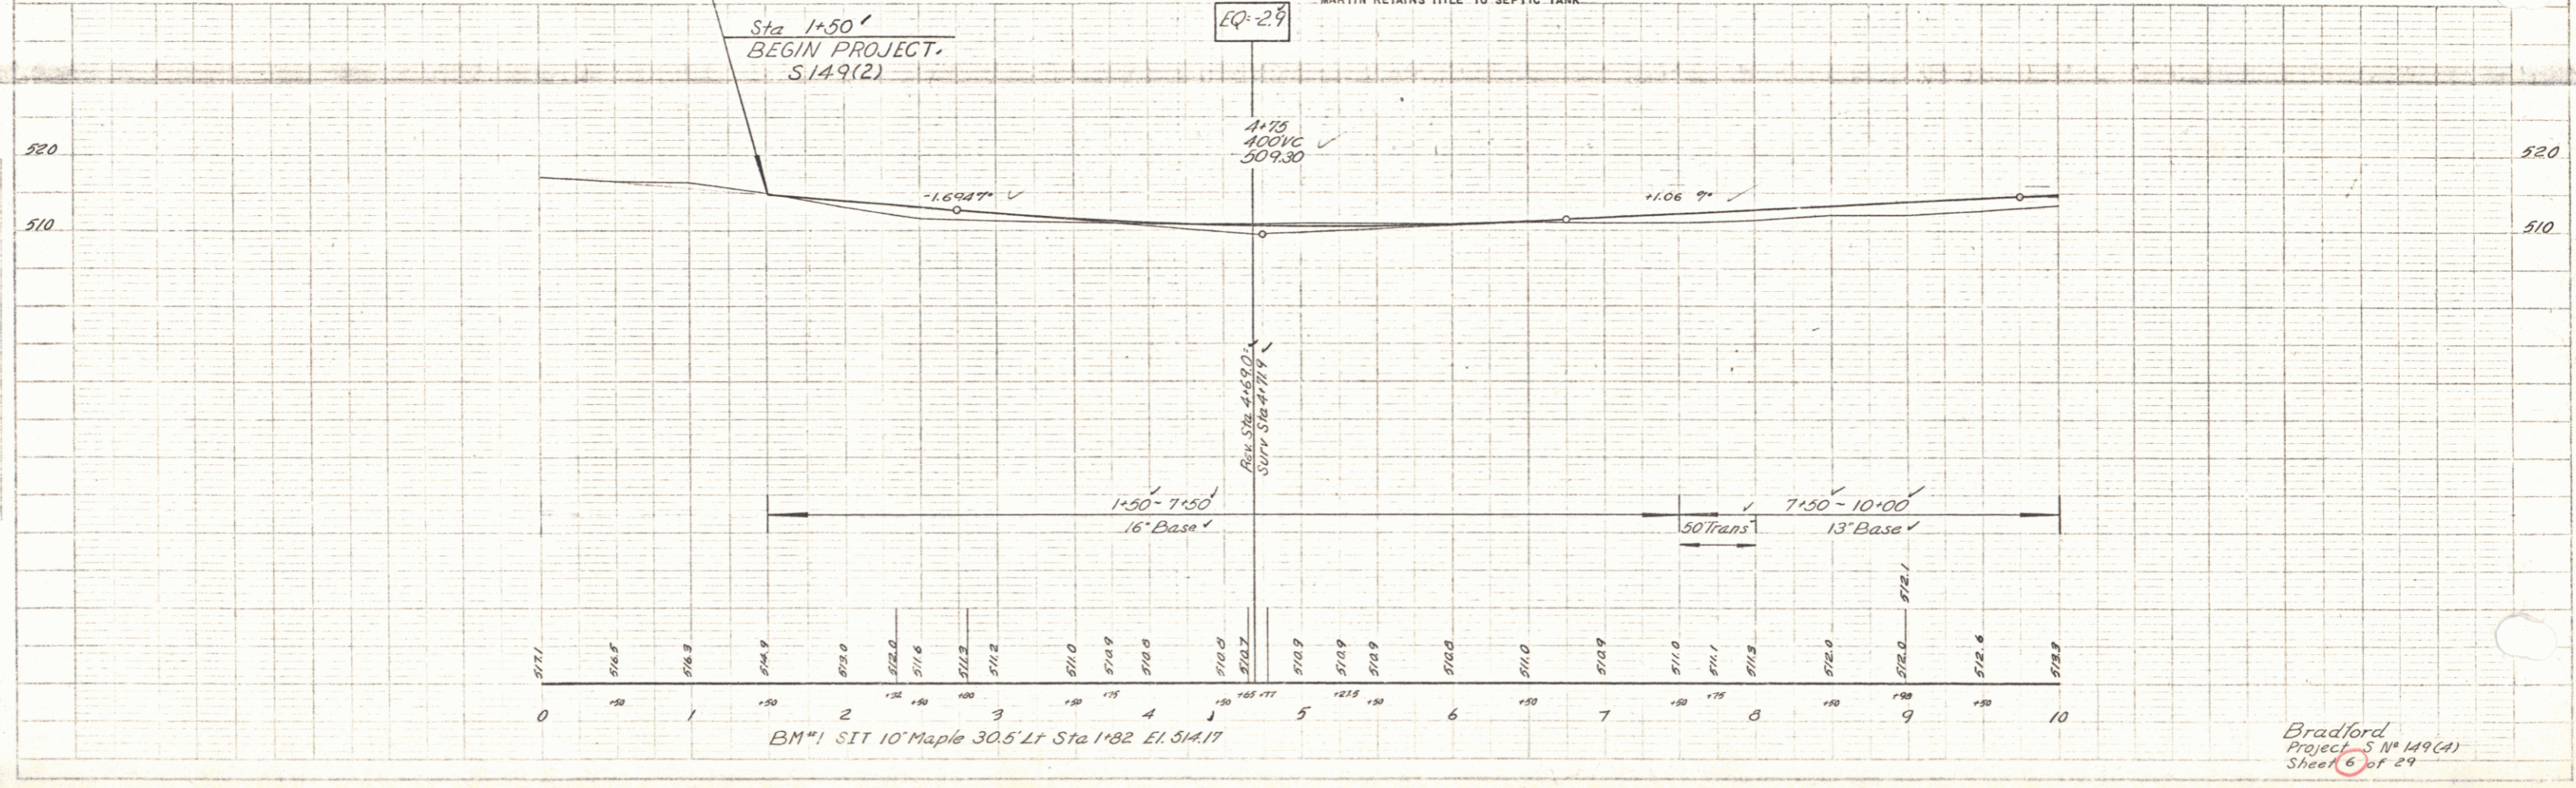

PLATE

NO.	DATE	BY	CHKD.

PROFILE

NO.	DATE	BY	CHKD.

Bradford
Project S No 149(A)
Sheet 6 of 29