


PARCEL	INSTRUMENT	DATE	GRANTOR	GRANTEE	RECORDED	REMARKS
A	Q.C.D.	3-3-38	J.A. PIERSON	ST OF VT	BOOK 30 PAGE 19	DATE 9-9-38
A	Q.C.D.	3-3-38	H.L. PRESCOTT	ST OF VT	BOOK 30 PAGE 17	DATE 3-8-38 CL 14-18-50

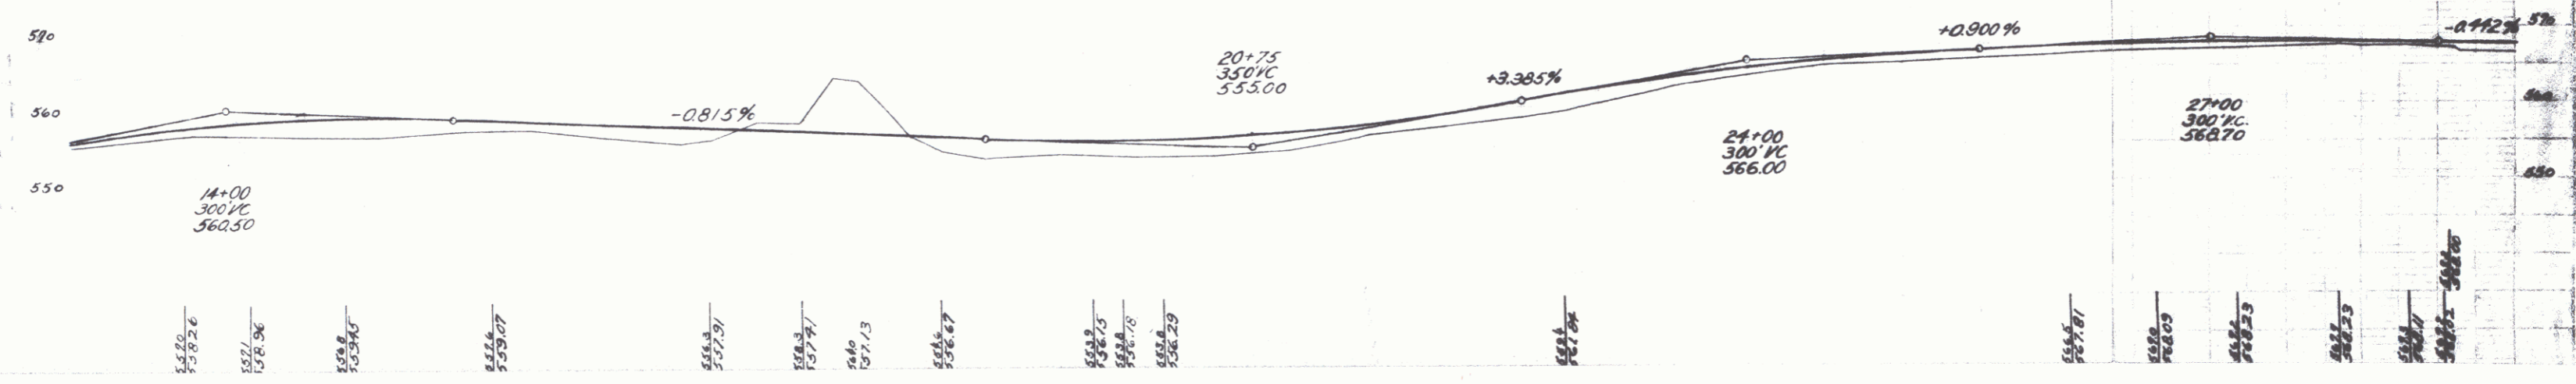

SHEET 3 of 40