



149

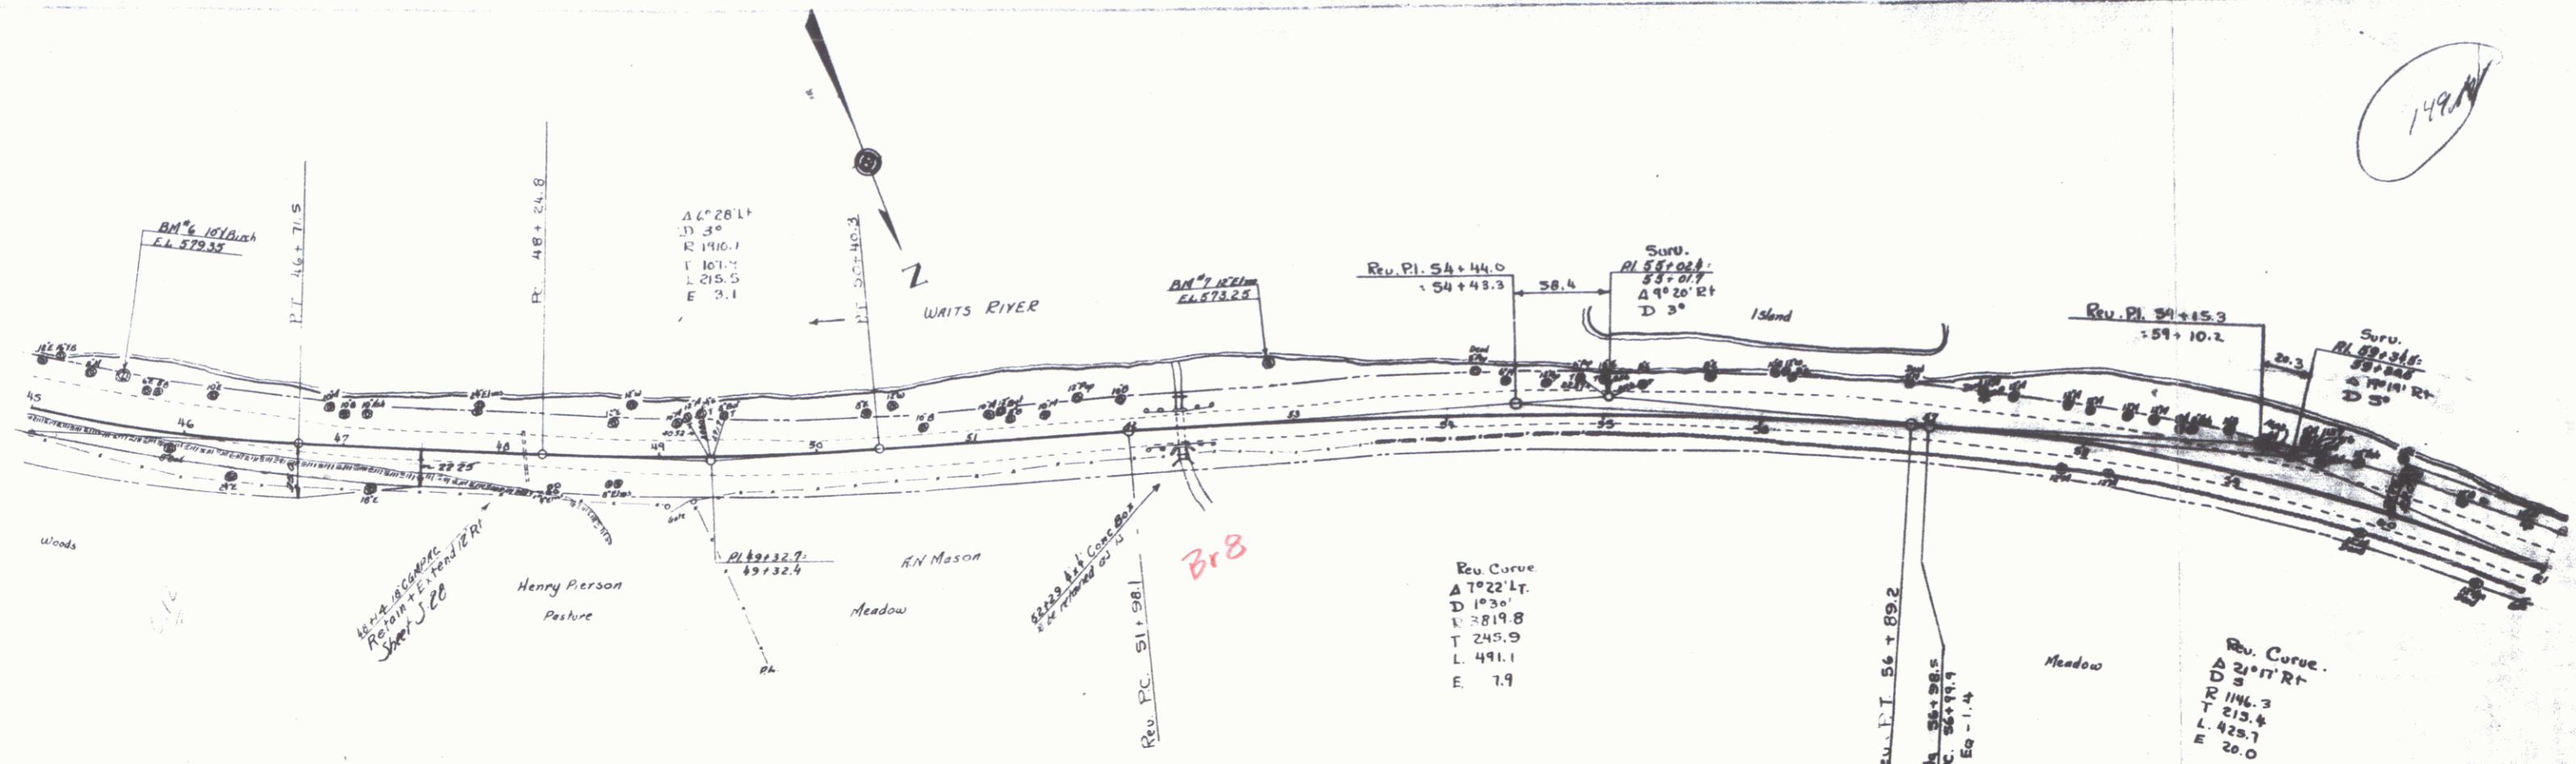

POOR ORIGINAL COPY

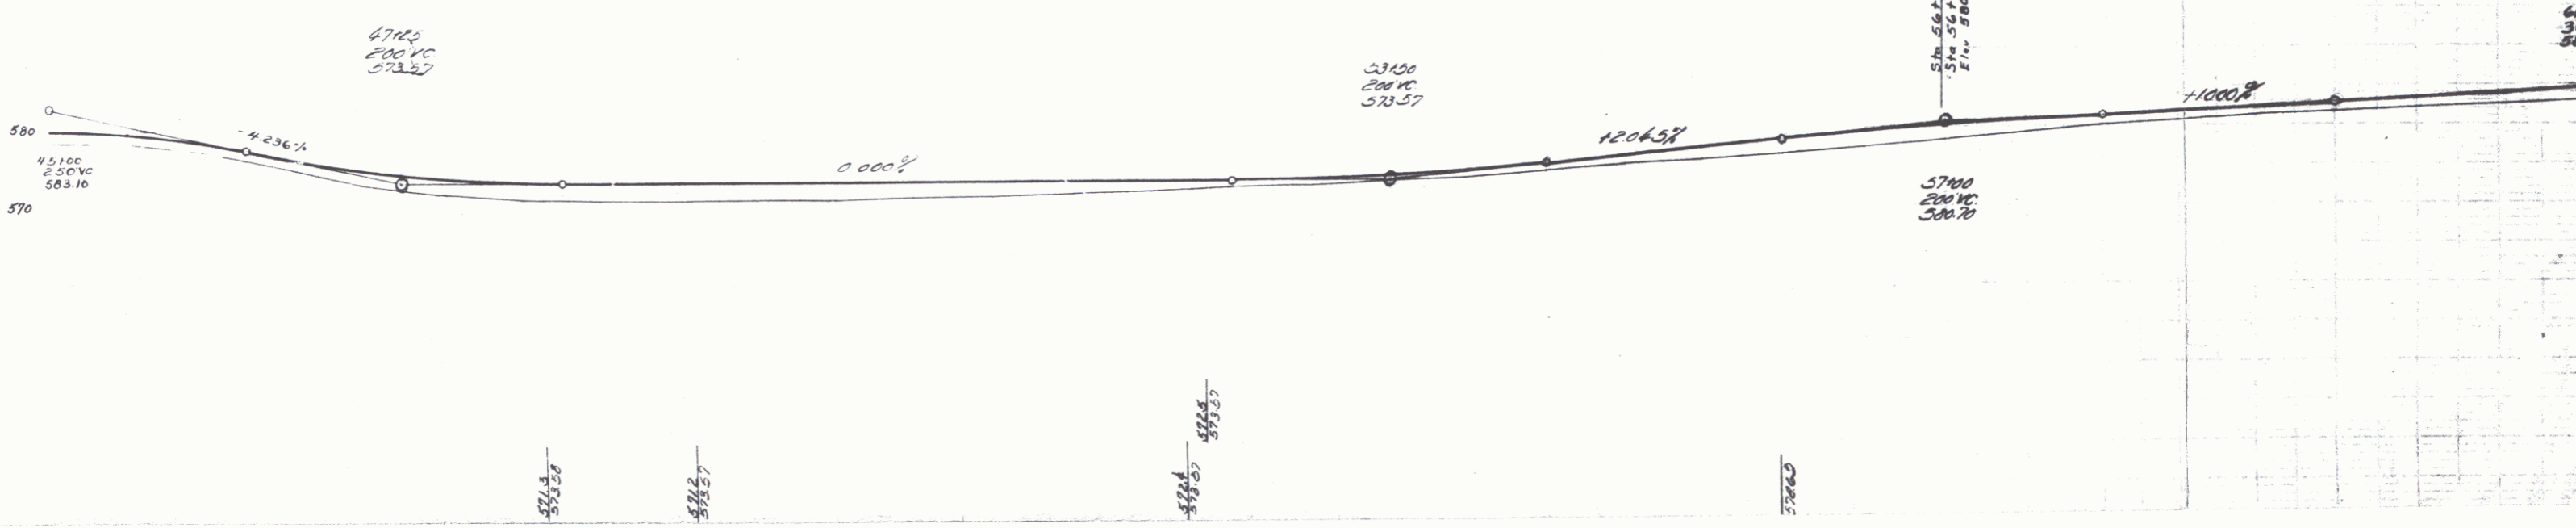

SHEET 5 of 40