



A. M. Shuler  
 Civil Engineer  
 No. 1000  
 State of Vermont  
 License No. 1000

A. M. Shuler  
 Civil Engineer  
 No. 1000  
 State of Vermont  
 License No. 1000

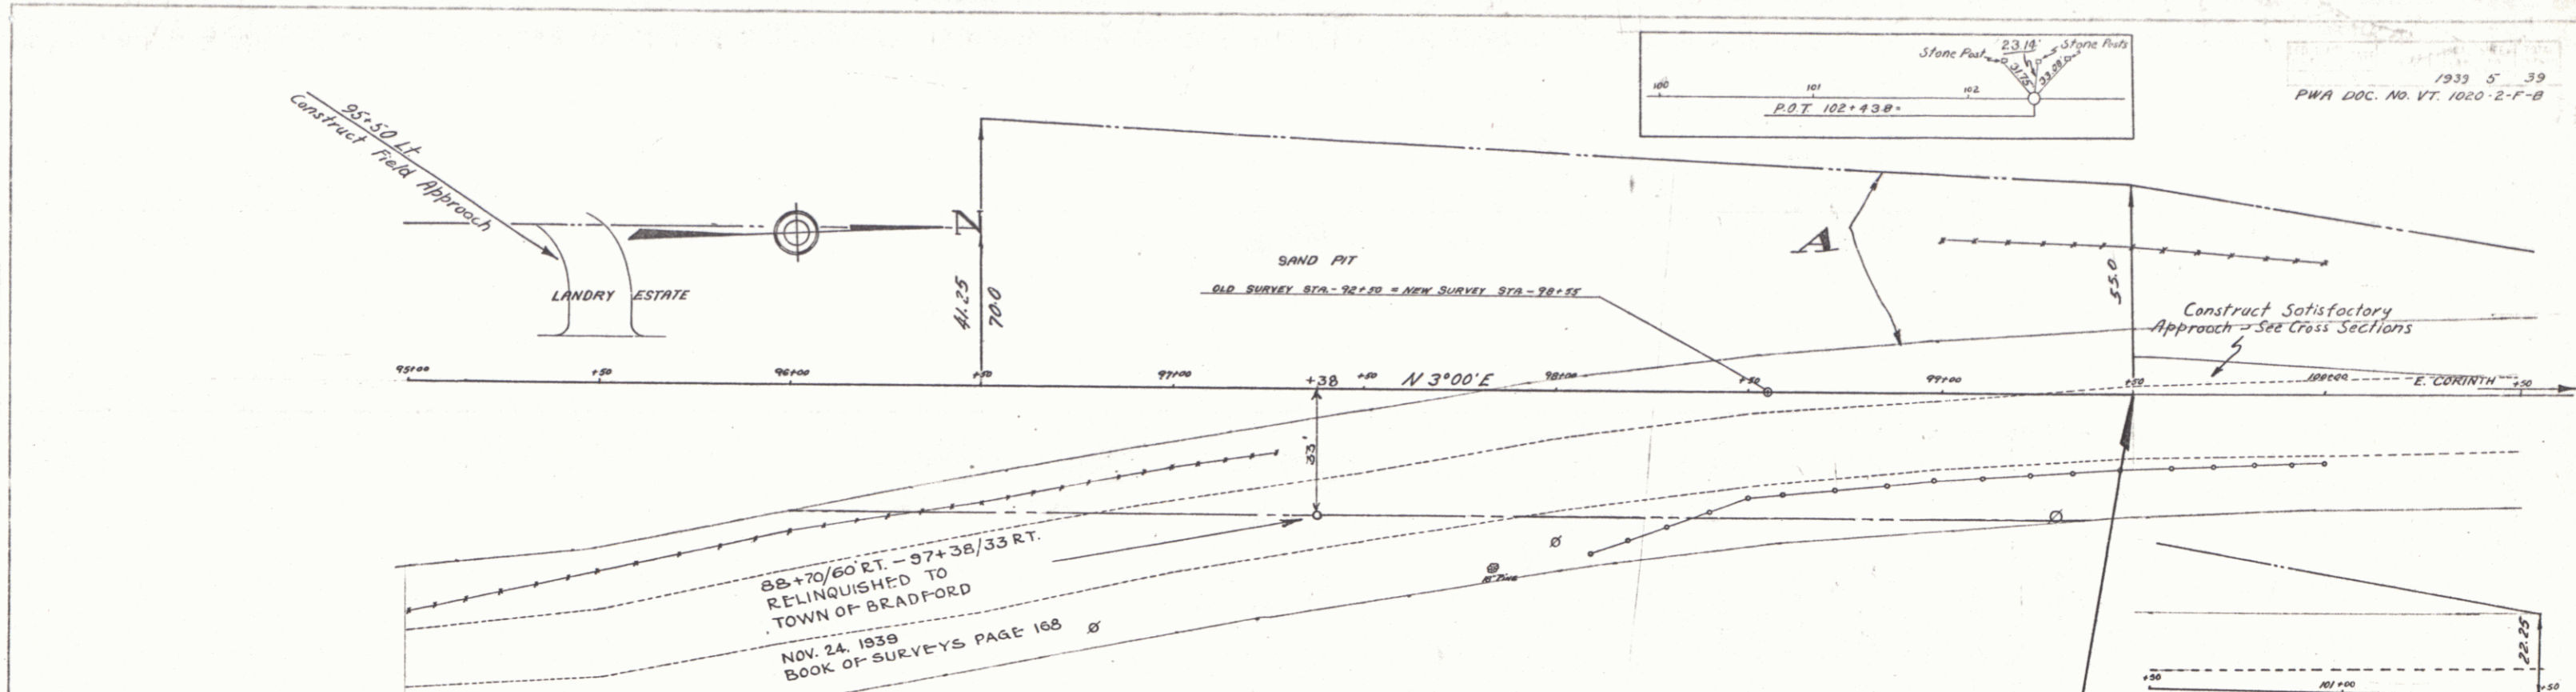

Parcel	Instrument Date	Grantor	Grantee	Recorded	Remarks
A	M.D. 130-39	Lira D. Landry	State	30 65 2-9-39	
A	Partial Release 126-39	Federal Land Bank	"	30 65-66 2-9-39	

STA 99+50  
 END OF PROJECT

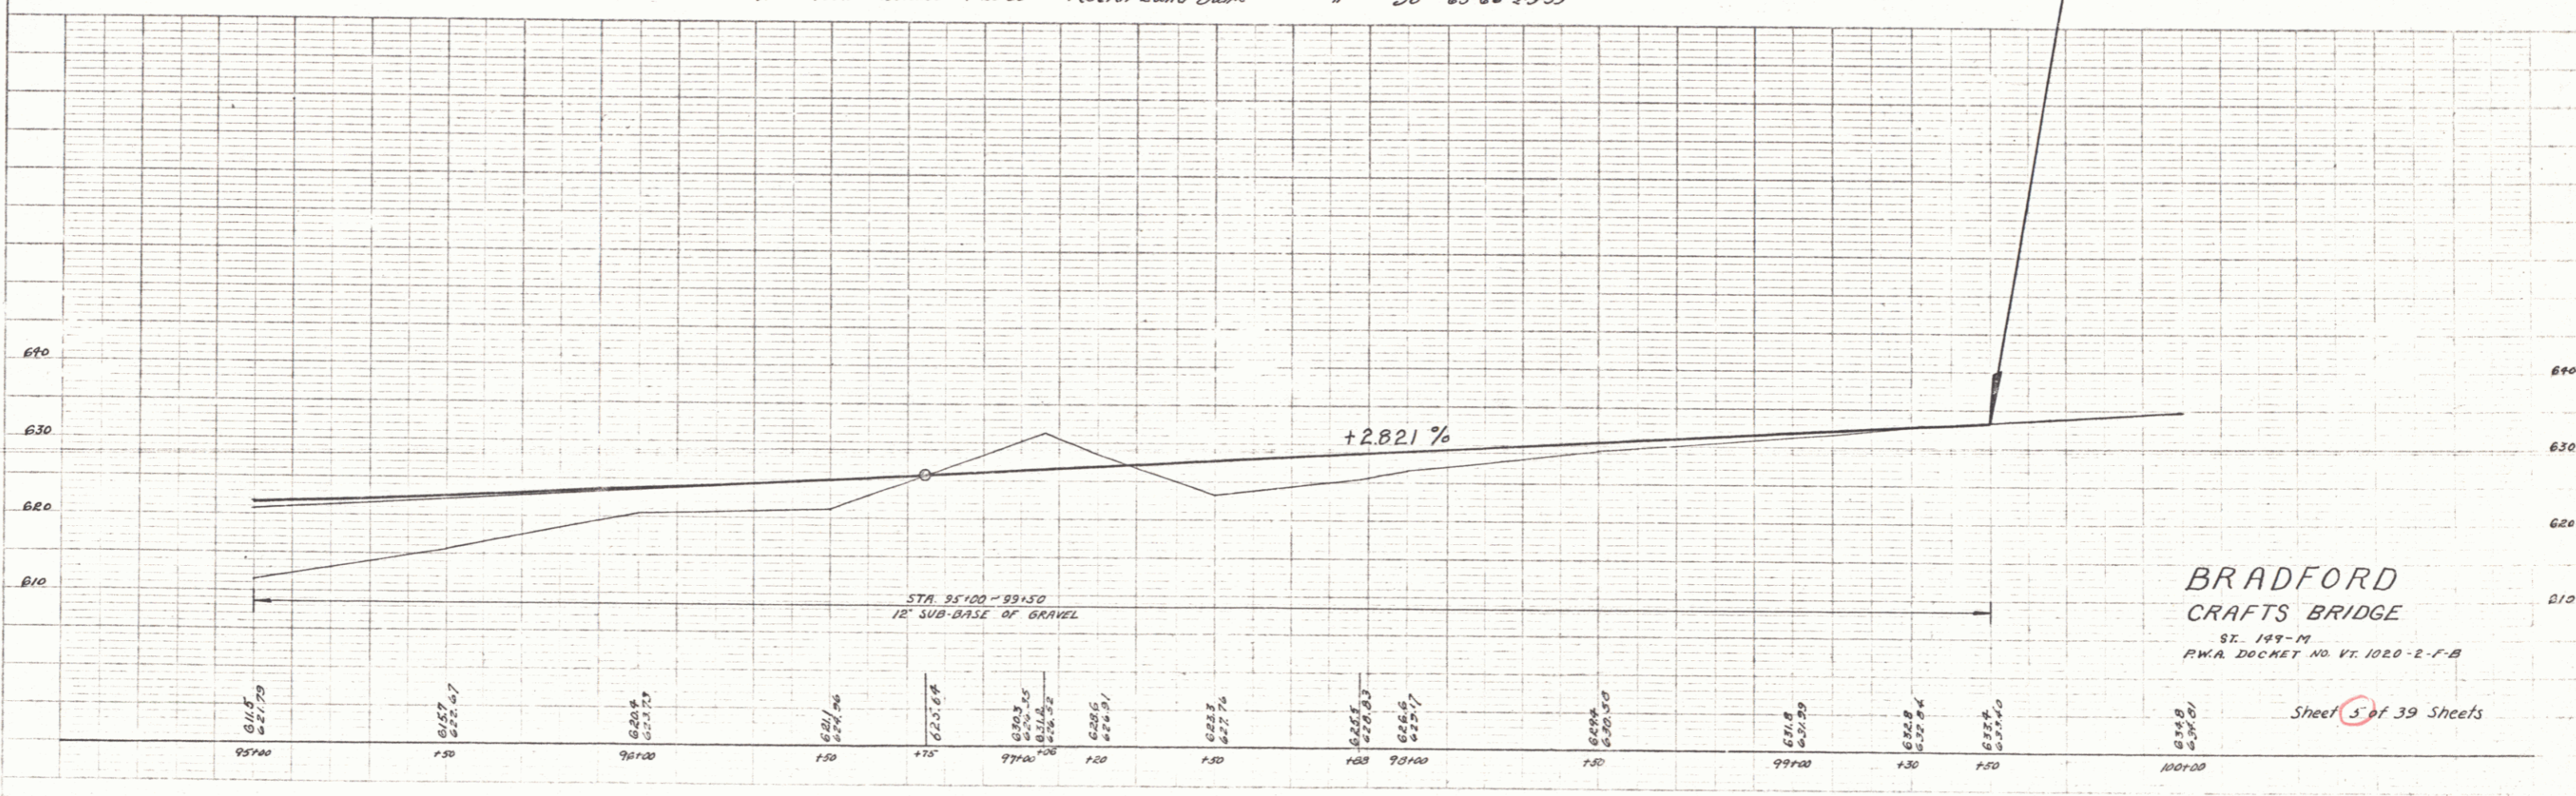

BRADFORD  
 CRAFTS BRIDGE  
 ST. 149-M  
 PWA DOCKET NO. VT. 1020-2-F-B

Sheet 5 of 39 Sheets