

PLAN
 DATE: _____
 BY: _____
 CHECKED: _____
 APPROVED: _____
 TITLE: _____

PROFILE
 DATE: _____
 BY: _____
 CHECKED: _____
 APPROVED: _____
 TITLE: _____

STONE FILL, TYPE II
 65+00 - 73+50 Rt
 NOTE: Removal of Guide Posts
 67+00 ± Lt - 71+50 ± Lt
 to be included in Common
 Excavation, Item 203.15

Richard G. Legge
 H.E. = 0.35 Acres
 Other = 0.09 Acres
 Taking = 0.33 Acres
 Slope Rights = 0.14 Acres

EXCAVATION & REMOVAL OF
 ROAD SURFACE & PAVEMENTS
 62+22 - 65+00 Rt
 66+50 - 71+50 Lt
 75+00 - 77+50 Rt
 75+40 MUCK EXCAVATION
 62+22.5 - 63+50
 74+00 - 76+00

BM #17
 S.I.T. Conc. Wing
 643.31


PI 66+44.9
 Δ = 55° 51' Rt
 D = 2' 00"

POST 69+31.10

GUARD RAIL, STEEL BEAM
 w/ STEEL POSTS, TYPE X II
 65+00 - 73+00 Rt

CONSTRUCT DRIVES
 71+00 ± Lt
 64+25 ± Lt


Bert T. Holland, Jr.
 H.E. = 0.4 A.
 Other = 1.2 A.
 Taking = 1.6 Acres
 Slope Rights = 0.9 Acres

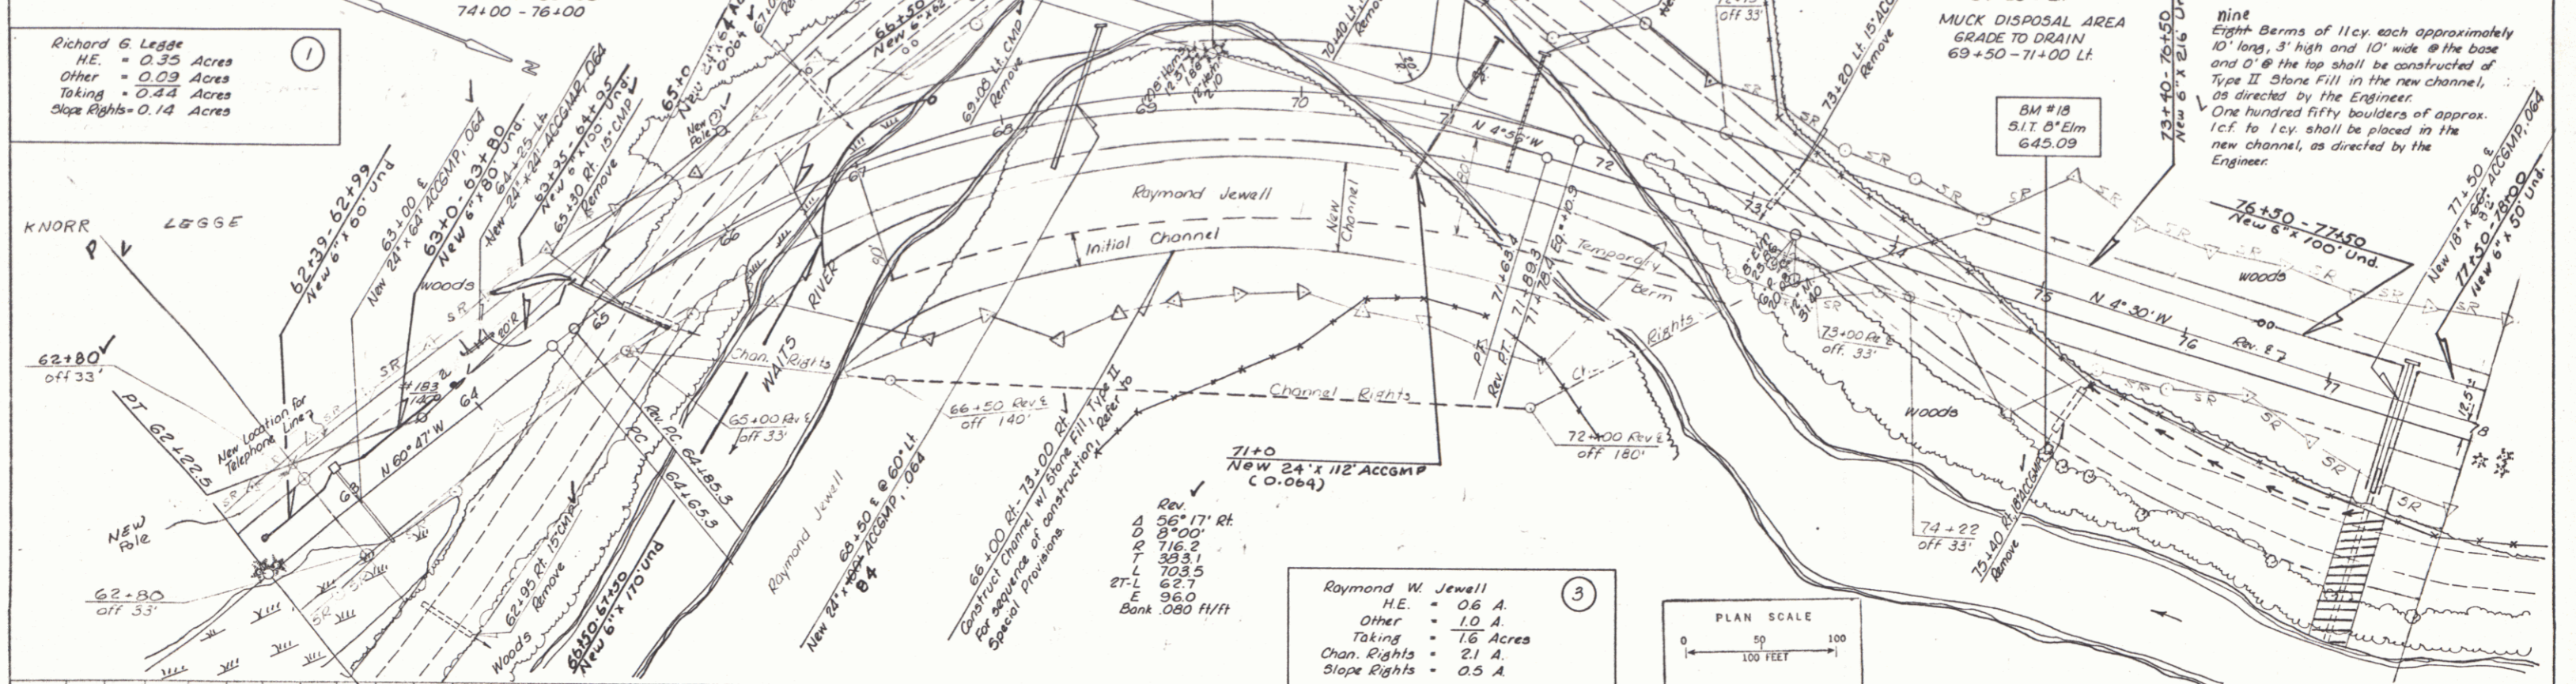

Rev
 A 56° 17' Rt
 D 8' 00"
 E 716.2
 L 53.1
 L 703.5
 2T-L 62.7
 E 96.0
 Bank 0.80 H/ft

Raymond W. Jewell
 H.E. = 0.6 A.
 Other = 1.0 A.
 Taking = 1.6 Acres
 Chan. Rights = 2.1 A.
 Slope Rights = 0.5 A

PLAN SCALE
 0 50 100
 FEET

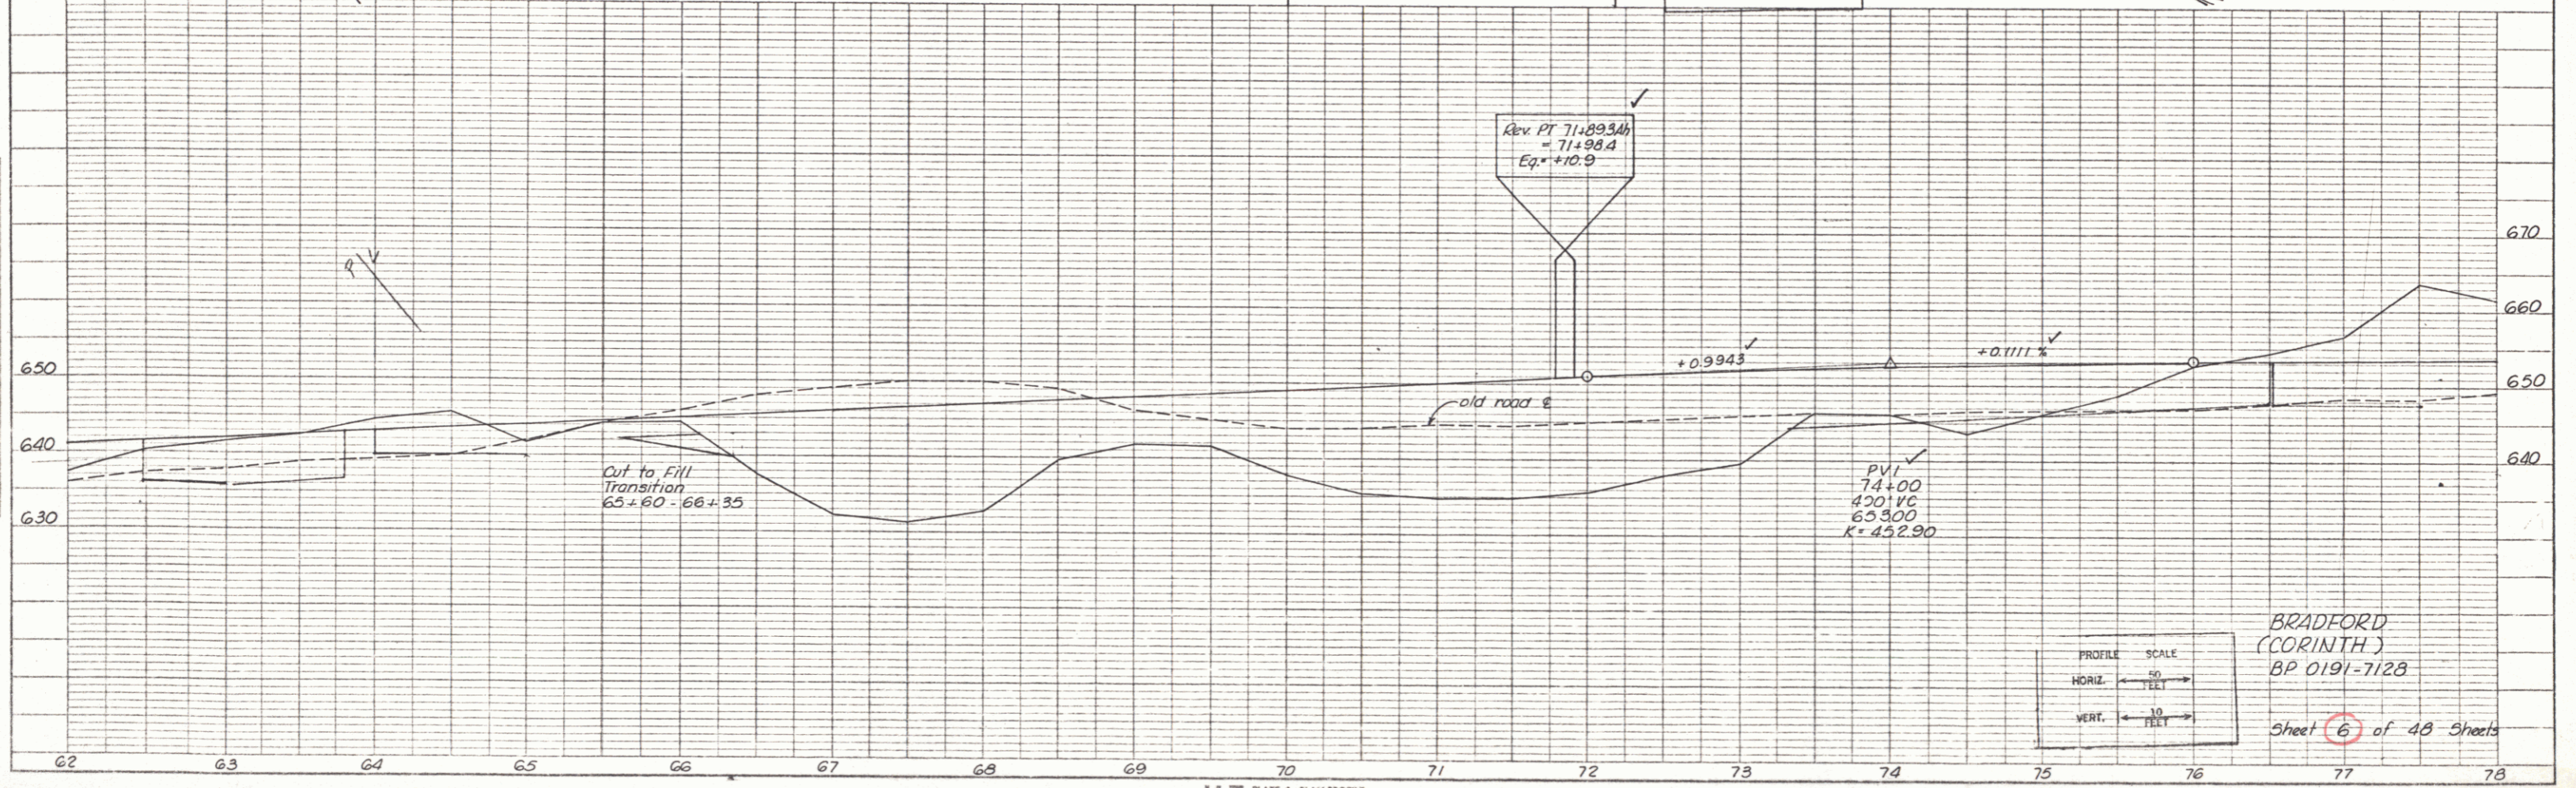

PROFILE SCALE
 HORIZ. 1" = 50 FEET
 VERT. 1" = 10 FEET

BRADFORD
 (CORINTH)
 BP 0191-7128

Sheet 6 of 48 Sheets