
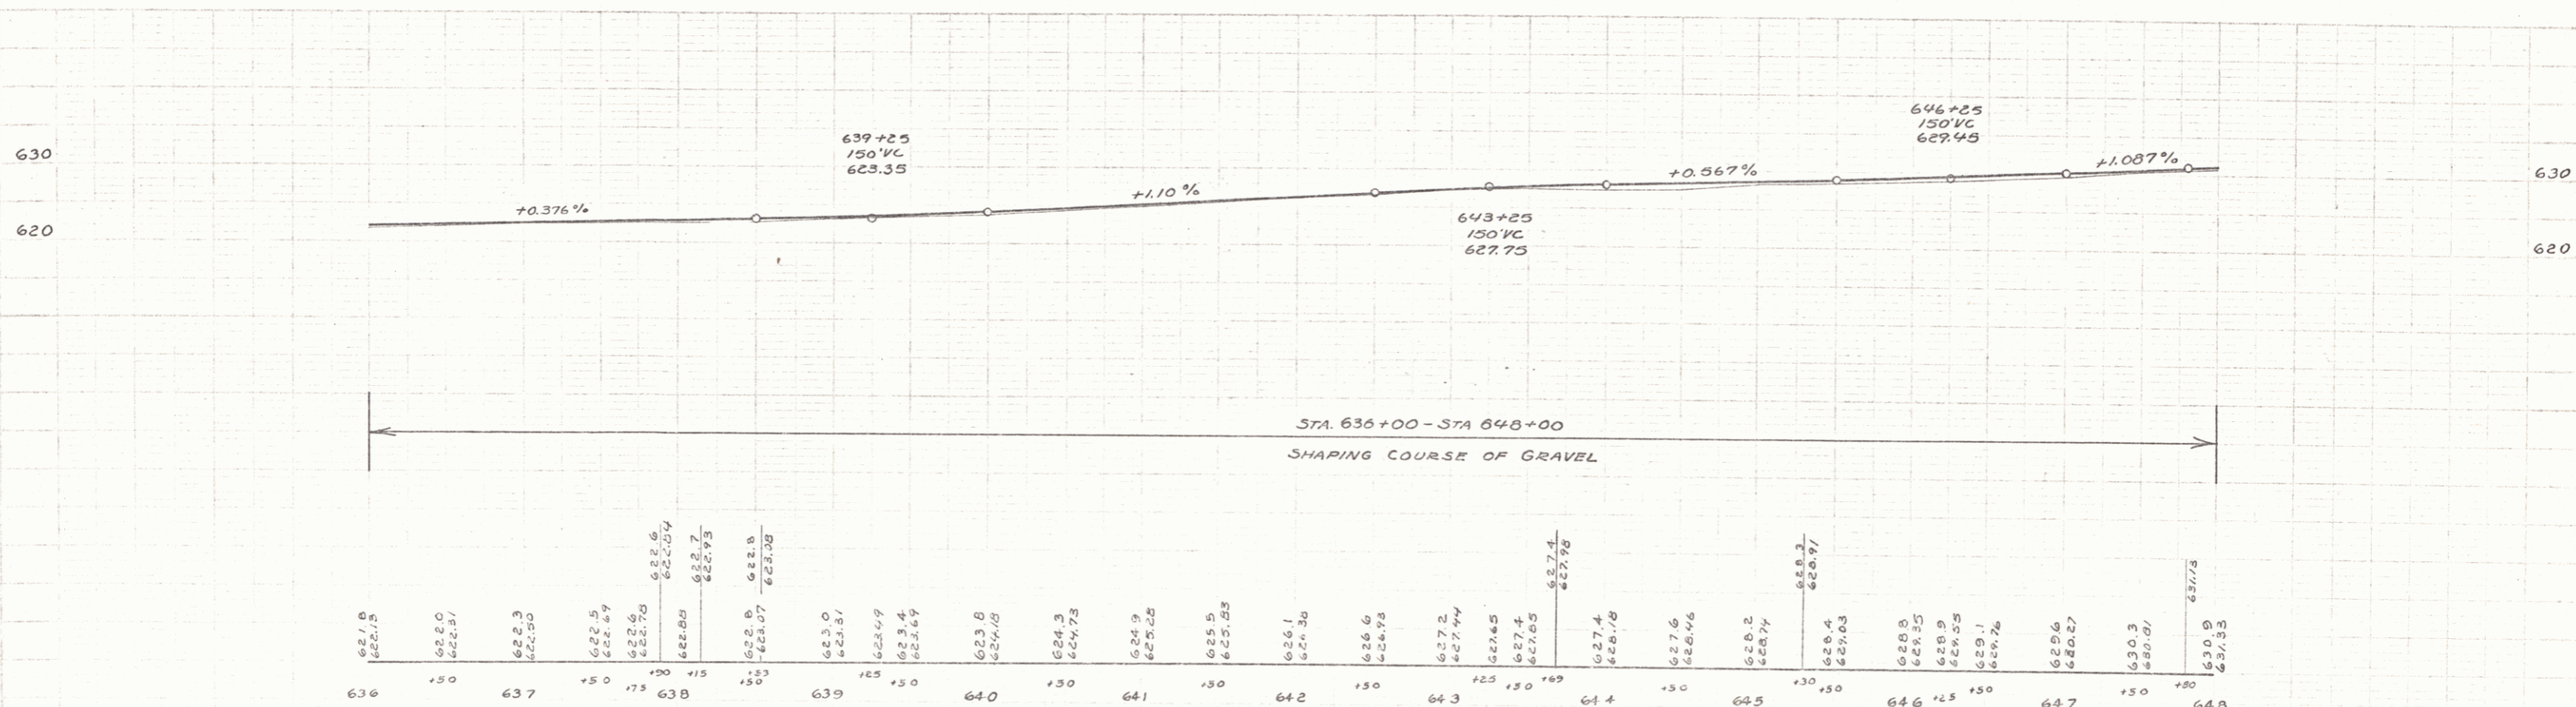


PUTNAM - WOOD 1933
 F.W. HAYWARD 3/1933

A.D. WOOD 3/1933
 F.W. HAYWARD 3/1933

FIELD NO. DIST. NO. STATE SHEET NO. SHEETS
 NCS 174 1933 6 21

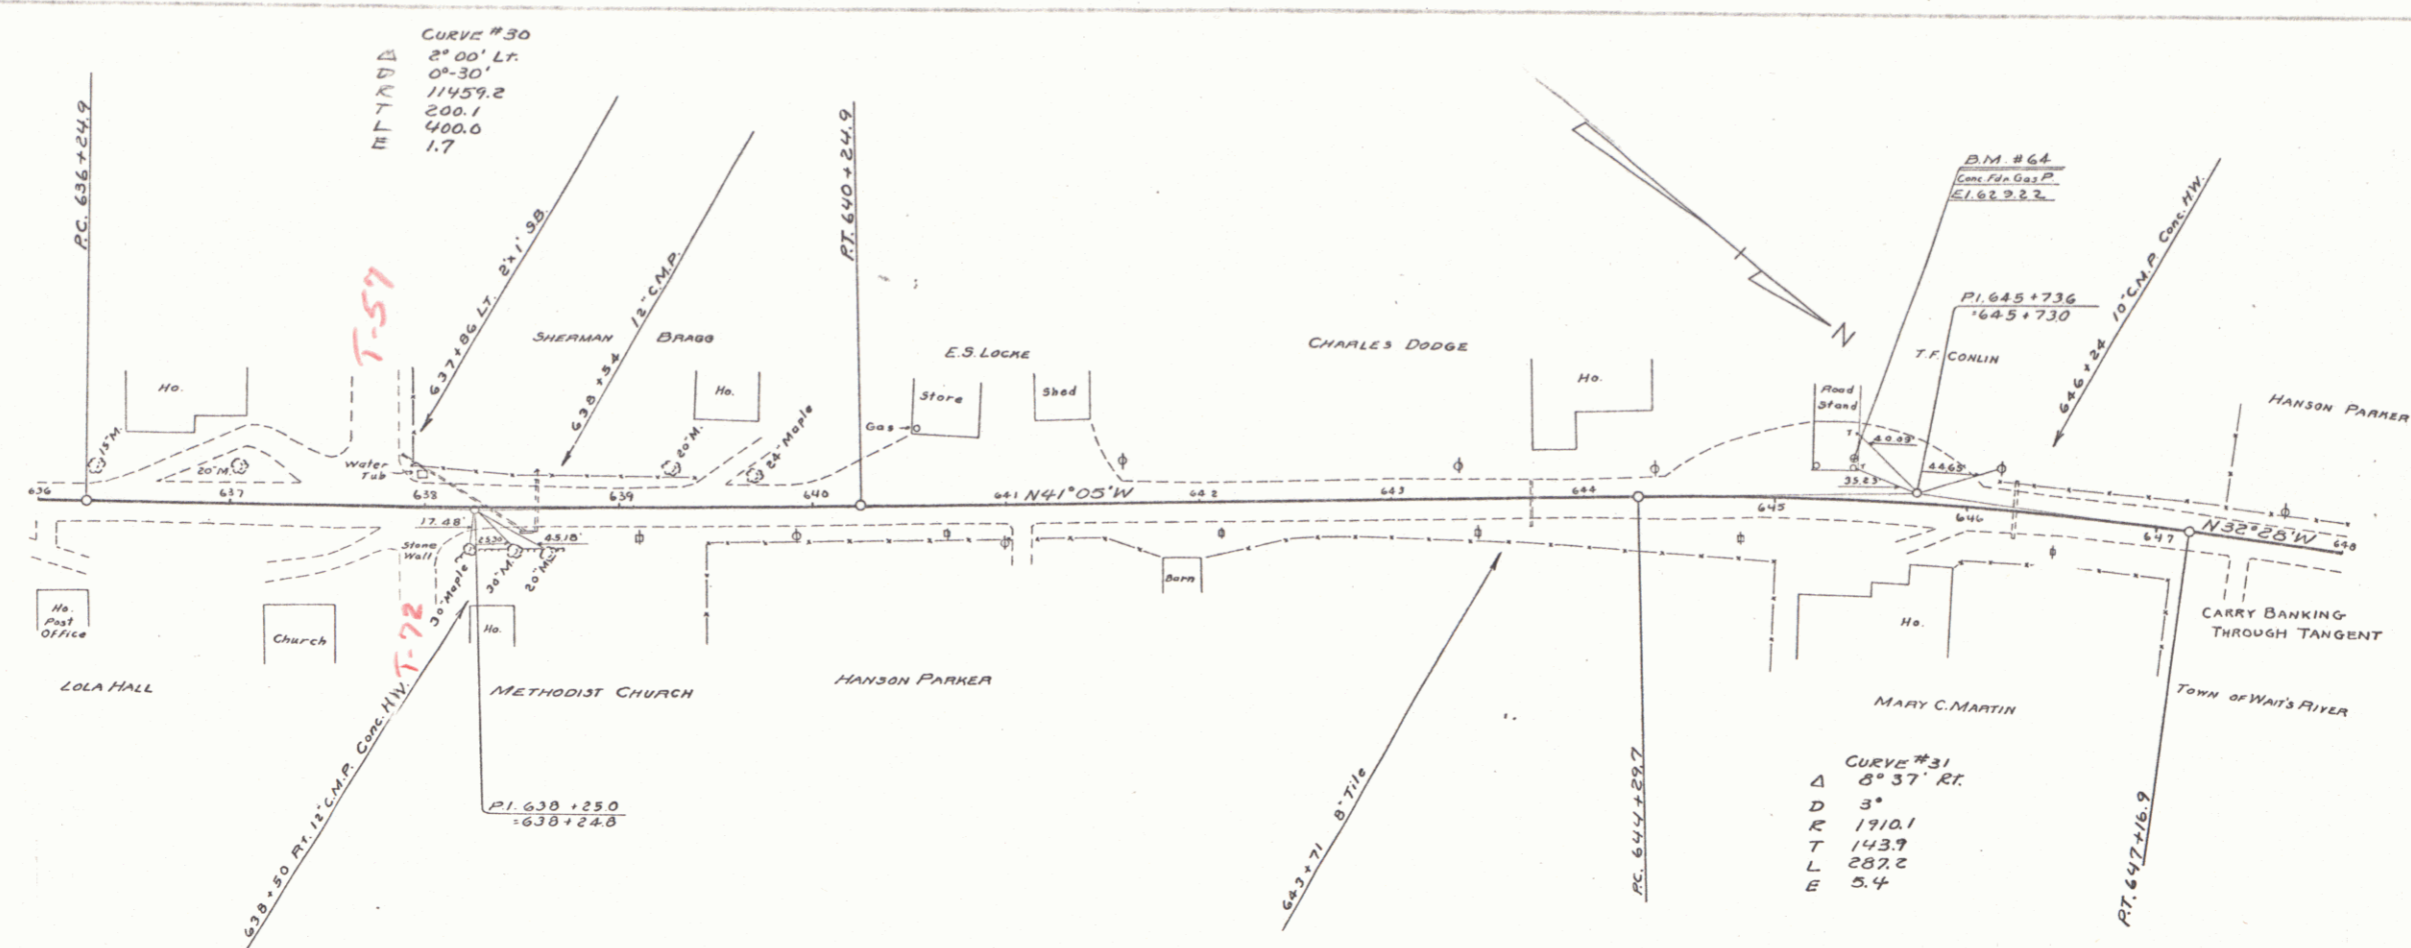

B.M. # 64 Spot on Conc Fdn. Gas Pump 15' Lt. Sta. 645+38 Elev 629.22

SERIES NRS NO. 149A
 SHEET 6 OF 21