
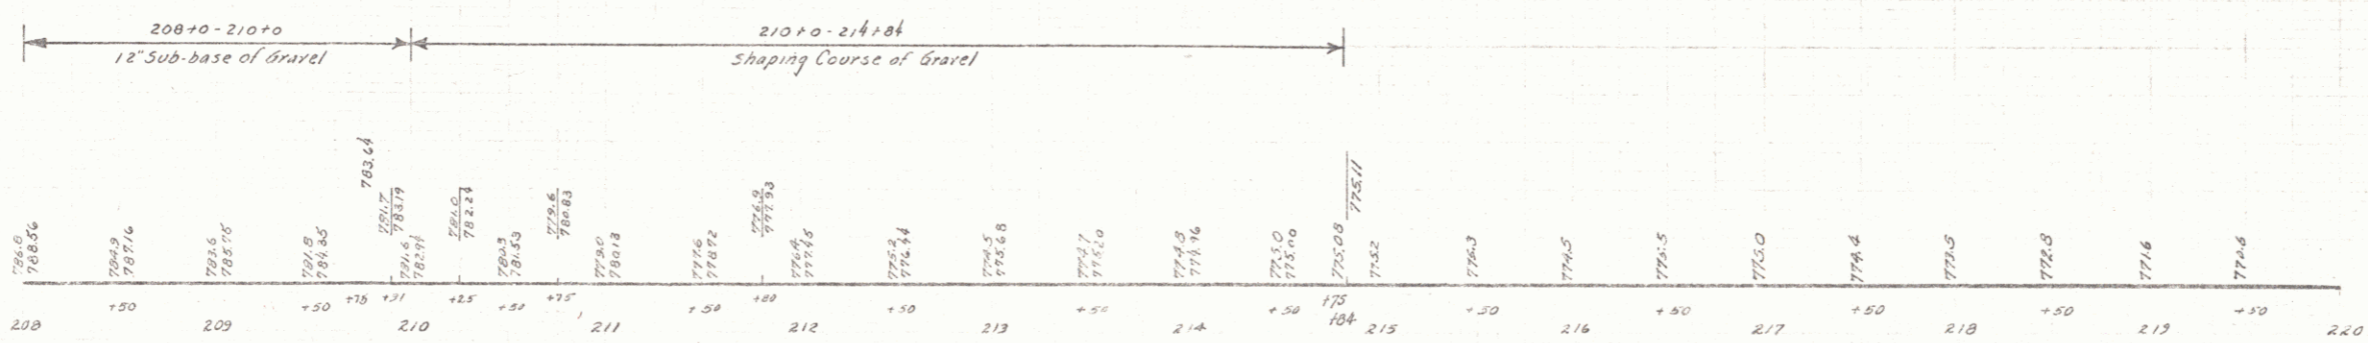
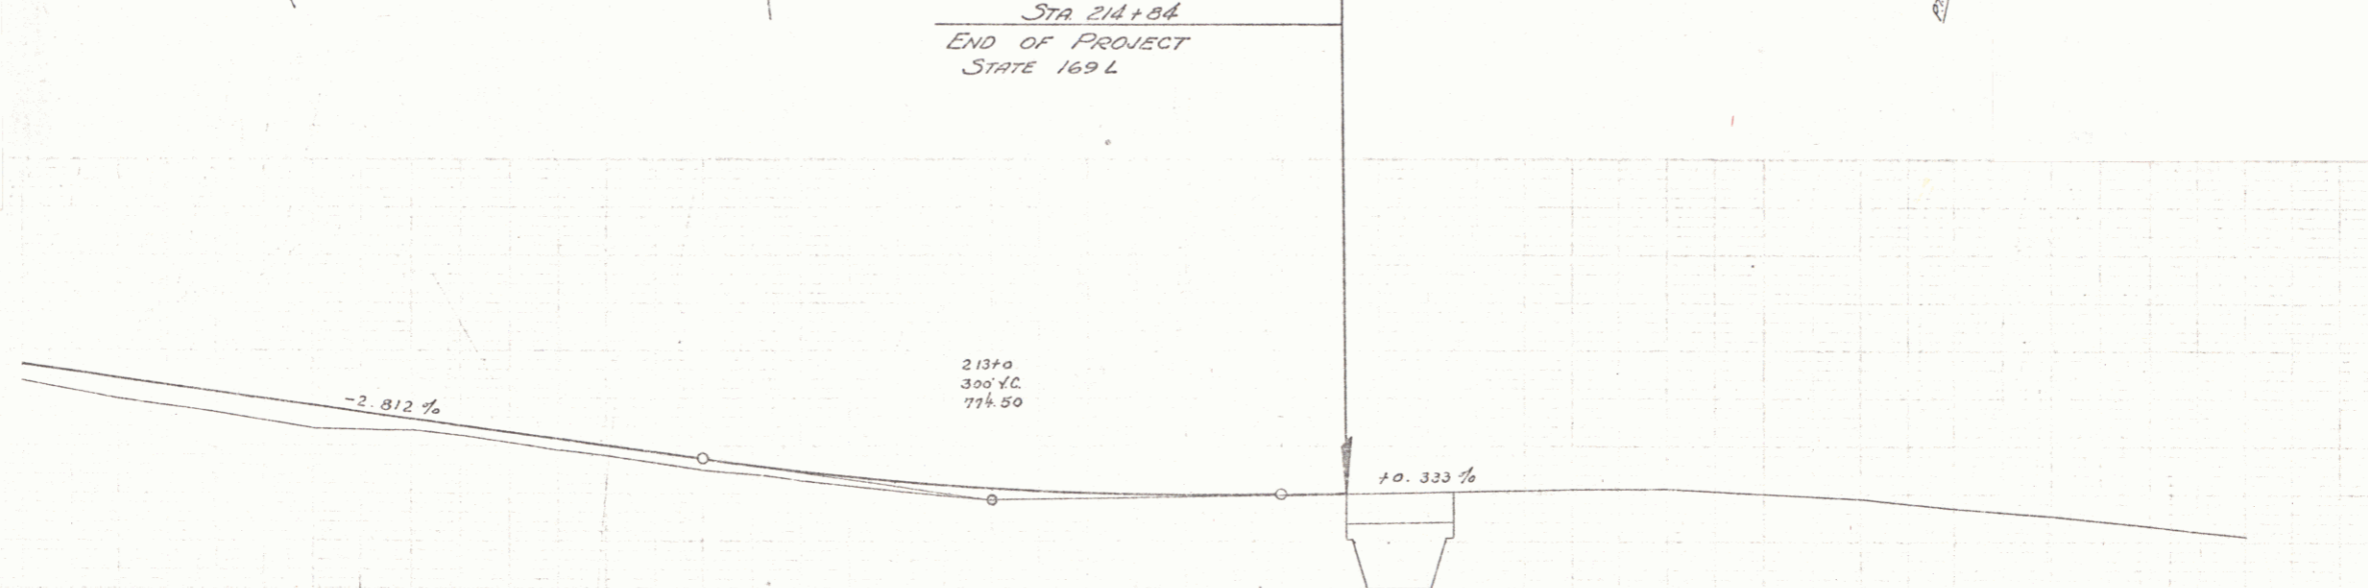


PARCEL INSTRUMENT	DATE	GRANTOR	GRANTEE	RECORDED	REMARKS
B.M. #128				TOPSHAM	
ST. OF VT.	30	53	7-11-40		
ST. OF VT.	30	79	7-11-40		

DATE	BY	TOTAL SHEETS	TOTAL SHEETS
7-11-40		6	6

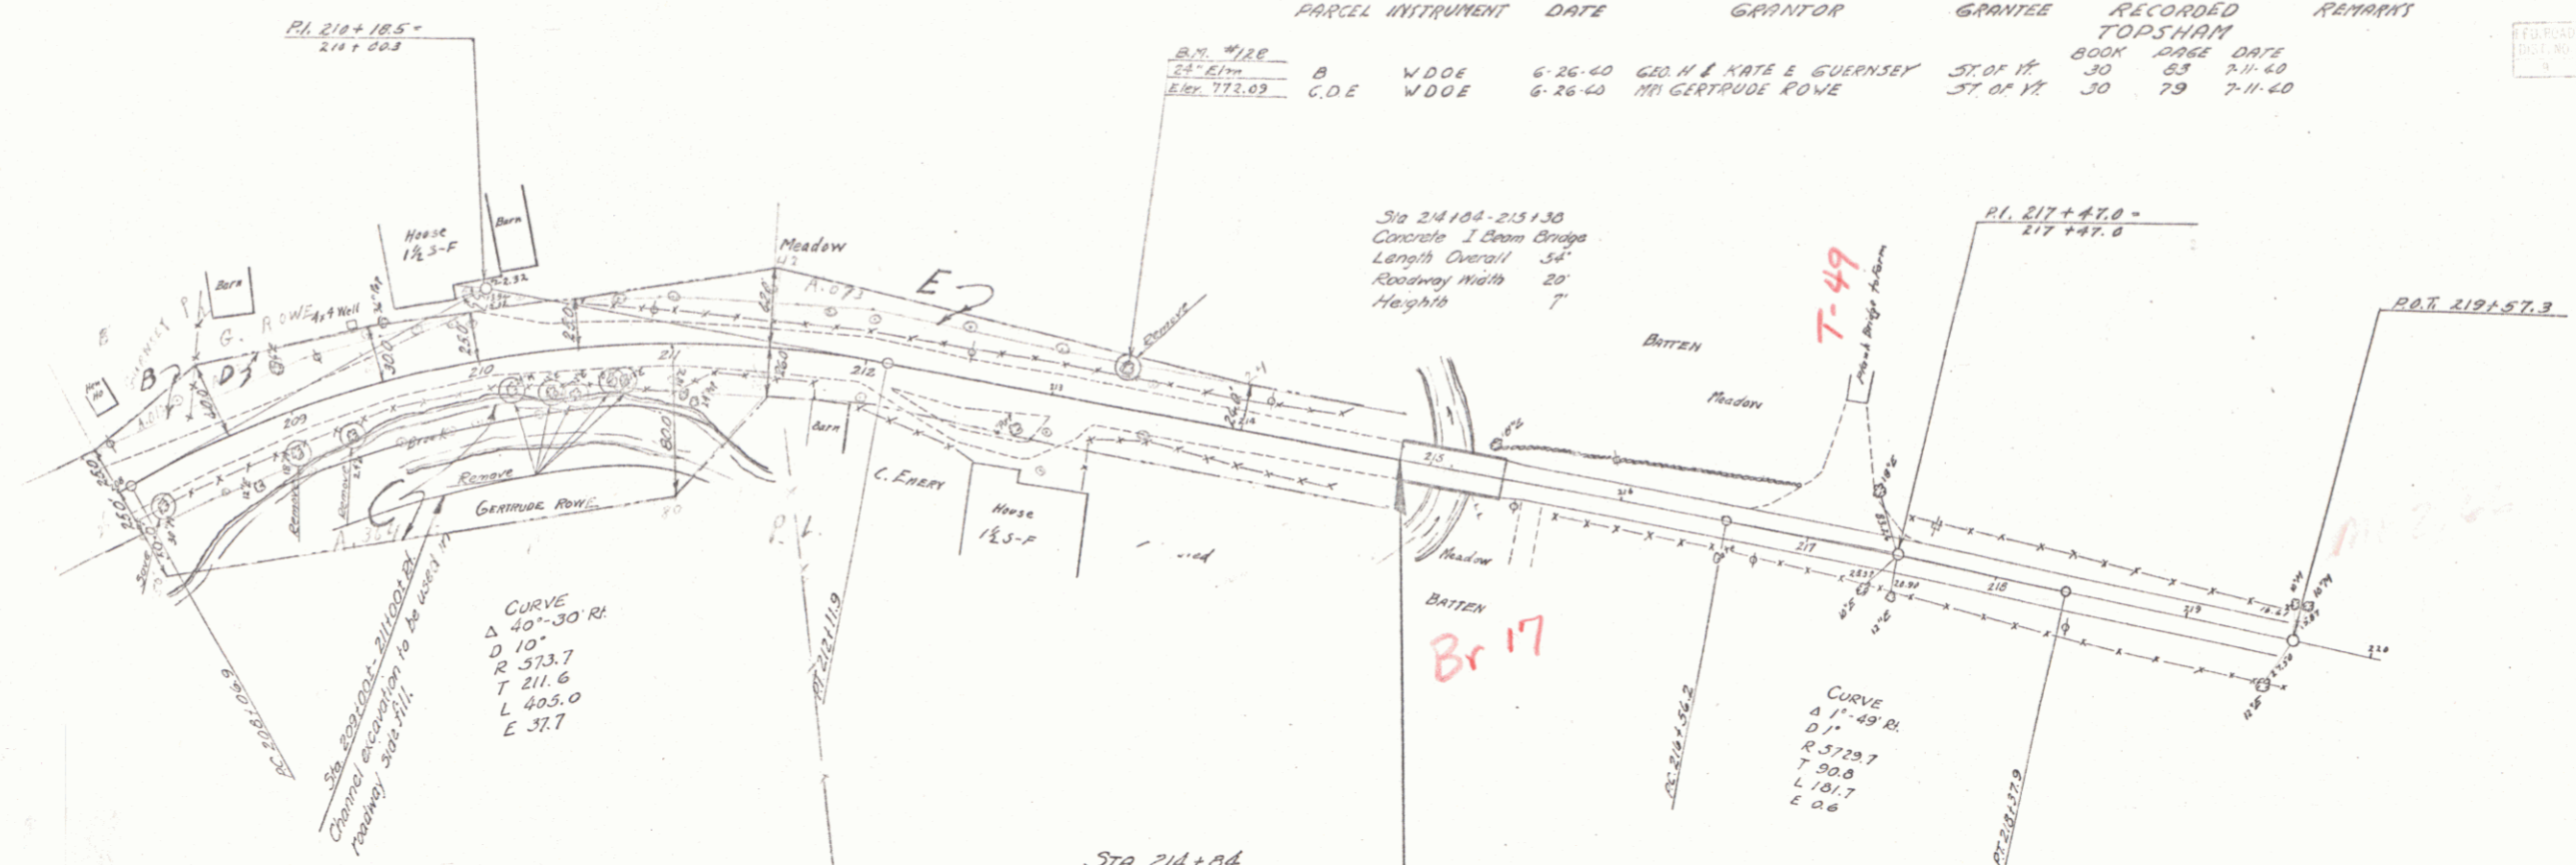

B.M. #128 SPIKE IN ROOT OF 24" ELM 17 FT. LT. OF STA. 212+35 ELEV. 772.03

TOPSHAM  
SERIES STATE NO. 169L  
SHEET 6 OF 6